




LEGEND:

- ULMUS PARVIFOLIA (UP)
- ACER SACCHARUM (AS)
- ILEX GLABRA (IG)
- ILEX X 'NELLIE R STEVENS' (IN)
- QUERCUS NUTTALLI

STREET TREE TABLE:							
KEY	QTY	BOTANICAL NAME	COMMON NAME	MIN. INSTALLED SIZE	ROOT	TYPE	REMARKS
UP	258	ULMUS PARVIFOLIA	LACINBARC ELM	2.5" CAL, 12' MIN.	DBS	STREET TREES	SINGLE STRAIGHT LEADER, FULL & HEAVY.
AS	211	ACER SACCHARUM	SUGAR MAPLE	2.5" CAL, 12' MIN.	DBS	STREET TREES	SINGLE STRAIGHT LEADER, FULL & HEAVY.
UNDERSTORY TREES							
	95	QUERCUS NUTTALLI	NUTTALL OAK	2.5" CAL, 10' HT MIN.	DBS	STREET TREES	
SHURBS							
IG	87	ILEX GLABRA	INKBERRY HOLLY	24" HT	5 GAL	PERMETER BUFFER	FULL & HEAVY, HEIGHT: 4' AFTER 2 YEARS.

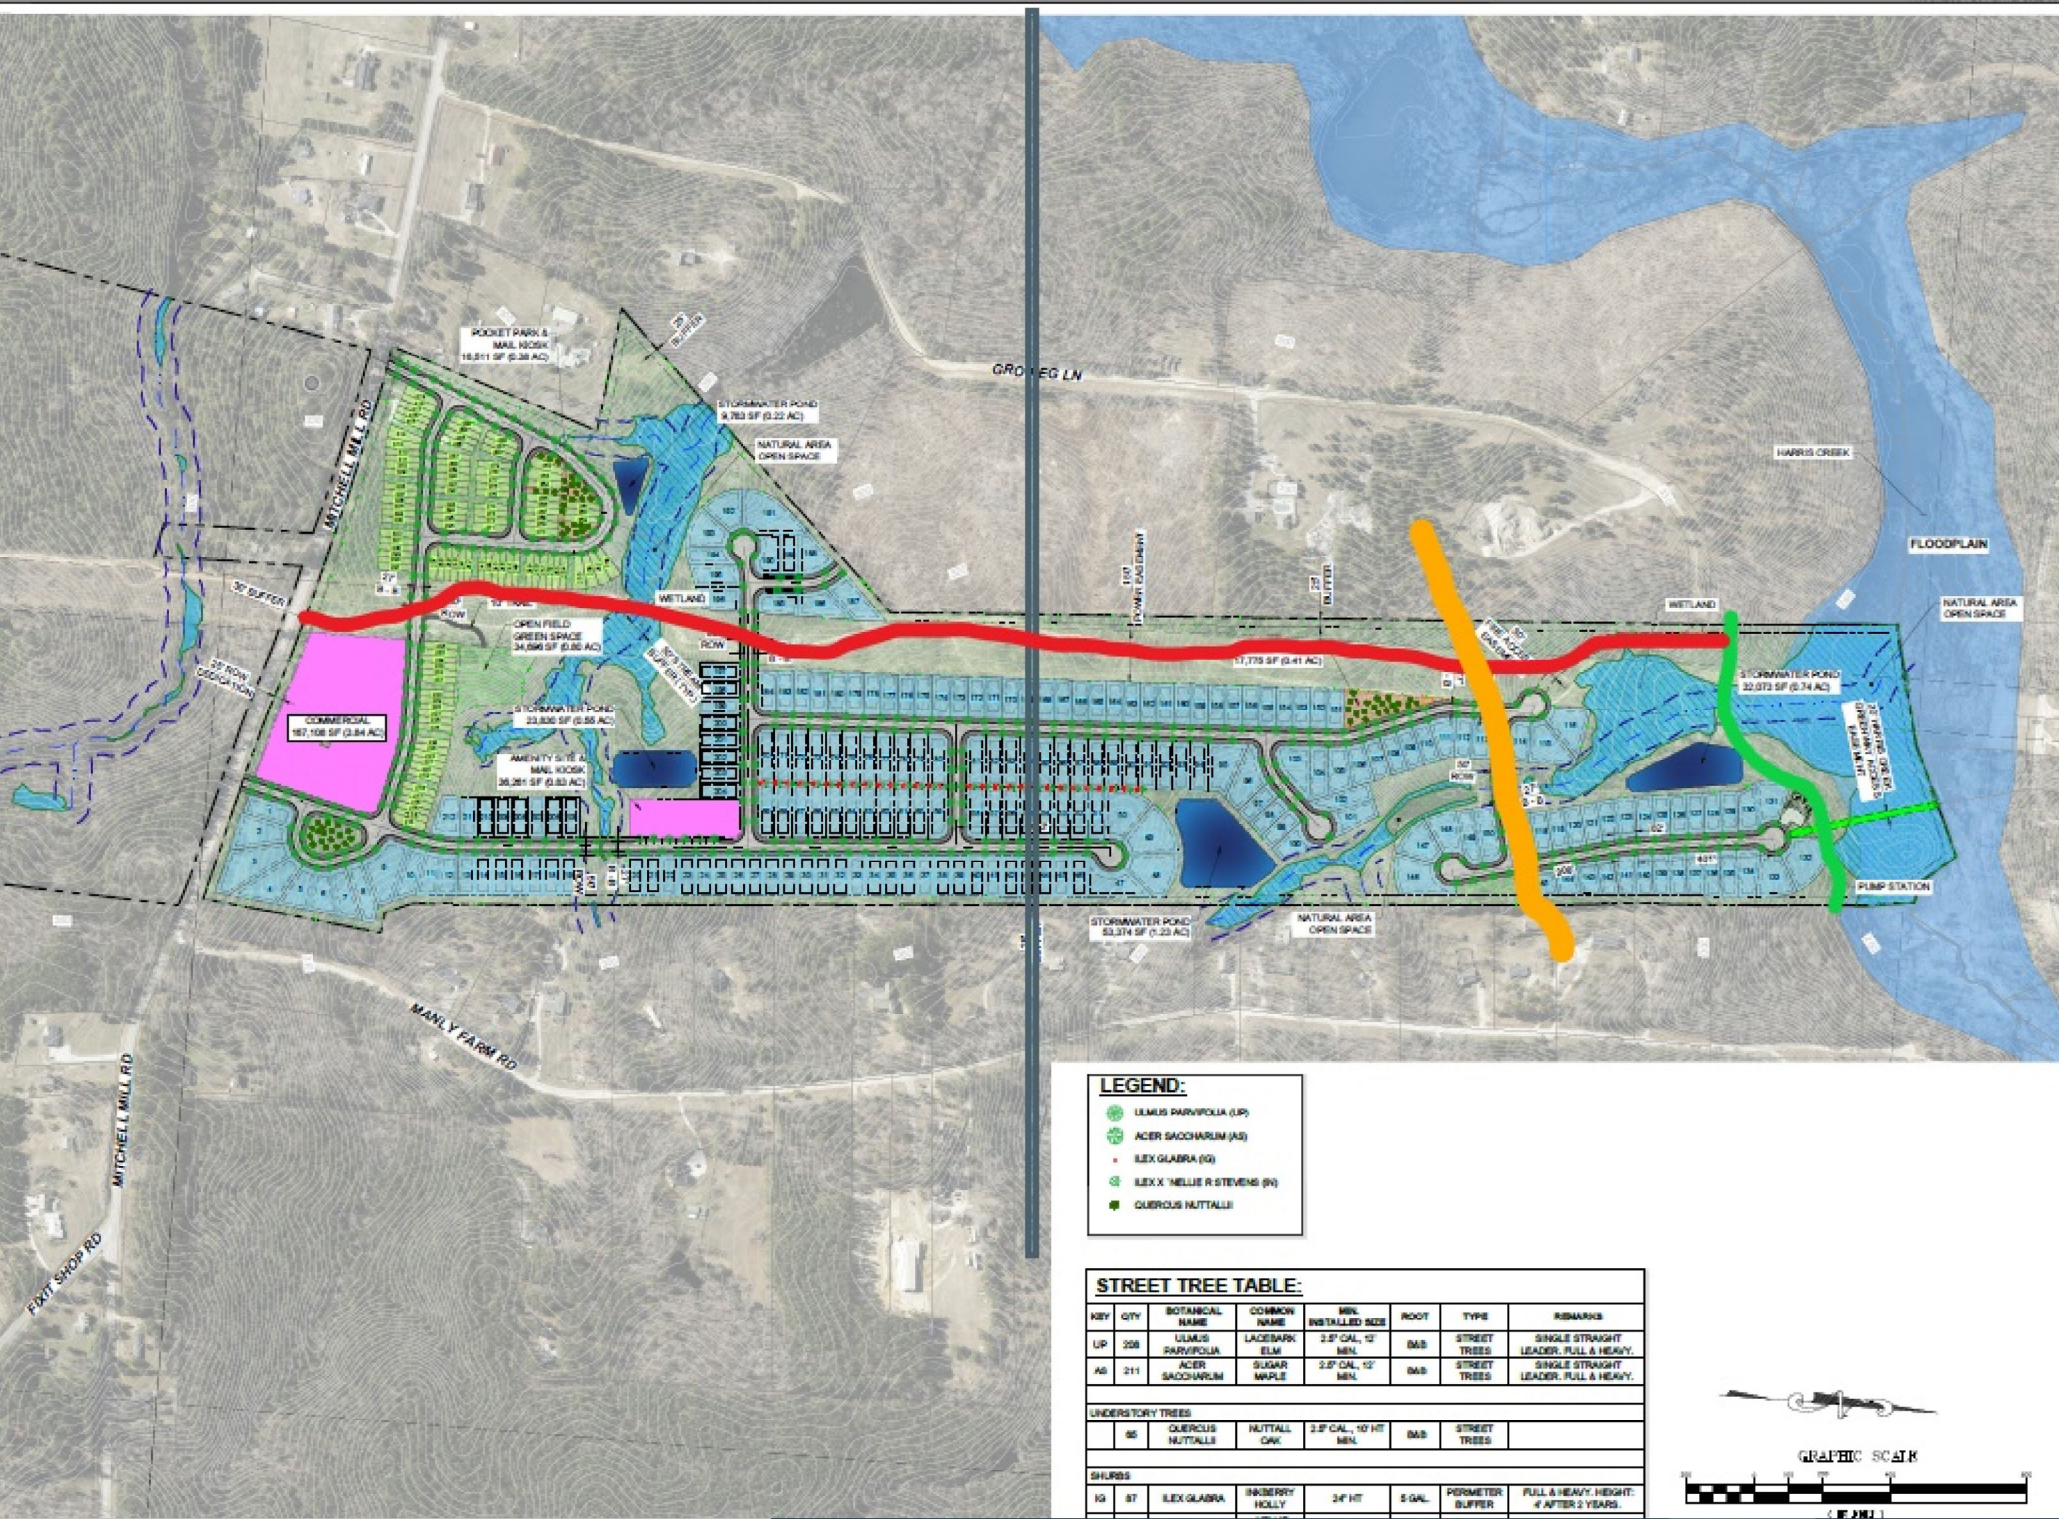