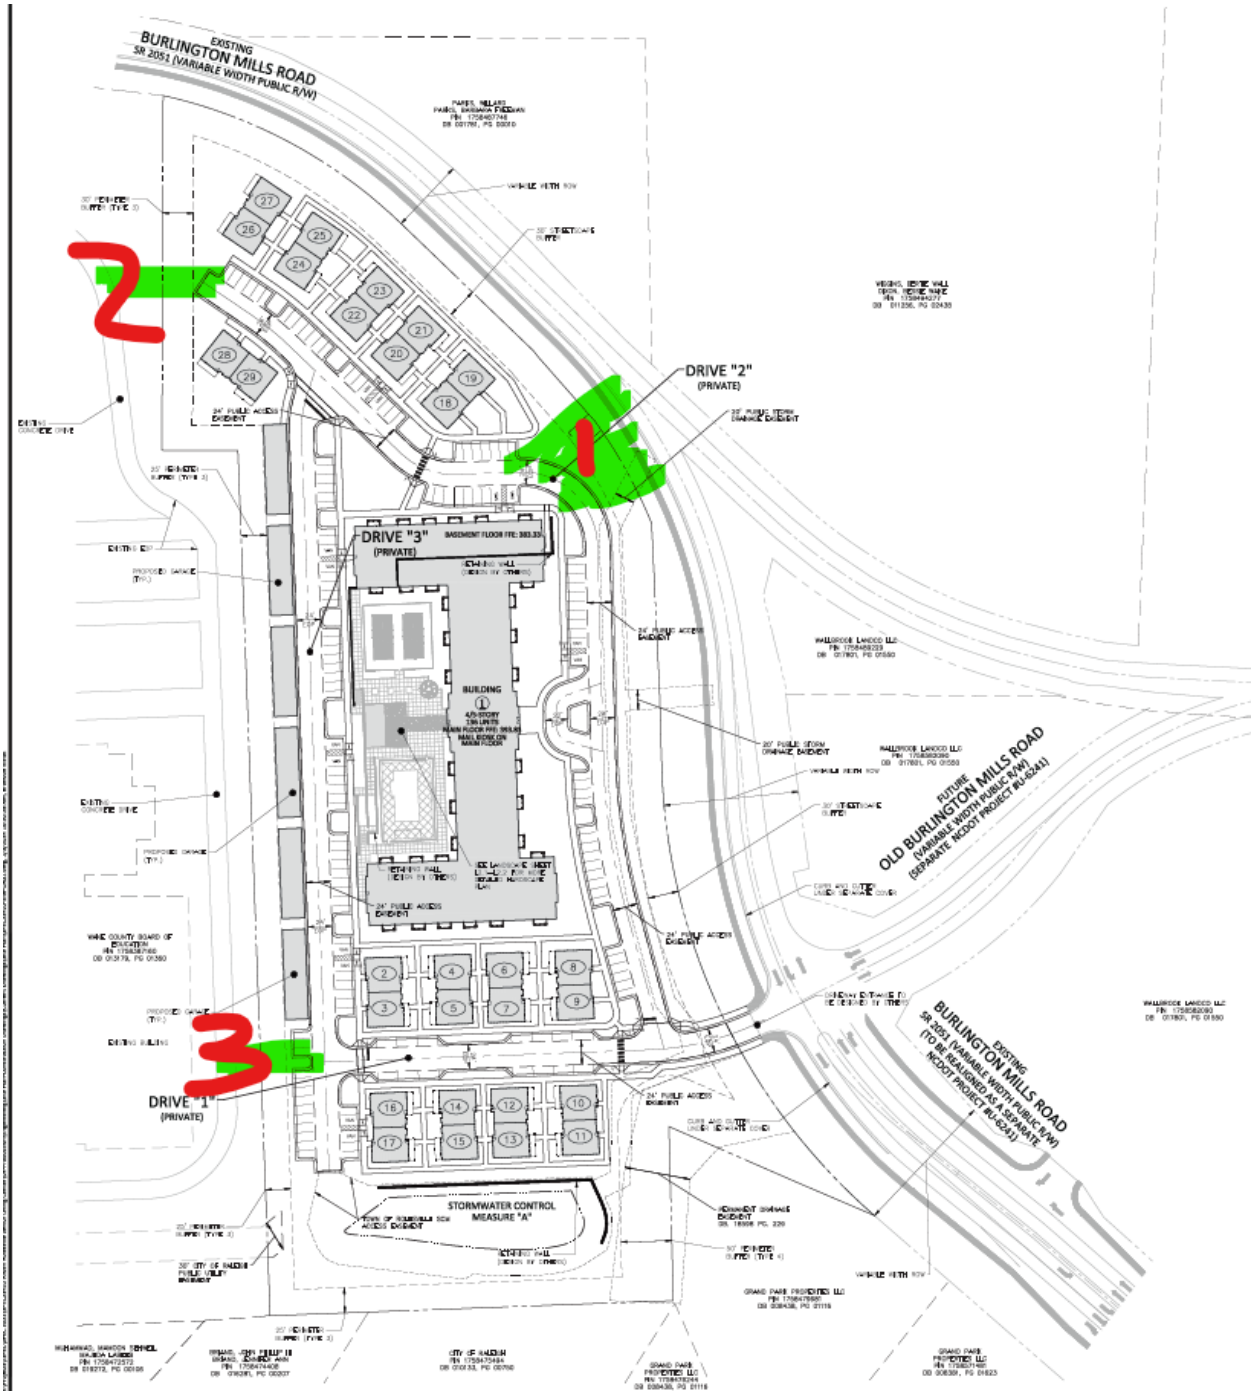Fire Access Exhibit by Staff