


Sheet 6.0
STAFF
MARK-UP

This is the lot...
1st

This gives the impression that this boundary is not which line is the live line boundary it is not

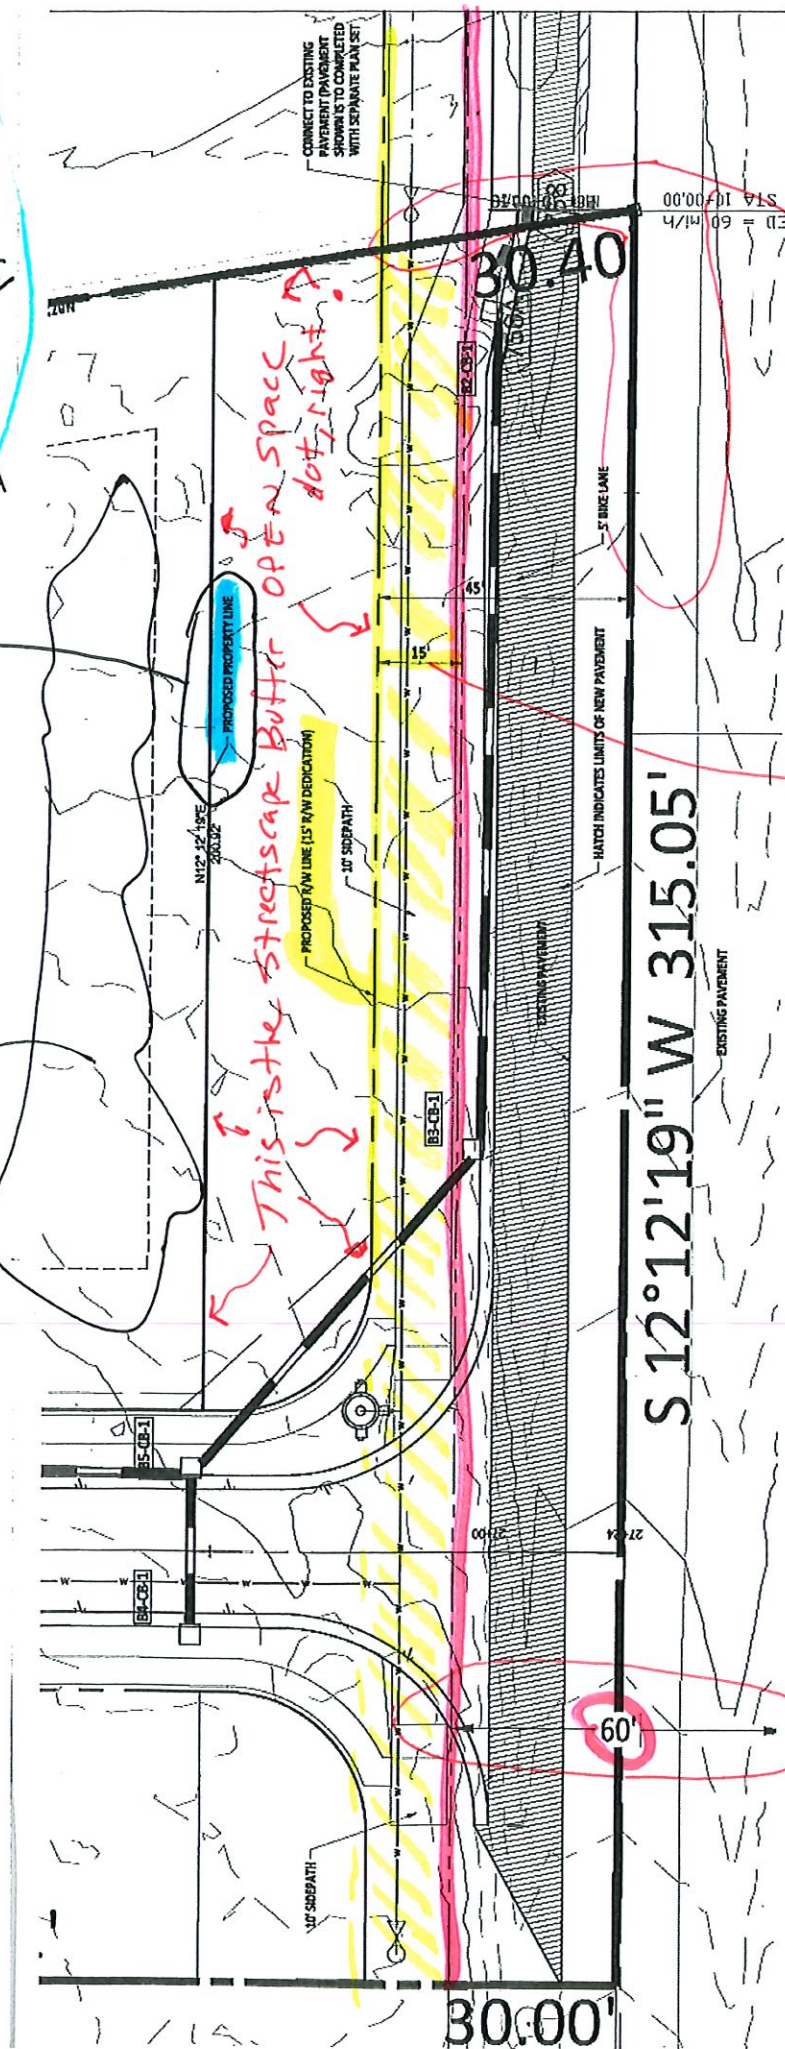

This is the streetscape Buffer OPEN SPACE dot right!

EXISTING ROW

15' Row Dedication

What is this heavy black line & why does it go to middle of EXISTING ROW?

CONNECT TO EXISTING PAVEMENT SHOWN IS TO COMPLETED WITH SEPARATE PLAN SET

ED = 60 m/h
STA 10+00.00

S12°12'19" W 315.05'

30.00

30.40

HATCH INDICATES LIMITS OF NEW PAVEMENT

EXISTING PAVEMENT

5' BIKE LANE

5' BIKE LANE

10' SIDEWALK

10' SIDEWALK

PROPOSED PROPERTY LINE

PROPOSED 15' W DEDICATION






B3-CB-1

B3-CB-1

