


JONES DAIRY ROAD WIDENING IS UNDER SEPARATE COVER AND HAS BEEN ALREADY BEEN SUBMITTED. IT IS CURRENTLY UNDER REVIEW

The Nau Company
 Consulting Civil Engineers
 PO Box 810, Rolesville, NC 27571
 919-435-6395
 NCBELS License P-0751

CLIENT:
 PRESERVE AT JONES DAIRY, LLC
 10534 ARNOLD PALMER DRIVE
 RALEIGH, NC 27617 919-0761

NO.	DATE	REVISIONS
1	2023-03-17	REVISIONS PER DOT COMMENTS FOR WATER LINE CONNECTIONS
2	2023-03-23	REVISED STORM AND SEWER MAINS TO 15" DIA. (15' TO 10' TO 15')
3	2023-03-24	TOWARDS SIGNING BUILD DRIVE
4	2023-03-24	REVISED PHASE LINES
5	2023-03-28	REVISED STORM PIPE DATA FROM EXISTING STRUCTURES TO 15" DIA.
6	2023-04-01	REVISED PHASE LINES AND RESPONSES PER TOWN REVIEW
7	2024-01-19	REVISED PHASE LINES AND RESPONSES PER TOWN REVIEW

PRESERVE AT JONES DAIRY - CENTRAL
CONSTRUCTION DRAWINGS
 ROLESVILLE, NC
GRADING PLAN - WEST

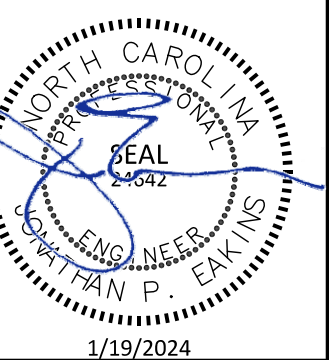

PROJECT NO: ---
 DESIGN BY: JPE
 DRAWN BY: RSF
 SCALE: 1"=50'
 DATE: 2023-01-27
 SHEET NO: **C4.5**

