


# QUARRY ROAD "1"

**CITY OF RALEIGH - PLANS AUTHORIZED FOR CONSTRUCTION**  
 Electronic Approval: This approval is being issued electronically. This approval is valid only upon the signature of a City of Raleigh Review Officer below. The City will retain a copy of the approved plans. Any work authorized by this approval must proceed in accordance with the plans kept on file with the City. This electronic approval may not be edited once issued. Any modification to this approval once issued will invalidate this approval.  
 City of Raleigh Development Approval: \_\_\_\_\_  
 City of Raleigh Review Officer: \_\_\_\_\_

**SITE PERMITTING APPROVAL**  
 Water and Sewer Permits (if applicable)  
 The City of Raleigh consents to the connection and extension of the City's Public Sewer System as shown on this plan. The material and construction methods used for this project shall conform to the standards and specifications of the City's Public Utilities Handbook, City of Raleigh Public Utilities Department Permit # S-3935.  
 The City of Raleigh consents to the connection and extension of the City's Public Water System as shown on this plan. The material and construction methods used for this project shall conform to the standards and specifications of the City's Public Utilities Handbook, City of Raleigh Public Utilities Department Permit # W-3552.  
 The City of Raleigh consents to the connection to its public sewer system and extension of the private sewer collection system as shown on this plan. The material and construction methods used for this project shall conform to the standards and specifications of the City's Public Utilities Handbook.  
 City of Raleigh Public Utilities Department Permit # \_\_\_\_\_

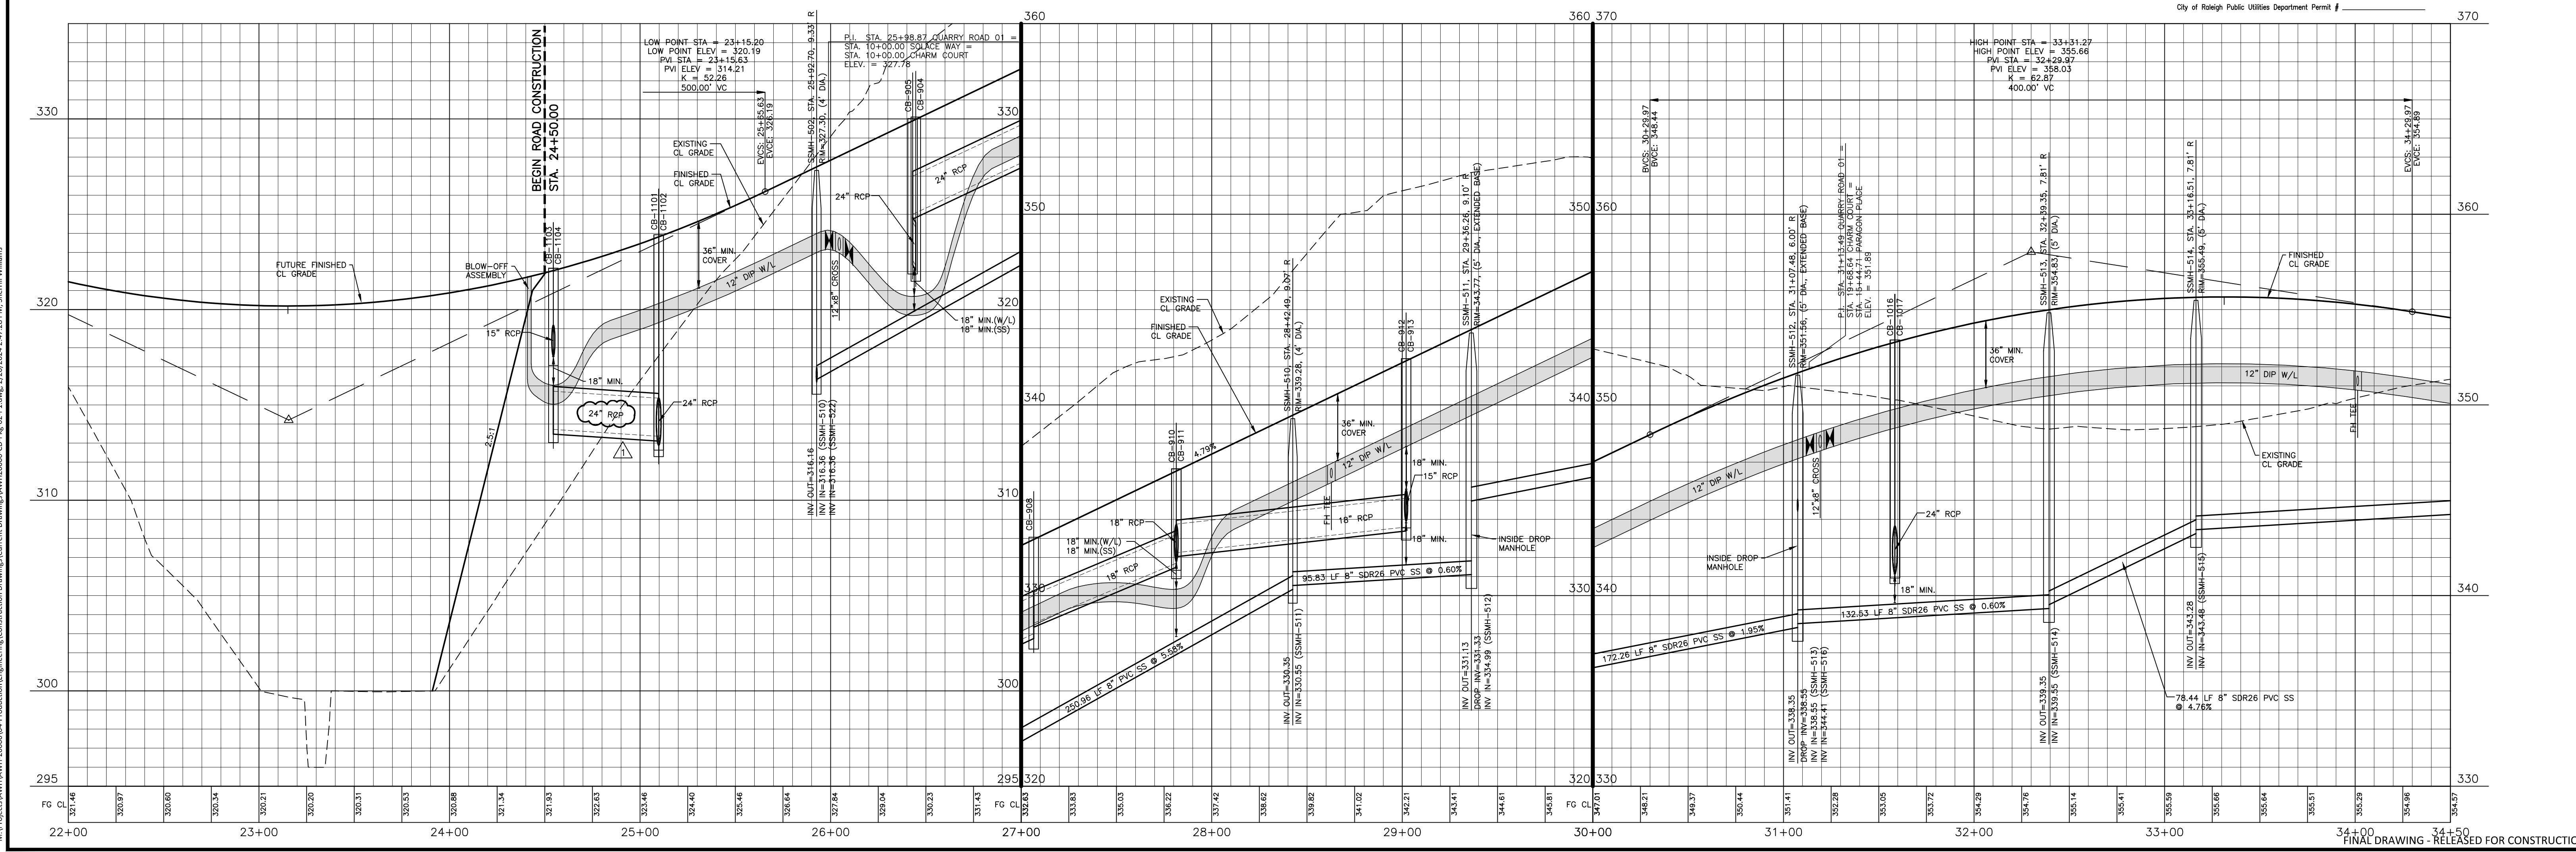

**McADAMS**  
 The John R. McAdams Company, Inc.  
 2905 Meridian Parkway  
 Durham, NC 27713  
 phone 919. 361. 5000  
 fax 919. 361. 2269  
 license number: C-0293, C-187  
 www.mcadamsco.com

**CLIENT**  
 ASHTON RALEIGH RESIDENTIAL, LLC.  
 900 RIDGEFIELD DRIVE, SUITE 335  
 RALEIGH, NORTH CAROLINA 27609  
 PHONE: 919. 422. 7663  
 CONTACT: BOB MISHLER  
 ASHTON WOODS.

**REVISIONS**

| NO. | DATE       | REV                                   | DESCRIPTION |
|-----|------------|---------------------------------------|-------------|
| 1   | 02.20.2024 | REV POND, STORM DRAINAGE AND ADD WALL |             |



**THE POINT - PHASES 3, 4, 5, 7 AND 10**  
**CONSTRUCTION DRAWINGS - PACKAGE 2**  
 TOWN OF ROLESVILLE, WAKE FOREST TOWNSHIP,  
 WAKE COUNTY, NORTH CAROLINA

**PLAN INFORMATION**  
 PROJECT NO. AWH-20000  
 FILENAME AWH20000-CD-PKG-02-P-  
 CHECKED BY WTO  
 DRAWN BY SRW  
 SCALE 1"=40'/1"=4'  
 DATE 05.08.2023

**PLAN AND PROFILE**  
 QUARRY ROAD "1", STA. 23+00 THRU STA. 34+50  
**C5.00**  
 CD 20-08