Town of Rolesville, NC
Department of Planning

502 Southtown Circle
Rolesville, NC 27571
Phone: (919) 556-3506

Comments on #SDP-26-0007 - Planning & Zoning: Site Development Plan

Application Number: #SDP-26-0007
Application Type: Site Development Plan
Date: September 11, 2026
Address: 408 E YOUNG ST, ROLESVILLE, NC 27571
Parcel: 1768098727

THIS DOCUMENT IS NOT AN APPROVAL.

The Town of Rolesville Technical Review Committee has reviewed your Site Development Plan Application and provided a set of comments requiring your attention. These comments must be addressed in full before approval is issued.

Reviewing this document on the GovWell, our online portal, will allow you to view interactive markups on the document. If you are viewing this as a PDF or offline, a list of all comments will be provided below in this cover sheet. These comments must be addressed before approval is granted.

After you have addressed all comments, please upload corrected versions of the plans by clicking here or by visiting https://app.govwell.com/record/c2357957-b1de-4e55-ae14-8a08b6e1f422.

Contacts

Austin Bain City of Raleigh Engineer	(919) 996-3468 austin.bain@raleighnc.gov	Repeat Comment(s)
Jacqueline Thompson On-Call Civil Engineer	jacqueline.thompson@bolton-menk.com	Updates Requested
Michael Elabarger Assistant Planning Director	melabarger@rolesvillenc.gov	Repeat Comment(s)
Michele Raby Planner II	mraby@rolesvillenc.gov	Review complete *See comments
Stephen Wensman Planning Director	swensman@rolesvillenc.gov	Updates Requested
Stephen Wolf Wake County Deputy Fire Marshal	stephen.wolf@wake.gov	Updates Requested

Comments on Plan

Reviewer feedback tied to specific locations on the plan. The number on each comment corresponds to a matching number marked on the plan page. Each comment must be resolved in GovWell.

1 JT Jacqueline Thompson
On-Call Civil Engineer

Please include pre and post impervious and pervious numbers.

V2_SDP 26-0007 -2026-08-19 Rolesville Police Site Plan Sub2.pdf · Page 1 • September 11, 2026, 1:21pm

2 MR Michele Raby
Planner II

Pls add PSP-26-0004.

V2_SDP 26-0007 -2026-08-19 Rolesville Police Site Plan Sub2.pdf · Page 1 • September 4, 2026, 3:07pm

3 SW Stephen Wolf
Wake County Deputy Fire Marshal

** No fire service issues with the initial site plan for the Rolesville Police Station.

V2_SDP 26-0007 -2026-08-19 Rolesville Police Site Plan Sub2.pdf · Page 2 • September 11, 2026, 9:16am

4 JT Jacqueline Thompson
On-Call Civil Engineer

Update all sheet references.

V2_SDP 26-0007 -2026-08-19 Rolesville Police Site Plan Sub2.pdf · Page 3 • September 11, 2026, 1:24pm

5 JT Jacqueline Thompson
On-Call Civil Engineer

Please review these labels - they appear to possibly match Key Note B.

V2_SDP 26-0007 -2026-08-19 Rolesville Police Site Plan Sub2.pdf · Page 4 • September 11, 2026, 1:23pm

6 JT Jacqueline Thompson
On-Call Civil Engineer

REPEAT: Please clarify if there is any reverse curb - if so, please identify locations on the plans in some way.

V2_SDP 26-0007 -2026-08-19 Rolesville Police Site Plan Sub2.pdf · Page 5 • September 11, 2026, 1:27pm

7 JT Jacqueline Thompson
On-Call Civil Engineer

REPEAT: Adjust curb and pavement limits and/or grading to match.

V2_SDP 26-0007 -2026-08-19 Rolesville Police Site Plan Sub2.pdf · Page 5 • September 11, 2026, 1:25pm

8 SW Stephen Wensman
Planning Director

Parking Perimeter Plantings required here.

V2_SDP 26-0007 -2026-08-19 Rolesville Police Site Plan Sub2.pdf · Page 8 • September 3, 2026, 10:58am

9

JT

Jacqueline Thompson
On-Call Civil Engineer

Please include a pipe backfill and trench detail to verify backfill, compaction, and materials required for storm pipe.

V2_SDP 26-0007 -2026-08-19 Rolesville Police Site Plan Sub2.pdf · Page 15 • September 11, 2026, 1:32pm

ROLESVILLE PLAN CASE # CID-25-07_SDP-26-0007

ROLESVILLE POLICE STATION

408 E. YOUNG STREET - LOT 1
ROLESVILLE NC, 27571
TOWN OF ROLESVILLE
AUGUST 19,2026

adw architects
environments for life
architecture planning interiors
2815 coliseum centre drive
suite 500
charlotte, nc 28217
704.379.1919
adwarchitects.com

Rolesville
Genuine Community • Capital Connection
Est. 1837

ROLESVILLE POLICE

CLH DESIGN
CLH design, p.a.
400 Regency Forest Drive
Suite 120
Cary, NC 27518
Phone: 919.319.6716
LA: C-106, PE: C-1595

VICINITY MAP

SITE DATA

OWNER:	TOWN OF ROLESVILLE
OWNER CONTACT:	P.O. BOX 250 ROLESVILLE, NC 27571 MEDHAT BASELIOUS, PE, PMP CAPITAL PROJECT MANAGER, TOWN OF ROLESVILLE MEDHAT.BASELIOUS@ROLESVILLE.NC.GOV
LANDSCAPE ARCHITECT:	CLH DESIGN, P.A.
DESIGNER CONTACT:	RACHEL WATSON, PLA 919-319-6716 400 REGENCY FOREST DRIVE, STE.120 CARY, NC 27511 RWATSON@CLHDESIGNPA.COM
CIVIL ENGINEER:	CLH DESIGN, P.A.
DESIGNER CONTACT:	DANI LOVERA, PE 919-319-6716 400 REGENCY FOREST DRIVE, STE. 120 CARY, NC 27511 DLOVERA@CLHDESIGNPA.COM
PROJECT ADDRESS:	LOT-1 408 E. YOUNG STREET & 0 E. YOUNG STREET ROLESVILLE, NC 27571
PLANNING JURISD:	TOWN OF ROLESVILLE
PIN:	1768098727
DEEDED ACREAGE:	13.39AC
SITE AREA:	2.0AC
ZONING:	BT – BUSINESS INDUSTRIAL AND TECHNOLOGY
EXISTING USE:	VACANT
PROPOSED USE:	GOVERNMENT FACILITY (POLICE STATION)
DISTURBED AREA:	2.0 ACRES16
BUILDING AREA SF:	15,112 SQFT
BUILDING HEIGHT:	25' HT
RIVER BASIN:	NEUSE RIVER
FLOODZONE:	N/A
FEMA MAP:	PANEL 3720176900J

1

SHEET INDEX

CIVIL

C-0.00	COVER
C-0.02	FIRE APPARATUS EXHIBIT
C-1.01	STAKING PLAN
C-2.01	EXISTING CONDITIONS & DEMOLITION PLAN
C-3.01	GRADING PLAN
C-4.01	EROSION CONTROL PLAN
C-5.01	UTILITY PLAN
C-6.01	LANDSCAPE PLAN
C-8.01	SITE DETAILS
C-8.02	SITE DETAILS
C-9.01	UTILITY DETAILS
C-9.02	UTILITY DETAILS
C-9.03	UTILITY DETAILS
C-9.04	UTILITY DETAILS
C-9.05	UTILITY DETAILS

ARCHITECTURAL

AR200	EXTERIOR ELEVATIONS
AR201	DUMPSTER ENCLOSURE DETAILS

ELECTRICAL

E010	ELECTRICAL SITE PLAN
E011	ELECTRICAL SITE PHOTOMETRICS
E503	ELECTRICAL DETAILS
E701	LIGHTING FIXTURE SCHEDULE

REVISION HISTORY

REV #	DESCRIPTION	DATE SUBMITTED
REV # 1	1st PLAN SUBMITTAL	JUNE 22nd, 2026
REV # 2	TOR COMMENTS	AUGUST 19th, 2026
–	–	–

PARKING SPACE REQUIREMENTS:

PARKING STANDARDS 2.5 PARKING SPACES PER 1000SF
15,112SF / 1000SF X 2.5 PARKING SPACES
=38 PARKING SPACES
48 PARKING SPACES PROVIDED

BIKE STANDARDS:1 BIKE SPACE PER 5000SF

15,112SF / 5000SF
= 3 BIKE SPACES REQUIRED
3 BIKE SPACES PROVIDED

PERVIOUS ENTITLEMENTS

CASE	APPROVAL DATE
CID-26-0003, CID-25-07	–
TA-26-0005	06-16-2026
PEZ-26-0003	06-16-2026
PSP	–

2

TOWN OF ROLESVILLE
POLICE
DEPARTMENT

ROLESVILLE, NC
27571

COVER

DATE: 08-19-2026
PROJECT NO:
CLH PROJECT NO: 25-108

THIS DRAWING IS THE PROPERTY OF ADW ARCHITECTS, P.A. AND SHALL NOT BE REPRODUCED OR COPIED IN WHOLE OR PART. IT SHALL NOT BE USED ON ANY OTHER PROJECT OR GIVEN TO ANY OTHER COMPANY OR AGENCY WITHOUT THE CONSENT OF ADW ARCHITECTS, P.A.

SHEET NUMBER:
C-0.00

TOWN OF ROLESVILLE SIGNATURE BLOCK

RALEIGH WATER INSPECTIONS QUANTITIES (SUBDIVISIONS & SITE PLANS)	
NUMBER OF LOTS	6
NUMBER OF UNITS	N/A
PUBLIC WATER (LF)	2023
PUBLIC SEWER (LF)	950
PUBLIC FORCE MAIN (LF)	N/A
PRIVATE SEWER (LF)	360
WATER SERVICE STUBS (QTY)	6
SEWER SERVICE STUBS (QTY)	0
AVERAGE DAILY FLOW PER PHASE	TBD

EROSION CONTROL, STORMWATER AND FLOODPLAIN MANAGEMENT
APPROVED
EROSION CONTROL ☐ SEC-_____
STORMWATER MGMT. ☐ SWF-_____
FLOOD STUDY ☐ SWF-_____
DATE_____
FOR ENGINEERING & CONSTRUCTION SERVICES USE

ATTENTION CONTRACTORS

THE CONTRACTOR RESPONSIBLE FOR THE EXTENSION OF WATER, SEWER, AND/OR REUSE, AS APPROVED IN THESE PLANS, IS RESPONSIBLE FOR CONTACTING THE INFRASTRUCTURE INSPECTIONS DIVISION AND SCHEDULE A PRE-CONSTRUCTION MEETING ON THE DEVELOPMENT PORTAL PRIOR TO BEGINNING ANY CONSTRUCTION. RALEIGH WATER MUST BE CONTACTED AT (919) 996-4540 AT LEAST TWENTY-FOUR HOURS PRIOR TO BEGINNING ANY WORK ACTIVITY AROUND CRITICAL WATER AND SEWER INFRASTRUCTURE.

FAILURE TO NOTIFY CITY DEPARTMENTS IN ADVANCE OF BEGINNING CONSTRUCTION, WILL RESULT IN THE ISSUANCE OF MONETARY FINES, AND REQUIRE REINSTALLATION OF ANY WATER OR SEWER FACILITIES NOT INSPECTED AS A RESULT OF THIS NOTIFICATION FAILURE.

FAILURE TO CALL FOR INSPECTION, INSTALL A DOWNSTREAM PLUG, HAVE PERMITTED PLANS ON THE JOBSITE, OR ANY OTHER VIOLATION OF CITY OF RALEIGH STANDARDS WILL RESULT IN A FINE AND POSSIBLE EXCLUSION FROM FUTURE WORK IN THE CITY OF RALEIGH.

1 **Jacqueline Thompson**
Please include pre and post impervious and pervious numbers.

2 **Michele Raby**
Pls add PSP-26-0004.

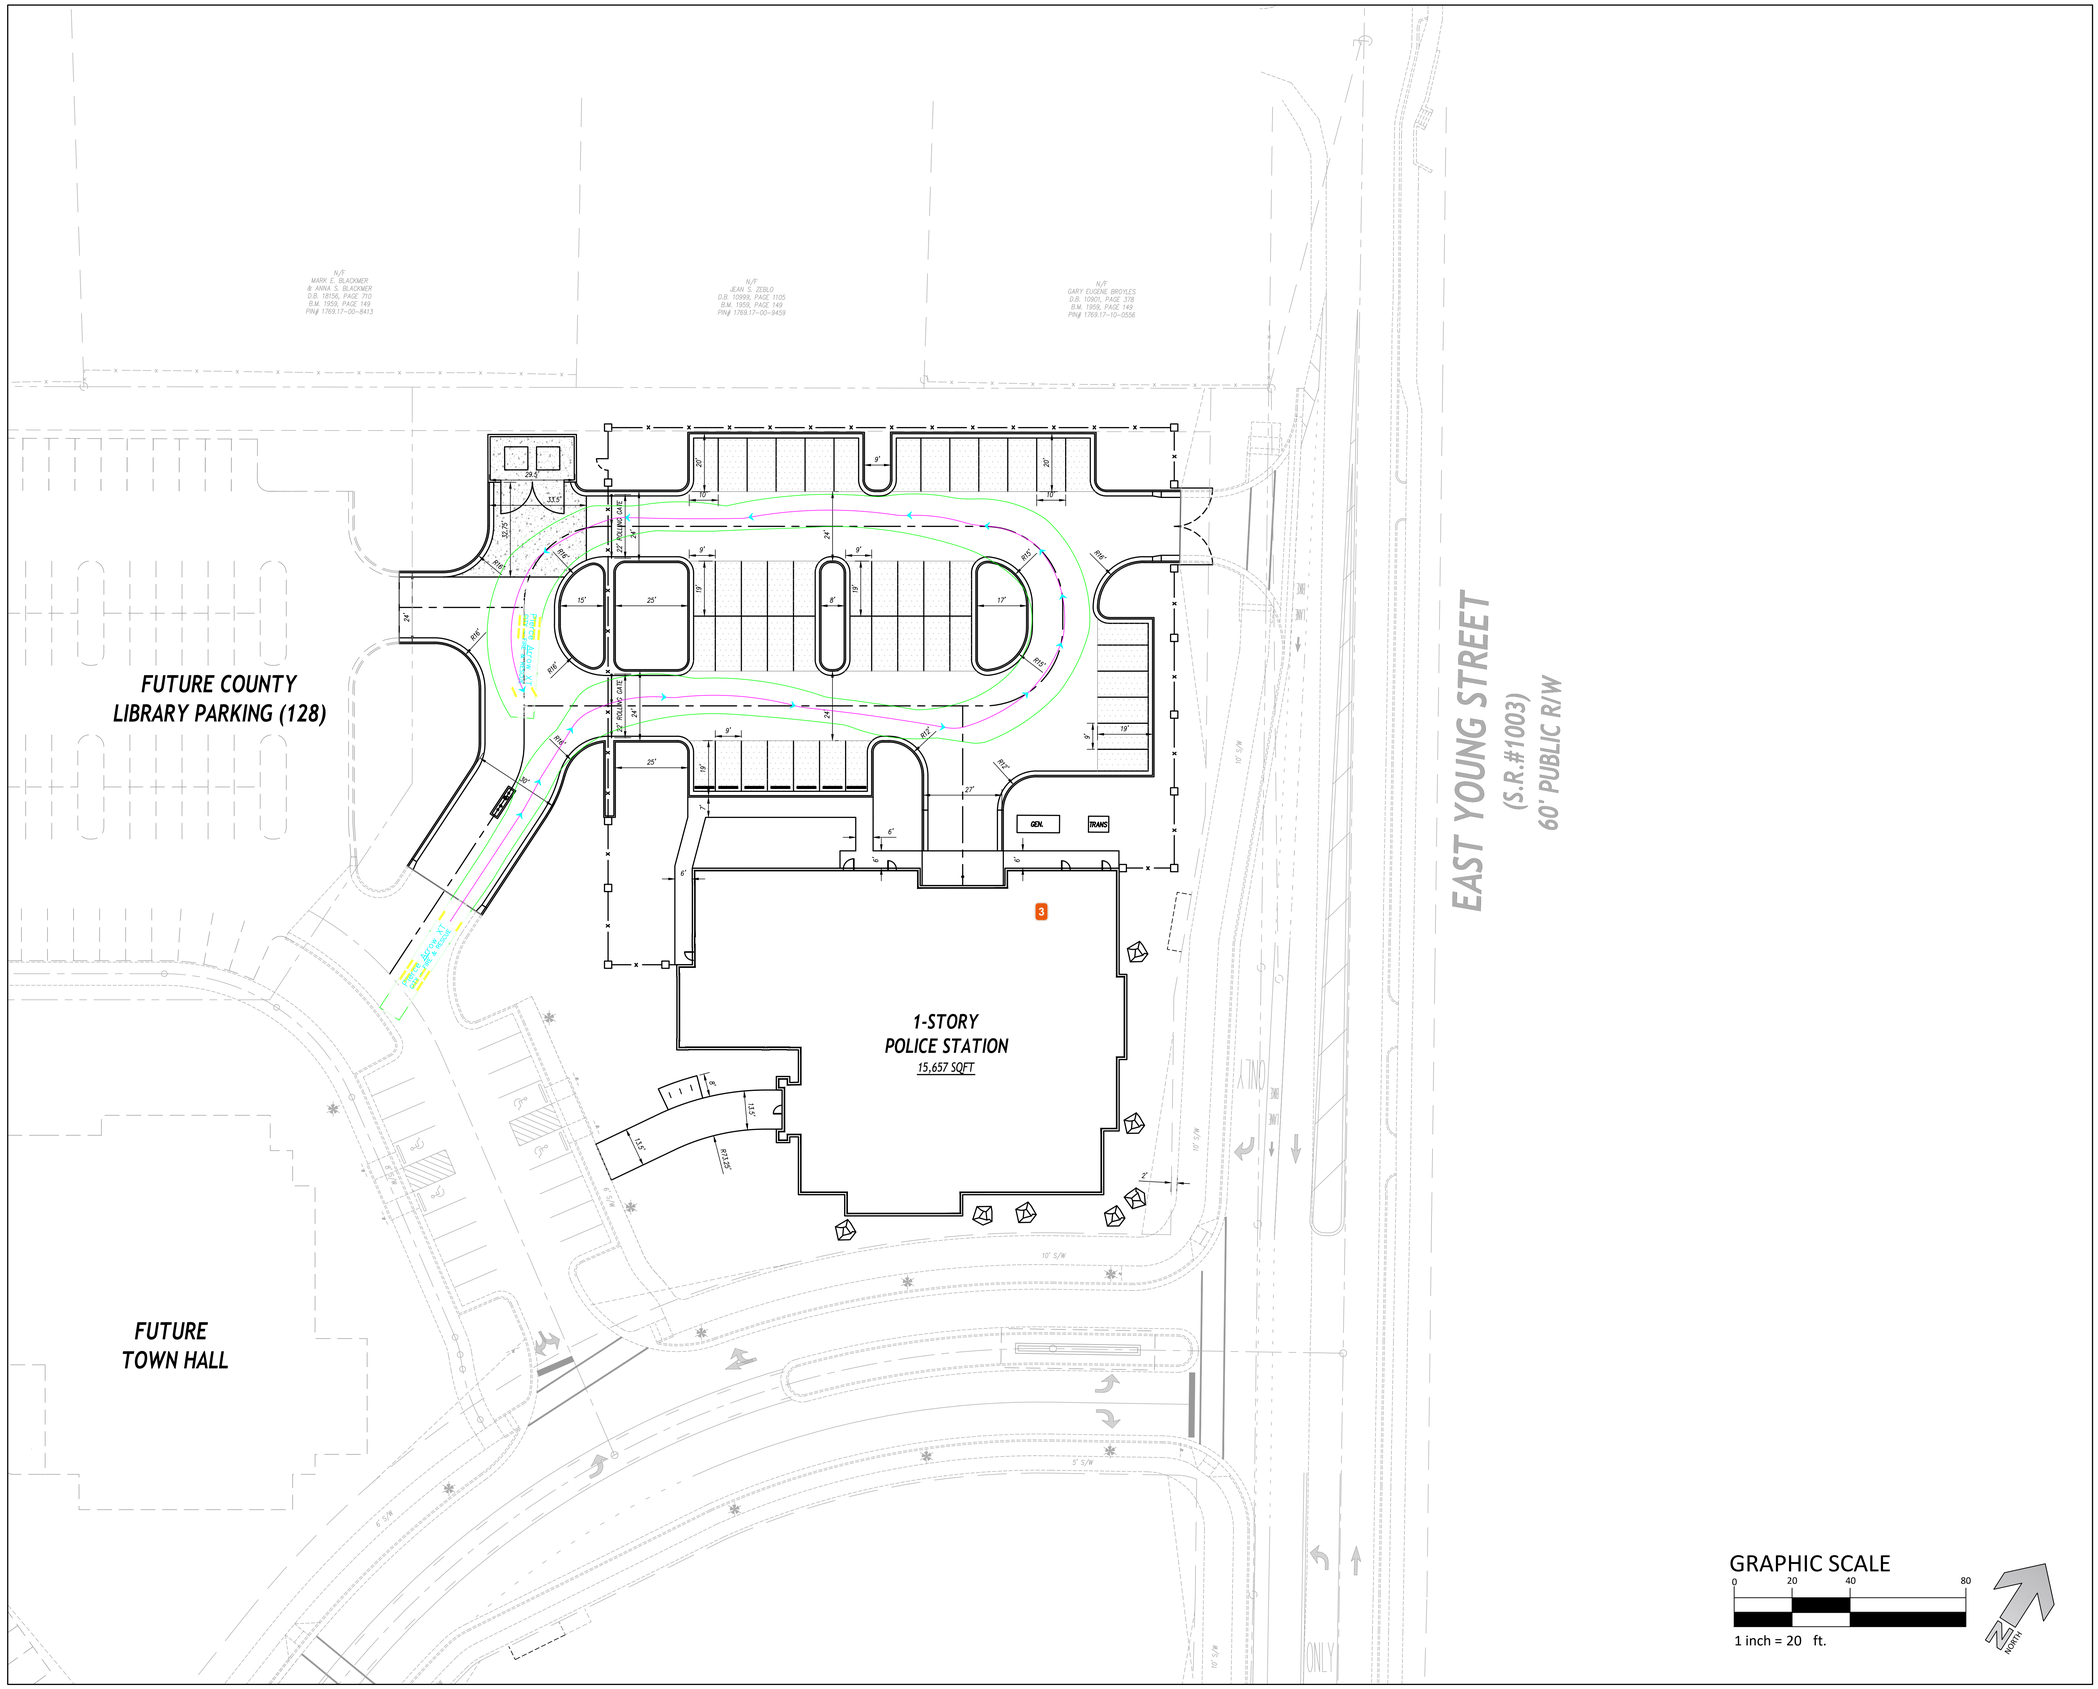

GRAPHIC SCALE

0 20 40 80

1 inch = 20 ft.

NORTH

adw architects
environments for life
architecture planning interiors
2815 coliseum centre drive
suite 500
charlotte, nc 28217
704.379.1919
adwarchitects.com

Rolesville
Genuine Community • Capital Connection
Est. 1837

ROLESVILLE POLICE

CLH DESIGN
CLH design, p.a.
400 Regency Forest Drive
Suite 120
Cary, NC 27518
Phone: 919.319.6716
LA: C-106, PE: C-1595

TOWN OF ROLESVILLE POLICE DEPARTMENT

ROLESVILLE, NC 27571

FIRE APPARATUS PLAN

DATE: 08-19-2026
PROJECT NO:
CLH PROJECT NO: 25-108

THIS DRAWING IS THE PROPERTY OF ADW ARCHITECTS, P.A. AND SHALL NOT BE REPRODUCED OR COPIED IN WHOLE OR PART. IT SHALL NOT BE USED ON ANY OTHER PROJECT OR GIVEN TO ANY OTHER COMPANY OR AGENCY WITHOUT THE CONSENT OF ADW ARCHITECTS, P.A.

SHEET NUMBER:

C-0.02

3 **Stephen Wolf**
** No fire service issues with the initial site plan for the Rolesville Police Station.

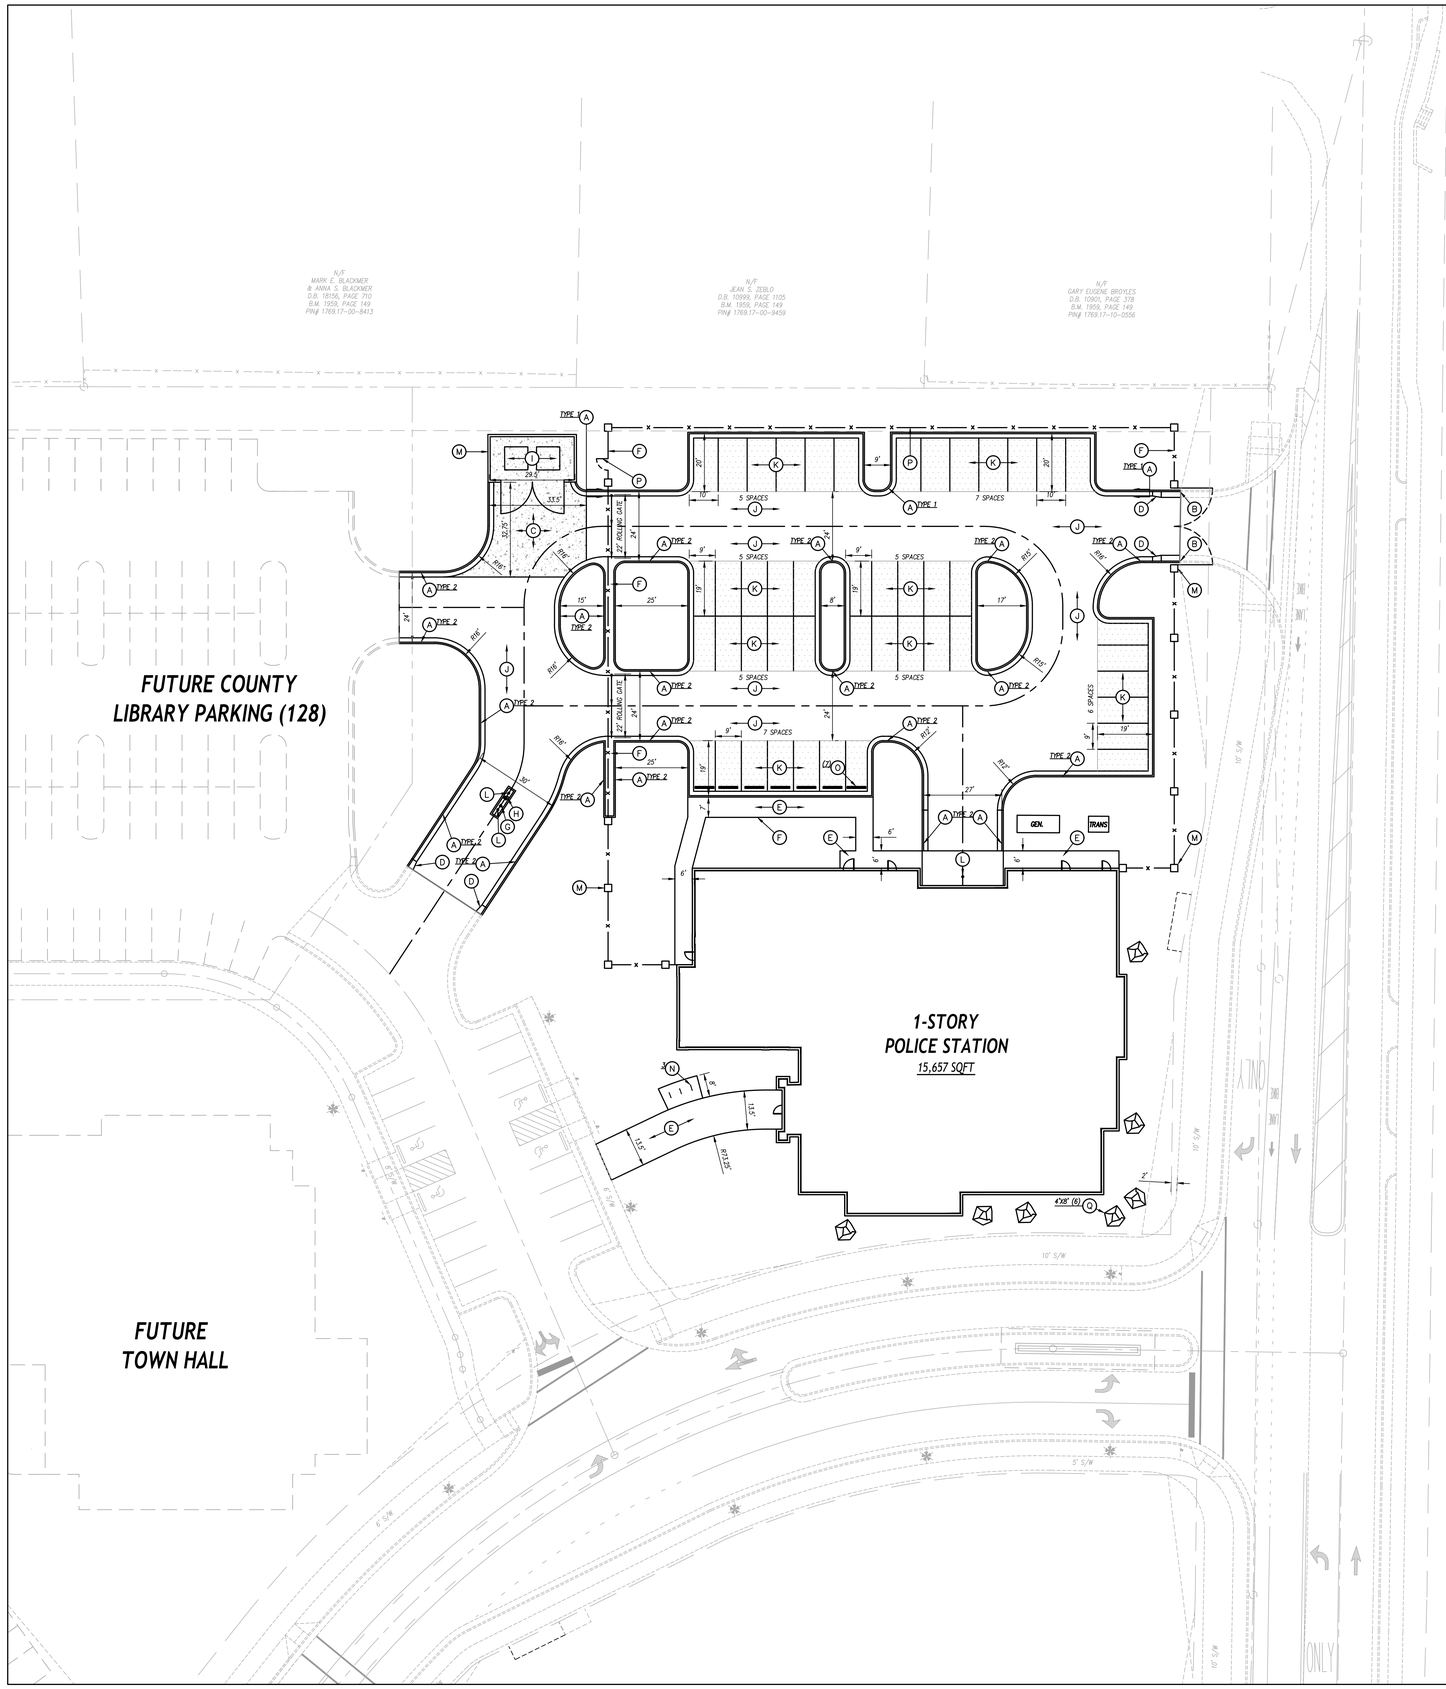

GENERAL NOTES

1. ALL CONSTRUCTION SHALL BE IN ACCORDANCE WITH ALL TOWN OF ROLESVILLE AND NCDOT STANDARDS AND SPECIFICATIONS.
2. ALL DIMENSIONS SHOWN ARE TO FACE OF CURB AND FACE OF BUILDING WALL, UNLESS OTHERWISE SHOWN.
3. CONTRACTOR SHALL BE RESPONSIBLE FOR FIELD VERIFICATION OF ALL DIMENSIONS SHOWN AND CONTACT THE ARCHITECT IF ANY DISCREPANCIES OCCUR.
4. CONSTRUCTION STAKE OUT IS THE RESPONSIBILITY OF THE CONTRACTOR.
5. ALL PAVEMENT MARKINGS AND SIGNAGE SHALL CONFORM TO THE "MANUAL ON UNIFORM TRAFFIC CONTROL DEVICES".
6. ALL FACE OF RADII ARE 4-FT UNLESS OTHERWISE SHOWN.
7. ALL PARKING SPACES SHALL BE A MINIMUM OF 9-FT WIDE X 19-FT DEEP.
8. (AC) DENOTES ACCESSIBLE PARKING SPACE.
9. (VAC) DENOTES VAN ACCESSIBLE PARKING SPACE.
10. ANY AND ALL LANDSCAPING, EXISTING TREES OR SHRUBS TO REMAIN WHICH ARE DAMAGED DURING DEMOLITION OR CONSTRUCTION SHALL BE REPLACED BY THE CONTRACTOR UTILIZING A LICENSED LANDSCAPE CONTRACTOR AT NO ADDITIONAL COST TO THE OWNER.
11. CONTRACTOR SHALL SUBMIT SCALED PLANS OF ALL SCORING/JOINTS FOR APPROVAL BY ARCHITECT 30 DAYS MINIMUM PRIOR TO INSTALLATION.
12. THE CROSS-SLOPE ON ALL SIDEWALKS SHALL BE A MAXIMUM OF 2.0%.
13. NO WORK SHALL BE PERFORMED ON RIGHT-OF-WAYS OR ADJACENT PROPERTIES UNTIL THE OWNER NOTIFIES CONTRACTOR IN WRITING OF PROCUREMENT OF APPROPRIATE PERMITS, EASEMENTS, AGREEMENTS, OR RIGHTS-OF-WAY.

KEY NOTES

4

- (A) 24-IN CURB & GUTTER, SEE DETAIL SHEET ___
- (B) 30-IN CURB & GUTTER, SEE DETAIL SHEET ___
- (C) CONCRETE PAVEMENT, SEE DETAIL SHEET___
- (D) 24-IN TO 30-IN CURB TRANSITION.
- (E) CONCRETE SIDEWALK, SEE DETAIL SHEET ___
- (F) 8-FT ORNAMENTAL ALUMINUM FENCE AND GATES WITH MASONRY COLUMNS, SEE DETAIL SHEET ___
- (G) APPROX. LOCATION OF KNOX BOX SWITCH; VERIFY W/ OWNER, SEE DETAIL SHEET ___
- (H) APPROX. LOCATION OF KEYPAD FOR GATE; VERIFY W/ OWNER, SEE DETAIL SHEET ___
- (I) DUMPSTER, PROVIDED BY OWNER.
- (J) "HEAVY" DUTY ASPHALT PAVEMENT, SEE DETAIL SHEET ___
- (K) "LIGHT" DUTY ASPHALT PAVEMENT, SEE DETAIL SHEET ___
- (L) STEEL BOLLARD, SEE DETAIL SHEET ___
- (M) SEE ARCHITECTURAL PLANS FOR CANOPY, SCREEN AND STRUCTURAL WALLS, BUILDING COLUMNS, LOADING DOCK, RAMPS, STAIRS, HANDRAILS, GUARDRAILS, BOLLARDS AND MECHANICAL SERVICE YARD.
- (N) BIKE RACK, SEE SPECIFICATIONS; SEE DETAIL SHEET ___
- (O) PRECAST CONCRETE WHEELSTOP, SEE DETAIL SHEET ___
- (P) 8-FT ORNAMENTAL ALUMINUM FENCE WITH NO COLUMN, SEE DETAIL SHEET ___
- (Q) 4' x 8' BOULDER TO BE BURIED MIN. 18"

GRAPHIC SCALE

0 20 40 80

1 inch = 20 ft.

NORTH

adw architects
environments for life
architecture planning interiors
2815 coliseum centre drive
suite 500
charlotte, nc 28217
704.379.1919
adwarchitects.com

Rolesville
Genuine Community • Capital Connection
Est. 1837

ROLESVILLE POLICE

CLH DESIGN
CLH design, p.a.
400 Regency Forest Drive
Suite 120
Cary, NC 27518
Phone: 919.319.6716
LA: C-106, PE: C-1595

TOWN OF ROLESVILLE POLICE DEPARTMENT

ROLESVILLE, NC 27571

STAKING PLAN

DATE: 08-19-2026
PROJECT NO:
CLH PROJECT NO: 25-108

THIS DRAWING IS THE PROPERTY OF ADW ARCHITECTS, P.A. AND SHALL NOT BE REPRODUCED OR COPIED IN WHOLE OR PART. IT SHALL NOT BE USED ON ANY OTHER PROJECT OR GIVEN TO ANY OTHER COMPANY OR AGENCY WITHOUT THE CONSENT OF ADW ARCHITECTS, P.A.

SHEET NUMBER:

C-1.01

4 **Jacqueline Thompson**
Update all sheet references.

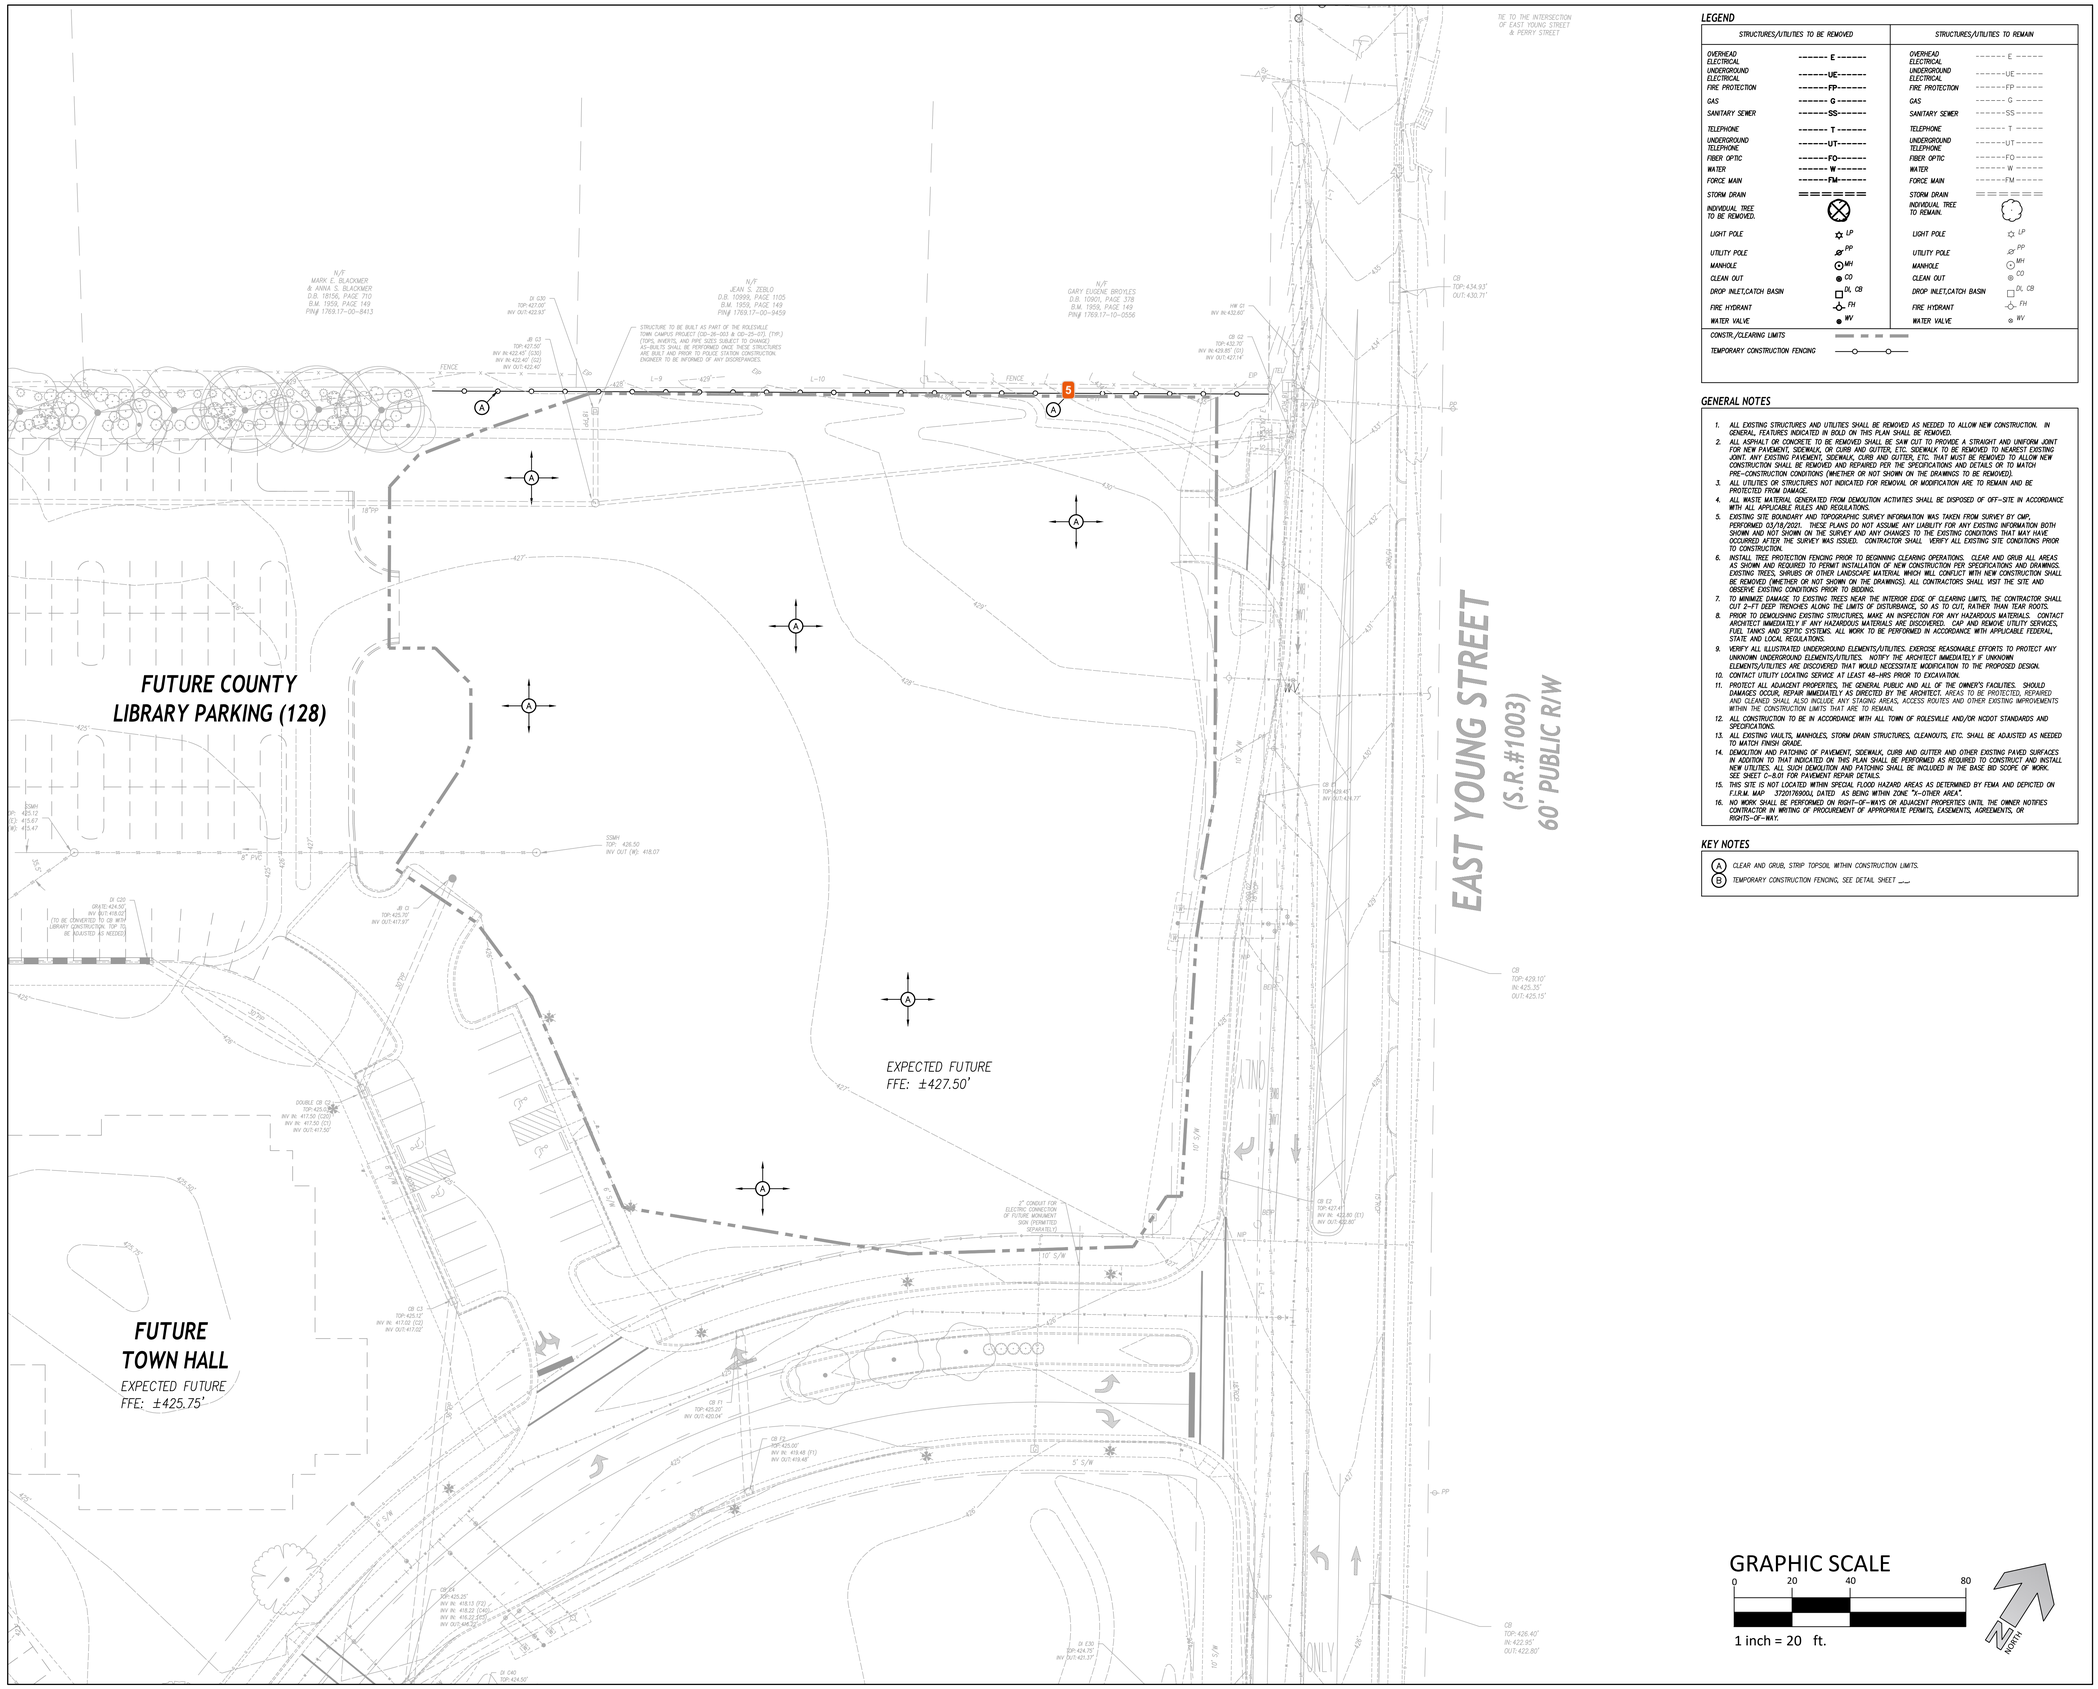

LEGEND

STRUCTURES/UTILITIES TO BE REMOVED		STRUCTURES/UTILITIES TO REMAIN	
OVERHEAD ELECTRICAL	------ E ------	OVERHEAD ELECTRICAL	------ E ------
UNDERGROUND ELECTRICAL	------UE------	UNDERGROUND ELECTRICAL	------UE------
FIRE PROTECTION	------FP------	FIRE PROTECTION	------FP------
GAS	------ G ------	GAS	------ G ------
SANITARY SEWER	------SS------	SANITARY SEWER	------SS------
TELEPHONE	------ T ------	TELEPHONE	------ T ------
UNDERGROUND TELEPHONE	------UT------	UNDERGROUND TELEPHONE	------UT------
FIBER OPTIC	------FO------	FIBER OPTIC	------FO------
WATER	------ W ------	WATER	------ W ------
FORCE MAIN	------FM------	FORCE MAIN	------FM------
STORM DRAIN	═══════	STORM DRAIN	═══════
INDIVIDUAL TREE TO BE REMOVED.		INDIVIDUAL TREE TO REMAIN.	
LIGHT POLE	LP	LIGHT POLE	LP
UTILITY POLE	PP	UTILITY POLE	PP
MANHOLE	MH	MANHOLE	MH
CLEAN OUT	CO	CLEAN OUT	CO
DROP INLET,CATCH BASIN	DI, CB	DROP INLET,CATCH BASIN	DI, CB
FIRE HYDRANT	FH	FIRE HYDRANT	FH
WATER VALVE	WV	WATER VALVE	WV
CONSTR./CLEARING LIMITS			
TEMPORARY CONSTRUCTION FENCING			

GENERAL NOTES

1. ALL EXISTING STRUCTURES AND UTILITIES SHALL BE REMOVED AS NEEDED TO ALLOW NEW CONSTRUCTION. IN GENERAL, FEATURES INDICATED IN BOLD ON THIS PLAN SHALL BE REMOVED.
2. ALL ASPHALT OR CONCRETE TO BE REMOVED SHALL BE SAW CUT TO PROVIDE A STRAIGHT AND UNIFORM JOINT FOR NEW PAVEMENT, SIDEWALK, OR CURB AND GUTTER, ETC. SIDEWALK TO BE REMOVED TO NEAREST EXISTING JOINT. ANY EXISTING PAVEMENT, SIDEWALK, CURB AND GUTTER, ETC. THAT MUST BE REMOVED TO ALLOW NEW CONSTRUCTION SHALL BE REMOVED AND REPAIRED PER THE SPECIFICATIONS AND DETAILS OR TO MATCH PRE-CONSTRUCTION CONDITIONS (WHETHER OR NOT SHOWN ON THE DRAWINGS TO BE REMOVED).
3. ALL UTILITIES OR STRUCTURES NOT INDICATED FOR REMOVAL OR MODIFICATION ARE TO REMAIN AND BE PROTECTED FROM DAMAGE.
4. ALL WASTE MATERIAL GENERATED FROM DEMOLITION ACTIVITIES SHALL BE DISPOSED OF OFF-SITE IN ACCORDANCE WITH ALL APPLICABLE RULES AND REGULATIONS.
5. EXISTING SITE BOUNDARY AND TOPOGRAPHIC SURVEY INFORMATION WAS TAKEN FROM SURVEY BY GMP, PERFORMED 03/18/2021. THESE PLANS DO NOT ASSUME ANY LIABILITY FOR ANY EXISTING INFORMATION BOTH SHOWN AND NOT SHOWN ON THE SURVEY AND ANY CHANGES TO THE EXISTING CONDITIONS THAT MAY HAVE OCCURRED AFTER THE SURVEY WAS ISSUED. CONTRACTOR SHALL VERIFY ALL EXISTING SITE CONDITIONS PRIOR TO CONSTRUCTION.
6. INSTALL TREE PROTECTION FENCING PRIOR TO BEGINNING CLEARING OPERATIONS. CLEAR AND GRUB ALL AREAS AS SHOWN AND REQUIRED TO PERMIT INSTALLATION OF NEW CONSTRUCTION PER SPECIFICATIONS AND DRAWINGS. EXISTING TREES, SHRUBS OR OTHER LANDSCAPE MATERIAL WHICH WILL CONFLICT WITH NEW CONSTRUCTION SHALL BE REMOVED (WHETHER OR NOT SHOWN ON THE DRAWINGS). ALL CONTRACTORS SHALL VISIT THE SITE AND OBSERVE EXISTING CONDITIONS PRIOR TO BIDDING.
7. TO MINIMIZE DAMAGE TO EXISTING TREES NEAR THE INTERIOR EDGE OF CLEARING LIMITS, THE CONTRACTOR SHALL CUT 2-FT DEEP TRENCHES ALONG THE LIMITS OF DISTURBANCE, SO AS TO CUT, RATHER THAN TEAR ROOTS.
8. PRIOR TO DEMOLISHING EXISTING STRUCTURES, MAKE AN INSPECTION FOR ANY HAZARDOUS MATERIALS. CONTACT ARCHITECT IMMEDIATELY IF ANY HAZARDOUS MATERIALS ARE DISCOVERED. CAP AND REMOVE UTILITY SERVICES, FUEL TANKS AND SEPTIC SYSTEMS. ALL WORK TO BE PERFORMED IN ACCORDANCE WITH APPLICABLE FEDERAL, STATE AND LOCAL REGULATIONS.
9. VERIFY ALL ILLUSTRATED UNDERGROUND ELEMENTS/UTILITIES. EXERCISE REASONABLE EFFORTS TO PROTECT ANY UNKNOWN UNDERGROUND ELEMENTS/UTILITIES. NOTIFY THE ARCHITECT IMMEDIATELY IF UNKNOWN ELEMENTS/UTILITIES ARE DISCOVERED THAT WOULD NECESSITATE MODIFICATION TO THE PROPOSED DESIGN.
10. CONTACT UTILITY LOCATING SERVICE AT LEAST 48-HRS PRIOR TO EXCAVATION.
11. PROTECT ALL ADJACENT PROPERTIES, THE GENERAL PUBLIC AND ALL OF THE OWNER'S FACILITIES. SHOULD DAMAGES OCCUR, REPAIR IMMEDIATELY AS DIRECTED BY THE ARCHITECT. AREAS TO BE PROTECTED, REPAIRED AND CLEANED SHALL ALSO INCLUDE ANY STAGING AREAS, ACCESS ROUTES AND OTHER EXISTING IMPROVEMENTS WITHIN THE CONSTRUCTION LIMITS THAT ARE TO REMAIN.
12. ALL CONSTRUCTION TO BE IN ACCORDANCE WITH ALL TOWN OF ROLESVILLE AND/OR NCDOT STANDARDS AND SPECIFICATIONS.
13. ALL EXISTING VAULTS, MANHOLES, STORM DRAIN STRUCTURES, CLEANOUTS, ETC. SHALL BE ADJUSTED AS NEEDED TO MATCH FINISH GRADE.
14. DEMOLITION AND PATCHING OF PAVEMENT, SIDEWALK, CURB AND GUTTER AND OTHER EXISTING PAVED SURFACES IN ADDITION TO THAT INDICATED ON THIS PLAN SHALL BE PERFORMED AS REQUIRED TO CONSTRUCT AND INSTALL NEW UTILITIES. ALL SUCH DEMOLITION AND PATCHING SHALL BE INCLUDED IN THE BASE BID SCOPE OF WORK. SEE SHEET C-8.01 FOR PAVEMENT REPAIR DETAILS.
15. THIS SITE IS NOT LOCATED WITHIN SPECIAL FLOOD HAZARD AREAS AS DETERMINED BY FEMA AND DEPICTED ON F.I.R.M. MAP 3720176900L DATED AS BEING WITHIN ZONE "X-OTHER AREA".
16. NO WORK SHALL BE PERFORMED ON RIGHT-OF-WAYS OR ADJACENT PROPERTIES UNTIL THE OWNER NOTIFIES CONTRACTOR IN WRITING OF PROCUREMENT OF APPROPRIATE PERMITS, EASEMENTS, AGREEMENTS, OR RIGHTS-OF-WAY.

KEY NOTES

(A) CLEAR AND GRUB, STRIP TOPSOIL WITHIN CONSTRUCTION LIMITS.
(B) TEMPORARY CONSTRUCTION FENCING, SEE DETAIL SHEET ___.

GRAPHIC SCALE
0 20 40 80
1 inch = 20 ft.
NORTH

adw architects
environments for life
architecture planning interiors
2815 coliseum centre drive
suite 500
charlotte, nc 28217
704.379.1919
adwarchitects.com

Rolesville
Genuine Community • Capital Connection
Est. 1837

ROLESVILLE POLICE

CLH DESIGN
CLH design, p.a.
400 Regency Forest Drive
Suite 120
Cary, NC 27518
Phone: 919.319.6716
LA: C-106, PE: C-1595

TOWN OF ROLESVILLE POLICE DEPARTMENT

ROLESVILLE, NC 27571

EXISTING CONDITIONS & DEMOLITION PLAN

DATE: 08-19-2026
PROJECT NO:
CLH PROJECT NO: 25-108

THIS DRAWING IS THE PROPERTY OF ADW ARCHITECTS, P.A. AND SHALL NOT BE REPRODUCED OR COPIED IN WHOLE OR PART. IT SHALL NOT BE USED ON ANY OTHER PROJECT OR GIVEN TO ANY OTHER COMPANY OR AGENCY WITHOUT THE CONSENT OF ADW ARCHITECTS, P.A.

SHEET NUMBER:
C-2.01

5 **Jacqueline Thompson**
Please review these labels - they appear to possibly match Key Note B.

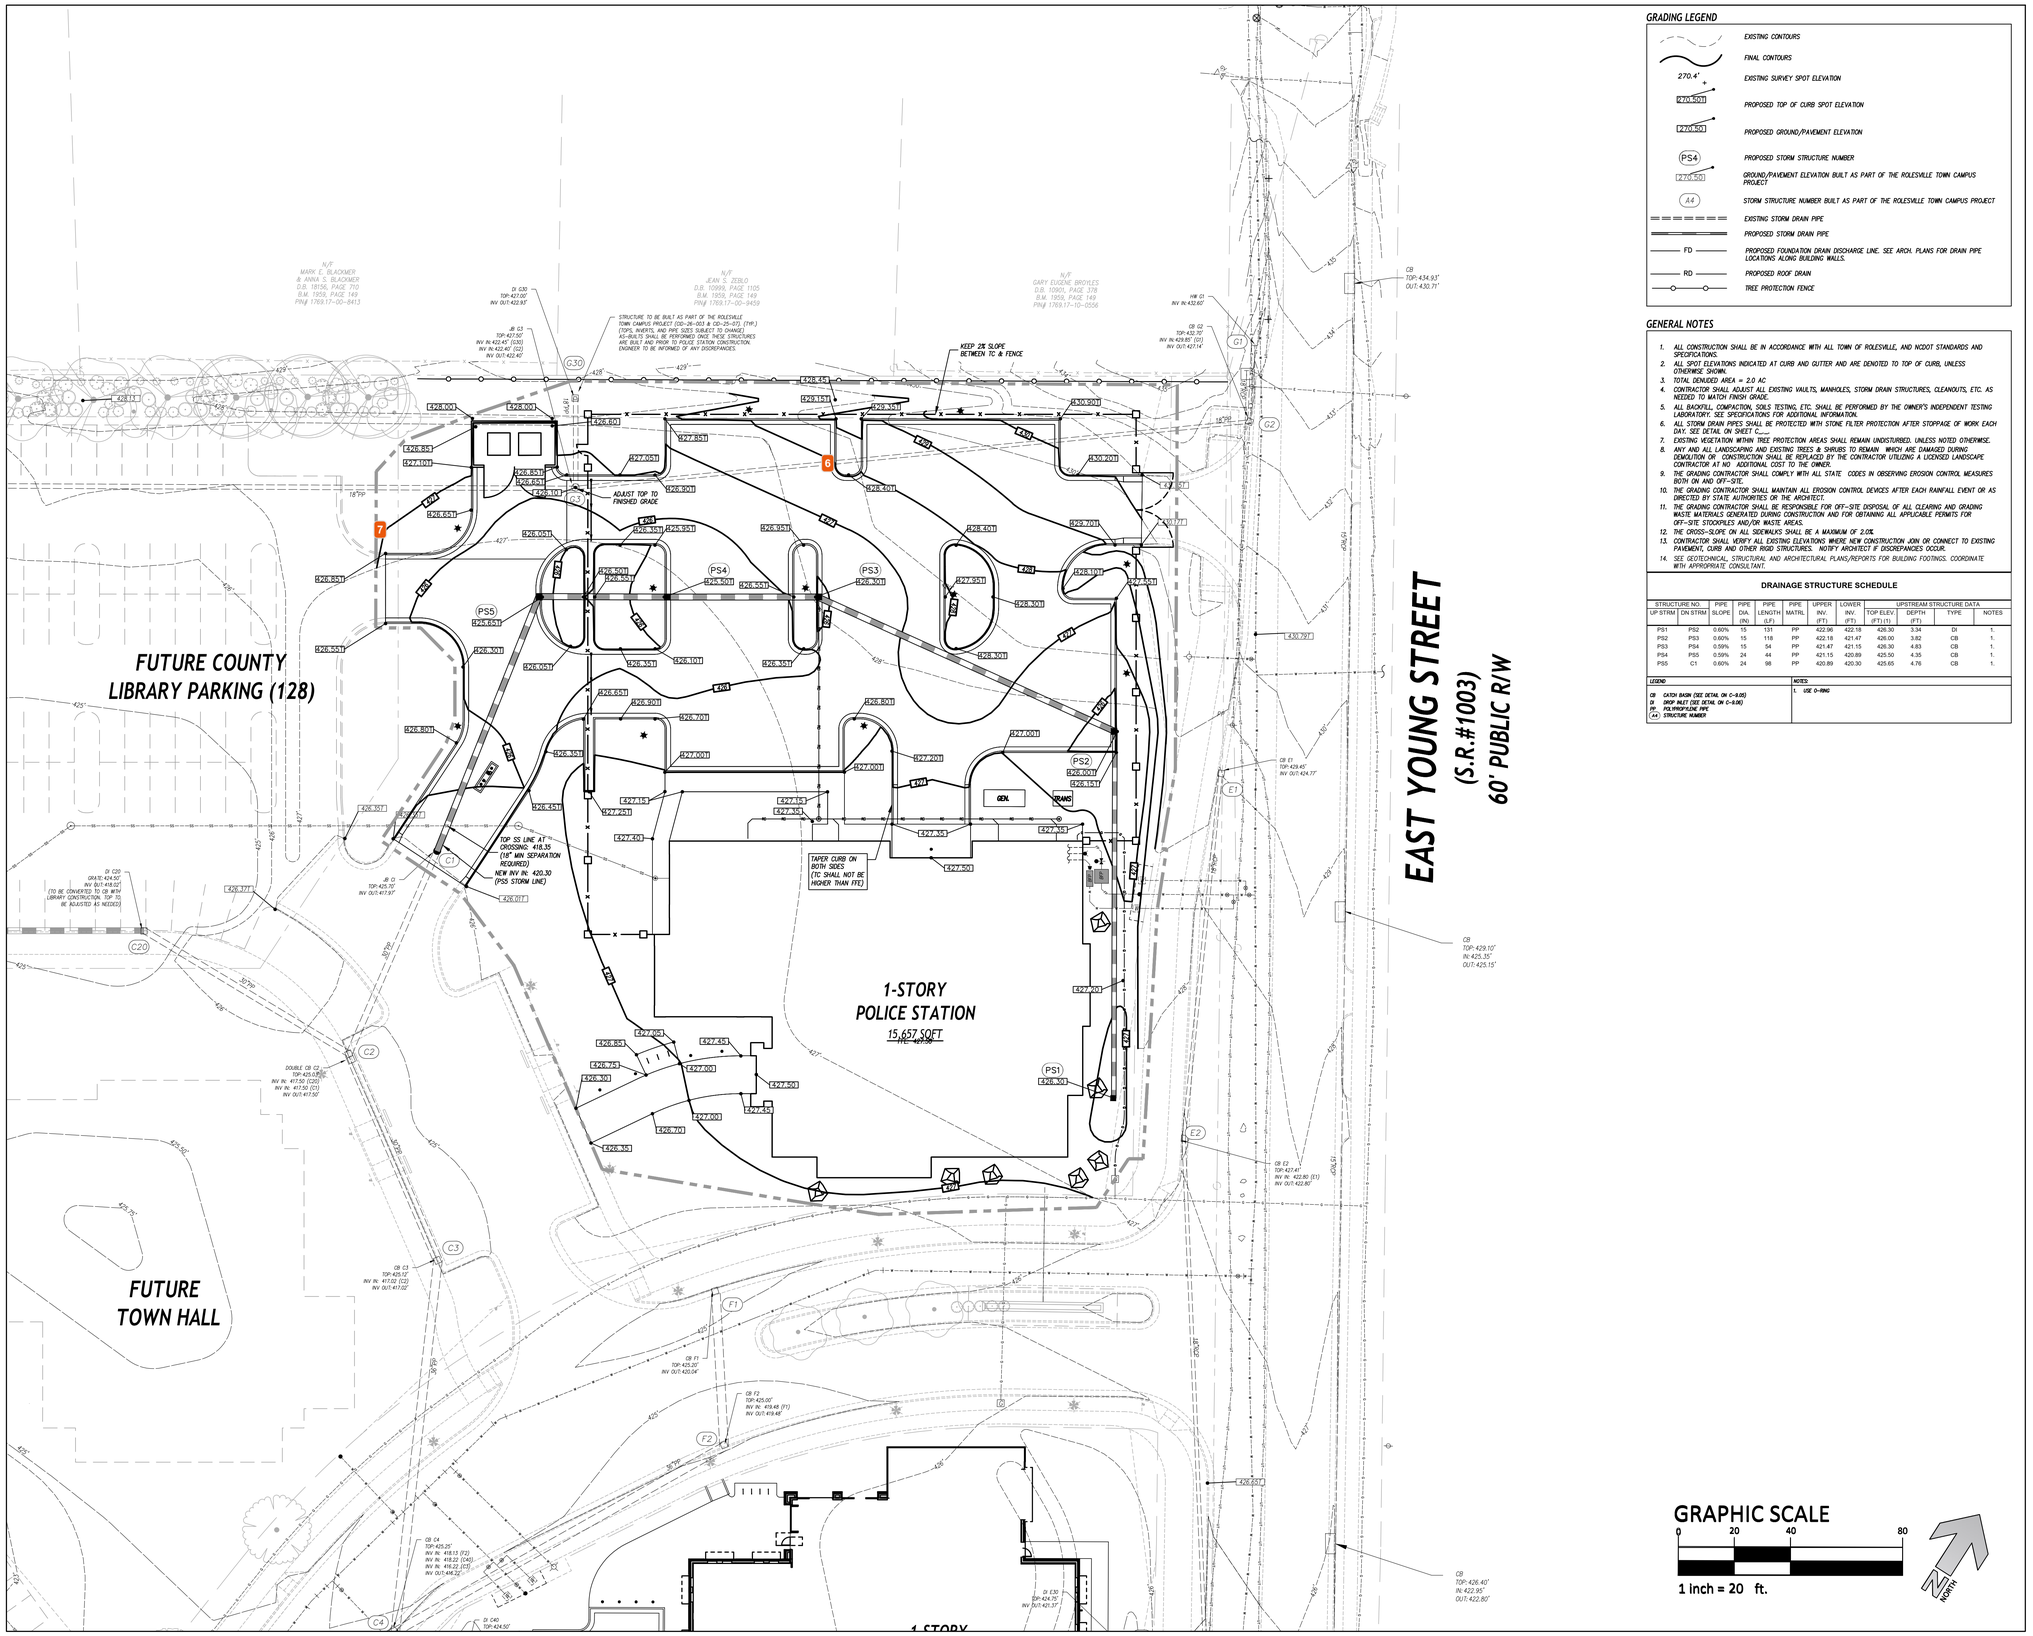

GRADING LEGEND

	EXISTING CONTOURS
	FINAL CONTOURS
270.4' +	EXISTING SURVEY SPOT ELEVATION
270.50+	PROPOSED TOP OF CURB SPOT ELEVATION
270.50+	PROPOSED GROUND/PAVEMENT ELEVATION
PS4	PROPOSED STORM STRUCTURE NUMBER
270.50+	GROUND/PAVEMENT ELEVATION BUILT AS PART OF THE ROLESVILLE TOWN CAMPUS PROJECT
A4	STORM STRUCTURE NUMBER BUILT AS PART OF THE ROLESVILLE TOWN CAMPUS PROJECT
	EXISTING STORM DRAIN PIPE
	PROPOSED STORM DRAIN PIPE
FD	PROPOSED FOUNDATION DRAIN DISCHARGE LINE. SEE ARCH. PLANS FOR DRAIN PIPE LOCATIONS ALONG BUILDING WALLS.
RD	PROPOSED ROOF DRAIN
	TREE PROTECTION FENCE

GENERAL NOTES

1. ALL CONSTRUCTION SHALL BE IN ACCORDANCE WITH ALL TOWN OF ROLESVILLE, AND NCDOT STANDARDS AND SPECIFICATIONS.
2. ALL SPOT ELEVATIONS INDICATED AT CURB AND GUTTER AND ARE DENOTED TO TOP OF CURB, UNLESS OTHERWISE SHOWN.
3. TOTAL DENUDED AREA = 2.0 AC
4. CONTRACTOR SHALL ADJUST ALL EXISTING VAULTS, MANHOLES, STORM DRAIN STRUCTURES, CLEANOUTS, ETC. AS NEEDED TO MATCH FINISH GRADE.
5. ALL BACKFILL, COMPACTION, SOILS TESTING, ETC. SHALL BE PERFORMED BY THE OWNER'S INDEPENDENT TESTING LABORATORY. SEE SPECIFICATIONS FOR ADDITIONAL INFORMATION.
6. ALL STORM DRAIN PIPES SHALL BE PROTECTED WITH STONE FILTER PROTECTION AFTER STOPPAGE OF WORK EACH DAY. SEE DETAIL ON SHEET C___
7. EXISTING VEGETATION WITHIN TREE PROTECTION AREAS SHALL REMAIN UNDISTURBED. UNLESS NOTED OTHERWISE.
8. ANY AND ALL LANDSCAPING AND EXISTING TREES & SHRUBS TO REMAIN WHICH ARE DAMAGED DURING DEMOLITION OR CONSTRUCTION SHALL BE REPLACED BY THE CONTRACTOR UTILIZING A LICENSED LANDSCAPE CONTRACTOR AT NO ADDITIONAL COST TO THE OWNER.
9. THE GRADING CONTRACTOR SHALL COMPLY WITH ALL STATE CODES IN OBSERVING EROSION CONTROL MEASURES BOTH ON AND OFF-SITE.
10. THE GRADING CONTRACTOR SHALL MAINTAIN ALL EROSION CONTROL DEVICES AFTER EACH RAINFALL EVENT OR AS DIRECTED BY STATE AUTHORITIES OR THE ARCHITECT.
11. THE GRADING CONTRACTOR SHALL BE RESPONSIBLE FOR OFF-SITE DISPOSAL OF ALL CLEARING AND GRADING WASTE MATERIALS GENERATED DURING CONSTRUCTION AND FOR OBTAINING ALL APPLICABLE PERMITS FOR OFF-SITE STOCKPILES AND/OR WASTE AREAS.
12. THE CROSS-SLOPE ON ALL SIDEWALKS SHALL BE A MAXIMUM OF 2.0%
13. CONTRACTOR SHALL VERIFY ALL EXISTING ELEVATIONS WHERE NEW CONSTRUCTION JOIN OR CONNECT TO EXISTING PAVEMENT, CURB AND OTHER RIGID STRUCTURES. NOTIFY ARCHITECT IF DISCREPANCIES OCCUR.
14. SEE GEOTECHNICAL, STRUCTURAL AND ARCHITECTURAL PLANS/REPORTS FOR BUILDING FOOTINGS. COORDINATE WITH APPROPRIATE CONSULTANT.

DRAINAGE STRUCTURE SCHEDULE

STRUCTURE NO.		PIPE	PIPE	PIPE	PIPE	UPPER	LOWER	UPSTREAM STRUCTURE DATA			
UP STRM	DN STRM	SLOPE	DIA. (IN)	LENGTH (LF)	MATRL	INV. (FT)	INV. (FT)	TOP ELEV. (FT)(1)	DEPTH (FT)	TYPE	NOTES
PS1	PS2	0.60%	15	131	PP	422.96	422.18	426.30	3.34	DI	1.
PS2	PS3	0.60%	15	118	PP	422.18	421.47	426.00	3.82	CB	1.
PS3	PS4	0.59%	15	54	PP	421.47	421.15	426.30	4.83	CB	1.
PS4	PS5	0.59%	24	44	PP	421.15	420.89	425.50	4.35	CB	1.
PS5	C1	0.60%	24	98	PP	420.89	420.30	425.65	4.76	CB	1.

LEGEND

CB CATCH BASIN (SEE DETAIL ON C-9.05)
DI DROP INLET (SEE DETAIL ON C-9.06)
PP POLYPROPYLENE PIPE
(A4) STRUCTURE NUMBER

NOTES:

1. USE D-RING

GRAPHIC SCALE

0 20 40 80

1 inch = 20 ft.

NORTH

adw architects
environments for life
architecture planning interiors
2815 coliseum centre drive
suite 500
charlotte, nc 28217
704.379.1919
adwarchitects.com

Rolesville
Genuine Community • Capital Connection
Est. 1837

ROLESVILLE POLICE

CLH DESIGN
CLH design, p.a.
400 Regency Forest Drive
Suite 120
Cary, NC 27518
Phone: 919.319.6716
LA: C-106, PE: C-1595

TOWN OF ROLESVILLE POLICE DEPARTMENT

ROLESVILLE, NC
27571

GRADING PLAN

DATE: 08-19-2026
PROJECT NO:
CLH PROJECT NO: 25-108

THIS DRAWING IS THE PROPERTY OF ADW ARCHITECTS, P.A. AND SHALL NOT BE REPRODUCED OR COPIED IN WHOLE OR PART. IT SHALL NOT BE USED ON ANY OTHER PROJECT OR GIVEN TO ANY OTHER COMPANY OR AGENCY WITHOUT THE CONSENT OF ADW ARCHITECTS, P.A.

SHEET NUMBER:
C-3.01

6 Jacqueline Thompson
REPEAT: Please clarify if there is any reverse curb - if so, please identify locations on the plans in some way.

7 Jacqueline Thompson
REPEAT: Adjust curb and pavement limits and/or grading to match.

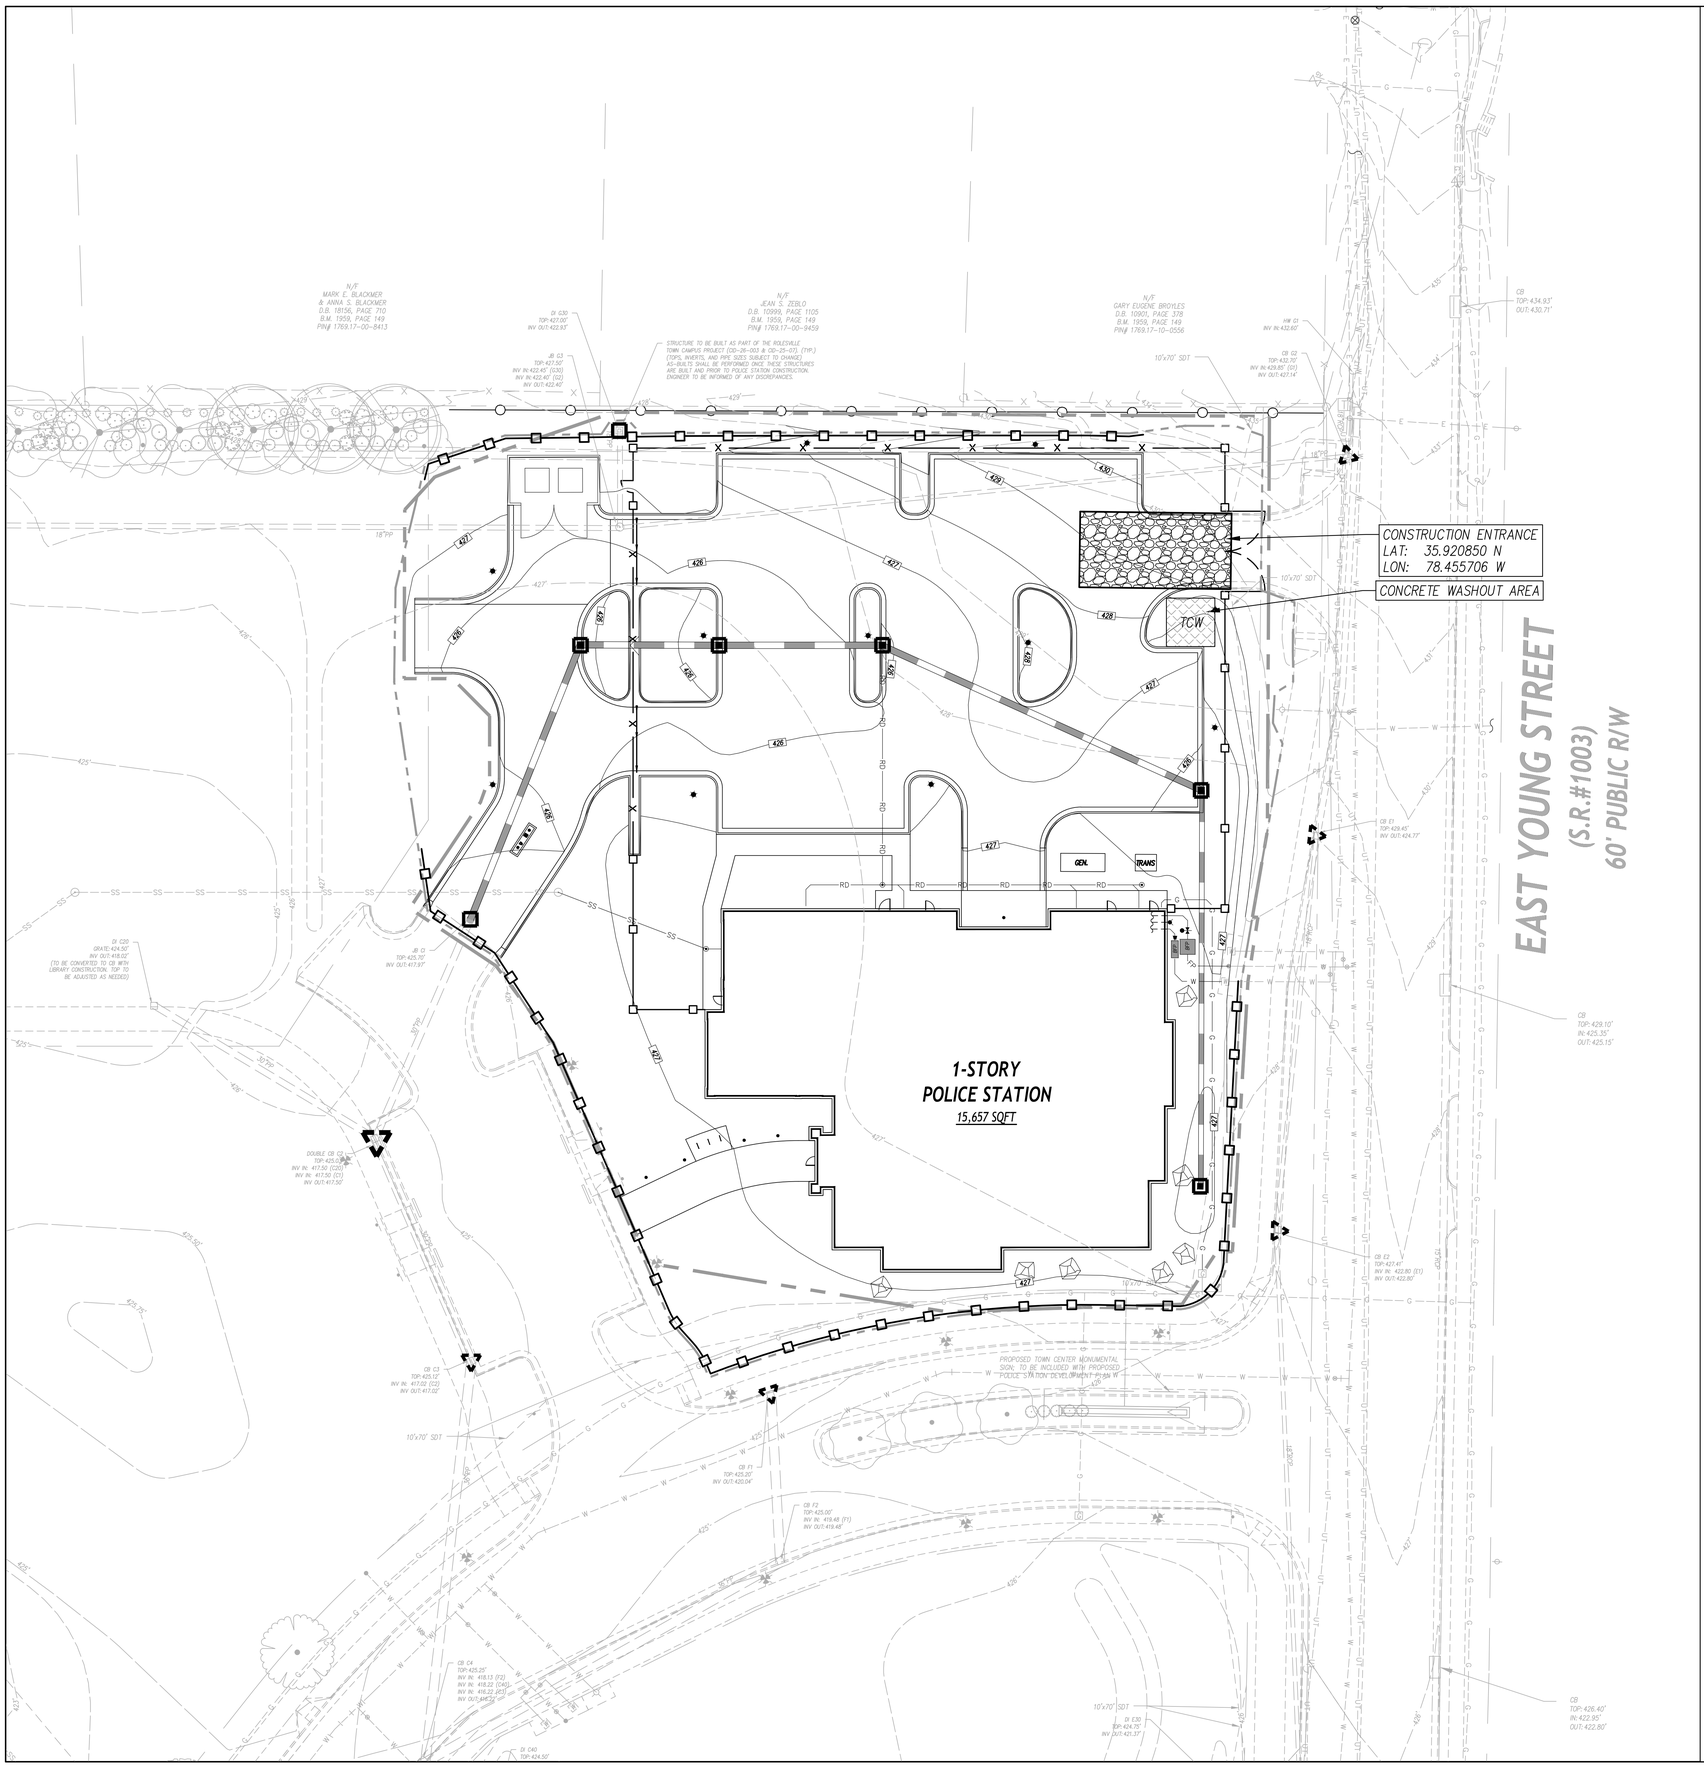

LEGEND

- GRAVEL CONSTR. ENTRANCE, SEE DETAIL SHEET ___
- TEMP. INLET PROTECTION DEVICE, SEE DETAIL SHEET ___
- TEMP. COMPOST SOCK INLET PROTECTION DEVICE, SEE DETAIL SHEET ___
- TEMP. SILT BAG INLET PROTECTION, SEE DETAIL SHEET ___
- TEMP. DIVERSION DITCH / BERM, SEE DETAIL SHEET ___
- TEMP. SILT FENCE, SEE DETAIL SHEET ___
- TEMP. REINFORCED SILT FENCE OUTLET, SEE DETAIL SHEET ___
- TEMP. J-HOOK PROTECTION, SEE DETAIL SHEET ___
- PERMANENT OUTLET PROTECTION, SEE DETAIL SHEET ___
- TCW — TEMP. CONCRETE WASHOUT AREA, SEE DETAIL SHEET ___
- TEMP. PLASTIC LINING, SEE TEMP. BASIN BAFFLES DETAIL SHEET ___
- TEMP. ROCK CHECK DAM, SEE DETAIL SHEET ___
- TEMP. COFFER DAM, SEE STREAM CROSSING/CULVERT INSTALLATION DETAIL SHEET ___
- TEMP. LEVEL SPREADER, SEE DETAIL SHEET ___
- TEMP. TIMBER/BRIDGE MAT, SEE DETAIL SHEET ___
- TEMP. EXCAVATED INLET, SEE DETAIL SHEET ___
- TSSB — TEMP. SKIMMER SEDIMENT BASIN, SEE DETAIL SHEET ___
- B — TEMP. BAFFLES, SEE DETAIL SHEET ___
- EXISTING CONTOUR
- FINISHED CONTOUR
- TEMP. CONTOUR (TEMP. GRADES DURING CONSTR.)
- TEMP. ROCK PIPE INLET PROTECTION, SEE DETAIL SHEET ___
- CHANNEL LINING, SEE DETAIL SHEET ___
- TEMPORARY SLOPE MATTING SLOPES 6:1 OR STEEPER
- TEMP. DEWATERING SILT BAG, SEE DETAIL SHEET ___
- TREE PROTECTION FENCE, SEE DETAIL SHEET ___
- TEMP. COMPOST SOCK, SEE DETAIL SHEET ___
- TEMP. COMPOST SOCK IN CHANNEL, SEE DETAIL SHEET ___
- TSD — TEMP. SLOPE DRAIN, SEE DETAIL SHEET ___
- PROPOSED STORM SEWER PIPES
- EXISTING STORM SEWER PIPES
- CONSTRUCTION LIMITS UNLESS OTHERWISE NOTED.
- REINFORCED SILT FENCE OUTLET W/ STORAGE, SEE DETAIL SHEET ___
- TRACK-OUT MAT CONSTRUCTION ENTRANCE, SEE DETAIL SHEET ___

GENERAL NOTES

1. ALL CONSTRUCTION SHALL BE IN ACCORDANCE WITH ALL WAKE COUNTY, NCDEQ, AND NCDOT STANDARDS, SPECIFICATIONS AND DETAILS.
2. THE CONTRACTOR SHALL COMPLY WITH ALL STATE AND LOCAL CODES IN OBSERVING EROSION CONTROL MEASURES BOTH ON AND OFF SITE. ALL OFF-SITE SOIL BORROW AND WASTE SITES SHALL BE PROPERLY PERMITTED FOR SUCH ACTIVITIES. CONTRACTOR SHALL PROVIDE WRITTEN DOCUMENTATION OF SEDIMENT & EROSION CONTROL PERMIT FOR ANY OFF-SITE SITES TO OWNER PRIOR TO RELOCATING ANY STOCKPILE MATERIALS.
3. THE CONTRACTOR SHALL MAINTAIN ALL EROSION CONTROL DEVICES AFTER EACH RAINFALL EVENT OR AS DIRECTED BY LOCAL AUTHORITIES OR ARCHITECT.
4. TOTAL DISTURBED AREA: 2.0 AC.
5. ALL OPEN STORM PIPES SHALL BE PROTECTED WITH STONE FILTER PROTECTION AFTER WORK STOPPAGE EACH DAY. SEE DETAIL SHEET ___.
6. ALL STORM DRAINAGE PIPES SHALL BE THOROUGHLY FLUSHED OF ALL SEDIMENT FOLLOWING SITE STABILIZATION. INTERIOR FLUSHING OF SYSTEM SHALL BE PERFORMED AS NEEDED TO MAINTAIN PROPER FUNCTIONING OF THE DRAINAGE SYSTEM. CLEANING SHALL BE PERFORMED IN A MANNER WHICH PREVENTS SEDIMENT FROM BEING FLUSHED THROUGH PIPES TO THE EXISTING DRAINAGE SYSTEM.
7. THE INDICATED STAGING AREA IS INTENDED FOR VEHICLES AND NON-ERODIBLE MATERIALS ONLY. NO SOIL, SAND OR OTHER ERODIBLE, FINE GRAINED MATERIAL SHALL BE STORED OUTSIDE OF THE LIMITS OF THE SITE PROTECTED BY SEDIMENT AND EROSION CONTROL DEVICES AND MEASURES.
8. SOIL AND OTHER MATERIALS SHALL ONLY BE TEMPORARILY STOCKPILED WITHIN THE CONSTRUCTION LIMITS PROTECTED BY SEDIMENT AND EROSION CONTROL DEVICES AND MEASURES. STOCKPILES SHALL BE STABILIZED AS REQUIRED AS INDICATED IN THE SLOPE & SURFACE STABILIZATION NOTES ON THIS PLAN.
9. THE TREE PROTECTION FENCE SHALL BE MAINTAINED ON THE SITE UNTIL ALL SITE WORK IS COMPLETED AND THE FINAL SITE INSPECTION IS SCHEDULED PRIOR TO THE ISSUANCE OF A CERTIFICATE OF OCCUPANCY (CO). THE FENCING SHALL BE REMOVED IMMEDIATELY PRIOR TO THE FINAL SITE INSPECTION FOR THE SITE.
10. TREE PROTECTION FENCING SHALL NOT BE MOVED AND THERE SHALL BE NO ENCROACHMENT INTO SUCH PROTECTED AREA(S) WITHOUT WRITTEN AUTHORIZATION OF THE COUNTY ZONING COMPLIANCE STAFF. ANY ACTIVITY (LANDSCAPING, FENCING, OR UTILITY INSTALLATION) SHOWN ON THE APPROVED PLANS IN A TREE PROTECTION AREA SHALL ALSO NOT OCCUR WITHOUT WRITTEN AUTHORIZATION FROM THE COUNTY ZONING COMPLIANCE STAFF. ANY UNAUTHORIZED ENCROACHMENT OR DISTURBANCE WITHIN THE BOUNDARIES OF A TREE PROTECTION AREA SHALL AUTOMATICALLY RESULT IN FINES AND THE REPLACEMENT OF ANY DAMAGED VEGETATION IN ACCORDANCE WITH THE LAND DEVELOPMENT ORDINANCE.
11. ROADSIDE DITCHES AND CHANNELS SHALL BE STABILIZED DAILY UNTIL PERMANENT GROUND COVER IS ESTABLISHED.
12. INSTALL TEMPORARY MATTING TO TOP OF ALL SIDE SLOPES ON CHANNELS, DIVERSION DITCHES AND TEMPORARY SEDIMENT BASINS. SEE DETAIL SHEET _____ (PERMANENT CHANNEL) AND _____ (TEMPORARY DIVERSION DITCH) FOR TYPE OF MATTING TO USE.
13. ANY DEWATERING OF SEDIMENT CONTAINMENT DEVICES FOR MAINTENANCE, REMOVAL OR CONVERSION PURPOSES IS TO BE DONE THROUGH A SILT BAG.
14. ANY DEWATERING OF STORM/UTILITY TRENCHES IS TO BE DONE THROUGH A SILT BAG.
15. GROUND COVER IS TO BE APPLIED PER CONDITIONS OF THE NPDES PERMIT OR AT THE END OF THE DAY IN CRITICAL AREAS.
16. CONTRACTOR SHALL USE TIRE WASH STATION TO PREVENT SEDIMENT FROM TRACKING ONTO THE ROAD IF CONSTRUCTION ENTRANCE IS FOUND INSUFFICIENT AT NO ADDITIONAL COST TO OWNER.
17. CONTRACTOR SHALL UTILIZE PAM FLOCCULANTS TO REDUCE RUN-OFF TURBIDITY. SEE SPECS.

MAINTENANCE PLAN

1. DURING ALL PHASES OF CONSTRUCTION, GROUNDCOVER ON EXPOSED SLOPES SHALL BE PROVIDED ACCORDING TO GROUND STABILIZATION TABLE (SHEET _____) FOLLOWING COMPLETION OF ANY PHASE OF GRADING.
2. FINAL PERMANENT GROUNDCOVER FOR ALL DISTURBED AREAS SHALL BE PROVIDED ON ALL DISTURBED AREAS ACCORDING TO GROUND STABILIZATION TABLE (SHEET _____) FOLLOWING COMPLETION OF CONSTRUCTION OR DEVELOPMENT.
3. THE ABOVE REQUIREMENTS ARE THE MINIMUM NECESSARY TO MEET EROSION AND SEDIMENT CONTROL REGULATIONS. THE CONTRACT DOCUMENTS INCLUDE ADDITIONAL SEEDING AND STABILIZATION REQUIREMENTS AND SCHEDULES WHICH MAY EXCEED THOSE ABOVE.
4. SLOPE EROSION CONTROL MATTING SHALL BE INSTALLED FOR TEMPORARY STABILIZATION DURING THE ESTABLISHMENT OF VEGETATIVE COVER ON ALL STEEP SLOPES (6:1 OR STEEPER). REFER TO MATERIAL SPECIFICATIONS. INSTALL MATTING PER MANUFACTURER'S INSTRUCTIONS.
5. ALL OTHER SEEDED AREAS SHALL BE MULCHED WITH STRAW AND TACKED WITH ASPHALT.

SELF-INSPECTION RULES

SEE SHEET _____ FOR SELF-INSPECTION REQUIREMENTS.

THE CONTRACTOR (ACTING AS AN AGENT FOR THE FINANCIALLY RESPONSIBLE PERSON) SHALL PERFORM SELF INSPECTIONS OF THE EROSION AND SEDIMENTATION CONTROL MEASURES USING NCDEMLR'S SELF INSPECTION REPORT (WORKSHEET) AND SHALL KEEP COPIES OF INSPECTION REPORTS ONSITE.

SLOPE & SURFACE STABILIZATION

GROUND STABILIZATION SHALL BE PROVIDED ON ALL DISTURBED AREAS ACCORDING TO GROUND STABILIZATION NOTES. SEE SHEET _____

EXTENSIONS OF TIME MAY BE APPROVED BY THE PERMITTING AUTHORITY BASED ON WEATHER OR OTHER SITE-SPECIFIC CONDITIONS THAT MAKE COMPLIANCE IMPRACTICABLE (SECTION II.B(2) (b)).

THE REQUIREMENTS ON SHEET _____ ARE THE MINIMUM NECESSARY TO MEET EROSION AND SEDIMENT CONTROL REGULATIONS. THE CONTRACT DOCUMENTS INCLUDE ADDITIONAL SEEDING AND STABILIZATION REQUIREMENTS AND SCHEDULES WHICH MAY EXCEED MINIMUM REQUIREMENTS.

INSTALL TEMPORARY EXCELSIOR MATTING FOR STABILIZATION DURING THE ESTABLISHMENT OF VEGETATIVE COVER ON ALL STEEP SLOPES (6:1 OR STEEPER) AND AREAS OF CONCENTRATED FLOW (CHANNELS, DITCHES, SWALES, ETC.). UTILIZE TEMPORARY COCONUT MAT IN AREAS IDENTIFIED ON PLAN. REFER TO SPECIFICATION SECTION 312500 FOR MATERIAL SPECIFICATIONS. INSTALL MATTING PER MANUFACTURER'S INSTRUCTIONS.

SEE SHEET _____ EROSION CONTROL CONSTRUCTION SEQUENCE.

SEE SHEET _____ EROSION CONTROL GROUND COVER PLAN FOR MORE INFORMATION.

adw architects
environments for life
architecture planning interiors
2815 coliseum centre drive
suite 500
charlotte, nc 28217
704.379.1919
adwarchitects.com

Rolesville
Genuine Community • Capital Connection
Est. 1837

ROLESVILLE POLICE

CLH DESIGN
CLH design, p.a.
400 Regency Forest Drive
Suite 120
Cary, NC 27518
Phone: 919.319.6716
LA: C-106, PE: C-1595

TOWN OF ROLESVILLE POLICE DEPARTMENT

ROLESVILLE, NC 27571

EROSION CONTROL PLAN

DATE: 08-19-2026
PROJECT NO:
CLH PROJECT NO: 25-108

THIS DRAWING IS THE PROPERTY OF ADW ARCHITECTS, P.A. AND SHALL NOT BE REPRODUCED OR COPIED IN WHOLE OR PART. IT SHALL NOT BE USED ON ANY OTHER PROJECT OR GIVEN TO ANY OTHER COMPANY OR AGENCY WITHOUT THE CONSENT OF ADW ARCHITECTS, P.A.

SHEET NUMBER:
C-4.01

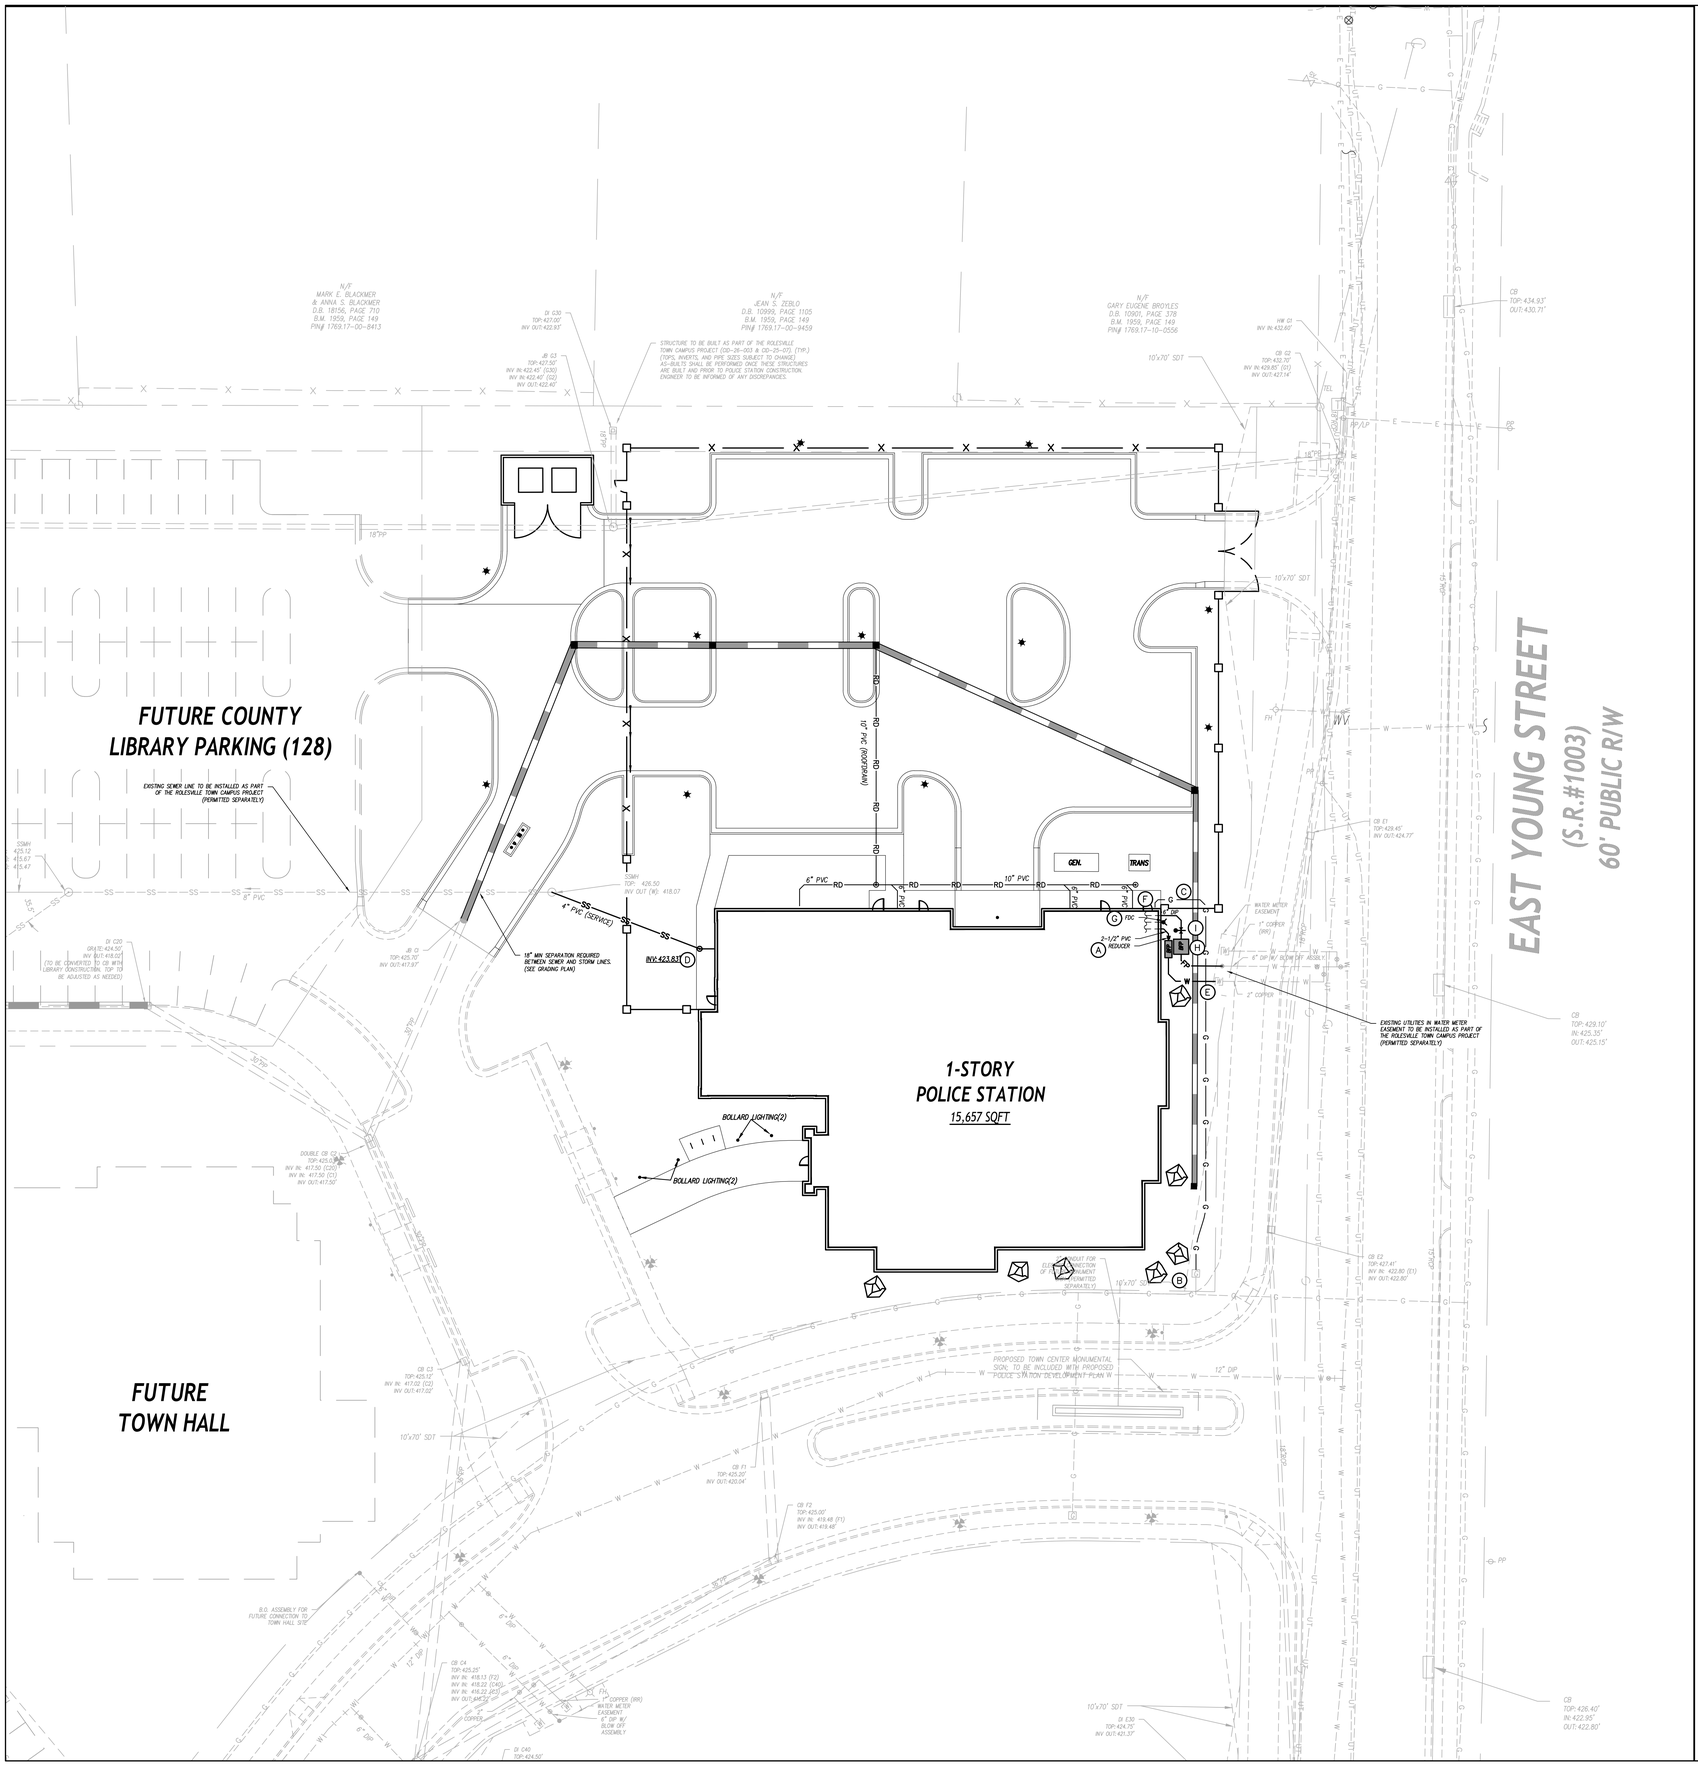

UTILITY LEGEND

	EXISTING	PROPOSED
CHILLED WATER	CW	CW
ELECTRICAL (OVERHEAD)	E	E
ELECTRICAL (UNDERGROUND)	UE	UE
FOUNDATION DRAIN	FD	FD
GAS	G	G
SANITARY SEWER	SS	SS
TELEPHONE (OVERHEAD)	T	T
TELEPHONE (UNDERGROUND)	UT	UT
WATER	W	W
ROOF DRAIN	RD	RD
FIRE PROTECTION	FP	FP
STORM DRAIN		
TREE PROTECTION FENCING, SEE EROSION CONTROL PLANS		
LIGHT POLE	LP	
UTILITY POLE	PP	
MANHOLE	MH	
CLEAN OUT	CO	
DROP INLET,CATCH BASIN	DI, CB	
FIRE HYDRANT	FH	
WATER VALVE	WV	
POST INDICATOR VALVE (PIV)		
FIRE DEPARTMENT CONNECTION (FDC)		
THRUST BLOCKING		
SANITARY SEWER STRUCTURE IDENTIFICATION		1

GENERAL NOTES-UTILITY

1. ALL CONSTRUCTION SHALL BE IN ACCORDANCE WITH ALL TOWN OF ROLESVILLE, CITY OF RALEIGH, AND NCDOT STANDARDS, SPECIFICATIONS AND DETAILS.
2. INSTALL WATERMAINS WITH A COVER OF NO LESS THAN 3-FT.
3. INSTALL SEWER MAINS WITH A COVER OF NO LESS THAN 3-FT TO FINISH GRADE IN NON-TRAFFIC AREAS, 4-FT TO FINISH GRADE IN TRAFFIC AREAS.
4. INSTALL ALL UTILITIES TO PROVIDE REQUIRED CLEARANCES AS INDICATED IN THE SPECIFICATIONS.
5. WATERLINES AND SEWER MAINS SHALL BE INSTALLED WITH A MINIMUM HORIZONTAL CLEARANCE OF 10-FT.
6. SEWER MAINS SHALL BE INSTALLED WITH A MINIMUM VERTICAL CLEARANCE OF 24-IN TO STORM DRAINAGE PIPES.
7. COORDINATE AND SCHEDULE INSTALLATION OF ALL UTILITIES WITH OTHER PRIME CONTRACTORS, UTILITY COMPANIES AND OTHER TRADES INCLUDING BUT NOT LIMITED TO: NATURAL GAS, ELECTRICITY, TELEPHONE AND CATV.
8. VERIFY EXISTING CONDITIONS AND CONNECTIONS TO EXISTING UTILITIES PRIOR TO CONSTRUCTION. NOTIFY ARCHITECT IF ANY DISCREPANCIES ARE DISCOVERED.
9. CONTRACTOR IS RESPONSIBLE FOR ALL DAMAGES DURING CONSTRUCTION AND SHALL MAKE REPAIRS AT NO EXPENSE TO THE OWNER.
10. ALL CONSTRUCTION SHALL COMPLY WITH ALL APPLICABLE NCSBC AND OSHA REQUIREMENTS.
11. THE CONTRACTOR SHALL PROVIDE AN AS-BUILT SURVEY OF ALL UTILITY AND STORM DRAINAGE IMPROVEMENTS FOLLOWING CONSTRUCTION, SEE SPECS FOR ALL AS-BUILT REQUIREMENTS.
12. CONTRACTOR SHALL PHASE DEMOLITION AND NEW CONSTRUCTION TO ENSURE UNINTERRUPTED ACCESS AND UTILITY SERVICE TO ADJACENT FACILITIES. COORDINATE SHORT-TERM, OFF-HOUR, TEMPORARY SHUT- DOWNS WITH THE OWNER.
13. SEE GENERAL NOTES ON EXISTING CONDITIONS AND DEMOLITION PLAN FOR REQUIREMENTS FOR REMOVAL AND PATCHING OF PAVEMENT FOR UTILITY INSTALLATION.
14. ALL ROOF DRAINS SHALL BE 6" PVC (SCH 40) @ 1.04% MIN. SLOPE UNLESS INDICATED OTHERWISE. USE DUCTILE IRON WHEN COVER IS LESS THAN 24-IN.
15. ALL SANITARY SEWER SERVICES SHALL BE 4" PVC (SCH 40) @1.04% MIN. SLOPE UNLESS INDICATED OTHERWISE. USE DUCTILE IRON WHEN COVER IS LESS THAN 24-IN.
16. ALL CONDENSATE LINES SHALL BE CONNECTED TO STORM DRAINAGE SYSTEM.
17. NO WORK SHALL BE PERFORMED ON RIGHT-OF-WAYS OR ADJACENT PROPERTIES UNTIL THE OWNER NOTIFIES CONTRACTOR IN WRITING OF PROCUREMENT OF APPROPRIATE PERMITS, EASEMENTS, AGREEMENTS, OR RIGHTS-OF-WAY.
18. SEE UTILITY DETAILS SHEETS FOR CITY OF RALEIGH STANDARD UTILITY NOTES AND DETAILS.

KEY NOTES

- (A) 2.0-IN ZURN-WILKINS MODEL 975XL2 OR APPROVED EQUIVAMENT BACKFLOW PREVENTER (BFP) WITHIN HEATED ENCLOSURE, SEE DETAIL SHEET C-9.02. SEE ELECTRICAL PLANS FOR ADDITIONAL INFORMATION.
- (B) APPROXIMATE LOCATION GAS METER AND GAS SERVICE LINES. SEE MECHANICAL PLANS FOR ADDITIONAL INFORMATION.
- (C) 2 PSI NATURAL GAS SERVICE LINE. SEE MEP PLANS FOR ADDITIONAL INFORMATION. GC TO COORDINATE WITH UTILITY PROVIDER.
- (D) NEW SANITARY SEWER CLEANOUT, TYP. SEE DETAIL SHEET C-9.03.
- (E) CONNECT TO EXISTING 2.0-IN WATER METER.
- (F) EXTEND UTILITY TO WITHIN 5'-0" OF BUILDING WALL OR AS INDICATED ON PLUMBING PLANS. REFER TO PLUMBING PLANS FOR LOCATION AND INVERTS.
- (G) FIRE DEPARTMENT CONNECTION ON BUILDING, SEE MEP PLANS FOR DETAILS.
- (H) 6-IN ZURN-WILKINS MODEL 375 REDUCED PRESSURE BACKFLOW ASSEMBLY (RPA) WITHIN HEATED ENCLOSURE, SEE DETAIL SHEET C-9.02. SEE ELECTRICAL PLANS FOR ADDITIONAL INFORMATION.
- (I) POST INDICATOR VALVE W/ TAMPER SWITCH, SEE DETAIL SHEET C-9.02 AND SPECIFICATIONS. SEE ELECTRICAL PLANS FOR ADDITIONAL INFORMATION.

GRAPHIC SCALE

0 20 40 80

1 inch = 20 ft.

NORTH

adw architects
environments for life
architecture planning interiors
2815 coliseum centre drive
suite 500
charlotte, nc 28217
704.379.1919
adwarchitects.com

Rolesville
Genuine Community • Capital Connection
Est. 1837

ROLESVILLE POLICE

CLH DESIGN
CLH design, p.a.
400 Regency Forest Drive
Suite 120
Cary, NC 27518
Phone: 919.319.6716
LA: C-106, PE: C-1595

TOWN OF ROLESVILLE POLICE DEPARTMENT

ROLESVILLE, NC
27571

UTILITY PLAN

DATE: 08-19-2026
PROJECT NO:
CLH PROJECT NO: 25-108

THIS DRAWING IS THE PROPERTY OF ADW ARCHITECTS, P.A. AND SHALL NOT BE REPRODUCED OR COPIED IN WHOLE OR PART. IT SHALL NOT BE USED ON ANY OTHER PROJECT OR GIVEN TO ANY OTHER COMPANY OR AGENCY WITHOUT THE CONSENT OF ADW ARCHITECTS, P.A.

SHEET NUMBER:
C-5.01

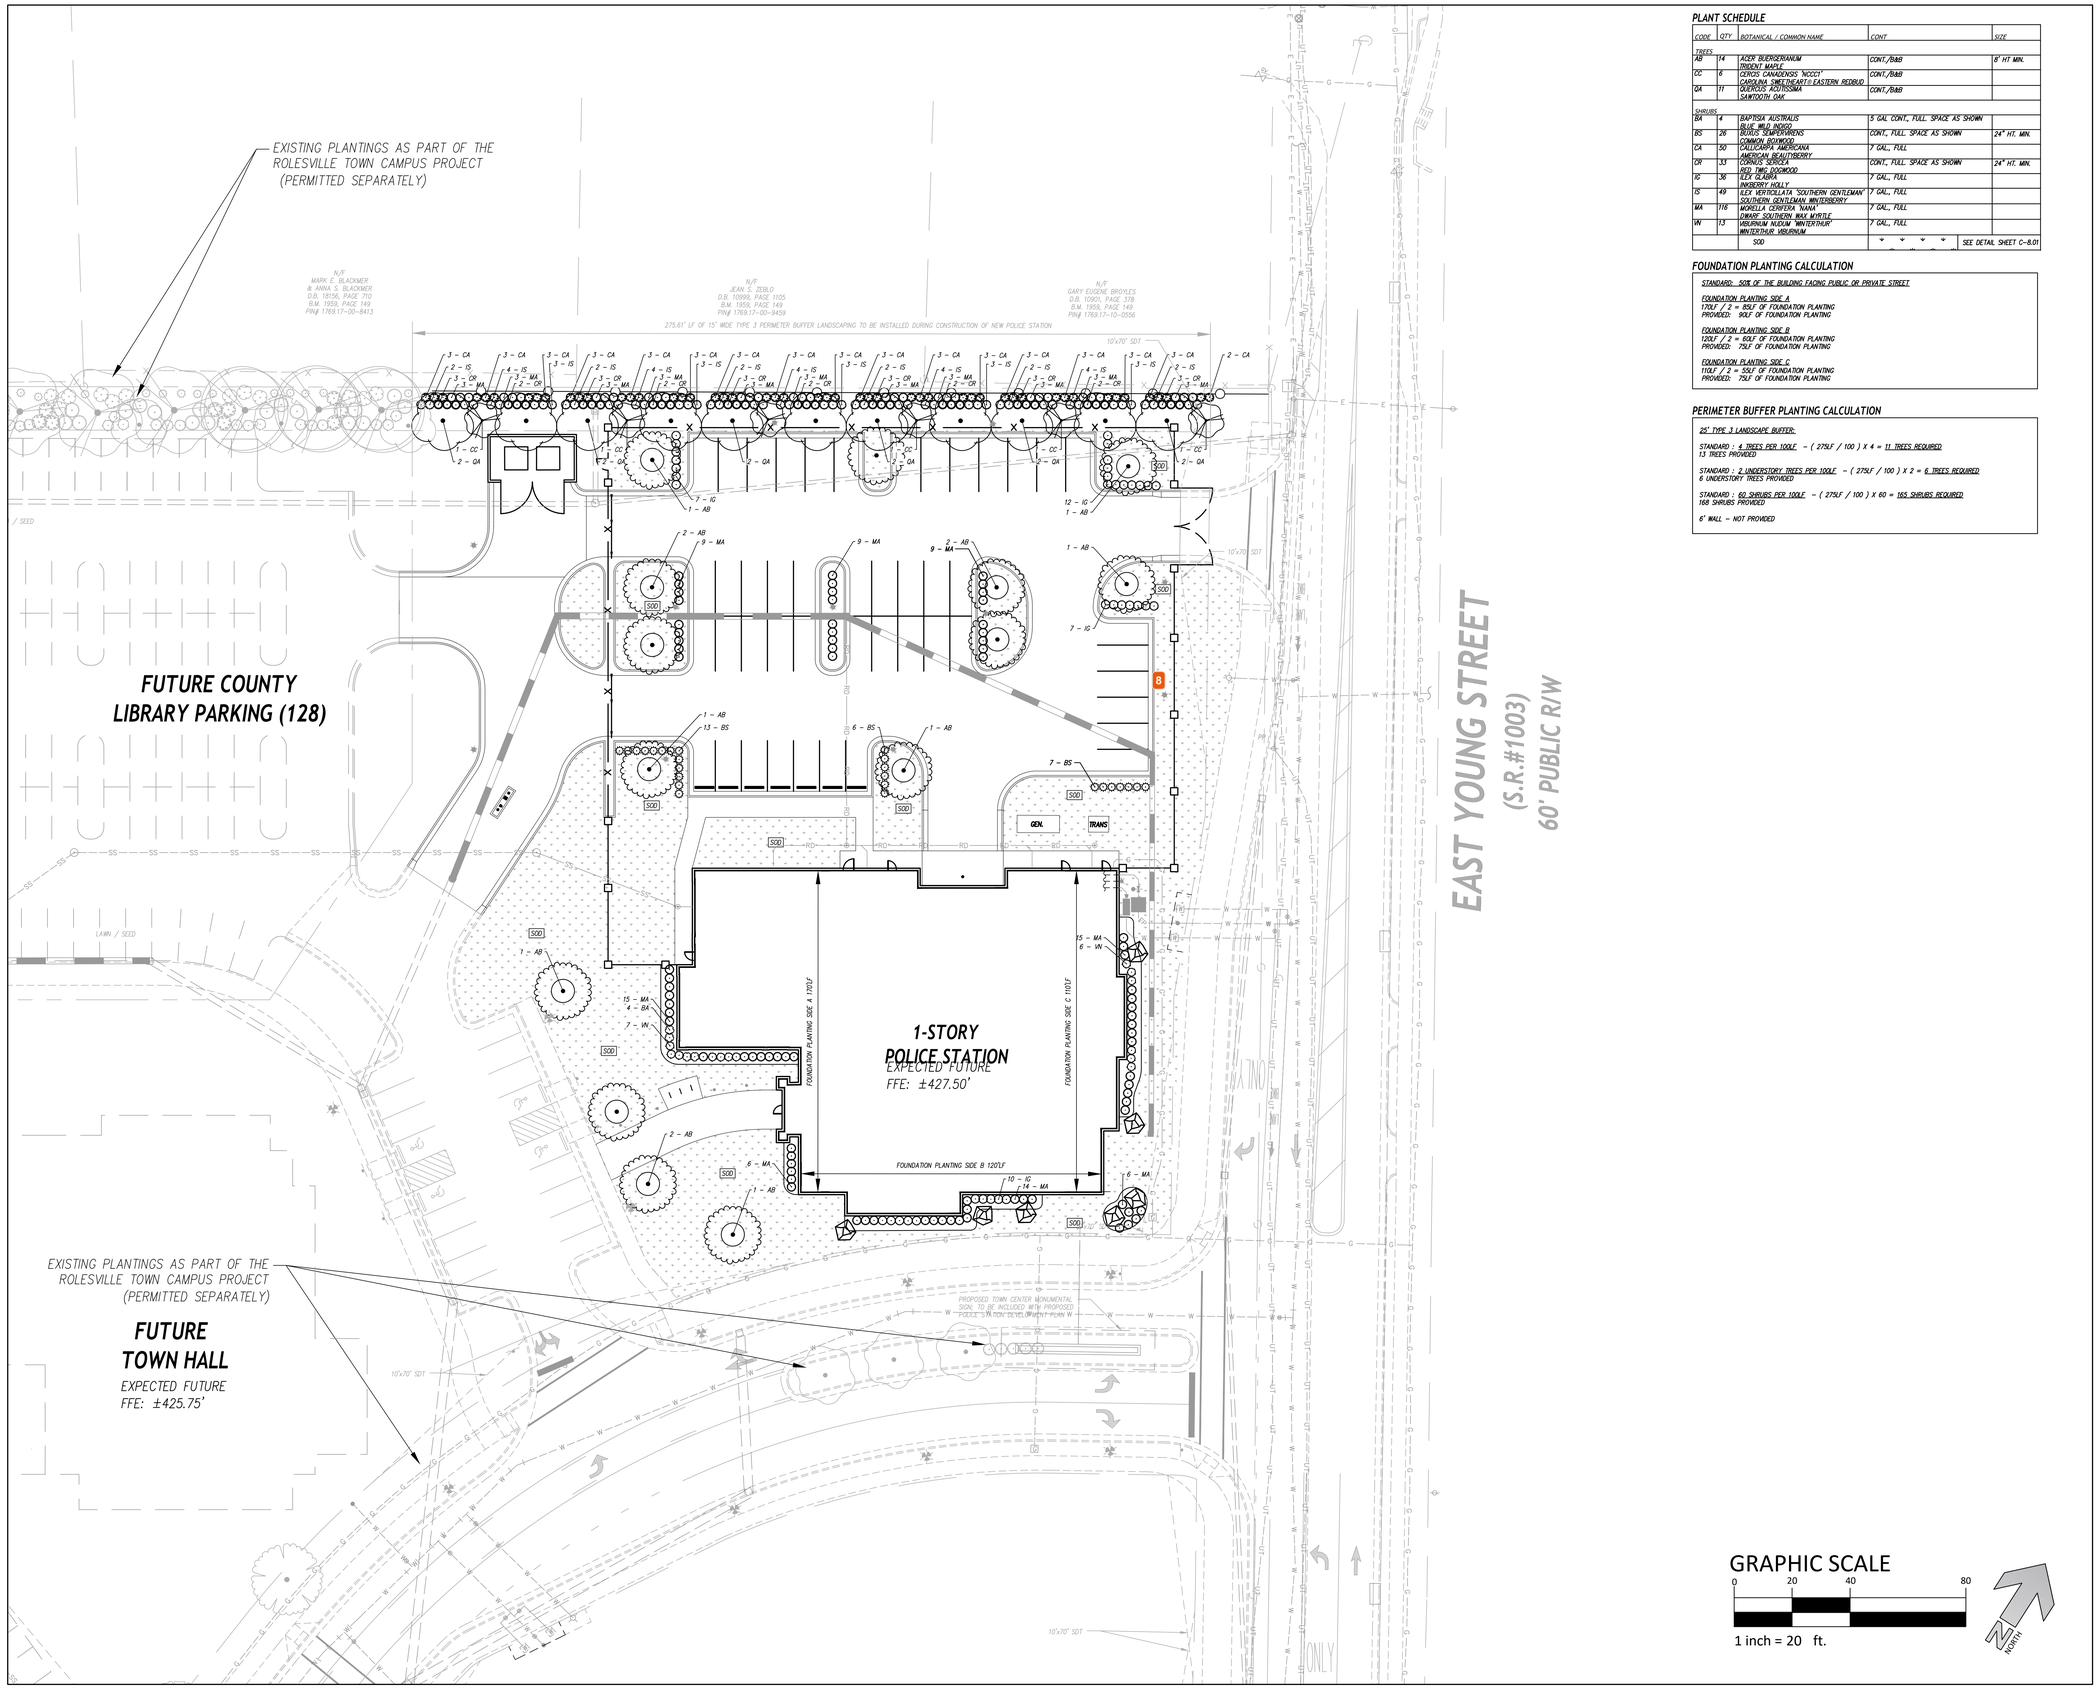

PLANT SCHEDULE

CODE	QTY	BOTANICAL / COMMON NAME	CONT.	SIZE
TREES:				
CC	6	CERCIS CANADENSIS 'NCCC1' CAROLINA SWEETHEART® EASTERN REDBUD	CONT./B&B	
QA	11	QUERCUS ACUTISSIMA SAWTOOTH OAK	CONT./B&B	
SHRUBS:				
BA	4	BAPTISIA AUSTRALIS BLUE WILD INDIGO	5 GAL CONT., FULL SPACE AS SHOWN	
BS	26	BUXUS SEMPERVIRENS COMMON BOXWOOD	CONT., FULL SPACE AS SHOWN	24" HT. MIN.
CA	50	CALLICARPA AMERICANA AMERICAN BEAUTYBERRY	7 GAL., FULL	
CR	33	CORNUS SERICEA RED TWIG DOGWOOD	CONT., FULL SPACE AS SHOWN	24" HT. MIN.
IG	36	ILEX GLABRA INKBERRY HOLLY	7 GAL., FULL	
IS	49	ILEX VERTICILLATA 'SOUTHERN GENTLEMAN' SOUTHERN GENTLEMAN WINTERBERRY	7 GAL., FULL	
MA	116	MORELLA CERIFERA 'NANA' DWARF SOUTHERN WAX MYRTLE	7 GAL., FULL	
VN	13	VIBURNUM NUDUM 'WINTERTHUR' WINTERTHUR VIBURNUM	7 GAL., FULL	
		SOD		SEE DETAIL SHEET C-8.01

FOUNDATION PLANTING CALCULATION

STANDARD: 50% OF THE BUILDING FACING PUBLIC OR PRIVATE STREET

FOUNDATION PLANTING SIDE A
170LF / 2 = 85LF OF FOUNDATION PLANTING
PROVIDED: 90LF OF FOUNDATION PLANTING

FOUNDATION PLANTING SIDE B
120LF / 2 = 60LF OF FOUNDATION PLANTING
PROVIDED: 75LF OF FOUNDATION PLANTING

FOUNDATION PLANTING SIDE C
110LF / 2 = 55LF OF FOUNDATION PLANTING
PROVIDED: 75LF OF FOUNDATION PLANTING

PERIMETER BUFFER PLANTING CALCULATION

25' TYPE 3 LANDSCAPE BUFFER:

STANDARD : 4 TREES PER 100LF = (275LF / 100) X 4 = 11 TREES REQUIRED
13 TREES PROVIDED

STANDARD : 2 UNDERSTORY TREES PER 100LF = (275LF / 100) X 2 = 6 TREES REQUIRED
6 UNDERSTORY TREES PROVIDED

STANDARD : 60 SHRUBS PER 100LF = (275LF / 100) X 60 = 165 SHRUBS REQUIRED
168 SHRUBS PROVIDED

6' WALL - NOT PROVIDED

adw architects
environments for life
architecture planning interiors
2815 coliseum centre drive
suite 500
charlotte, nc 28217
704.379.1919
adwarchitects.com

Rolesville
Genuine Community • Capital Connection
Est. 1837

ROLESVILLE POLICE

CLH DESIGN
CLH design, p.a.
400 Regency Forest Drive
Suite 120
Cary, NC 27518
Phone: 919.319.6716
LA: C-106, PE: C-1595

TOWN OF ROLESVILLE POLICE DEPARTMENT

ROLESVILLE, NC 27571

LANDSCAPE PLAN

DATE: 06-22-2026
PROJECT NO:
CLH PROJECT NO: 25-108

THIS DRAWING IS THE PROPERTY OF ADW ARCHITECTS, P.A. AND SHALL NOT BE REPRODUCED OR COPIED IN WHOLE OR PART. IT SHALL NOT BE USED ON ANY OTHER PROJECT OR GIVEN TO ANY OTHER COMPANY OR AGENCY WITHOUT THE CONSENT OF ADW ARCHITECTS, P.A.

SHEET NUMBER:
C-6.01

8 **Stephen Wensman**
Parking Perimeter Plantings required here.

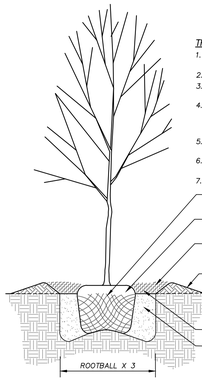

TREE PLANTING

TREE PLANTING NOTES:

1. SEE SPECIFICATION SECTION 329000 FOR ADDITIONAL INFORMATION NOT NOTED ON DETAILS
2. TREE PLANTING TO MEET ALL LOCAL CODE/RULES.
3. MARK THE NORTH SIDE OF THE TREE IN THE NURSERY AND LOCATE TO THE NORTH IN THE FIELD.
4. IF TREE WRAPS ARE PROVIDED ENSURE TO START AT SECOND BRANCH. TIE SECURELY AT TOP, BOTTOM, AND AT 2' INTERVALS. ALL TREE WRAPS TO BE REMOVED UPON PROJECT FINAL COMPLETION.
5. PLEASE REFER TO SPEC 329000 SECTION FOR ALL WARRANTY REQUIREMENTS.
6. TREE STAKING TO BE PROVIDED ON 3:1 SLOPES AND/OR AREAS OF HIGH WINDS.
7. DO NOT PRUNE OR CUT LEADERS.

REMOVE TOP 1/3 OF WIRE BASKET WHERE PRESENT. REMOVE FROM PIT
TOP OF ROOT BALL AT FINISHED GRADE. REMOVE BURLAP AND TWINE FROM TOP 1/3 OF ROOT BALL.
MULCH SEE LANDSCAPE NOTES. – KEEP MULCH FROM ROOT FLARE. NO MULCH SHALL CONTACT TREE TRUNK
6" EARTH SAUCER
FINISHED GRADE
PREPARED & MULCHED PLANT BED OR PREPARED LAWN AREA
SOIL BACKFILL MIXTURE 1 PART GROUND PINE BARK TO 6 PARTS SOIL WITH 8–8–8 FERT.MIXED IN AT 1 LB/100 S.F. (NO FERTILIZER ON BURFORD HOLLIES)

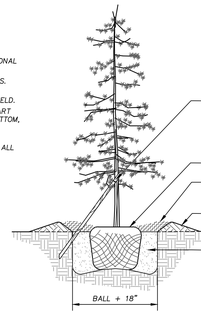

EVERGREEN PLANTING

EVERGREEN PLANTINGS NOTES:
PLANT PITS ONLY FOR SINGLE PLANTS. FOR OTHER PLANTING PREPARE THE ENTIRE BED AREA
2" x 2" STAKE
18" MIN. ABOVE GRADE @ 45° ANGLE STRING OR THIN CORD LOOSELY TIED MUST ROT AWAY WITHIN TWO YEARS 12" MIN BELOW GRADE
TOP OF ROOT BALL AT FINISHED GRADE.
MULCH SEE LANDSCAPE NOTES. – KEEP MULCH FROM ROOT FLARE. NO MULCH SHALL CONTACT TREE TRUNK
4" EARTH SAUCER
FINISHED GRADE
SOIL BACKFILL MIXTURE 1 PART GROUND PINE BARK TO 6 PARTS SOIL WITH 8–8–8 FERT.MIXED IN AT 1 LB/100 S.F.

SOD MAINTENANCE NOTES:

1. CONTRACTOR SHALL BE RESPONSIBLE FOR SOD MAINTENANCE UNTIL FINAL COMPLETION.
2. PLEASE REFER TO SPEC 329000 FOR ALL SOD INSTALLATION REQUIREMENT, WARRANTEES AND MAINTENANCE TILL FINAL COMPLETION
3. CONTRACTOR MUST MEET 95% SOD ESTABLISHMENT FOR FINAL COMPLETION. REFER TO SPEC 329000 SECTION 1.9 & 1.12 FOR ALL APPLICABLE REQUIREMENTS.
4. SOD INSTALLED INSTALLED OUTSIDE GROWING SEASON WILL NEED TO MEET THE FOLLOWING SECTION 329000 SECTIONS 1.9 & 1.12
5. PLEASE REFER TO SPEC 329000 SECTION 1.10 FOR ALL WARRANTY REQUIREMENTS.
6. CONTRACTOR IS RESPONSIBLE FOR REGULAR MOWING AND FOR FURNISHING AND APPLYING ADEQUATE WATER TO THE INSTALLED SOD UNTIL PROJECT FINAL COMPLETION BUT NO LESS THAN 4–WEEKS FOLLOWING SOD INSTALLATION
7. WATERING SHALL BE MONITORED TO ENSURE PROPER RATES ARE APPLIED. OVER–WATERING SHALL BE AVOIDED.
8. DEAD OR DYING SOD SHALL BE REPLACED PRIOR TO OWNER'S ACCEPTANCE.

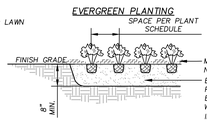

GROUNDCOVER PLANTING

REMOVE NETTING PRIOR TO INSTALLATION

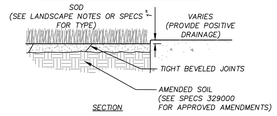

SECTION

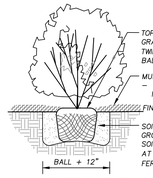

SHRUB PLANTING

MULCH NOTES:
EDGE TO BE APPLIED TO ALL PLANTING BEDS.

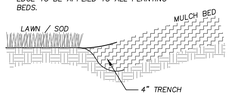

PLANTING BED EDGE

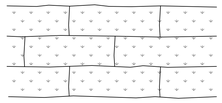

PLAN

SOD INSTALLATION

PLANTING / LANDSCAPING DETAIL

N.T.S.

GENERAL NOTES:

1. PROVIDE GROOVE CONTROL JOINT 1–IN DEEP WITH 1/8–IN RADII IN EDGING AT 10' INTERVALS UNLESS INDICATED OTHERWISE.
2. PROVIDE 1/2–IN WIDE EXPANSION JOINT AT 50' INTERVALS AND WHERE EDGING ABUTS ANY RIGID PAVEMENT AND/OR STRUCTURE.
3. ALL CONCRETE SHALL BE 4,000 P.S.I.
4. SURFACE SHALL RECEIVE FINE BROOM FINISH.

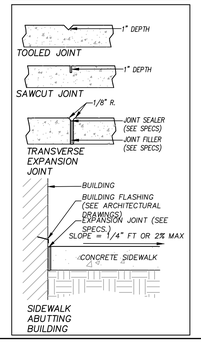

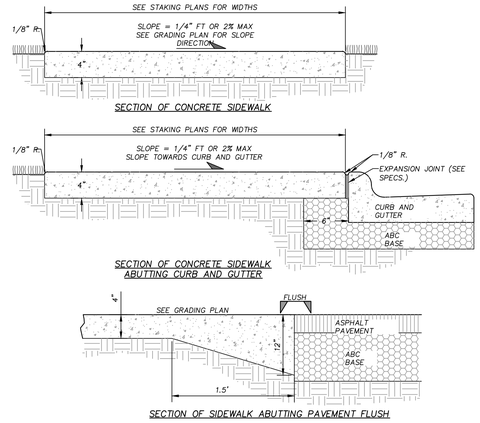

CONCRETE SIDEWALK

N.T.S.

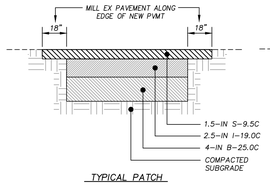

TYPICAL PATCH

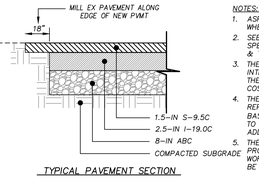

TYPICAL PAVEMENT SECTION

NOTES:

1. ASPHALT PATCH SECTION SHALL BE INSTALLED WHERE PAVEMENT WIDTH IS LESS THAN 6–FT.
2. SEE EARTH MOVING AND ASPHALT PAVEMENT SPECIFICATIONS FOR PROOF–ROLLING, COMPACTION & TESTING REQUIREMENTS.
3. THE CONTRACTOR MAY CHOOSE TO INSTALL INTERMEDIATE COURSES OF PAVEMENT TO STABILIZE THE SITE DURING CONSTRUCTION AT NO ADDITIONAL COST.
4. THE CONTRACTOR SHALL BE RESPONSIBLE FOR REPAIRING ANY DAMAGES TO SUBGRADE, INSTALLED BASE COURSE AND/OR INTERMEDIATE PAVING PRIOR TO PLACING SUBSEQUENT PAVEMENT LIFTS AT NO ADDITIONAL COST.
5. THE CONTRACTOR SHALL BE RESPONSIBLE FOR PROTECTING PAVEMENT DURING ALL PHASES OF WORK. THE FINAL SURFACE OF PAVEMENT SHALL BE FREE OF ALL DEFECTS OR DAMAGE.

ASPHALT PATCH

N.T.S.

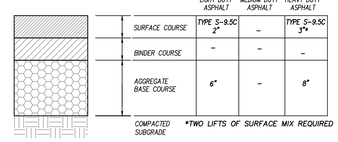

	LIGHT DUTY ASPHALT	MEDIUM DUTY ASPHALT	HEAVY DUTY ASPHALT
SURFACE COURSE	TYPE S–9.5C 2"	–	TYPE S–9.5C 3"*
BINDER COURSE	–	–	–
AGGREGATE BASE COURSE	6"	–	8"
COMPACTED SUBGRADE			

*TWO LIFTS OF SURFACE MIX REQUIRED

SEE SPECIFICATIONS FOR PROOFROLLING, COMPACTION & TESTING REQUIREMENTS.

DETAIL IS FOR ON–SITE PAVING OPERATIONS ONLY.

THE CONTRACTOR MAY CHOOSE TO INSTALL INTERMEDIATE COURSES OF PAVEMENT TO STABILIZE THE SITE DURING CONSTRUCTION AT NO ADDITIONAL COST.

THE CONTRACTOR IS RESPONSIBLE FOR DETERMINING THE ADEQUATE THICKNESS REQUIRED FOR INTERMEDIATE PAVING. INCREASES IN THE DESIGN PAVEMENT SECTION TO FACILITATE INTERMEDIATE PAVING SHALL BE PROVIDED AT NO ADDITIONAL COST.

THE CONTRACTOR SHALL BE RESPONSIBLE FOR REPAIRING ANY DAMAGES TO SUBGRADE, INSTALLED BASE COURSE AND/OR INTERMEDIATE PAVING PRIOR TO PLACING SUBSEQUENT PAVEMENT LIFTS AT NO ADDITIONAL COST.

THE CONTRACTOR SHALL BE RESPONSIBLE FOR PROTECTING PAVEMENT DURING ALL PHASES OF WORK. THE FINAL SURFACE OF PAVEMENT SHALL BE FREE OF ALL DEFECTS OR DAMAGE.

PAVEMENT SECTIONS

N.T.S.

NOTES:

1. INSTALL TREE PROTECTION FENCING PRIOR TO PERFORMING ANY CLEARING OF THE SITE.
2. WARNING SIGNS TO BE MADE OF DURABLE, WEATHERPROOF MATERIAL.
3. LETTERS TO BE 3" HIGH MINIMUM, CLEARLY LEGIBLE AND SPACED AS DETAILED.
4. SIGNS SHALL BE PLACED AT 100' MAXIMUM INTERVALS. PLACE A SIGN AT EACH END OF LINEAR TREE PROTECTION AND 100' ON CENTER THEREAFTER.
5. FOR TREE PROTECTION AREAS LESS THAN 200' IN PERIMETER, PROVIDE NO LESS THAN ONE SIGN PER PROTECTION AREA.
6. ATTACH SIGNS SECURELY TO FENCE POSTS AND FABRIC.
7. MAINTAIN TREE PROTECTION FENCE THROUGHOUT DURATION OF PROJECT.

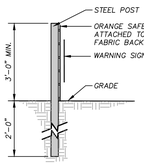

SIDE VIEW

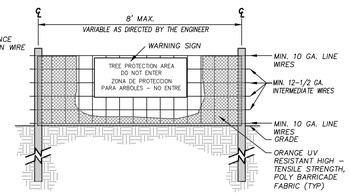

FRONT VIEW

WARNING SIGN DETAIL

TEMPORARY TREE PROTECTION FENCE

N.T.S.

TEMPORARY SEEDING SCHEDULE (JUNE 1ST TO FEBRUARY 28TH)

DATE	TYPE	SEEDING RATE
AUG 15 – APR 15	3–WAY TALL FESCUE BLEND AND CEREAL RYE (GRAIN)	10 LBS PER 1,000/SF 35 LBS/ACRE
APR 15 – AUG 15	3–WAY TALL FESCUE BLEND AND GERMAN MILLET *** OR SUDANGRASS (SMALL–STEMMED VAR.) ***	10 LBS PER 1,000/SF 25 LBS/ACRE

CONSULT CONSERVATION ENGINEER OR SOIL CONSERVATION SERVICE FOR ADDITIONAL INFORMATION CONCERNING OTHER ALTERNATIVES FOR VEGETATION OF DENUDED AREAS. THE ABOVE VEGETATION RATES ARE THOSE WHICH DO WELL UNDER LOCAL CONDITIONS; OTHER SEEDING RATE COMBINATIONS ARE POSSIBLE.

*** TEMPORARY – RESEED ACCORDING TO OPTIMUM SEASON FOR DESIRED PERMANENT VEGETATION. DO NOT ALLOW TEMPORARY COVER TO GROW OVER 12" IN HEIGHT BEFORE MOWING, OTHERWISE FESCUE MAY BE SHADED OUT.

PERMANENT SEEDING SCHEDULE

DATE	TYPE	SEEDING RATE
APR 15 – JULY 15 **	HULLED SUNSTAR OR RIVIERA BERMUDA	150 LBS/ACRE *
JULY 15 – AUG 15 (WATERING AT CONTRACTOR'S EXPENSE)	SUNSTAR OR RIVIERA BERMUDA	150 LBS/ACRE *

* OR AS REQUIRED TO ACHIEVE 95% COVERAGE AS DETERMINED ON A PER SQUARE YARD BASIS PRIOR TO SUBSTANTIAL COMPLETION.

** WHEN SEEDING MUST TAKE PLACE OUT–OF– SEASON FOR PERMANENT GRASS, APPROPRIATE TEMPORARY SEEDING SHALL BE DONE AND THE CONTRACTOR SHALL BE RESPONSIBLE FOR PERMANENT SEEDING AS SPECIFIED IN SEASON AT NO ADDITIONAL COST TO OWNER.

PLANTING / LANDSCAPING GENERAL NOTES

1. LOCATE ALL EXISTING UTILITIES PRIOR TO INSTALLATION OF PLANT MATERIAL. NOTIFY OWNER OF ANY DISCREPANCIES BETWEEN ACTUAL FIELD CONDITIONS AND THOSE SHOWN ON THE PLAN.
2. VERIFICATION OF TOTAL QUANTITIES AS SHOWN ON THE PLANT LIST SHALL BE THE RESPONSIBILITY OF THE CONTRACTOR AND THE TOTAL QUANTITIES SHALL BE AS SHOWN ON THE PLAN.
3. ALL PLANT MATERIAL SHALL CONFORM WITH THE STANDARDS SET FORTH BY THE AMERICAN ASSOCIATION OF NURSERYMEN AND THE WRITTEN SPECIFICATIONS.
4. ALL PLANT MATERIAL (SHRUBS/TREES) SHALL BE A MINIMUM DISTANCE OF 4–1/2 FEET FROM BACK OF CURB, EXCEPT ALONG ANY NEW WALLS ADJACENT TO PARKING WHERE CURB STOPS WILL BE USED.
5. ALL PLANT GROUPINGS SHALL BE MULCHED AS ONE BED. **3–IN OF DYED BROWN DESIGNER (PALLETIZED)** MULCH SHALL BE USED AROUND ALL PLANTINGS WITH THE EXCEPTION OF BUFFER PLANTINGS. BUFFER PLANTINGS MAY USE TRIPLE SHREDDED HARDWOOD. CONFIRM WITH LANDSCAPE ARCHITECT AND OWNER FOR APPROVAL PRIOR TO INSTALLATION.
6. APPLY PRE–EMERGENT HERBICIDE TO ALL NEW PLANTING BEDS AT MANUFACTURER'S RECOMMENDED RATE PRIOR TO INSTALLATION OF MULCH.
7. ESTABLISH POSITIVE DRAINAGE IN ALL PLANTING BEDS AND AWAY FROM BUILDINGS.
8. DO NOT INSTALL PLANT MATERIAL IN IMPERVIOUS SOILS, (i.e. HOLES WHICH, WHEN FILLED WITH WATER, DO NOT COMPLETELY DRAIN WITHIN TWO HOURS). SEE SPECIFICATIONS FOR TOPSOIL REQUIREMENTS.
9. CONTACT THE LANDSCAPE ARCHITECT FOR INSPECTION 48 HOURS IN ADVANCE OF THE SCHEDULED SITE VISIT AND AT THE FOLLOWING INTERVALS:
   - 9.1. REVIEW OF GRADING PRIOR TO PLANT AND LAWN INSTALLATION.
   - 9.2. REVIEW OF PLANT MATERIAL PRIOR TO INSTALLATION.
   - 9.3. ONE SUBSTANTIAL COMPLETION MEETING FOR PLANT INSTALLATION.
   - 9.4. ONE FINAL INSPECTION FOR ALL SEEDING/PLANTING OPERATIONS.
10. THE TREE PROTECTION FENCE SHALL BE MAINTAINED ON THE SITE UNTIL ALL SITE WORK IS COMPLETED AND THE FINAL SITE INSPECTION PRIOR TO THE CERTIFICATE OF OCCUPANCY (CO) IS SCHEDULED. THE FENCING SHALL BE REMOVED PRIOR TO FINAL SITE INSPECTION FOR THE CO.

LIME AND FERTILIZATION SCHEDULE:

1. APPLY LIME AND FERTILIZER ACCORDING TO SOIL TESTS, OR APPLY A MINIMUM 3,000 LB/ACRE GROUND AGRICULTURAL LIMESTONE AND A MINIMUM 500 LB/ACRE 10–10–10 FERTILIZER, AS NEEDED TO ESTABLISH 95% COVERAGE (AS DETERMINED ON A PER SQUARE YARD BASIS) PRIOR TO SUBSTANTIAL COMPLETION.
2. CONTRACTOR TO SUBMIT A COPY OF ALL SOIL REPORTS TO OWNER UPON RECEIPT.

SURFACE STABILIZATION REQUIREMENTS:

1. DURING ALL PHASES OF CONSTRUCTION, GROUNDCOVER ON EXPOSED SLOPES SHALL BE PROVIDED WITHIN 14 CALENDAR DAYS FOLLOWING COMPLETION OF ANY PHASE OF GRADING.
2. FINAL PERMANENT GROUNDCOVER FOR ALL DISTURBED AREAS SHALL BE PROVIDED ON ALL DISTURBED AREAS WITHIN 14 CALENDAR DAYS FOLLOWING COMPLETION OF CONSTRUCTION OR DEVELOPMENT.
3. USE EXCELSIOR MATTING OR OTHER APPROVED CHANNEL LINING MATERIAL TO COVER THE BOTTOM OF CHANNELS.
4. APPLY 4000 LB/ACRE(2 TONS LB/AC) GRAIN STRAW OVER SEEDED AREAS AND ANCHOR STRAW CRIMPING WITH HAND OR MECHANICAL CRIMPER 8" MAX. SPACING, ASPHALT TACKING OR OTHER APPROVED METHOD. ASPHALT TACKING SHALL BE 400 GAL/ACRE (9 GAL/1000 SF).
5. MULCH AND ANCHORING MATERIALS MUST NOT BE ALLOWED TO WASH DOWN SLOPES AND CLOG DRAINAGE DEVICES.
6. SEE NCDEQ GROUND STABILIZATION REQUIREMENTS FOR ADDITIONAL INFORMATION.

LANDSCAPE SUB–CONTRACTOR (UNDER GC CONTRACT) SHALL BE RESPONSIBLE FOR WATERING ALL PLANTS AND LAWN/SOD AREAS AT HIS COST FROM HIS OWN WATER SOURCE INCLUDING DURING PERIODS OF DROUGHT UNTIL THE PLANTS AND LAWN MEET FINAL COMPLETION. PLANT MATERIALS OR AREAS OF GRASS WHICH PERISH SHALL BE RE–ESTABLISHED BY THE CONTRACTOR AT NO EXPENSE TO THE OWNER. REFER TO SPECIFICATIONS FOR ADDITIONAL WATERING INFORMATION.

12. GENERAL CONTRACTOR SHALL BE RESPONSIBLE FOR KEEPING ALL EQUIPMENT & SUBCONTRACTORS AWAY FROM SEEDED/SOD AREAS. IF DAMAGE OCCURS, THROUGH NO FAULT OF THE OWNER, AREAS SHALL BE RE–GRADED AND RE–SEEDED IMMEDIATELY AT NO ADDITIONAL COST TO THE OWNER. CONTRACTOR SHALL WATER AND MAINTAIN THOSE AREAS UNTIL THEY ARE AT 95% COVERAGE AT FINAL COMPLETION.
13. SUBSTITUTIONS OF PLANT MATERIAL SHALL ONLY BE ACCEPTED 60 DAYS PRIOR TO COMMENCEMENT OF PLANTING OPERATIONS. SUBSTITUTION REQUESTS MUST BE IN WRITING AND WILL ONLY BE ACCEPTED FOR LACK OF AVAILABILITY REASONS WHICH CAN BE SUBSTANTIATED OR FOR SUPERIOR STOCK SUBSTITUTIONS.
14. LANDSCAPE CONTRACTOR SHALL NOTIFY LANDSCAPE ARCHITECT TO REVIEW GRADING ONE WEEK PRIOR TO SEEDING, IF THE LANDSCAPE CONTRACTOR AND LANDSCAPE ARCHITECT FIND GRADING UNACCEPTABLE FOR FINAL SEEDING. LANDSCAPE CONTRACTOR SHALL BRING IT TO THE ATTENTION OF THE GENERAL CONTRACTOR. LANDSCAPE CONTRACTOR SHALL NOT PROCEED WITHOUT APPROVAL BY LANDSCAPE ARCHITECT.
15. IF CONFLICTS OCCUR BETWEEN WRITTEN SPECIFICATIONS AND THE DRAWINGS, THE WRITTEN SPECIFICATIONS SHALL PREVAIL.
16. GENERAL LAWN AREAS SHALL BE SEEDED WITH **RIVIERA OR SUNSTAR BERMUDA SEED. SOD AREAS SHALL BE TIF–TUF BERMUDA.** 95% COVERAGE (BASED ON A PER SQUARE YARD SAMPLE) SHALL BE ATTAINED PRIOR TO FINAL INSPECTION. SEE DETAIL SHEET FOR RATES AND SPECIFICATIONS FOR ADDITIONAL INFORMATION.
17. SEE PLANTING PLAN FOR LIMITS.
18. ALL 3:1 SLOPES OR GREATER SHALL RECEIVE EROSION CONTROL MATTING. REFER TO PLANTING PLANS FOR STABILIZATION REQUIREMENTS.
19. ALL FOUNDATION SHRUBS TO BE PLANTED A MINIMUM OF 5–FT FROM BUILDING WALL. ALL SHADE TREES SHALL BE A MINIMUM DISTANCE OF 15–FT FROM BUILDING ROOF EDGE TO CENTER OF TREE. NOTIFY LANDSCAPE ARCHITECT FOR ANY DISCREPANCIES.
20. **INSTALL PERMANENT SEEDING ALONG ALL ROADSIDE DITCHES AND CHANNELS WITHIN CONSTRUCTION LIMITS OF PROJECT. SEE EROSION CONTROL PLANS FOR ADDITIONAL INFORMATION.**

LAWN MAINTENANCE NOTES:

1. SEE SPEC. SECTION 329000 FOR LAWN MAINTENANCE REQUIREMENTS.
2. CONTRACTOR SHALL BE RESPONSIBLE FOR LAWN MAINTENANCE UNTIL FINAL COMPLETION.
3. LAWN MUST BE AT 95% COVERAGE AT SUBSTANTIAL COMPLETION REVIEW TO BE ACCEPTED.
4. IF NOT AT 95% SUBSTANTIAL COMPLETION WILL BE DELAYED UNTIL THE FOLLOWING GROWING SEASON.
5. DO NOT ALLOW NURSE CROP TO GROW OVER 12" IN HEIGHT BEFORE MOWING, OTHERWISE THE PERMANENT SEEDING MAY BE SHADED OUT.

TURF, SOD AND SEEDBED PREPARATION:

1. CHISEL ALL CUT GRADED OR COMPACTED AREAS TO A MINIMUM DEPTH OF 8".
2. DISC ALL AREAS TO RECEIVE GRASS TO A MINIMUM OF 8 INCHES, MIX AND AMEND WITH 3 INCHES OF WELL SCREENED TOPSOIL. ON–SITE TOPSOIL MAY BE USED IN PLACE OF IMPORTED TOPSOIL, IF WELL–SCREENED AND DRY PRIOR TO APPLICATION IN ACCORDANCE WITH SPECIFICATION SECTION 329000.
3. REMOVE ALL LOOSE ROCK, ROOTS, AND OTHER OBSTRUCTIONS LEAVING SURFACE REASONABLY SMOOTH AND UNIFORM.
4. APPLY AGRICULTURAL LIME, FERTILIZER, AND PHOSPHATE UNIFORMLY AS PER SPECIFICATIONS AND MIX WELL WITH SOIL.
5. CONTINUE TILLAGE UNTIL A WELL–PULVERIZED, FIRM, REASONABLY UNIFORM SEEDBED IS PREPARED TO A 6 INCHES DEPTH.
6. SEED AT RATE SPECIFIED OR AS NEEDED TO ACHIEVE AND MAINTAIN A THICK HEALTHY GROUND COVERAGE.
7. MULCH IMMEDIATELY AFTER SEEDING AND ANCHOR MULCH. BEGIN THOROUGH WATERING OF GRASSED AREAS IMMEDIATELY UPON INSTALLATION. DO NOT ALLOW GRASSED AREAS TO BECOME EXCESSIVELY DRY.
8. INSPECT ALL SEEDED AREAS AND MAKE NECESSARY REPAIRS OR RESEEDINGS AS NEEDED.
9. IF CONFLICTS OCCUR BETWEEN WRITTEN SPECIFICATIONS AND THE DRAWINGS, THE WRITTEN SPECIFICATIONS SHALL PREVAIL.

PLANTING / LANDSCAPING DETAIL

N.T.S.

CURB AND GUTTER NOTES:

1. ALL CONCRETE SHALL BE **4,000 P.S.I. @ 28 DAYS**
2. CONTRACTION JOINTS SHALL BE SPACED AT 10' INTERVALS, SPACING MAY BE INCREASED TO 15' IF MACHINE IS USED.
3. CONTRACTION JOINTS SHALL BE INSTALLED BY THE USE OF TEMPLATES OR FORMED BY OTHER APPROVED METHODS. WHERE SUCH JOINTS ARE NOT FORMED BY TEMPLATES, A MINIMUM DEPTH OF 1–1/2" SHALL BE OBTAINED.
4. EXPANSION JOINTS SHALL BE SPACED AT 90' MAX INTERVALS, AND ADJACENT TO ALL RIGID OBJECTS.
5. ALL JOINTS SHALL BE FILLED WITH JOINT FILLER AND SEALER.
6. SEE SPECIFICATION SECTION 32 13 13 FOR ADDITIONAL INFORMATION

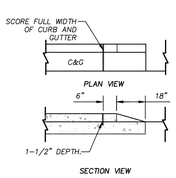

ENDING CURB AND GUTTER

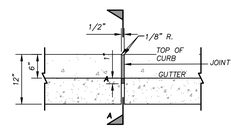

CONTRACTION JOINT

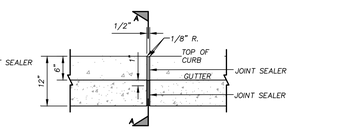

TRANSVERSE EXPANSION JOINT

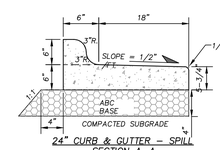

24" CURB & GUTTER – SPILL
SECTION A–A
TYPE 1

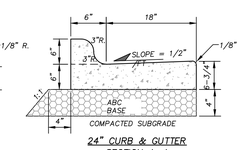

24" CURB & GUTTER
SECTION A–A
TYPE 2

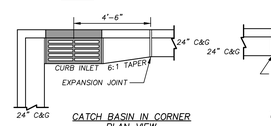

CATCH BASIN IN CORNER
PLAN VIEW

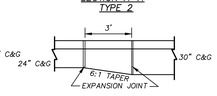

24" TO 30" G&G
TRANSITION
PLAN VIEW

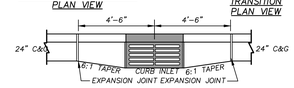

CATCH BASIN ALONG
GUTTER
PLAN VIEW

CURB AND GUTTER

N.T.S.

adw architects
environments for life
architecture planning interiors
2815 coliseum centre drive
suite 500
charlotte, nc 28217
704.379.1919
adwarchitects.com

Rolesville
Genuine Community • Capital Connection
Est. 1837

ROLESVILLE POLICE

CLH DESIGN
CLH design, p.a.
400 Regency Forest Drive
Suite 120
Cary, NC 27518
Phone: 919.319.6716
LA: C-106, PE: C-1595

TOWN OF ROLESVILLE POLICE DEPARTMENT

ROLESVILLE, NC 27571

SITE DETAILS

DATE: 08-19-2026
PROJECT NO:
CLH PROJECT NO: 25-108

THIS DRAWING IS THE PROPERTY OF ADW ARCHITECTS, P.A. AND SHALL NOT BE REPRODUCED OR COPIED IN WHOLE OR PART. IT SHALL NOT BE USED ON ANY OTHER PROJECT OR GIVEN TO ANY OTHER COMPANY OR AGENCY WITHOUT THE CONSENT OF ADW ARCHITECTS, P.A.

SHEET NUMBER:
C-8.01

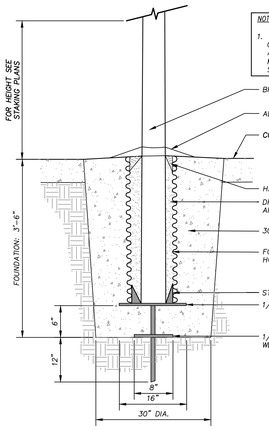

FLAGPOLE N.T.S.

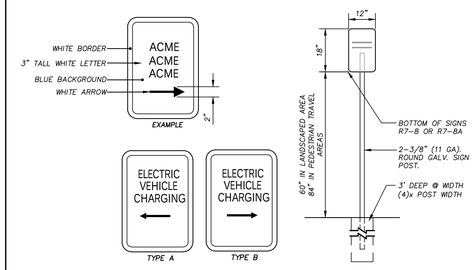

EV PARKING SIGN

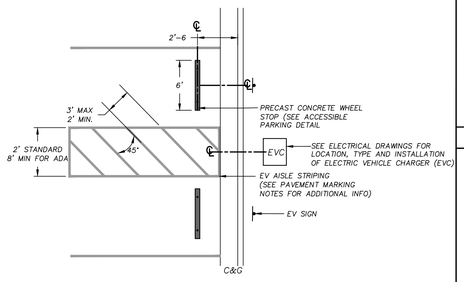

EV STALL STRIPING PLAN VIEW

EV PARKING N.T.S.

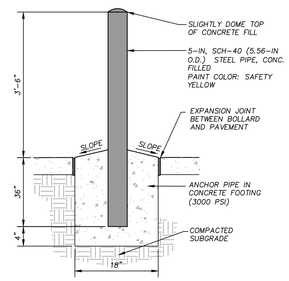

STEEL BOLLARD N.T.S.

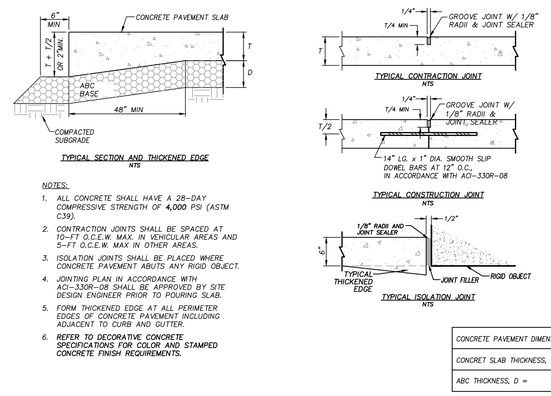

NOTES:

1. ALL CONCRETE SHALL HAVE A 28-DAY COMPRESSIVE STRENGTH OF 4,000 PSI (ASTM C39).
2. CONTRACTION JOINTS SHALL BE SPACED AT 10-FT O.C.E.W. MAX. IN VEHICULAR AREAS AND 5-FT O.C.E.W. MAX IN OTHER AREAS.
3. ISOLATION JOINTS SHALL BE PLACED WHERE CONCRETE PAVEMENT ABUTS ANY RIGID OBJECT.
4. JOINTING PLAN IN ACCORDANCE WITH ACI-330R-08 SHALL BE APPROVED BY SITE DESIGN ENGINEER PRIOR TO POURING SLAB.
5. FORM THICKENED EDGE AT ALL PERIMETER EDGES OF CONCRETE PAVEMENT INCLUDING ADJACENT TO CURB AND GUTTER.
6. REFER TO DECORATIVE CONCRETE SPECIFICATIONS FOR COLOR AND STAMPED CONCRETE FINISH REQUIREMENTS.

CONCRETE PAVEMENT DIMENSIONS	LIGHT DUTY	HEAVY DUTY
CONCRET SLAB THICKNESS, T =	5"	8"
ABC THICKNESS, D =	4"	4"

STANDARD CONCRETE PAVEMENT N.T.S.

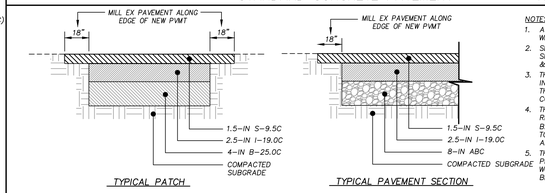

NOTES:

1. ASPHALT PATCH SECTION SHALL BE INSTALLED WHERE PAVEMENT WIDTH IS LESS THAN 6-FT.
2. SEE EARTH MOVING AND ASPHALT PAVEMENT SPECIFICATIONS FOR PROOF-ROLLING, COMPACTION & TESTING REQUIREMENTS.
3. THE CONTRACTOR MAY CHOOSE TO INSTALL INTERMEDIATE COURSES OF PAVEMENT TO STABILIZE THE SITE DURING CONSTRUCTION AT NO ADDITIONAL COST.
4. THE CONTRACTOR SHALL BE RESPONSIBLE FOR REPAIRING ANY DAMAGES TO SUBGRADE, INSTALLED BASE COURSE AND/OR INTERMEDIATE PAVING PRIOR TO PLACING SUBSEQUENT PAVEMENT LIFTS AT NO ADDITIONAL COST.
5. THE CONTRACTOR SHALL BE RESPONSIBLE FOR PROTECTING PAVEMENT DURING ALL PHASES OF WORK. THE FINAL SURFACE OF PAVEMENT SHALL BE FREE OF ALL DEFECTS OR DAMAGE.

ASPHALT PATCH N.T.S.

ACCESSIBLE PARKING NOTES:

RAMPS DEVELOPED IN ACCORDANCE WITH AMERICANS WITH DISABILITES ACT (ADA)

THE WALKING SURFACE SHALL BE SLIP RESISTANT. THE COLOR FOR THE DETECTABLE WARNING AREA SHALL BE **YELLOW** FOR CONTRAST.

NO SLOPE ON THE SIDEWALK ACCESS RAMP SHALL EXCEED 1"/FT (12:1) IN RELATIONSHIP TO THE GRADE OF THE STREET. SEE GRADING FOR ADDITIONAL INFORMATION.

NO RAMPS OR SIDEWALK SHALL BE LESS THAN 48" WIDE. REFER TO STAKING SHEETS FOR ALL SIDEWALK AND RAMP WIDTHS.

ALL CONCRETE SHALL BE 4,000 PSI @ 28 DAYS. SEE CONCRETE SIDEWALK DETAIL FOR ADDITIONAL INFO.

CURB RAMPS SHALL BE PARALLEL TO THE DIRECTION OF TRAVEL.

EXPANSION JOINTS SHALL BE INSTALLED FULL DEPTH WHEN EVER IT ABUTS EXISTING OR CURB AND GUTTER

CROSS SLOPE NOT TO EXCEED 2% ON ANY PORTION OF RAMP OR TRANSITION TO STREET.

ALL RAMPS SHALL HAVE A 4' MIN. LANDING WITH A MAX SLOPE OF 2% WERE PEDESTRIANS PERFORM TURNING. ENSURE TO PITCH TOWARDS GUTTER.

DETECTABLE DOMES SHALL BE INSTALL AT FULL WIDTH OF RAMP.

ALL DIMENSIONS ARE FROM FACE OF CURB

ACCESSIBLE STALL WIDTH AND LENGTH AS SHOWN. NO ACCESSIBLE STALL SHALL BE LESS THAT 8' WIDE.
ALL VAN ACCESSIBLE PARKING STALLS ARE AS SHOWN. NO ACCESSIBLE VAN STALL SHALL BE LESS THAT 8' WIDE WITH AISLE BEING NOT LESS THAN 8' WIDE.
CONTRACTOR IS RESPONSIBLE FOR MARKING OUT ACCESSIBLE STALL TO ENSURE THEY MEET CODE. ANY DEFICIENCIES SHALL BE REPAIR AT THE CONTRACTORS EXPENSE.
NO RAMP SHALL EXCEED 8.33% (12:1) SLOPE.

CROSS SLOPE SHALL BE MAX 2%

PARKING STALL AND ACCESSIBLE AISLE SHALL BE WHITE ON ASPHALT SURFACES AND BLUE ON CONCRETE SURFACES.

1. 8.33% (12:1) MAX RAMP SLOPE
2. CROSS SLOPE: 2%
3. 2% MAX IN ALL DIRECTIONS
4. 2% LANDING
5. 6" WIDE X 12" DEEP CURB (MONOLITH POUR IS ACCEPTABLE)
6. DETECTABLE WARNING DOME (SEE DETAIL)
7. 1/2" EXPANSION JOINT

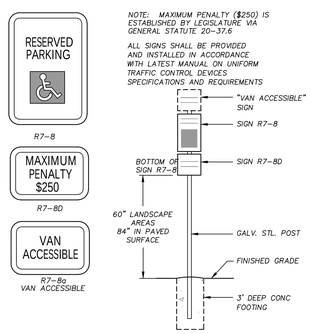

ACCESSIBLE PARKING SIGNAGE

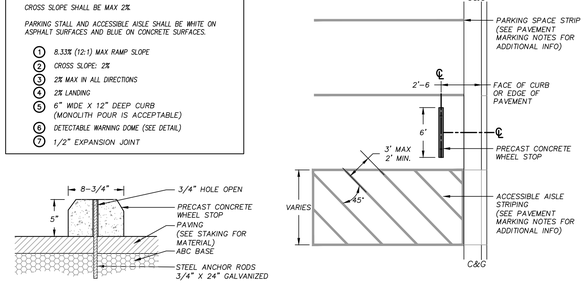

PRECAST CONCRETE WHEEL STOP SECTION VIEW

ACCESSIBLE STALL STRIPING AND 90° PARKING SPACE PLAN VIEW

ACCESSIBLE PARKING N.T.S.

FENCE AND GATE NOTES:

1. SEE STAKING PLAN FOR PRE-K PANIC HARDWARE IF APPLICABLE, SEE SPEC SECTION 323119 FOR ADDITIONAL INFORMATION. ALL FENCING SHALL HAVE A SECURING LATCH FOR TIME WERE STUDENT OCCUPY THE SPACE IN ADDITION TO THE PANIC HARDWARE.
2. REFER TO SPECIFICATION SECTION 323119 FOR ASSEMBLY AND MATERIALS OR PER MANUFACTURES RECOMMENDATIONS.
3. ALL BOLTS SHALL BE CUT FLUSH TO NUT AND PAINTED TO MATCH FENCE.
4. GATES WIDER THAN 4'-0" SHALL BE DOUBLE.
5. ALL FENCING FOR PRE-K MUST COMPLY WITH NC GENERAL STATUTE 110-91(6) AND CHILD CARE RULE .0605
6. FENCE PICKETS MUST BE LESS THAN 3-1/2"
7. BOTTOM RAIL SHALL BE NO GREATER THAN 2" FROM THE FINISHED GRADE.

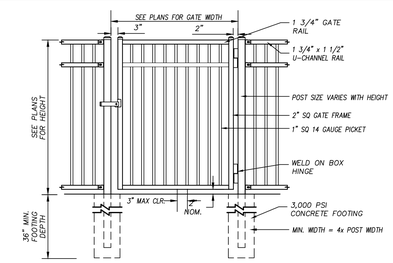

SINGLE GATE SECTION ELEVATION

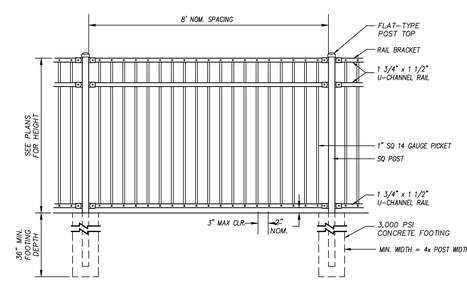

FENCE SECTION ELEVATION

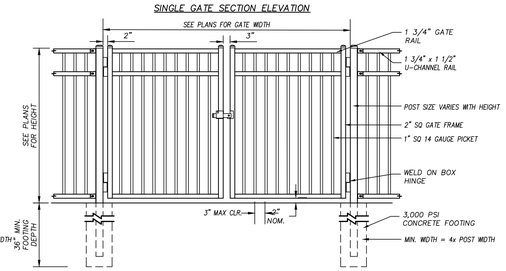

DOUBLE GATE SECTION ELEVATION

ORNAMENTAL FENCE AND GATES N.T.S.

adw architects
environments for life
architecture planning interiors
2815 coliseum centre drive
suite 500
charlotte, nc 28217
704.379.1919
adwarchitects.com

Rolesville
Genuine Community • Capital Connection
Est. 1837

ROLESVILLE POLICE

CLH DESIGN
CLH design, p.a.
400 Regency Forest Drive
Suite 120
Cary, NC 27518
Phone: 919.319.6716
LA: C-106, PE: C-1595

TOWN OF ROLESVILLE POLICE DEPARTMENT

ROLESVILLE, NC 27571

SITE DETAILS

DATE: 08-19-2026
PROJECT NO:
CLH PROJECT NO: 25-108

THIS DRAWING IS THE PROPERTY OF ADW ARCHITECTS, P.A. AND SHALL NOT BE REPRODUCED OR COPIED IN WHOLE OR PART. IT SHALL NOT BE USED ON ANY OTHER PROJECT OR GIVEN TO ANY OTHER COMPANY OR AGENCY WITHOUT THE CONSENT OF ADW ARCHITECTS, P.A.

SHEET NUMBER:
C-8.02

CITY OF RALEIGH - STANDARD UTILITY NOTES

1. ALL MATERIALS & CONSTRUCTION METHODS SHALL BE IN ACCORDANCE WITH CITY OF RALEIGH DESIGN STANDARDS, DETAILS & SPECIFICATIONS (REFERENCE: CORPUD HANDBOOK, CURRENT EDITION)
2. UTILITY SEPARATION REQUIREMENTS:
   - 2.1. A) A DISTANCE OF 100'SHALL BE MAINTAINED BETWEEN SANITARY SEWER & ANY PRIVATE OR PUBLIC WATER SUPPLY SOURCE SUCH AS AN IMPOUNDED RESERVOIR USED AS A SOURCE OF DRINKING WATER. IF ADEQUATE LATERAL SEPARATION CANNOT BE ACHIEVED, FERROUS SANITARY SEWER PIPE SHALL BE SPECIFIED & INSTALLED TO WATERLINE SPECIFICATIONS. HOWEVER, THE MINIMUM SEPARATION SHALL NOT BE LESS THAN 25'FROM A PRIVATE WELL OR 50'FROM A PUBLIC WELL.
   - 2.2. B) WHEN INSTALLING WATER &/OR SEWER MAINS, THE HORIZONTAL SEPARATION BETWEEN UTILITIES SHALL BE 10'. IF THIS SEPARATION CANNOT BE MAINTAINED DUE TO EXISTING CONDITIONS, THE VARIATION ALLOWED IS THE WATER MAIN IN A SEPARATE TRENCH WITH THE ELEVATION OF THE WATER MAIN AT LEAST 18"ABOVE THE TOP OF THE SEWER & MUST BE APPROVED BY THE PUBLIC UTILITIES DIRECTOR. ALL DISTANCES ARE MEASURED FROM OUTSIDE DIAMETER TO OUTSIDE DIAMETER.
   - 2.3. C) WHERE IT IS IMPOSSIBLE TO OBTAIN PROPER SEPARATION, OR ANYTIME A SANITARY SEWER PASSES OVER A WATERMAIN, DIP MATERIALS OR STEEL ENCASEMENT EXTENDED 10'ON EACH SIDE OF CROSSING MUST BE SPECIFIED & INSTALLED TO WATERLINE SPECIFICATIONS.
   - 2.4. D) 5.0'MINIMUM HORIZONTAL SEPARATION IS REQUIRED BETWEEN ALL SANITARY SEWER & STORM SEWER FACILITIES, UNLESS DIP MATERIAL IS SPECIFIED FOR SANITARY SEWER
   - 2.5. E) MAINTAIN 18"MIN. VERTICAL SEPARATION AT ALL WATERMAIN & RCP STORM DRAIN CROSSINGS; MAINTAIN 18"MIN. VERTICAL SEPARATION AT ALL SANITARY SEWER & RCP STORMDRAIN CROSSINGS. WHERE ADEQUATE SEPARATIONS CANNOT BE ACHIEVED, SPECIFY DIP MATERIALS & A CONCRETE CRADLE HAVING 6"MIN. CLEARANCE (PER CORPUD DETAILS W– 41 & S–49).
   - 2.6. F) ALL OTHER UNDERGROUND UTILITIES SHALL CROSS WATER & SEWER FACILITIES WITH 18"MIN. VERTICAL SEPARATION REQUIRED.
3. ANY NECESSARY FIELD REVISIONS ARE SUBJECT TO REVIEW & APPROVAL OF AN AMENDED PLAN &/OR PROFILE BY THE CITY OF RALEIGH PUBLIC UTILITIES DEPARTMENT PRIOR TO CONSTRUCTION.
4. DEVELOPER SHALL PROVIDE 30 DAYS ADVANCE WRITTEN NOTICE TO OWNER FOR ANY WORK REQUIRED WITHIN AN EXISTING CITY OF RALEIGH UTILITY EASEMENT TRAVERSING PRIVATE PROPERTY.
5. CONTRACTOR SHALL MAINTAIN CONTINUOUS WATER & SEWER SERVICE TO EXISTING RESIDENCES & BUSINESSES THROUGHOUT CONSTRUCTION OF PROJECT. ANY NECESSARY SERVICE INTERRUPTIONS SHALL BE PRECEDED BY A 24–HOUR ADVANCE NOTICE TO THE CITY OF RALEIGH PUBLIC UTILITIES DEPARTMENT.
6. SEWER BYPASS PUMPING – A BYPASS PLAN SEALED BY AN NC PROFESSIONAL ENGINEER SHALL BE PROVIDED TO RALEIGH WATER PRIOR TO PUMPING OPERATIONS FOR APPROVAL. THE OPERATIONS AND EQUIPMENT SHALL COMPLY WITH THE PUBLIC UTILITIES HANDBOOK.
7. 3.0'MINIMUM COVER IS REQUIRED ON ALL WATER MAINS & SEWER FORCE MAINS. 4.0'MINIMUM COVER IS REQUIRED ON ALL REUSE MAINS.
8. IT IS THE DEVELOPER'S RESPONSIBILITY TO ABANDON OR REMOVE EXISTING WATER & SEWER SERVICES NOT BEING USED IN REDEVELOPMENT OF A SITE UNLESS OTHERWISE DIRECTED BY THE CITY OF RALEIGH PUBLIC UTILITIES DEPARTMENT. THIS INCLUDES ABANDONING TAP AT MAIN & REMOVAL OF SERVICE FROM ROW OR EASEMENT PER CORPUD HANDBOOK PROCEDURE.
9. INSTALL WATER SERVICES WITH METERS LOCATED AT ROW OR WITHIN A 2'X2' WATERLINE EASEMENT IMMEDIATELY ADJACENT. NOTE: IT IS THE APPLICANT'S RESPONSIBILITY TO PROPERLY SIZE THE WATER SERVICE FOR EACH CONNECTION TO PROVIDE ADEQUATE FLOW & PRESSURE.
10. INSPECTIONS OF 4"AND LARGER WATER MAINS OF THE PRIVATE DISTRIBUTION SYSTEM WILL BE INSPECTED AS PART OF THE INFRASTRUCTURE PERMIT.
11. PRIVATE SEWER MAINS AS PART OF A COLLECTION SYSTEM ARE PERMITTED AND INSPECTED UNDER THE PRIVATE INFRASTRUCTURE PERMIT FOR SEWER.
12. ANY WATER OR SEWER SERVICES ON PRIVATE PROPERTY THAT WILL BE INSTALLED UNDER CONSTRUCTION DRAWINGS MAY REQUIRE A PLUMBING UTILITY PERMIT IN THE CITY OF RALEIGH. CONSULT WITH THE ENGINEERING INSPECTION COORDINATOR DURING THE PRE–CONSTRUCTION MEETING ON THE NECESSARY PERMITS.
13. INSTALL SEWER SERVICES WITH CLEANOUTS LOCATED AT ROW OR EASEMENT LINE & SPACED PER THE CURRENT NC PLUMBING CODE.
14. PRESSURE REDUCING VALVES ARE REQUIRED ON ALL WATER SERVICES EXCEEDING 80 PSI; BACKWATER VALVES ARE REQUIRED ON ALL SANITARY SEWER SERVICES HAVING BUILDING DRAINS LOWER THAN 1.0'ABOVE THE NEXT UPSTREAM MANHOLE.
15. ALL ENVIRONMENTAL PERMITS APPLICABLE TO THE PROJECT MUST BE OBTAINED FROM NCDWQ, USACE &/OR FEMA FOR ANY RIPARIAN BUFFER, WETLAND &/OR FLOODPLAIN IMPACTS (RESPECTIVELY) PRIOR TO CONSTRUCTION.
16. NCDOT / RAILROAD ENCROACHMENT AGREEMENTS ARE REQUIRED FOR ANY UTILITY WORK (INCLUDING MAIN EXTENSIONS & SERVICE TAPS) WITHIN STATE OR RAILROAD ROW PRIOR TO CONSTRUCTION.
17. GREASE INTERCEPTOR / OIL WATER SEPARATOR SIZING CALCULATIONS & INSTALLATION SPECIFICATIONS SHALL BE APPROVED BY THE RW FOG PROGRAM COORDINATOR PRIOR TO ISSUANCE OF A UC AND/OR BUILDING PERMIT. CONTACT (919) 996–4516 OR FOG@RALEIGHNC.GOV FOR MORE INFORMATION.
18. CROSS–CONNECTION CONTROL PROTECTION DEVICES ARE REQUIRED BASED ON THE DEGREE OF HEALTH HAZARD INVOLVED AS LISTED IN APPENDIX B OF THE RULES GOVERNING PUBLIC WATER SYSTEMS IN NORTH CAROLINA.
19. THE DEVICES SHALL MEET THE AMERICAN SOCIETY OF SANITARY ENGINEERING (ASSE) STANDARDS AND BE ON THE UNIVERSITY OF SOUTHERN CALIFORNIA APPROVAL LIST.
20. THE DEVICE AND INSTALLATION SHALL MEET THE GUIDELINES OF APPENDIX A – GUIDELINES AND REQUIREMENTS FOR THE CROSS CONNECTION PROGRAM IN RALEIGH'S SERVICE AREA.
21. THE DEVICES SHALL BE INSTALLED AND TESTED (BOTH, INITIAL AND PERIODIC TESTING THEREAFTER) IN ACCORDANCE WITH THE MANUFACTURER'S RECOMMENDATIONS OR THE LOCAL CROSS CONNECTION CONTROL PROGRAM, WHICHEVER IS MORE STRINGENT. CONTACT CROSS.CONNECTION@RALEIGHNC.GOV FOR MORE INFORMATION.
22. NOTICE FOR PROJECTS THAT INVOLVE AN OVERSIZED MAIN OR URBAN MAIN REPLACEMENT. ANY CITY REIMBURSEMENT GREATER THAN $250,000.00 MUST UNDERGO THE PUBLIC BIDDING PROCESS.
23. PRIVATE SUB–METERING – NO RESALE OF WATER SHALL OCCUR WITHOUT APPROVAL OF THE NORTH CAROLINA UTILITY COMMISSION. SUB–METERING SHALL BE IN ACCORDANCE WITH SECTION 1400 OF THE "SAFE DRINKING WATER ACT".

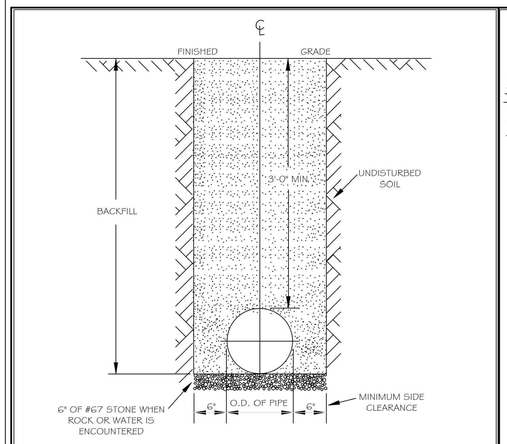

NOTES:
1. TRENCHES REQUIRING SHORING AND BRACING, DIMENSIONS SHALL BE TAKEN FROM THE INSIDE FACE OF THE SHORING AND BRACING.
2. NO ROCKS OR BOULDERS 4" OR LARGER TO BE USED IN BACKFILL.
3. ALL BACKFILL MATERIAL SHALL BE SUITABLE NATIVE MATERIAL.
4. BACKFILL SHALL BE TAMPED IN 6" LIFTS.
5. ACHIEVE 95% COMPACTION IN BACKFILL.

CITY OF RALEIGH
DEPARTMENT OF PUBLIC UTILITIES
TRENCH BOTTOM DIMENSIONS & BACKFILLING REQUIREMENTS FOR DUCTILE IRON

DWG. NO.	REVISIONS	DATE	REVISIONS	DATE
W-3	D.W.C.	9-3-99	ABB	2-15-05
	RRH	3-31-00	J.P.S.	10-29-10

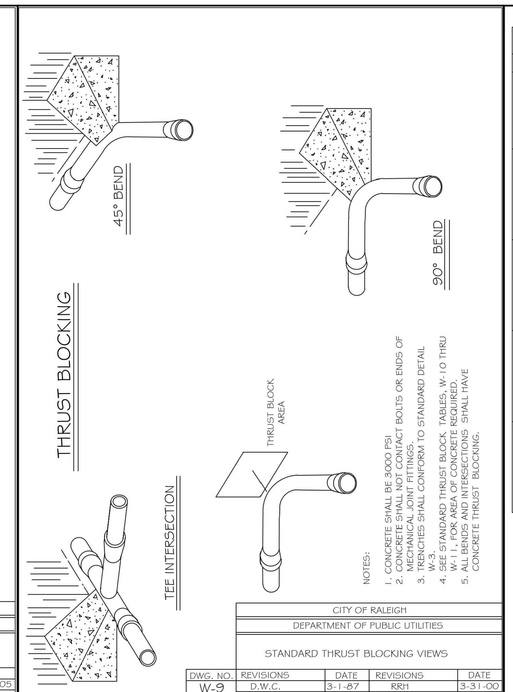

NOTES:
1. CONCRETE SHALL BE 3000 PSI
2. CONCRETE SHALL NOT CONTACT BOLTS OR ENDS OF MECHANICAL JOINT FITTINGS
4. SEE STANDARD THRUST BLOCK TABLES, W-10 THRU W-11, FOR AREA OF CONCRETE REQUIRED.

CITY OF RALEIGH
DEPARTMENT OF PUBLIC UTILITIES
STANDARD THRUST BLOCKING VIEWS

DWG. NO.	REVISIONS	DATE	REVISIONS	DATE
W-9	D.W.C.	3-1-87	RRH	3-31-00
		9-7-99	D.H.L.	6-18-08

REACTION BEARING AREAS FOR HORIZONTAL WATER PIPE BENDS BASED ON TEST PRESSURE OF 200 PSI

ALL AREAS GIVEN IN SQUARE FEET

SIZE OF BEND	DEGREE OF BEND	STATIC THRUST IN POUNDS	MODERATELY DRY CLAY 4,000 LBS/FT²	SOFT CLAY 2,000 LBS/FT²	1,600 LBS/FT² GRAVEL/ COARSE SAND	8,000 LBS/FT² DRY CLAY (ALWAYS DRY)	SAND, COMPACT FIRM 8,000 LBS/FT²	SAND– CLEAN DRY 4,000 LBS/FT²	SOIL 1,000 LBS/FT² QUICKSAND (VERY POOR)	ROCK– POOR 10,000 LBS/FT²
6"	11 ¼°	1,108	1	1	1	1	1	1	2	1
	22 ½°	2,207	1	2	2	1	1	1	3	1
	45°	4,328	2	3	3	1	1	2	5	1
	90°	7,996	2	4	5	1	1	2	8	1
	PLUG	5,655	2	3	4	1	1	2	6	1
8"	11 ¼°	1,970	1	1	2	1	1	1	2	1
	22 ½°	3,922	1	2	3	1	1	1	4	1
	45°	7,694	2	4	5	1	1	2	8	1
	90°	14,215	4	8	9	2	2	4	15	2
	PLUG	10,053	3	5	6	2	2	3	10	1
12"	11 ¼°	4,433	2	3	3	1	1	2	5	1
	22 ½°	8,826	3	5	6	2	2	3	9	1
	45°	17,312	5	9	11	3	3	5	18	2
	90°	31,983	8	16	19	4	4	8	32	4
	PLUG	22,619	6	12	14	3	3	6	23	3
16"	11 ¼°	7,881	2	4	5	1	1	2	8	1
	22 ½°	15,691	4	8	10	2	2	4	16	2
	45°	30,779	8	16	19	4	4	8	31	4
	90°	56,861	15	29	35	8	8	15	57	6
	PLUG	40,213	10	21	25	5	5	10	41	5

NOTES:
1. REACTION BEARING AREAS ARE IN SQUARE FEET MEASURED IN A VERTICAL PLANE IN THE TRENCH SIDE AT AN ANGLE OF 90° TO THE THRUST VECTOR.
2. USE 6" 90° BEND VALUE FOR HYDRANTS FOR ADDITIONAL SAFETY FACTOR.

CITY OF RALEIGH
STANDARD DETAIL

REVISIONS	DATE: 01/16/2025	NOT TO SCALE
	THRUST BLOCKING DESIGN QUANTITY TABLE	
	W-10	

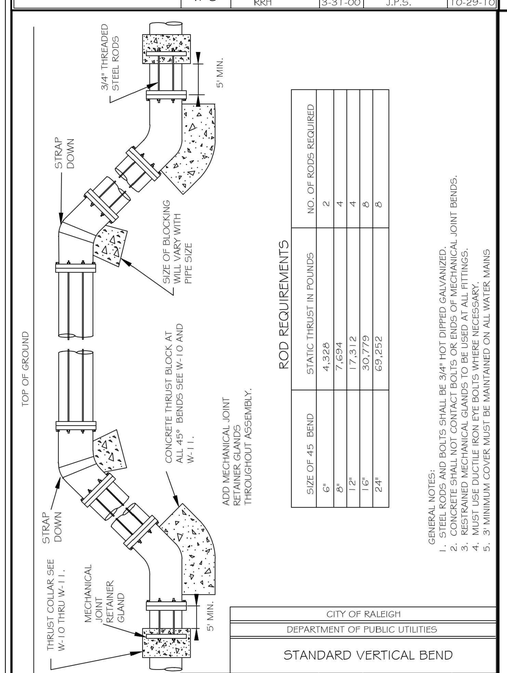

ROD REQUIREMENTS

SIZE OF 45 BEND	STATIC THRUST IN POUNDS	NO. OF RODS REQUIRED
6"	4,328	2
8"	7,694	4
12"	17,312	4
24"	69,252	8

GENERAL NOTES:
1. STEEL RODS AND BOLTS SHALL BE 3/4" HOT DIPPED GALVANIZED.
2. CONCRETE SHALL NOT CONTACT BOLTS OR ENDS OF MECHANICAL JOINT BENDS.
3. RESTRAINED MECHANICAL GLANDS TO BE USED AT ALL FITTINGS.
4. MUST USE DUCTILE IRON EYE BOLTS WHERE NECESSARY.
5. 3' MINIMUM COVER MUST BE MAINTAINED ON ALL WATER MAINS

CITY OF RALEIGH
DEPARTMENT OF PUBLIC UTILITIES
STANDARD VERTICAL BEND

DWG. NO.	REVISIONS	DATE	REVISIONS	DATE
W-12	ABB	4-6-04	J.P.S.	11-1-10
	D.H.L.	6-18-08		

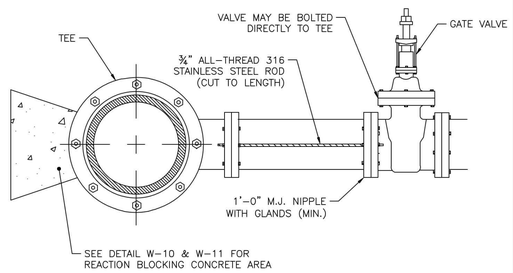

ROD REQUIREMENTS

BRANCH SIZE	NO. OF RODS
4"	2
6"	2
8"	4
12"	4
16"	6
24"	6
30"	8
36"	8

NOTES:
1. STEEL RODS AND BOLTS SHALL BE 3/4" 316 STAINLESS STEEL.
2. SEE DETAIL W–10 AND W–11 (THRUST BLOCK TABLES) FOR CONCRETE.
3. CONCRETE SHALL NOT CONTACT BOLTS OR ENDS OF MECHANICAL FITTINGS.
4. THIS RODDING REQUIREMENT DOES NOT APPLY TO FIRE HYDRANTS.

CITY OF RALEIGH
STANDARD DETAIL

REVISIONS	DATE: 01/16/2025	NOT TO SCALE
	VALVE RESTRAINT AT TEES AND CROSSES FOR LINES (4"–24")	
	W-15	

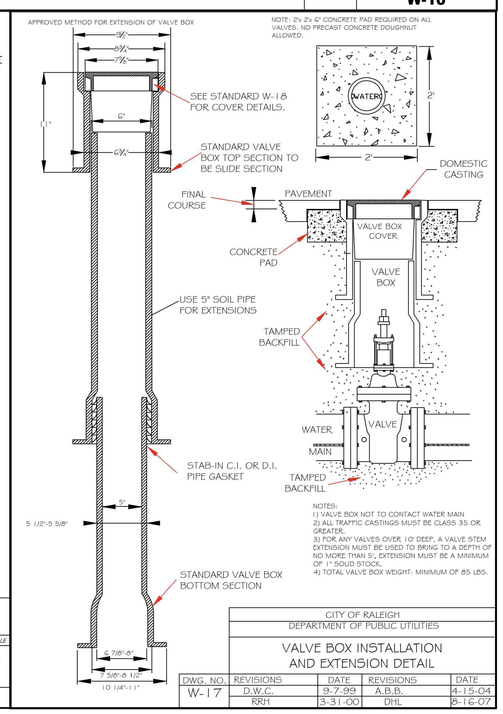

NOTES:
1) VALVE BOX NOT TO CONTACT WATER MAIN
2) ALL TRAFFIC CASTINGS MUST BE CLASS 35 OR GREATER.
3) FOR ANY VALVES OVER 10' DEEP, A VALVE STEM EXTENSION MUST BE USED TO BRING TO A DEPTH OF NO MORE THAN 5'. EXTENSION MUST BE A MINIMUM OF 1" SOLID STOCK.
4) TOTAL VALVE BOX WEIGHT: MINIMUM OF 85 LBS.

CITY OF RALEIGH
DEPARTMENT OF PUBLIC UTILITIES
VALVE BOX INSTALLATION AND EXTENSION DETAIL

DWG. NO.	REVISIONS	DATE	REVISIONS	DATE
W-17	D.W.C.	9-7-99	A.B.B.	4-15-04
	RRH	3-31-00	DHL	8-16-07

adw architects
environments for life
architecture planning interiors
2815 coliseum centre drive
suite 500
charlotte, nc 28217
704.379.1919
adwarchitects.com

Rolesville
Genuine Community • Capital Connection
Est. 1837

ROLESVILLE POLICE

CLH DESIGN
CLH design, p.a.
400 Regency Forest Drive
Suite 120
Cary, NC 27518
Phone: 919.319.6716
LA: C-106, PE: C-1595

TOWN OF ROLESVILLE POLICE DEPARTMENT

ROLESVILLE, NC 27571

UTILITY DETAILS

DATE: 08-19-2026
PROJECT NO:
CLH PROJECT NO: 25-108

THIS DRAWING IS THE PROPERTY OF ADW ARCHITECTS, P.A. AND SHALL NOT BE REPRODUCED OR COPIED IN WHOLE OR PART. IT SHALL NOT BE USED ON ANY OTHER PROJECT OR GIVEN TO ANY OTHER COMPANY OR AGENCY WITHOUT THE CONSENT OF ADW ARCHITECTS, P.A.

SHEET NUMBER:
C-9.01

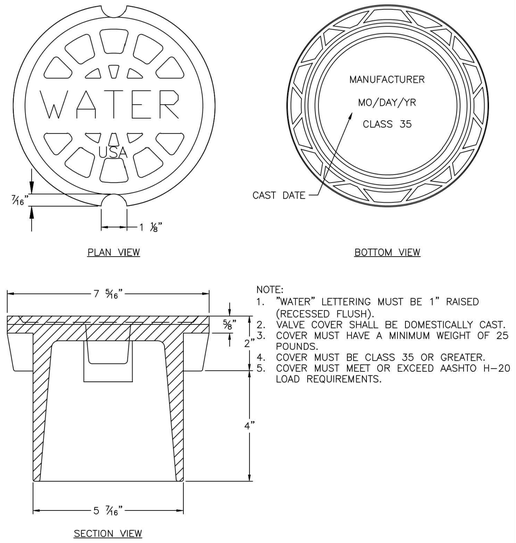

NOTE:
1. "WATER" LETTERING MUST BE 1" RAISED (RECESSED FLUSH).
2. VALVE COVER SHALL BE DOMESTICALLY CAST.
3. COVER MUST HAVE A MINIMUM WEIGHT OF 25 POUNDS.
4. COVER MUST BE CLASS 35 OR GREATER.
5. COVER MUST MEET OR EXCEED AASHTO H-20 LOAD REQUIREMENTS.

CITY OF RALEIGH
STANDARD DETAIL

REVISIONS	DATE: 01/18/2025 NOT TO SCALE
	5 ¼" VALVE BOX DROP LID WITH 4" SKIRT
	W-18

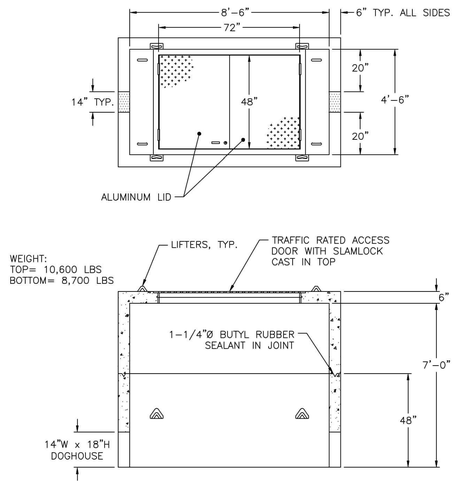

NOTES:
1. REINFORCEMENT: #4 @ 6" O.C.E.W.
2. CONCRETE: 4,000 PSI @ 28 DAYS.
3. 6" OF #67 STONE SHALL BE PLACED IN BOTTOM OF VAULT.
4. METER FLANGE SHALL BE PLACED 49" BELOW FINISHED GRADE.
5. HEIGHT ADJUSTMENTS ALLOWED BY PRECAST RISERS OR BRICK AND MORTAR. DRY STACKING OF BLOCK IS NOT ALLOWED.

CITY OF RALEIGH
STANDARD DETAIL

REVISIONS	DATE: 01/18/2025 NOT TO SCALE
	TYPICAL 6" THRU 10" WATER METER VAULT
	W-33

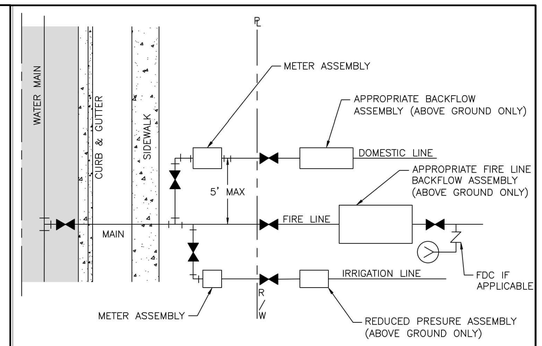

NOTES:
1. SERVICE TAPS FOR 2" AND SMALLER DOMESTIC SERVICES MAY BE BY CORPORATION COCKS. LARGER SERVICES WILL REQUIRE A TEE AND GATE VALVE OR TAPPING SLEEVE AND VALVE ASSEMBLY AND 90° BEND.
2. DOMESTIC SERVICE TAPS SHALL BE ALLOWED ON 4" AND LARGER FIRE LINE BEFORE THE BACKFLOW ASSEMBLY, PROVIDED THAT THE FIRE PROTECTION AND SPRINKLER PLANS AND SITE PLANS ARE SIGNED AND SEALED BY A PROFESSIONAL ENGINEER.
3. ONE DOMESTIC TAP PER FIRE LINE ON STREET SIDE OF BACKFLOW.
4. FIRE LINE SHALL HAVE A FIRE HYDRANT OR BLOW OFF ASSEMBLY AT ITS END TO FACILITATE FLUSHING WHEN NEEDED.
5. IRRIGATION METER SHALL BE LOCATED ON THE SIDE OF DOMESTIC METER WITH INCREASING ADDRESSES.
6. THE CONTAINMENT BACKFLOW ASSEMBLY SHALL BE INSTALLED WITHIN 50 LINEAR PIPING FEET OF THE METER OR RIGHT-OF-WAY FOR FIRE SERVICE LINES.
7. DOMESTIC/IRRIGATION BACKFLOW RISER/STANDPIPE SHALL BE OF APPROVED MATERIALS AS LISTED IN NC PLUMBING CODE.
8. THE RP RELIEF VALVE SHALL BE A MINIMUM OF 12" ABOVE ANY MATERIAL (MULCH INCLUDED) OR GRADE.
9. A SERVICE VALVE IS REQUIRED AFTER THE METER BUT BEFORE THE BACKFLOW ASSEMBLY FOR MAINTENANCE AND REPLACEMENT PURPOSES.
10. THE INSTALLATION MUST ALSO MEET ALL CODE REQUIREMENTS PER THE NC PLUMBING CODE.

CITY OF RALEIGH
STANDARD DETAIL

REVISIONS	DATE: 01/18/2025 NOT TO SCALE
	FIRE, DOMESTIC & IRRIGATION OPTIONS SCHEMATIC
	W-34

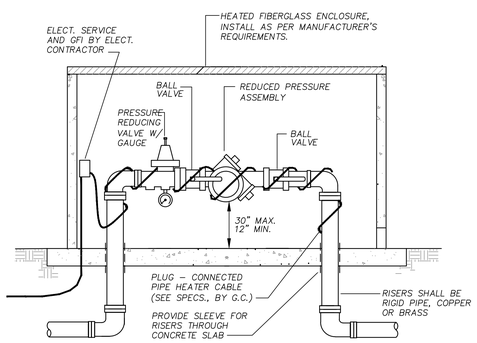

NOTES:
1. REDUCED PRESSURE ASSEMBLY SHALL BE WILKINS MODEL 975XL2 OR APPROVED EQUAL. ALL BACKFLOW PREVENTERS SHALL BE AS APPROVED BY THE LOCAL AUTHORITY HAVING JURISDICTION.
2. SEE SPECIFICATIONS FOR ADDITIONAL REQUIREMENTS OF BACKFLOW PREVENTER, VALVES, ENCLOSURE, ETC.
3. HEATER AND POWER CORD BY G.C.., SEE SPECIFICATIONS INSTALL PER MANUFACTURES INSTRUCTIONS.

REDUCED PRESSURE ASSEMBLY IN HEATED ENCLOSURE N.T.S.

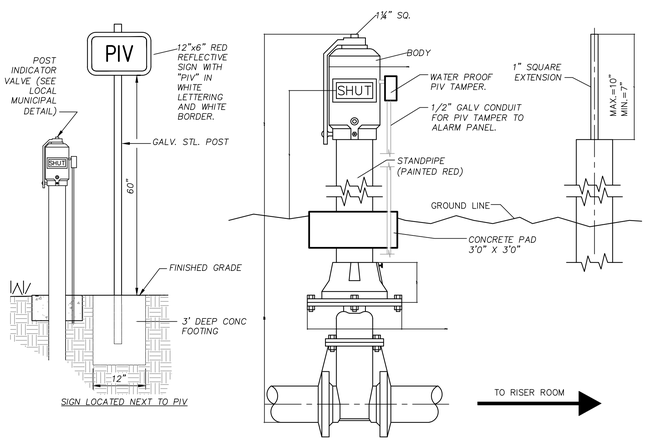

FIELD ADJUSTMENT INSTRUCTIONS

1. REMOVE THE BODY FROM THE TOP OF THE INDICATOR POST ASSEMBLY.
2. CUT THE REQUIRED LENGTH OFF THE BOTTOM OF THE STANDPIPE FOR THE GROUND LINE TO MATCH UP WITH STANDPIPE GROUND LINE MARK.
3. CUT THE 1" SQ. EXTENSION AT A DISTANCE OF 9" ABOVE THE TOP OF THE STANDPIPE.
4. SET THE "OPEN" AND "SHUT" TARGETS FOR THE APPROPRIATE VALVE SIZE.
5. RE-ATTACH THE BODY TO THE TOP OF THE INDICATOR POST ASSEMBLY.
6. ALL PIV(s) SHALL BE INSTALLED WITH AN ELECTRONICALLY CONTROLLED TAMPER SWITCH.

NOTE:

POST INDICATOR VALVE SHALL BE LOCATED AT A MINIMUM 40-ft FROM BUILDING

POST INDICATOR VALVE DETAIL N.T.S.

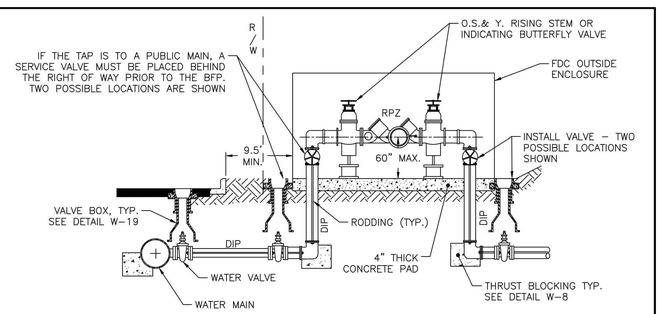

NOTES:
1. ENCLOSURE MUST BE ASSE 1060 APPROVED AND HAVE ADEQUATE DRAINAGE.
2. CONTAINMENT RPZ/RPDA BACKFLOW ASSEMBLIES ARE TO BE INSTALLED WITHIN 50 LINEAR PIPING FEET OF THE METER OR RIGHT-OF-WAY FOR FIRE SERVICE LINES AND MEET INSTALLATION REQUIREMENTS AS LISTED IN APPENDIX A: GUIDELINES AND REQUIREMENTS OF THE CROSS CONNECTION AND HYDRANT METER PROGRAM.
3. NO VALVE IN THE EXISTING SYSTEM SHALL BE OPERATED WITHOUT FOLLOWING THE PROCEDURE OUTLINED IN THE RALEIGH WATER PUBLIC UTILITY DESIGN MANUAL. THE CONTRACTOR SHALL NOTIFY RALEIGH WATER'S DISTRIBUTION DIVISION AT 919-996-3245 TO REQUEST THE OPERATION OF ANY VALVE.
4. RESIDENTIAL LAWN IRRIGATION R.P. ASSEMBLIES THAT ARE REMOVED TO PREVENT FREEZING IN THE WINTER MONTHS MUST BE CAPPED OFF. ALL ABOVE GROUND ASSEMBLIES, EXCEPT RESIDENTIAL LAWN IRRIGATION ASSEMBLIES, MUST BE PROTECTED FROM FROST.
5. ALL CONTAINMENT BACKFLOW ASSEMBLIES MUST BE ASSE AND USC APPROVED.
6. STEEL RODS AND BOLTS SHALL BE ¾" 316 STAINLESS STEEL.

CITY OF RALEIGH
STANDARD DETAIL

REVISIONS	DATE: 01/18/2025 NOT TO SCALE
	REDUCED PRESSURE ZONE AND REDUCED PRESSURE DETECTOR ASSEMBLY
	W-36

CITY OF RALEIGH WATER DETAILS N.T.S.

adw architects
environments for life
architecture planning interiors
2815 coliseum centre drive
suite 500
charlotte, nc 28217
704.379.1919
adwarchitects.com

Rolesville
Genuine Community • Capital Connection
Est. 1837

ROLESVILLE POLICE

CLH DESIGN

CLH design, p.a.
400 Regency Forest Drive
Suite 120
Cary, NC 27518
Phone: 919.319.6716
LA: C-106, PE: C-1595

TOWN OF ROLESVILLE POLICE DEPARTMENT

ROLESVILLE, NC 27571

UTILITY DETAILS

DATE: 08-19-2026
PROJECT NO:
CLH PROJECT NO: 25-108

THIS DRAWING IS THE PROPERTY OF ADW ARCHITECTS, P.A. AND SHALL NOT BE REPRODUCED OR COPIED IN WHOLE OR PART. IT SHALL NOT BE USED ON ANY OTHER PROJECT OR GIVEN TO ANY OTHER COMPANY OR AGENCY WITHOUT THE CONSENT OF ADW ARCHITECTS, P.A.

SHEET NUMBER:
C-9.02

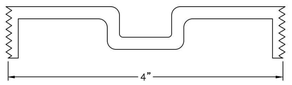

STANDARD 4" BRONZE CLEANOUT PLUG

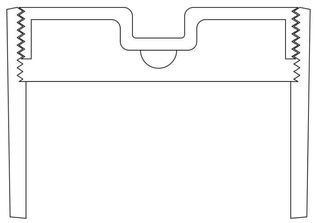

CLEANOUT FERRULE WITH PLUG

STYLES ACCEPTED:
INVERTED NUT
RAISED NUT

CITY OF RALEIGH
STANDARD DETAIL

REVISIONS	DATE: 01/18/2025	NOT TO SCALE
	4" CLEANOUT PLUG	
	S-34	

NOTES:

1. THE FULL LENGTH OF THE SERVICE DITCH SHALL BE COMPACTED IN 6" LIFTS WITH MECHANICAL TAMP. ALL TAPS WILL BE MADE USING MECHANICAL TAPPING MACHINE. FOR PVC INSTALLATIONS, SADDLE AND BEND MUST BE BEDDED IN #67 STONE. BEDDING AND HAUNCHING OF PIPE BARREL MUST COMPLY WITH REQUIREMENTS OF DETAIL S-4 OR S-5 ACCORDING TO PIPE MATERIAL.
2. WHEN SEWER CLEAN OUT IS IN PAVEMENT OR IMPERVIOUS SURFACE, IT SHALL BE INSTALLED AS SHOWN IN DETAIL S-30B.
3. INSTALLATIONS BY UTILITY CONTRACTORS BEYOND THE PROPERTY OR EASEMENT LINE REQUIRE A "PLUMBING UTILITY" PERMIT AND ARE INSPECTED BY THE PLUMBING INSPECTOR. DO NOT BACKFILL PRIOR TO INSPECTION.

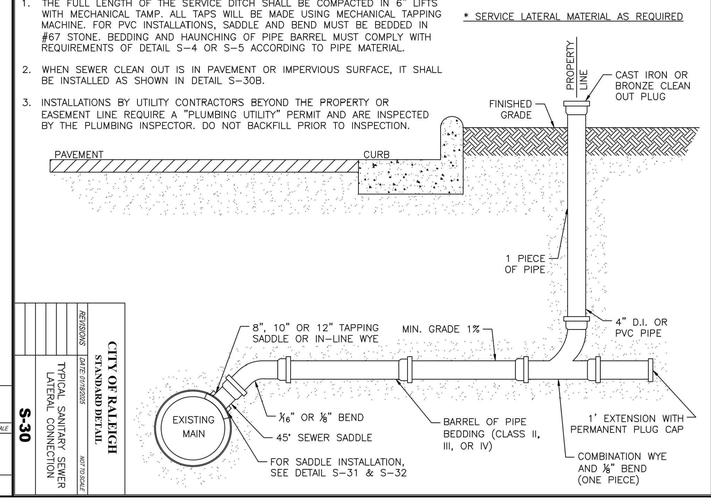

REVISIONS	DATE: 01/18/2025	NOT TO SCALE
TYPICAL SANITARY SEWER LATERAL CONNECTION		
S-30		

CITY OF RALEIGH
STANDARD DETAIL

NOTES:

1. THE TRACER WIRE SHALL BE CONTINUOUS TO THE GREATEST EXTENT POSSIBLE. WHERE JOINTS ARE NECESSITATED IN THE WIRE, THE JOINTS SHALL BE SECURELY BONDED TOGETHER WITH AN APPROVED INDUSTRIAL CRIMP CONNECTOR TO PROVIDE ELECTRICAL CONTINUITY. CRIMPS SHALL BE SIMILAR METAL.
2. THE CLEANOUT AT THE RIGHT OF WAY AND/OR EASEMENT SHALL SERVE AS THE TEST PORT WITH THE TRACING WIRE BROUGHT UP OUTSIDE THE CLEANOUT ASSEMBLY AND WRAPPED AROUND THE STACK TWICE AT A DEPTH OF APPROXIMATELY 12" BELOW GRADE.
3. SPLICED CONNECTIONS SHALL BE ALLOWED BETWEEN THE MAIN LINE TRACER WIRE AND THE LATERAL TRACER WIRE.
4. FOR NEW SEWER TAPS ON EXISTING MAINS VOID OF ANY TRACER WIRE, PROVIDE AN ANODE FOR THE TRACING WIRE TERMINATION AT THE POINT OF THE NEW TAP ON THE EXISTING SEWER MAIN.

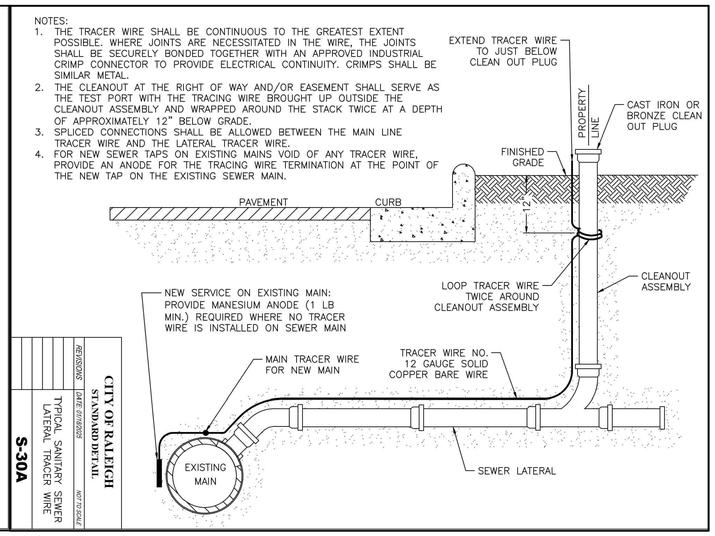

REVISIONS	DATE: 01/18/2025	NOT TO SCALE
TYPICAL SANITARY SEWER LATERAL TRACER WIRE		
S-30A		

CITY OF RALEIGH
STANDARD DETAIL

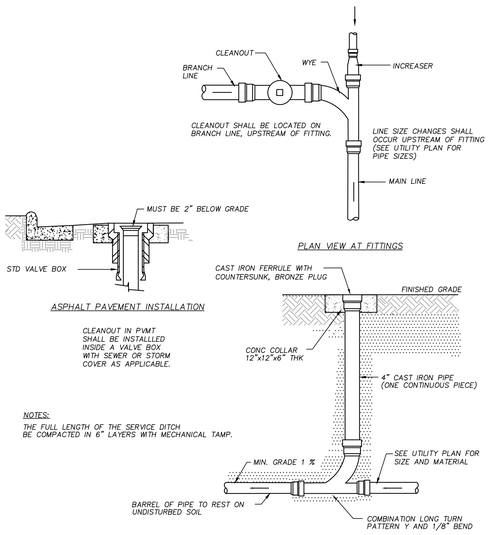

STANDARD CLEANOUT N.T.S.

adw architects
environments for life
architecture planning interiors
2815 coliseum centre drive
suite 500
charlotte, nc 28217
704.379.1919
adwarchitects.com

Rolesville
Genuine Community • Capital Connection
Est. 1837

ROLESVILLE POLICE

CLH DESIGN
CLH design, p.a.
400 Regency Forest Drive
Suite 120
Cary, NC 27518
Phone: 919.319.6716
LA: C-106, PE: C-1595

TOWN OF ROLESVILLE POLICE DEPARTMENT

ROLESVILLE, NC 27571

UTILITY DETAILS

DATE: 08-19-2026
PROJECT NO:
CLH PROJECT NO: 25-108

THIS DRAWING IS THE PROPERTY OF ADW ARCHITECTS, P.A. AND SHALL NOT BE REPRODUCED OR COPIED IN WHOLE OR PART. IT SHALL NOT BE USED ON ANY OTHER PROJECT OR GIVEN TO ANY OTHER COMPANY OR AGENCY WITHOUT THE CONSENT OF ADW ARCHITECTS, P.A.

SHEET NUMBER:
C-9.03

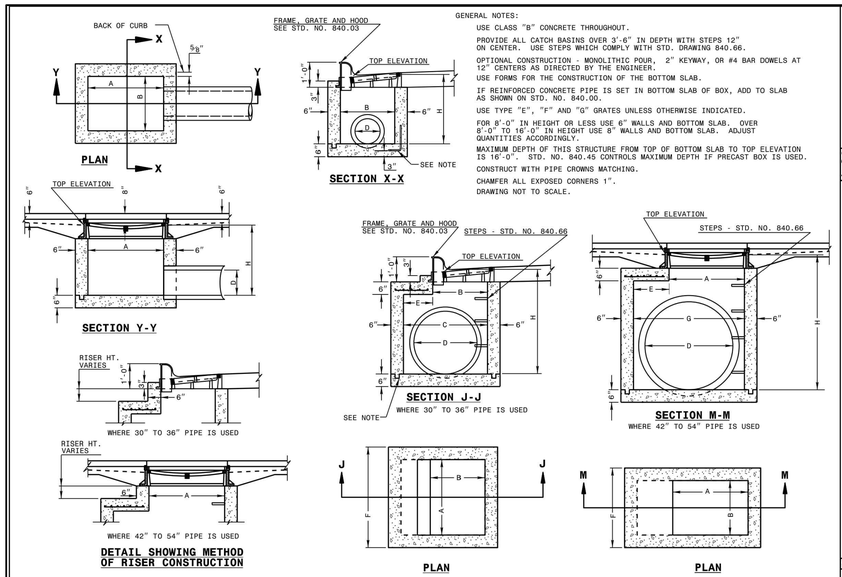

GENERAL NOTES:

USE CLASS "B" CONCRETE THROUGHOUT.

PROVIDE ALL CATCH BASINS OVER 3'-6" IN DEPTH WITH STEPS 12" ON CENTER. USE STEPS WHICH COMPLY WITH STD. DRAWING 840.66.

OPTIONAL CONSTRUCTION - MONOLITHIC POUR, 2" KEYWAY, OR #4 BAR DOWELS AT 12" CENTERS AS DIRECTED BY THE ENGINEER.

USE FORMS FOR THE CONSTRUCTION OF THE BOTTOM SLAB.

IF REINFORCED CONCRETE PIPE IS SET IN BOTTOM SLAB OF BOX, ADD TO SLAB AS SHOWN ON STD. NO. 840.00.

USE TYPE "E", "F" AND "G" GRATES UNLESS OTHERWISE INDICATED.

FOR 8'-0" IN HEIGHT OR LESS USE 6" WALLS AND BOTTOM SLAB. OVER 8'-0" TO 16'-0" IN HEIGHT USE 8" WALLS AND BOTTOM SLAB. ADJUST QUANTITIES ACCORDINGLY.

MAXIMUM DEPTH OF THIS STRUCTURE FROM TOP OF BOTTOM SLAB TO TOP ELEVATION IS 16'-0". STD. NO. 840.45 CONTROLS MAXIMUM DEPTH IF PRECAST BOX IS USED.

CONSTRUCT WITH PIPE CROWNS MATCHING.

CHAMFER ALL EXPOSED CORNERS 1".

DRAWING NOT TO SCALE.

1-24 STATE OF NORTH CAROLINA DEPT. OF TRANSPORTATION DIVISION OF HIGHWAYS RALEIGH, N.C.

ROADWAY STANDARD DRAWING FOR **CONCRETE CATCH BASIN** 12" THRU 54" PIPE

SHEET 1 OF 2 **840.02**

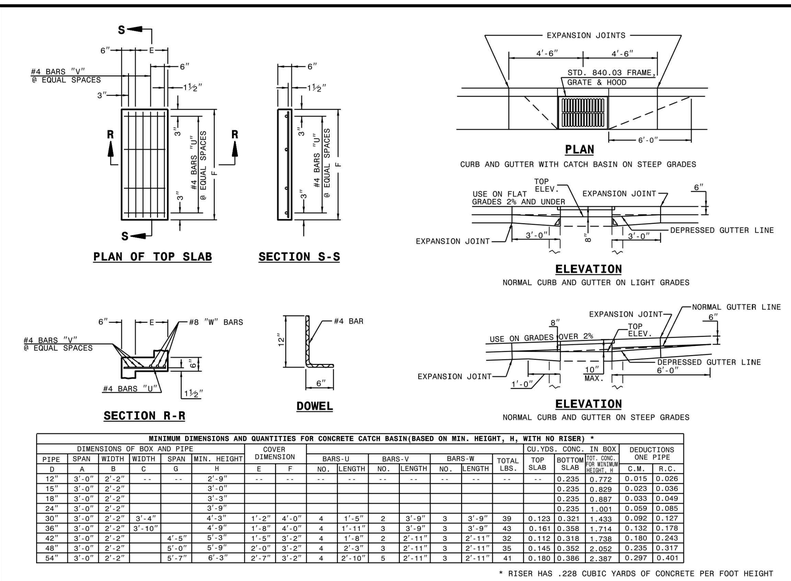

MINIMUM DIMENSIONS AND QUANTITIES FOR CONCRETE CATCH BASIN(BASED ON MIN. HEIGHT, H, WITH NO RISER) *																			
DIMENSIONS OF BOX AND PIPE						COVER DIMENSION		BARS-U		BARS-V		BARS-W		TOTAL LBS.	CU.YDS. CONC. IN BOX		DEDUCTIONS ONE PIPE	
PIPE	SPAN	WIDTH	WIDTH	SPAN	MIN. HEIGHT	E	F	NO.	LENGTH	NO.	LENGTH	NO.	LENGTH		TOP SLAB	BOTTOM SLAB	TOT. CONC. FOR MINIMUM HEIGHT, H	C.M.	R.C.
D	A	B	C	G	H														
12"	3'-0"	2'-2"	--	--	2'-9"	--	--	--	--	--	--	--	--	--	--	0.235	0.772	0.015	0.026
15"	3'-0"	2'-2"			3'-0"											0.235	0.829	0.023	0.036
18"	3'-0"	2'-2"			3'-3"											0.235	0.887	0.033	0.049
24"	3'-0"	2'-2"			3'-9"											0.235	1.001	0.059	0.085
30"	3'-0"	2'-2"	3'-4"		4'-3"	1'-2"	4'-0"	4	1'-5"	2	3'-9"	3	3'-9"	39	0.123	0.321	1.433	0.092	0.127
36"	3'-0"	2'-2"	3'-10"		4'-9"	1'-8"	4'-0"	4	1'-11"	3	3'-9"	3	3'-9"	43	0.161	0.358	1.714	0.132	0.178
42"	3'-0"	2'-2"		4'-5"	5'-3"	1'-5"	3'-2"	4	1'-8"	2	2'-11"	3	2'-11"	32	0.112	0.318	1.738	0.180	0.243
48"	3'-0"	2'-2"		5'-0"	5'-9"	2'-0"	3'-2"	4	2'-3"	3	2'-11"	3	2'-11"	35	0.145	0.352	2.052	0.235	0.317
54"	3'-0"	2'-2"		5'-7"	6'-3"	2'-7"	3'-2"	4	2'-10"	5	2'-11"	3	2'-11"	41	0.180	0.386	2.387	0.297	0.401

* RISER HAS .228 CUBIC YARDS OF CONCRETE PER FOOT HEIGHT

1-24 STATE OF NORTH CAROLINA DEPT. OF TRANSPORTATION DIVISION OF HIGHWAYS RALEIGH, N.C.

ROADWAY STANDARD DRAWING FOR **CONCRETE CATCH BASIN** 12" THRU 54" PIPE

SHEET 2 OF 2 **840.02**

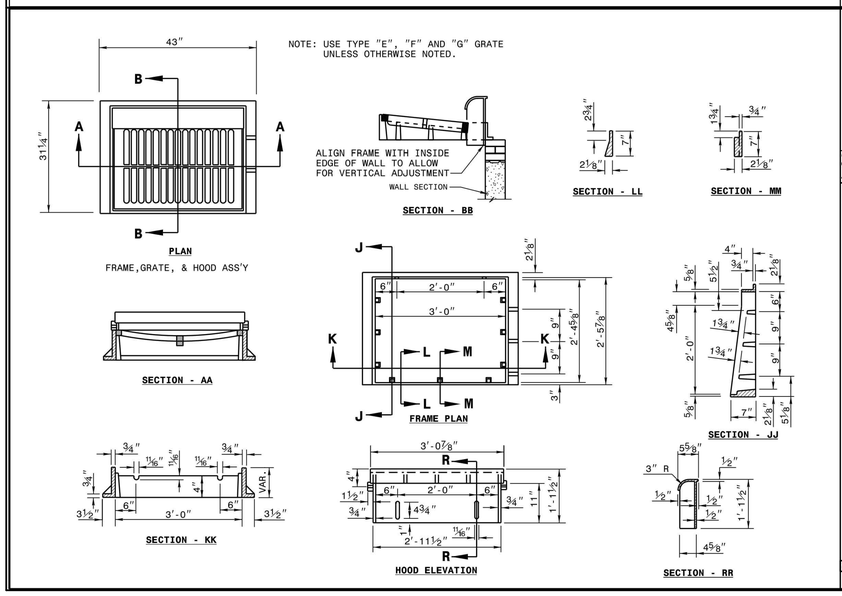

1-24 STATE OF NORTH CAROLINA DEPT. OF TRANSPORTATION DIVISION OF HIGHWAYS RALEIGH, N.C.

ROADWAY STANDARD DRAWING FOR **FRAME, GRATES, AND HOOD** FOR USE ON STANDARD CATCH BASIN

SHEET 1 OF 2 **840.03**

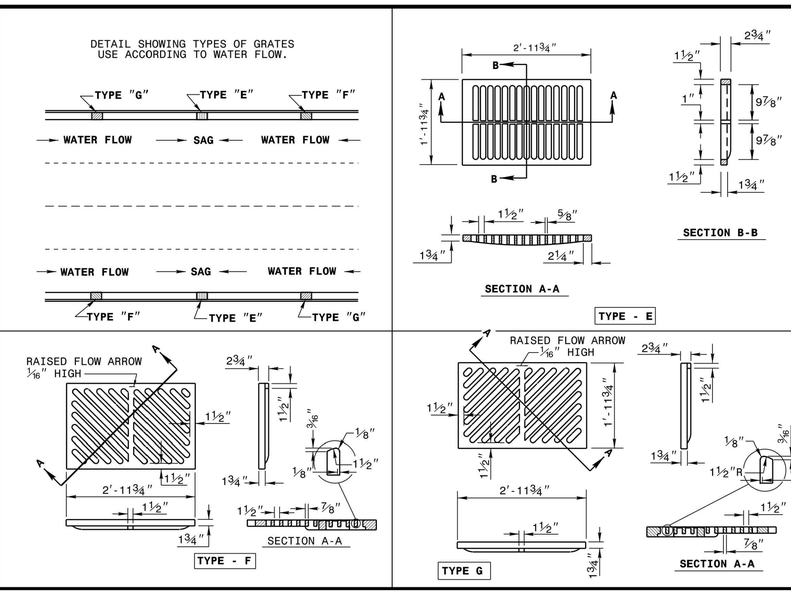

1-24 STATE OF NORTH CAROLINA DEPT. OF TRANSPORTATION DIVISION OF HIGHWAYS RALEIGH, N.C.

ROADWAY STANDARD DRAWING FOR **FRAME, GRATES, AND HOOD** FOR USE ON STANDARD CATCH BASIN

SHEET 2 OF 2 **840.03**

adw architects
environments for life
architecture planning interiors
2815 coliseum centre drive
suite 500
charlotte, nc 28217
704.379.1919
adwarchitects.com

Rolesville
Genuine Community • Capital Connection
Est. 1837

ROLESVILLE POLICE

CLH DESIGN
CLH design, p.a.
400 Regency Forest Drive
Suite 120
Cary, NC 27518
Phone: 919.319.6716
LA: C-106, PE: C-1595

TOWN OF ROLESVILLE POLICE DEPARTMENT

ROLESVILLE, NC 27571

UTILITY DETAILS

DATE: 08-19-2026
PROJECT NO:
CLH PROJECT NO: 25-108

THIS DRAWING IS THE PROPERTY OF ADW ARCHITECTS, P.A. AND SHALL NOT BE REPRODUCED OR COPIED IN WHOLE OR PART. IT SHALL NOT BE USED ON ANY OTHER PROJECT OR GIVEN TO ANY OTHER COMPANY OR AGENCY WITHOUT THE CONSENT OF ADW ARCHITECTS, P.A.

SHEET NUMBER:
C-9.04

CATCH BASIN DETAIL *N.T.S.*

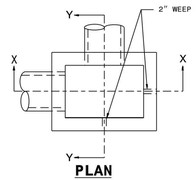

PLAN

WITH GRATE & FRAME REMOVED

GENERAL NOTES:

USE CLASS "B" CONCRETE THROUGHOUT.

PROVIDE ALL DROP INLETS OVER 3'-6" IN DEPTH WITH STEPS 12" ON CENTER. USE STEPS WHICH COMPLY WITH STD. DRAWING 840.66.

OPTIONAL CONSTRUCTION - MONOLITHIC POUR 2" KEYWAY OR #4 BAR DOWELS AT 12" CENTERS AS DIRECTED BY THE ENGINEER.

USE FORMS FOR THE CONSTRUCTION OF THE BOTTOM SLAB.

IF REINFORCED CONCRETE PIPE IS SET IN BOTTOM SLAB OF BOX, ADD TO SLAB AS SHOWN ON STD. NO. 840.00.

MAX.DEPTH OF THIS STRUCTURE FROM TOP OF BOTTOM SLAB TO TOP ELEVATION IS 12'-0". STD. DWG. 840.45 OR 840.46 CONTROLS MAXIMUM DEPTH IF PRECAST BOX IS USED.

CONSTRUCT WITH PIPE CROWNS MATCHING.

SEE STANDARD DRAWING 840.25 FOR ATTACHMENT OF FRAMES AND GRATES NOT SHOWN.

INSTALL 2" WEEPHOLES AS DIRECTED BY THE ENGINEER.

INSTALL STONE DRAINS, OF A MINIMUM OF 1 CUBIC FOOT OF NO. 78M STONE IN A POROUS FABRIC BAG OR WRAP, AT EACH WEEP HOLE OR AS DIRECTED BY THE ENGINEER.

CHAMFER ALL EXPOSED CORNERS 1".

DRAWING NOT TO SCALE.

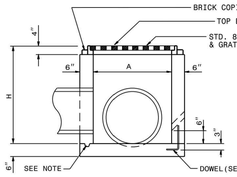

SECTION X-X

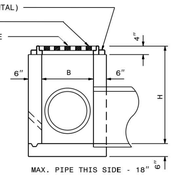

SECTION Y-Y

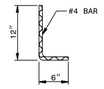

DOWEL

DIMENSIONS AND QUANTITIES FOR DROP INLET(BASED ON MIN. HEIGHT, H)								
DIMENSIONS OF BOX & PIPE				CUBIC YARDS CONC. IN BOX			DEDUCTIONS FOR ONE PIPE	
PIPE	SPAN	WIDTH	MIN. HEIGHT					
D	A	B	H	BOTTOM SLAB	WALL PER FT. HT.	TOTAL CONCRETE FOR MINIMUM HEIGHT	C.M.	R.C.
12"	3'-0"	2'-0"	2'-0"	0.222	0.222	0.592	0.015	0.026
15"			2'-3"			0.648	0.023	0.036
18"			2'-6"			0.703	0.033	0.049
24"			3'-0"			0.814	0.059	0.085
30"	3'-0"	2'-0"	3'-6"	0.222	0.222	0.925	0.092	0.127

STATE OF NORTH CAROLINA
DEPT. OF TRANSPORTATION
DIVISION OF HIGHWAYS
RALEIGH, N.C.

1-24

ROADWAY STANDARD DRAWING FOR
CONCRETE DROP INLET
12" THRU 30" PIPE

SHEET 1 OF 1
840.14

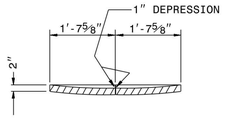

SECTION G-G

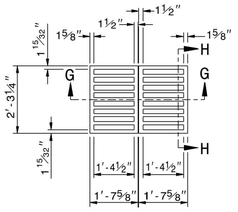

PLAN OF GRATING

CAST IRON

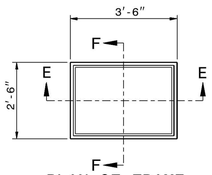

PLAN OF FRAME

CAST IRON

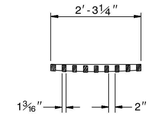

SECTION H-H

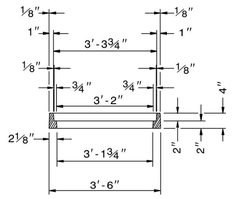

SECTION E-E

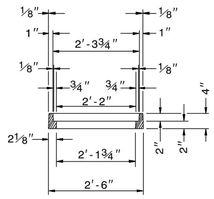

SECTION F-F

STATE OF NORTH CAROLINA
DEPT. OF TRANSPORTATION
DIVISION OF HIGHWAYS
RALEIGH, N.C.

1-24

ROADWAY STANDARD DRAWING FOR
DROP INLET FRAME AND GRATES
FOR USE WITH STD. DWG.S 840.14 AND 840.15

SHEET 1 OF 1
840.16

DROP INLET DETAIL *N.T.S.*

STORMWATER DETAILS *N.T.S.*

adw architects
environments for life
architecture planning interiors
2815 coliseum centre drive
suite 500
charlotte, nc 28217
704.379.1919
adwarchitects.com

Rolesville
Genuine Community • Capital Connection
Est. 1837

ROLESVILLE POLICE

CLH DESIGN

CLH design, p.a.
400 Regency Forest Drive
Suite 120
Cary, NC 27518
Phone: 919.319.6716
LA: C-106, PE: C-1595

TOWN OF ROLESVILLE POLICE DEPARTMENT

ROLESVILLE, NC 27571

UTILITY DETAILS

DATE: 08-19-2026
PROJECT NO:
CLH PROJECT NO: 25-108

THIS DRAWING IS THE PROPERTY OF ADW ARCHITECTS, P.A. AND SHALL NOT BE REPRODUCED OR COPIED IN WHOLE OR PART. IT SHALL NOT BE USED ON ANY OTHER PROJECT OR GIVEN TO ANY OTHER COMPANY OR AGENCY WITHOUT THE CONSENT OF ADW ARCHITECTS, P.A.

SHEET NUMBER:
C-9.05

9 **Jacqueline Thompson**
Please include a pipe backfill and trench detail to verify backfill, compaction, and materials required for storm pipe.

NOTE:
PUBLIC SAFETY USES INCLUDED IN GOVERNMENT FACILITY USES ARE EXEMPT FROM MEETING THE TRANSPARENCY REQUIREMENTS PER LDO 6.8.2.D.2

NOTE:
FACADE ADJACENT TO RESIDENTIALLY ZONED PROPERTY SO COMPLIANCE WITH LDO 6.8.2 IS REQUIRED

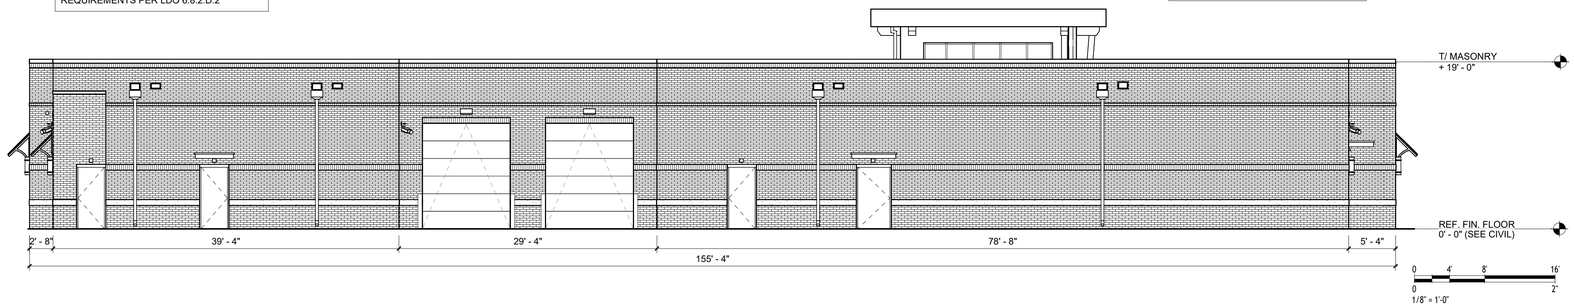

NORTH ELEVATION | 1/8" = 1'-0" 4

LDO 6.8.2.D DESIGN STANDARDS COMPLIANCE:

1. FACADES:
   a. VERTICAL MASS: NOT APPLICABLE W/ ONE STORY BUILDING
   b. ROOF LINES: NOT APPLICABLE W/ GOVERNMENT FACILITY USES
   c. HORIZONTAL MASS: NOT APPLICABLE W/ BUILDINGS LESS THAN 35' IN HEIGHT.
   d. WALL OFFSETS: FACADES OF 60 FEET OR GREATER IN WIDTH SHALL INCORPORATE WALL OFFSETS OF AT LEAST ONE FOOT OF DEPTH (* MINIMUM OF EVERY 40 FEET)
   e. REPEATING DESIGN PATTERNS: IN COMPLIANCE
2. TRANSPARENCY: NOT APPLICABLE W/ PUBLIC SAFETY USES INCLUDED IN GOVERNMENT FACILITY USES.
3. BUILDING BLANK WALL AREA: MAXIMUM CONTINUOUS BLANK WALL AREA FOR ANY BUILDINGS IN BUSINESS, INDUSTRY, AND TECHNOLOGY (BT) DISTRICTS SHALL BE A MAXIMUM OF 100 LINEAR FEET. SEE DIMENSIONAL FLOOR PLAN IN CONJUNCTION W/ EXTERIOR ELEVATIONS FOR COMPLIANCE VERIFICATION.
4. MATERIALS: AT LEAST 60% OF THE FACADE FACING A PUBLIC OR PRIVATE STREET SHALL BE BRICK OR STONE (OR A COMBINATION). REFER TO CALCULATIONS ON APPLICABLE ELEVATIONS FOR COMPLIANCE VERIFICATION.
5. COLORS: SPECIFIED EXTERIOR FINISH MATERIALS ARE IN LOW REFLECTANCE EARTH TONES, MUTED, SUBTLE, OR NEUTRAL COLORS.
6. MINIMUM DESIGN ITEMS:
   a. A CHANGE IN PLANE
   b. COMPLEMENTARY CHANGE IN MATERIAL OR TEXTURE
   c. COMPLEMENTARY CHANGE IN COLOR
   d. DIFFERING BUILDING SETBACKS OR PROJECTIONS

MATERIALS:
FACADE AREA = 2,280 SF
MASONRY/STONE AREA = 1,927 SF
85% OF TOTAL FACADE AREA
IN COMPLIANCE W/ 60% MIN.

NOTE:
PUBLIC SAFETY USES INCLUDED IN GOVERNMENT FACILITY USES ARE EXEMPT FROM MEETING THE TRANSPARENCY REQUIREMENTS PER LDO 6.8.2.D.2

NOTE:
FACADE FACES PUBLIC STREET/R.O.W. SO COMPLIANCE WITH LDO 6.8.2 IS REQUIRED

SIGNAGE UNDER SEPARATE PERMIT
(FOR ILLUSTRATIVE PURPOSES ONLY)

200 SF TOTAL SIGN AREA ALLOWED
94 SF TOTAL SIGN AREA INDICATED

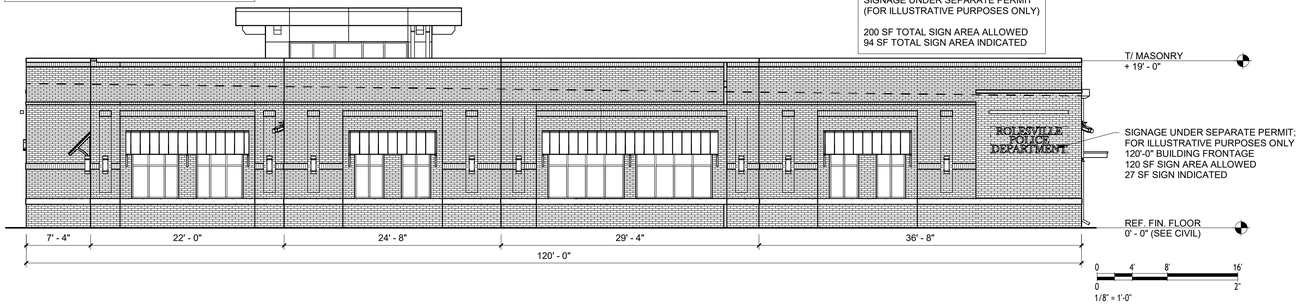

EAST ELEVATION | 1/8" = 1'-0" 3

NOTE:
PUBLIC SAFETY USES INCLUDED IN GOVERNMENT FACILITY USES ARE EXEMPT FROM MEETING THE TRANSPARENCY REQUIREMENTS PER LDO 6.8.2.D.2

MATERIALS:
FACADE AREA = 3,085 SF
MASONRY/STONE AREA = 2,582 SF
84% OF TOTAL FACADE AREA
IN COMPLIANCE W/ 60% MIN.

SIGNAGE UNDER SEPARATE PERMIT;
FOR ILLUSTRATIVE PURPOSES ONLY
155'-4" BUILDING FRONTAGE
155 SF SIGN AREA ALLOWED
41 SF SIGN INDICATED

NOTE:
FACADE FACES PUBLIC STREET/R.O.W. SO COMPLIANCE WITH LDO 6.8.2 IS REQUIRED

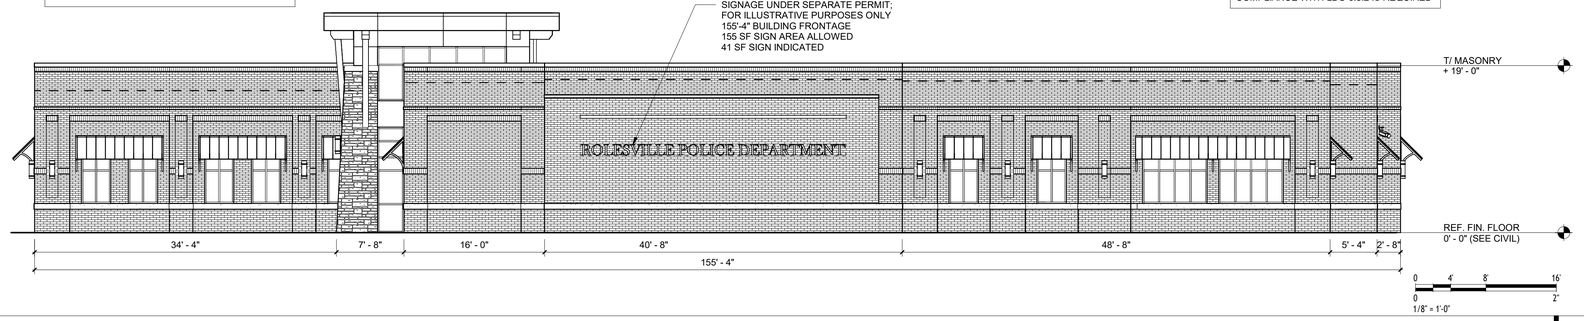

SOUTH ELEVATION | 1/8" = 1'-0" 2

NOTE:
FACADE FACES PRIVATE STREET SO COMPLIANCE WITH LOD 6.8.2 IS NOT REQUIRED

BUILDING ENTRANCE:
VARIATION IN BUILDING HEIGHT AND ARCHITECTURAL DETAILS

NOTE:
PUBLIC SAFETY USES INCLUDED IN GOVERNMENT FACILITY USES ARE EXEMPT FROM MEETING THE TRANSPARENCY REQUIREMENTS PER LDO 6.8.2.D.2

MATERIALS:
FACADE AREA = 2,407 SF
MASONRY/STONE AREA = 1,784 SF
74% OF TOTAL FACADE AREA
IN COMPLIANCE W/ 60% MIN.

SIGNAGE UNDER SEPARATE PERMIT;
FOR ILLUSTRATIVE PURPOSES ONLY
120'-0" BUILDING FRONTAGE
120 SF SIGN AREA ALLOWED
26 SF SIGN INDICATED

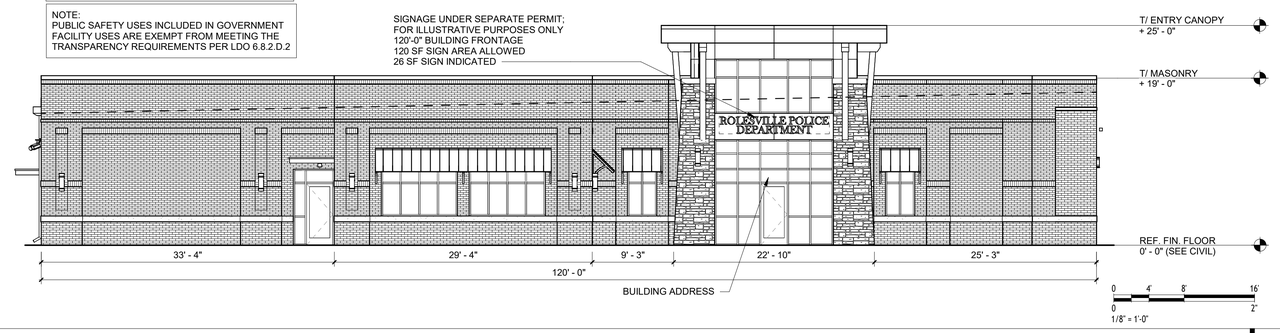

WEST ELEVATION | 1/8" = 1'-0" 1

adwarchitects
environments for life
architecture planning interiors
2815 COLISEUM CENTRE DRIVE
SUITE 500
CHARLOTTE, NORTH CAROLINA 28217
P704.379.1919
F704.379.1920
www.adwarchitects.com

TOWN OF ROLESVILLE POLICE DEPARTMENT

ROLESVILLE, NC
27571

EXTERIOR ELEVATIONS

DATE: 07/30/26
PROJECT NO: 24008

REVISIONS

NO:	DATE:	DESCRIPTION:

THIS DRAWING IS THE PROPERTY OF ADW ARCHITECTS, PA. AND SHALL NOT BE REPRODUCED OR COPIED IN WHOLE OR PART. IT SHALL NOT BE USED ON ANY OTHER PROJECT OR GIVEN TO ANY OTHER COMPANIY OR AGENCY WITHOUT THE CONSENT IF ADW ARCHITECTS, PA.

SEAL:

SHEET NUMBER:
AR200

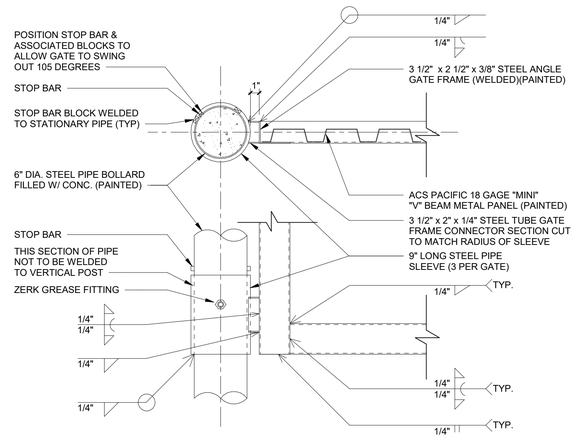

SLEEVE/HINGE DETAIL | 1 1/2" = 1'-0" | 5

NOTE:
DUMPSTER ENCLOSURE GATES & BOLLARDS TO BE PAINTED TO MATCH MTL-1

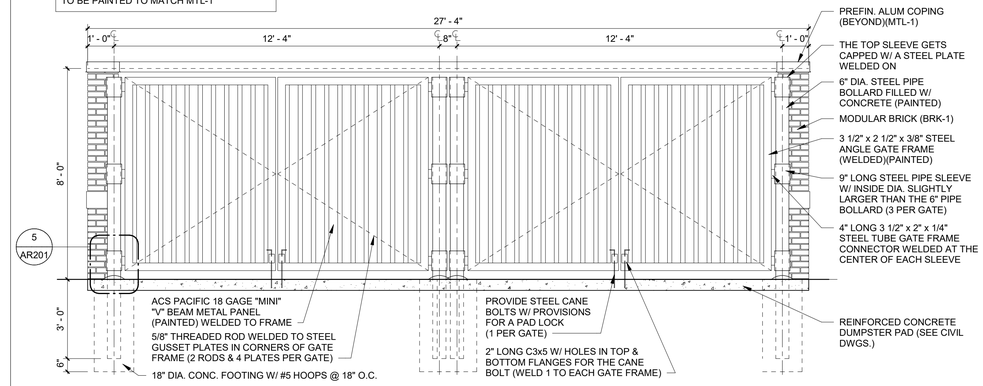

DUMPSTER FRONT ELEVATION | 3/8" = 1'-0" | 3

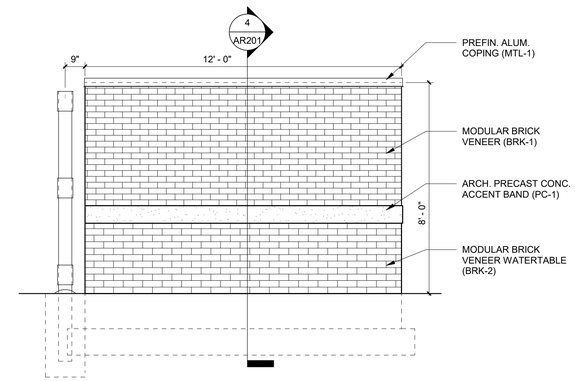

DUMPSTER SIDE ELEVATION | 3/8" = 1'-0" | 2

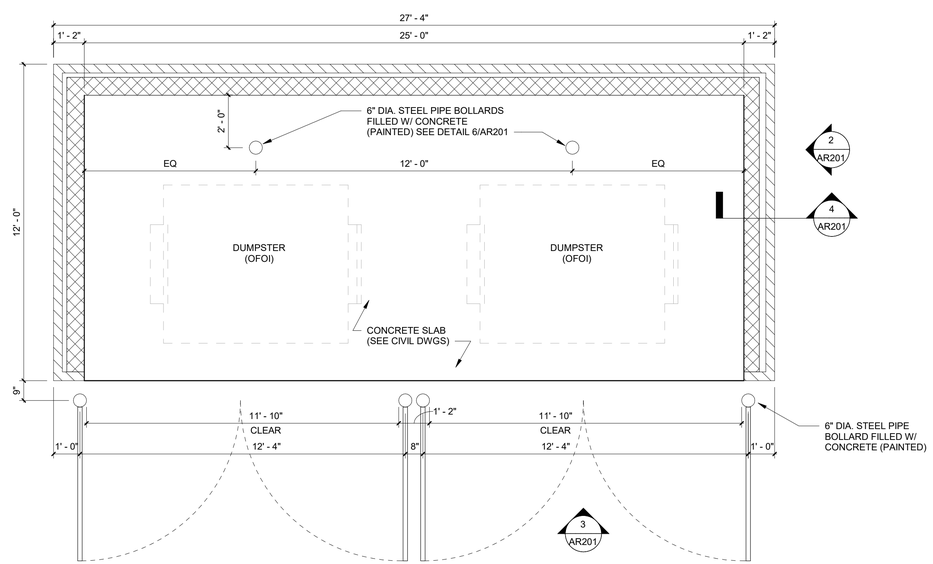

DUMPSTER ENCLOSURE PLAN | 3/8" = 1'-0" | 1

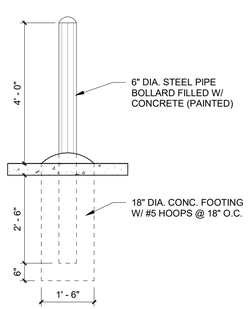

BOLLARD DETAIL | 1/2" = 1'-0" | 6

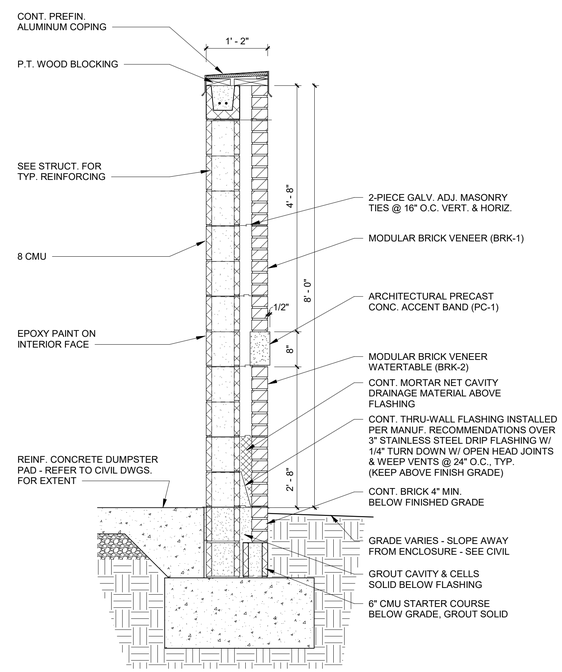

WALL SECTION @ ENCLOSURE | 3/4" = 1'-0" | 4

adwarchitects
environments for life
architecture planning interiors
2815 COLISEUM CENTRE DRIVE
SUITE 500
CHARLOTTE, NORTH CAROLINA 28217
P 704.379.1919
F 704.379.1920
www.adwarchitects.com

TOWN OF ROLESVILLE POLICE DEPARTMENT

ROLESVILLE, NC
27571

DUMPSTER ENCLOSURE DETAILS

DATE: 08/17/26
PROJECT NO: 24008
REVISIONS

NO:	DATE:	DESCRIPTION:

THIS DRAWING IS THE PROPERTY OF ADW ARCHITECTS, PA. AND SHALL NOT BE REPRODUCED OR COPIED IN WHOLE OR PART. IT SHALL NOT BE USED ON ANY OTHER PROJECT OR GIVEN TO ANY OTHER COMPANIY OR AGENCY WITHOUT THE CONSENT IF ADW ARCHITECTS, PA.

SEAL:

SHEET NUMBER:

AR201

GENERAL NOTES - SITE PLAN

A.	ALL LIGHTING AND POWER CONDUCTORS SHALL BE INSTALLED BETWEEN 24" (MINIMUM) AND 36" (MAXIMUM) BELOW FINISHED GRADE.
B.	ALL COMMUNICATIONS CONDUIT AND CABLES SHALL BE INSTALLED 36" (MINIMUM) BELOW FINISHED GRADE.
C.	ALL CONDUCTORS FOR EXTERIOR LIGHTING AND POWER CIRCUITS SHALL BE #10 AWG MINIMUM.
D.	PROVIDE TRANSFORMER BASE AT ALL POLE MOUNTED FIXTURES, TAP 2 LEGS OF THREE PHASE FEEDER (CIRCUITS DENOTED), PROVIDE BALLAST FUSES AT TAP, AND PROVIDE BRANCH CIRCUITS TO FIXTURES.

KEYNOTE LEGEND (#)

1	PROVIDE (2) 4" CONDUITS WITH PULLSTRING MINIMUM 3' BELOW GRADE FROM UTILITY TRANSFORMER TO LOCATION SHOWN FOR FUTURE UTILITY PATHWAY. CAP AND SEAL CONDUITS AND MARK LOCATION FOR FUTURE USE.
2	PROVIDE (2) 4" CONDUITS WITH PULLSTRING MINIMUM 3' BELOW GRADE FROM UTILITY TRANSFORMER TO UTILITY POINT OF SERVICE. CONFIRM EXACT LOCATION WITH UTILITY.

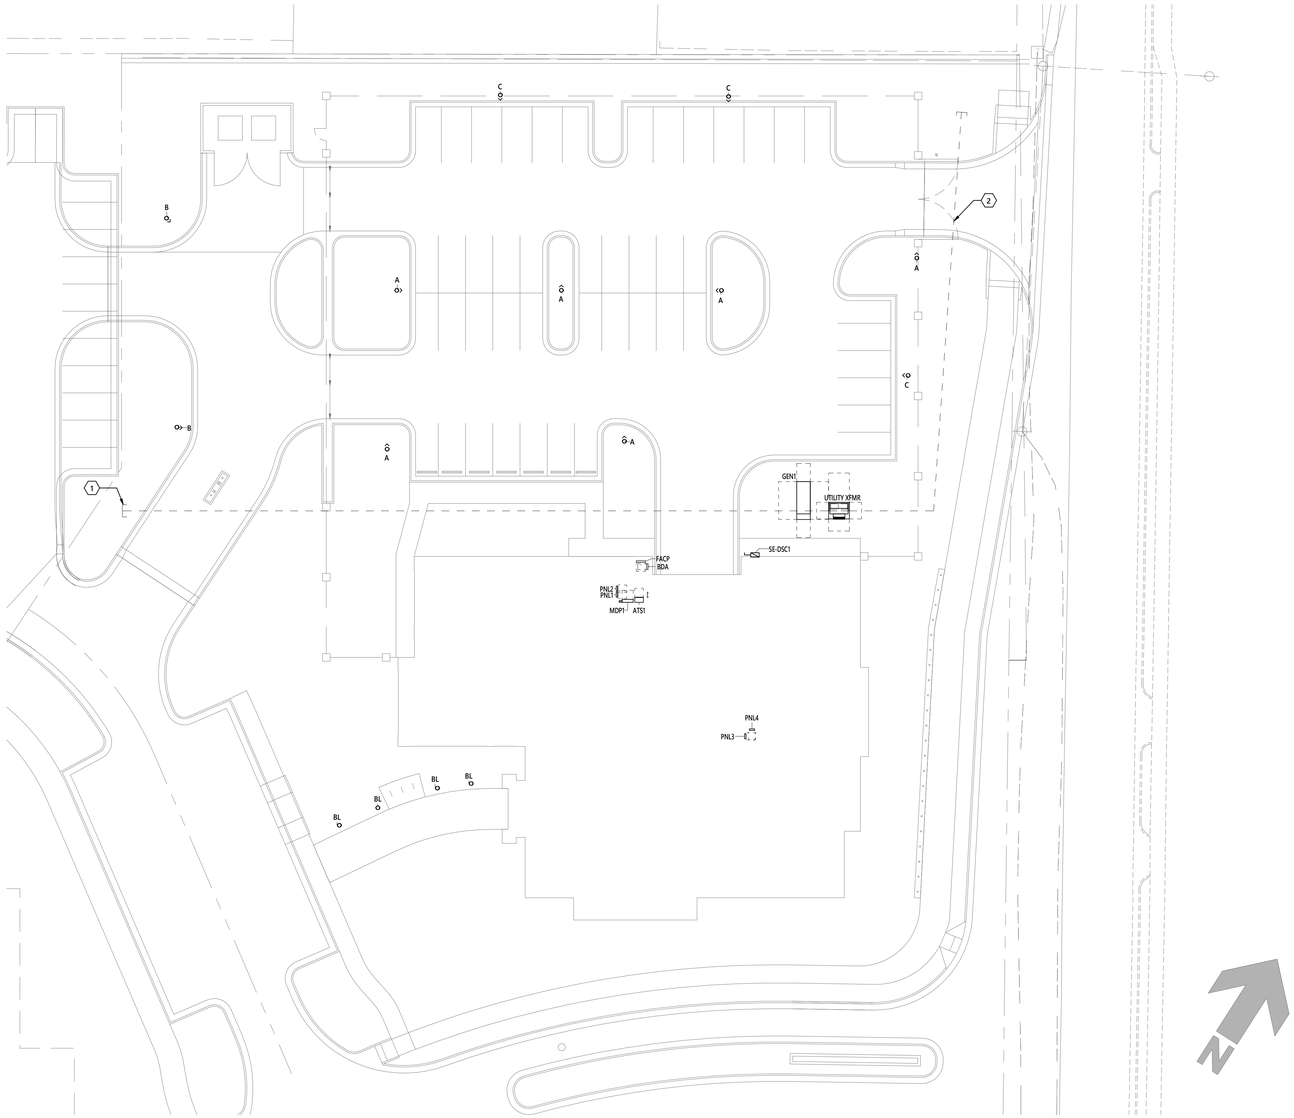

1 ELECTRICAL SITE PLAN
1" = 20'-0"

adwarchitects
environments for life
architecture planning interiors
2815 coliseum centre drive
suite 500
charlotte, nc 28217
704.379.1919
adwarchitects.com

Rolesville
Genuine Community • Capital Connection
Est. 1837

ROLESVILLE POLICE

optima engineering
434 Fayetteville St. Suite 2450, Raleigh NC 27601
Phone: 919.928.2200 · www.optimaengineering.com
North Carolina License Number C-0914

TOWN OF ROLESVILLE POLICE DEPARTMENT

ROLESVILLE, NC 27571

ELECTRICAL SITE PLAN

DATE: 04-10-26
PROJECT NO: 24008

REVISIONS

NO:	DATE:	DESCRIPTION:

THIS DRAWING IS THE PROPERTY OF ADW ARCHITECTS, P.A. AND SHALL NOT BE REPRODUCED OR COPIED IN WHOLE OR PART. IT SHALL NOT BE USED ON ANY OTHER PROJECT OR GIVEN TO ANY OTHER COMPANY OR AGENCY WITHOUT THE CONSENT OF ADW ARCHITECTS, P.A.

SHEET NUMBER:

E010

8/14/2026 11:30:15 AM

THIS DRAWING IS AN INSTRUMENT OF SERVICE. THE DRAWING AND THE INFORMATION THEREON IS THE PROPERTY OF OPTIMA ENGINEERING, P.A. ANY REPRODUCTION, ALTERATION, OR USE FOR OTHER THAN THE INTENDED PROJECT, WITHOUT THE WRITTEN CONSENT OF OPTIMA ENGINEERING, P.A. IS EXPRESSLY FORBIDDEN. COPYRIGHT © OPTIMA ENGINEERING P.A. 2026, ALL RIGHTS RESERVED.

GENERAL NOTES - SITE PLAN

A.	ALL LIGHTING AND POWER CONDUCTORS SHALL BE INSTALLED BETWEEN 24" (MINIMUM) AND 36" (MAXIMUM) BELOW FINISHED GRADE.
B.	ALL COMMUNICATIONS CONDUIT AND CABLES SHALL BE INSTALLED 36" (MINIMUM) BELOW FINISHED GRADE.
C.	ALL CONDUCTORS FOR EXTERIOR LIGHTING AND POWER CIRCUITS SHALL BE #10 AWG MINIMUM.
D.	PROVIDE TRANSFORMER BASE AT ALL POLE MOUNTED FIXTURES, TAP 2 LEGS OF THREE PHASE FEEDER (CIRCUITS DENOTED), PROVIDE BALLAST FUSES AT TAP, AND PROVIDE BRANCH CIRCUITS TO FIXTURES.

KEYNOTE LEGEND (1)

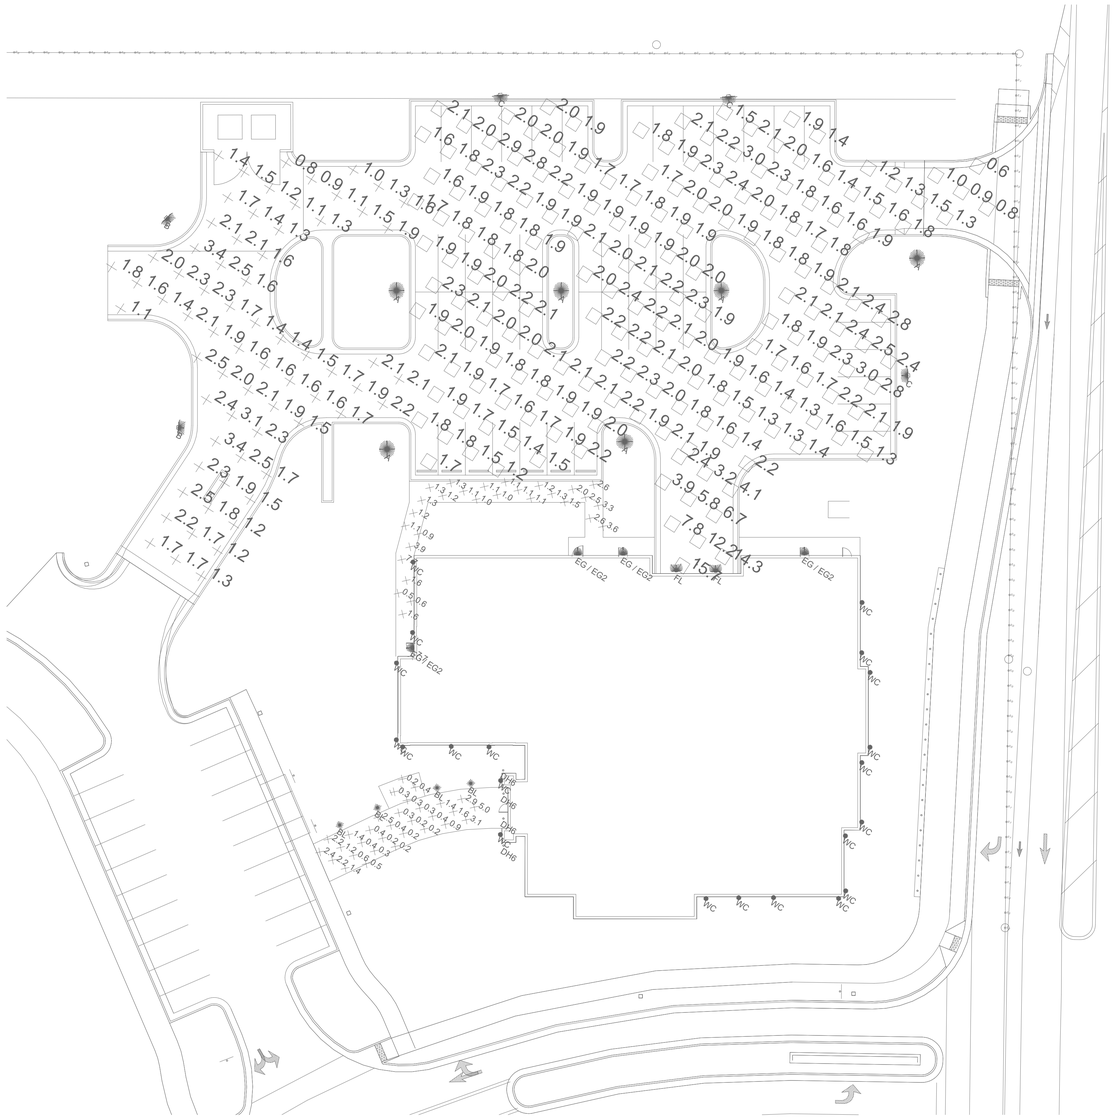

1 ELECTRICAL SITE PHOTOMETRICS PLAN
1" = 20'-0"

PHOTOMETRICS CALCULATION STATISTICS						
AREA	SYMBOL	AVG	MAX	MIN	AVG/MIN	MAX/MIN
FRONT WALKWAY	×	1.1 fc	5.0 fc	0.2 fc	5.5:1	25.0:1
GARAGE BAY AISLE		7.1 fc	15.7 fc	2.2 fc	3.2:1	7.1:1
PD PARKING LOT	■	1.9 fc	3.0 fc	0.6 fc	3.2:1	5.0:1
PD ROADWAY	+	1.8 fc	3.4 fc	0.8 fc	2.3:1	4.3:1
PROPERTY LINE		0.1 fc	0.7 fc	0.0 fc	N/A	N/A
BACK WALKWAY	×	2.0 fc	7.7 fc	0.5 fc	4.0:1	15.4:1

NOTES:
- ROADWAY CALCULATIONS ARE TAKEN AT GRADE AT 10' x 10' SPACING
- SIDEWALK CALCULATIONS ARE TAKEN AT GRADE AT 5' x 5' SPACING
- PROPERTY LINE CALCULATIONS ARE TAKEN AT GRADE AT 5' x 5' SPACING
- LIGHT LOSS FACTORS WERE TAKEN AT 0.9
- PROPERTY LINE MAX IS LESS THAN 1 FOR PUBLIC WAY (AT ROADWAYS) AND LESS THAN 0.3 FOR RESIDENTIAL BOARDING PROPERTY

ROLESVILLE SITE LIGHTING REQUIREMENTS				
AREA	AVG	MAX	MIN	AVG/MIN
PARKING	1.9fc - 2.9fc	6.0 fc	0.2fc	6.0:1
ROADS	1.0fc	N/A	N/A	4.0:1
SIDEWALKS	0.8fc	N/A	N/A	6.0:1
PROPERTY LINE (RESIDENTIAL)	N/A	0.3	N/A	N/A
PROPERTY LINE (ROADWAY)	N/A	0.1	N/A	N/A
OUTDOOR LIGHTING FIXTURES SHALL BE DESIGNED, LOCATED AND MOUNTED AT HEIGHTS NO GREATER THAN 18 FEET ABOVE GRADE FOR NON-CUTOFF LIGHTS AND FOR WALL-PACK UNITS, AND 35 FEET ABOVE GRADE FOR POLE MOUNTED CUTOFF LIGHTS.				

adwarchitects
environments for life
architecture planning interiors
2815 coliseum centre drive
suite 500
charlotte, nc 28217
704.379.1919
adwarchitects.com

Rolesville
Genuine Community • Capital Connection
Est. 1837

ROLESVILLE POLICE

optima engineering
434 Fayetteville St. Suite 2450, Raleigh NC 27601
Phone: 919.928.2200 - www.optimaengineering.com
North Carolina License Number C-0914

TOWN OF ROLESVILLE POLICE DEPARTMENT

ROLESVILLE, NC 27571

ELECTRICAL SITE PHOTOMETRICS

DATE: 04-10-26
PROJECT NO: 24008

REVISIONS

NO:	DATE:	DESCRIPTION:

THIS DRAWING IS THE PROPERTY OF ADW ARCHITECTS, P.A. AND SHALL NOT BE REPRODUCED OR COPIED IN WHOLE OR PART. IT SHALL NOT BE USED ON ANY OTHER PROJECT OR GIVEN TO ANY OTHER COMPANY OR AGENCY WITHOUT THE CONSENT OF ADW ARCHITECTS, P.A.

SHEET NUMBER:
E011

8/14/2026 11:30:15 AM

THIS DRAWING IS AN INSTRUMENT OF SERVICE. THE DRAWING AND THE INFORMATION THEREON IS THE PROPERTY OF OPTIMA ENGINEERING, P.A. ANY REPRODUCTION, ALTERATION, OR USE FOR OTHER THAN THE INTENDED PROJECT, WITHOUT THE WRITTEN CONSENT OF OPTIMA ENGINEERING, P.A. IS EXPRESSLY FORBIDDEN. COPYRIGHT © OPTIMA ENGINEERING P.A. 2026, ALL RIGHTS RESERVED.

Project		Catalog #		Type	
Prepared by		Notes		Date	

Streetworks

UTLD Traditionaire

Decorative Post Top Luminaire

Product Certifications & Features

Interactive Menu

- Ordering Information page 2
- Product Specifications page 2
- Energy and Performance Data page 3

Product Specifications

OPTICAL
- Choice of five patented, high-efficiency AccuLED Optic technology manufactured from injection-molded acrylic.
- Optics are precisely designed to shape the light output, maximizing efficiency and application spacing.
- AccuLED Optic technology creates consistent distributions with the scalability to meet customized application requirements.
- Optional 2700K, 3000K, 4000K and 5000K CCT. For the ultimate level of spill light control, an optional house-side shield accessory can be field, or factory installed.
- Optics are IP66 enclosure rated.
- Offered open sided as a standard with four lens options.

ELECTRICAL
- 120-277V 50/60Hz operation. 347V and 480V options available
- 10kV and 20kV surge protection options with series or parallel configurations
- 0-10V dimming standard
- Ambient operating temperature from -40°C to 40°C
- Standard three-position tunnel type compression terminal block.

PHYSICAL CHARACTERISTICS
- Hinged (stainless steel hinge pins) die-cast aluminum housing and cover with cupola.
- Self-aligning pole-top fitter for 3" O.D. pole tops or vertical tenons.
- Square headed 1-1/4" polymer coated mounting bolts with a lock nut.
- Cast components finished in a super TGIC polyester powder coat paint, 2.5 mil nominal thickness for superior protection against fade and wear.
- Optional colors include bronze, grey and white. RAL and custom color matches available.

CONTROLS
- 3- and 7-pin photocell receptacle options
- Field Adjustable Dimming Control option for manual adjustment of power consumption and lumen output. Factory preset to highest output level

COMPLIANCE
- UL wet location rated
- Configurations available that meet DLC and DLC Premium requirements, submission in progress - visit www.designlights.org to confirm listed variants
- BAA domestic preference option meets BAA requirements. See DOMESTIC PREFERENCES website or consult the CLS Domestic Preferences team for more information
- FHWA and FTA agencies are utilizing their BAA rules for BABA compliance. Cooper's products with a BABA designation are manufactured in the US and utilize a BAA COTS exemption rule for compliance. To verify a configured product with specific accessories and options meet BABA Domestic Preference Requirements, submit this catalog number to Cooper Lighting Quotation team for validation by our Engineering and Manufacturing teams. Please refer to the DOMESTIC PREFERENCES website or consult the CLS Domestic Preferences team for more information. Components shipped separately may be separately analyzed under domestic preference requirements

SHIPPING DATA
- Approximate Net Weight: 37 lbs. (17 kgs.)
- Effective Projected Area: 2.3 (Sq. Ft.)

WARRANTY
- Five-year limited warranty. Consult website for details. www.cooperlighting.com/legal

Dimensional Details

UTLD

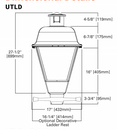

UTLD - Tall Cupola

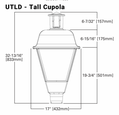

Optional Bird Cone

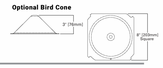

COOPER Lighting Solutions
a Signify business

PS506054EN page 1
July 24, 2025 3:35 PM

---

hapco Poles and Products — Proven Performance

RSS16B4-4-T406-FF-GF2-LPC-DP

RSS - Round Straight Steel Pole
16' - 11 ga - 4" Diameter Steel Pole
Finish (DP): 73737-151 (DP) - Black

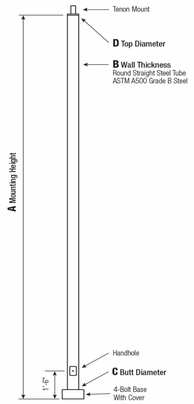

4-Bolt Base Plate
With 2-piece Cover

Anchorage
Base Plate

Anchor Bolts
Projection & Size

Handhole
Reinforced 3" x 5"
With Grounding

WARNING: Do not install light pole without luminaire.

If determined necessary by Hapco, or if specified by the customer, a first and/or second mode vibration damper will be provided.

Specifications	
A - Mounting Height: 16'	
B - Wall Gauge: 11 ga. (0.12")	
C - Butt Diameter: 4"	
D - Top Diameter: 4"	
F - Bolt Circle Range: 7.5" - 8.5"	
G - Base Square: 8"	
H - Bolt Proj: 3.75"	
I - Bolt Size: 0.75" x 17" x 3"	
Tenon: 4" OD (3.5" Pipe) x 6" Long	
Add Duplex GFI Receptcle w/ In-Use Cover	
Elec. Box 36" Up (B - 1 @ 0deg)	
Pole Order is Less Pole Cap	

Customer Name: Optima
Dealer:
Project: Rolesville Campus — Qty: 31
Location: Rolesville NC
Notes:

RSS16B4-4-T406-FF-GF2-LPC-DP

Webpole_040821

HOMEWOOD LARGE STRUCTURAL - Straight Round Aluminum Pole

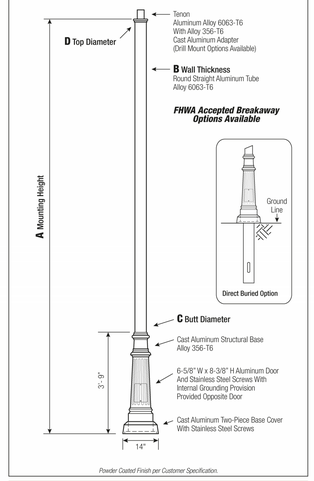

Powder Coated Finish per Customer Specification.

C Butt Dia.	D Top Dia.	F Bolt Cir. Dia.	G Base Sq.	H Bolt Proj.	I Bolt Size
4	4	13 - 14 ■	14	2	.75 x 17 x 3
5	5	13 - 14 ■	14	2	.75 x 17 x 3
6	6	13 - 14 ■	14	2	.75 x 17 x 3

■ *Square Bolt Pattern* — *Dimensions in Inches*

Base
Cast Aluminum. 1-Piece Structural Pedestal Base of Alloy 356 per ASTM B26 or B108. The base shall have an access door with cast aluminum cover and stainless steel attaching hardware. An internal grounding provision will be provided opposite the access door.

Pole
The pole shaft will be constructed of seamless extruded tube of 6063 Aluminum Alloy per the requirements of ASTM B221. The shaft shall be joined to the structural base by means of a complete circumferential weld in accordance with AWS Specification D1.2. The assembly shall be full-length heat-treated after weld to produce a T6 temper.

Anchorage
Anchorage Kit will include four (4) L-shaped Steel Anchor Bolts conforming to A449/F0 M314-90 Grade 55. Ten inches (10") of threaded end will be galvanized per ASTM A153. Kits will contain four (4) Hex Nuts, four (4) Lock Washers, and four (4) Flat Washers (all components Galvanized Steel). A bolt circle template will be provided.

NOTE: *All HOMEWOOD LARGE pole options may be specified in designs utilizing Direct Buried anchorage.*

Vibration Damper
When determined necessary by Hapco, a Vibration Damper will be factory installed inside the pole shaft. Customer specification of the damper is available.

WARNING: *Do not install light pole without luminaire.*

www.hapco.com — hapco poles and products — 1 OF 2

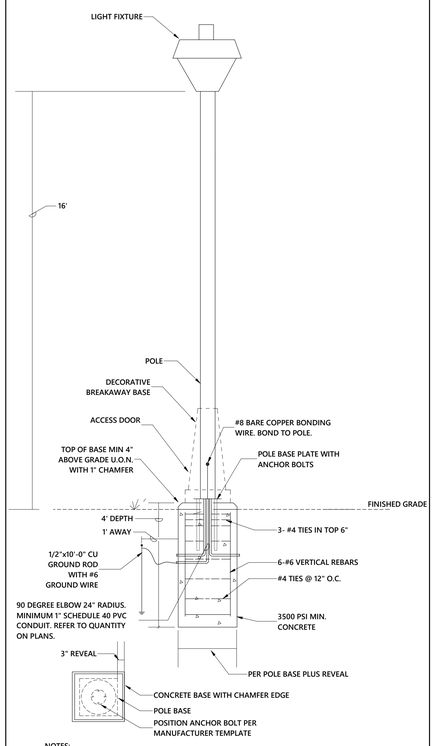

NOTES:
1. PRE-CAST ASSEMBLY OR CAST-IN-PLACE OPTIONS BOTH ARE ACCEPTABLE.
2. IF THE CAST-IN-PLACE OPTION IS CHOSEN, ALLOW 30 DAYS FOR CONCRETE BASE TO CURE BEFORE INSTALLING POLE.
3. REINFORCING STEEL TO BE GRADE 60.
4. ALL SHIMS AND NUTS TO BE HOT DIPPED GALVANIZED.

1 POLE BASE DETAIL (EXTENDED)
NOT TO SCALE

---

adwarchitects
environments for life
architecture planning interiors
2815 coliseum centre drive
suite 500
charlotte, nc 28217
704.379.1919
adwarchitects.com

Rolesville — Genuine Community • Capital Connection — Est. 1837

ROLESVILLE POLICE

optima engineering
434 Fayetteville St. Suite 2450, Raleigh NC 27601
Phone: 919.926.2200 - www.optimaengineering.com
North Carolina License Number C-0914

TOWN OF ROLESVILLE POLICE DEPARTMENT

ROLESVILLE, NC 27571

ELECTRICAL DETAILS

DATE: 04-10-26
PROJECT NO: 24008

REVISIONS

NO:	DATE:	DESCRIPTION:

THIS DRAWING IS THE PROPERTY OF ADW ARCHITECTS, P.A. AND SHALL NOT BE REPRODUCED OR COPIED IN WHOLE OR PART. IT SHALL NOT BE USED ON ANY OTHER PROJECT OR GIVEN TO ANY OTHER COMPANY OR AGENCY WITHOUT THE CONSENT OF ADW ARCHITECTS, P.A.

SHEET NUMBER:
E503

THIS DRAWING IS AN INSTRUMENT OF SERVICE. THE DRAWING AND THE INFORMATION THEREON IS THE PROPERTY OF OPTIMA ENGINEERING, P.A. ANY REPRODUCTION, ALTERATION, OR USE FOR OTHER THAN THE INTENDED PROJECT, WITHOUT THE WRITTEN CONSENT OF OPTIMA ENGINEERING, P.A. IS EXPRESSLY FORBIDDEN. COPYRIGHT © OPTIMA ENGINEERING P.A. 2026, ALL RIGHTS RESERVED.

LIGHTING FIXTURE SCHEDULE

TYPE	DESCRIPTION	MINIMUM LUMENS	CCT	TOTAL FIXURE WATTAGE	VOLTAGE	MANUFACTURER	MODEL	REMARKS
CF	CEILING FAN			15 W	120V	BIG ASS FANS	HAIKU 52"	PROVIDE PENDANT MOUNTING KIT. 52" DIAMETER.
D6	6" RECESSED DOWNLIGHT	1,000	3500K	10 W	120V	LITHONIA	LDN6	WET LOCATION LISTED. 90 CRI. MINIMUM 10% DIMMMING.
DH6	HIGH MOUNTING 6" RECESSED DOWNLIGHT	2,000	3500K	20 W	120V	LITHONIA	LDN6	WET LOCATION LISTED. 90 CRI. MINIMUM 10% DIMMMING.
DH6E	HIGH MOUNTING 6" RECESSED DOWNLIGHT	2,000	3500K	20 W	120V	LITHONIA	LDN6	WET LOCATION LISTED. 90 CRI. MINIMUM 10% DIMMMING.
EG	EXTERIOR EMERGENCY EGRESS LIGHT	2,000	4000K	11 W	120V	LITHONIA	WDGE2 LED P1	PROVIDE COLD WEATHER 90 MINUTE BATTERY BACKUP. WET LOCATION LISTED.
FL	EXTERIOR FLOOD LIGHT	9,000	4000K	71 W	120V	LITHONIA	WDGE3 LED P3	WET LOCATION LISTED.
GS	4' LINEAR PENDANT	3,000	3500K	42 W	120V	MARK ARCHITECTURAL	S4PD	80 CRI. MINIMUM 10% DIMMING. PROVIDE PENDANT MOUNTING KIT.
GSE	4' LINEAR PENDANT EMERGENCY	3,000	3500K	42 W	120V	MARK ARCHITECTURAL	S4PD	80 CRI. MINIMUM 10% DIMMING. PROVIDE PENDANT MOUNTING KIT. PROVIDE 90 MINUTE BATTERY BACKUP.
LB	LOW BAY PENDANT	7,500	3500K	50 W	120V	LITHONIA	MLX L4	PROVIDE PENDANT MOUNTING KIT AND MOUNT AT HEIGHT INDICATED ON PLANS.
LD	8' LINEAR PENDANT DIRECT/INDIRECT	2,400	3500K	35 W	120V	MARK ARCHITECTURAL LIGHTING	S4PID	90 CRI. MINIMUM 1% DIMMING. DIRECT/INDIRECT DISTRIBUTION. DIRECT: 300 LUMNES/FT, REGRESSED LOUVER LENS INDIRECT: 300 LUMENS/FT, TOP GLOW LENS PROVIDE PENDANT MOUNTING KIT.
S	SURFACE MOUNTED 4' STRIP LIGHT	3,000	3500K	29 W	120V	LITHONIA	WL4	80 CRI.
SC	WALL MOUNTED 2' STRIP LIGHT	1,000	3500K	12 W	120V	LITHONIA	WL2	80 CRI.
SE	SURFACE MOUNTED 4' STRIP LIGHT EMERGENCY	3,000	3500K	29 W	120V	LITHONIA	WL4	80 CRI. PROVIDE 90 MINUTE BATTERY BACKUP.
SL	RECESSED LINEAR 4'	2,400	3500K	24 W	120V	MARK ARCHITECTURAL LIGHTING	SL4L	90 CRI. MINIMUM 1% DIMMING. REGRESSED LENS.
T2	2X2 TROFFER	2,000	3500K	17 W	120V	LITHONIA	STAK 2X2	80 CRI. MINIMUM 10% DIMMING.
T2E	2X2 TROFFER EMERGENCY	2,000	3500K	17 W	120V	LITHONIA	STAK 2X2	80 CRI. MINIMUM 10% DIMMING. PROVIDE 90 MINUTE EMERGENCY BATTERY BACKUP.
T4	2X4 TROFFER	4,000	3500K	33 W	120V	LITHONIA	STAK 2X4	80 CRI. MINIMUM 10% DIMMING.
T4E	2X4 TROFFER	4,000	3500K	33 W	120V	LITHONIA	STAK 2X4	80 CRI. MINIMUM 10% DIMMING. PROVIDE 90 MINUTE EMERGENCY BATTERY BACKUP.
UC	UNDER CABINET LINEAR	400	3500K	9 W	120V	LITHONIA	UCES	"-X" APPENDED TO FIXTURE TAG INDICATES LENGHT OF FIXTURE TO BE ORDERED IN FEET. WATTS AND LUMENS LISTED ON THE FIXTURE SCHEDULE ARE PER FOOT OF FIXTURE LENGTH.
V	2' VANITY LINEAR SCONCE	1,000	3500K	18 W	120V	LITHONIA	FMVCCLS	VERIFY FINISH WITH ARCHITECT
W	EXTERIOR LINEAR WALL WASH	400	4000K	8 W	120V	HYDREL	RIDGE	WET LOCATION LSITED. WALL WASH DISTRIBUTION. "-X" APPENDED TO FIXTURE TAG INDICATES LENGHT OF FIXTURE TO BE ORDERED IN FEET. WATTS AND LUMENS LISTED ON THE FIXTURE SCHEDULE ARE PER FOOT OF FIXTURE LENGTH.
WC	EXTERIOR CYLINDER SCONCE	4,000	4000K	31 W	120V	LITHONIA	WMCL4 P1	UP AND DOWN LIGHT. WET LOCATION LISTED.
WW	RECESSED LINEAR WALL WASH	4,000	3500K	57 W	120V	PEERLESS	OPRW	WALL WASH DISTRIBUTION.
X1	UNIVERSAL EXIT SIGN		RED	5 W	120V	LITHONIA	EDG/EDGR	90 MINUTE OPERATION. RED LETTERS AND ARROWS. SEE PLANS FOR FACE STYLE.

1. ALL FIXTURES SHALL BE LED UNLESS OTHERWISE SPECIFIED. COLOR TEMPERATURE SHALL BE 3500K UNLESS OTHERWISE NOTED.
2. LED DRIVERS SHALL BE PROVIDED FROM PER MANUFACTURER RECOMMENDATION. AS PART OF THIS RECOMMENDATION COORDINATE THE REQUIRED WAVE OUTPUT SO THEY ARE COMPATIBLE. THIS INCLUDES EMERGENCY DRIVERS.
3. SEE ARCHITECTURAL REFLECTED CEILING PLAN FOR EXACT FIXTURE LOCATIONS.
4. FIXTURES IN FIRE RATED CEILING SHALL BE PROVIDED WITH FIRE RATED TENTS AS REQUIRED.
5. SUSPEND ALL FOUR CORNERS WITH WIRE TO STRUCTURE. DO NOT ALLOW GRID ALONE TO SUPPORT FIXTURE.
6. FIXTURES WITH EMERGENCY BATTERY PACKS SHALL BE SUPPLIED WITH 1100 LUMEN INVERTERS.
7. PROVIDE INTEGRAL SURGE PROTECTION ON ALL EXTERIOR LED DRIVER FIXTURE TYPES.
8. DIMMING OF FIXTURES SHALL BE WITH A SWITCH AS RECOMMENDED BY THE DRIVER MANUFACTURER.
9. THE CONTRACTOR SHALL VERIFY THE LEAD TIME OF ALL PRODUCTS SPECIFIED IN THIS SCHEDULE AT THE TIME OF PACKAGE QUOTE.
10. DURING THE BID PROCESS, THE CONTRACTOR SHALL NOTIFY THE ARCHITECT/ENGINEER OF ANY DELIVERY/SCHEDULING ISSUES.
11. NO SUBSTITUTIONS WILL BE ALLOWED DUE TO LACK OF COORDINATION OF DELIVERY DATES AND CONSTRUCTION SCHEDULE AFTER BID.
12. ALL EXPEDITED EXPENSES SHALL BE THE RESPONSIBILTY OF THE CONTRACTOR.
13. FIXTURES TO BE INSTALLED IN CEILINGS, INDICATED ON ARCHITECTURAL PLANS AS HAVING INSULATION IN CONTACT WITH CEILING SURFACE, SHALL BE IC RATED BY MANUFACTURER.
14. LED DRIVERS LOCATED IN UNCONDITIONED SPACES SHALL BE RATED FOR 90 DEGREES F.
15. PROVIDE 90 MINUTE EMERGENCY BATTERY BACK UP. EMERGENCY BACK UP SHALL BE BASED ON TYPE OF FIXTURE, LED DRIVER, BALLAST, ETC. EMERGENCY BACKUP SHALL BE DUAL INPUT FOR BOTH SWITCHING AND CHARGING. PROVIDE UNSWITCHED "HOT" FROM LOCAL CIRCUIT UNLESS OTHERWISE INDICATED ON PLANS. PROVIDE WITH INDICATOR LIGHT. INSTALL LED INDICATOR ON LIGHT FIXTURE UNLESS DECORATIVE. DECORATIVE FIXTURES SHALL HAVE INDICATOR PLACED AT LOCAL CEILING. BODINE, PHILLIPS, POWER SENTRY OR EQUAL.
16. PROVIDE EMERGENCY RELAY BASED ON MINIMUM BODINE GLCD-20B OR EQUAL. SEE PLANS FOR INTENT. PROVIDE EMERGENCY GENERATOR/INVERTER CIRCUIT AND SWITCH LEG NORMAL CIRCUIT. SEE DETAIL.
17. POLES PROVIDED FOR LED FIXTURES SHALL BE METAL, REGARDLESS OF SPECIFICATION FOR GROUNDING PURPOSES.

SITE LIGHTING FIXTURE SCHEDULE

TYPE	DESCRIPTION	MINIMUM LUMENS	CCT	TOTAL FIXURE WATTAGE	VOLTAGE	MANUFACTURER	MODEL	REMARKS
A	16 FT HIGH OUTPUT POLE MOUNTED PARKING LOT LAMP	7,500	4000K	64 W	208V	COOPER LIGHTING SOLUTIONS - STREETWORKS	LXF.LXT-PA1-60-740-U-SWQ	BLACK FINISH PROVIDE 4" ROUND SMOOTH ALUMINUM POLE WITH BREAKAWAY DECORATIVE BASE T5 DISTRIBUTION B3-U0-G2
B	16 FT HIGH OUTPUT POLE MOUNTED PARKING LOT LAMP	7,500	4000K	64 W	208V	COOPER LIGHTING SOLUTIONS - STREETWORKS	LXF.LXT-PA1-60-740-U-T4W	BLACK FINISH PROVIDE 4" ROUND SMOOTH ALUMINUM POLE WITH BREAKAWAY DECORATIVE BASE T4 DISTRIBUTION B1-U0-G2
BL	43"X8"X8" BOLLARD	350	4000K	16 W	208V	FORMS AND SURFACES	KNIGHT BOLLARD	BLACK FINISH
C	16 FT HIGH OUTPUT POLE MOUNTED PARKING LOT LAMP	7,500	4000K	64 W	208V	COOPER LIGHTING SOLUTIONS - STREETWORKS	LXF.LXT-PA1-60-740-U-T4W-HSS	BLACK FINISH PROVIDE 4" ROUND SMOOTH ALUMINUM POLE WITH BREAKAWAY DECORATIVE BASE PROVIDE BACKLIGHT SHIELD T4 DISTRIBUTION B1-U0-G2

NOTES:
- ALL LIGHTS SHALL BE EQUIVALENT TO THE OPTICAL DISTRIBUTION. APPROVED EQUAL MANUFACTURERS ARE LITHONIA, RAB, US OUTDOOR LIGHTING
- ALL LIGHTS TO BE POLE MOUNTED AT 16FT UNLESS OTHERWISE NOTED. REFER TO POLE BASE DETAILS FOR MORE INFORMATION.

adwarchitects
environments for life
architecture planning interiors
2815 coliseum centre drive
suite 500
charlotte, nc 28217
704.379.1919
adwarchitects.com

Rolesville
Genuine Community • Capital Connection
Est. 1837

ROLESVILLE POLICE

optima engineering
434 Fayetteville St. Suite 2450, Raleigh NC 27601
Phone: 919.926.2200 - www.optimaengineering.com
North Carolina License Number C-0914

TOWN OF ROLESVILLE POLICE DEPARTMENT

ROLESVILLE, NC 27571

LIGHTING FIXTURE SCHEDULE

DATE: 04-10-26
PROJECT NO: 24008

REVISIONS

NO:	DATE:	DESCRIPTION:

THIS DRAWING IS THE PROPERTY OF ADW ARCHITECTS, P.A. AND SHALL NOT BE REPRODUCED OR COPIED IN WHOLE OR PART. IT SHALL NOT BE USED ON ANY OTHER PROJECT OR GIVEN TO ANY OTHER COMPANY OR AGENCY WITHOUT THE CONSENT OF ADW ARCHITECTS, P.A.

SHEET NUMBER:

E701

8/14/2026 11:30:18 AM

THIS DRAWING IS AN INSTRUMENT OF SERVICE. THE DRAWING AND THE INFORMATION THEREON IS THE PROPERTY OF OPTIMA ENGINEERING, P.A. ANY REPRODUCTION, ALTERATION, OR USE FOR OTHER THAN THE INTENDED PROJECT, WITHOUT THE WRITTEN CONSENT OF OPTIMA ENGINEERING, P.A. IS EXPRESSLY FORBIDDEN. COPYRIGHT © OPTIMA ENGINEERING P.A. 2026, ALL RIGHTS RESERVED.

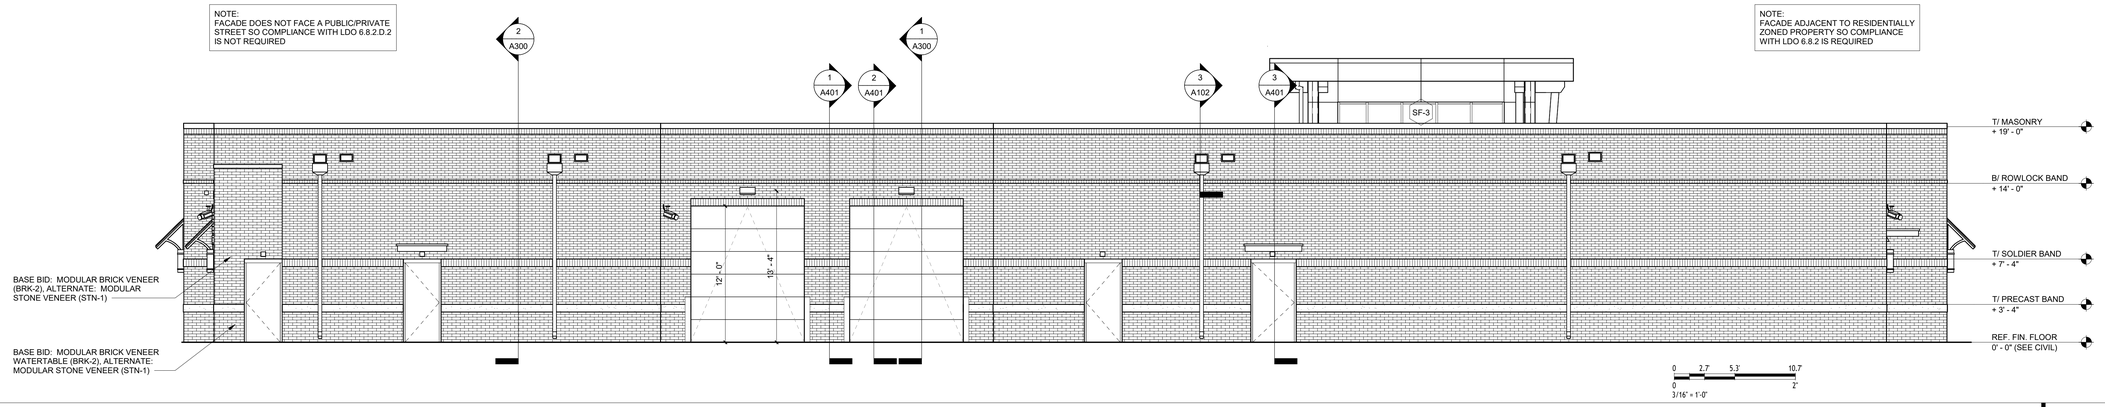

NORTH ELEVATION 3/16" = 1'-0" 4

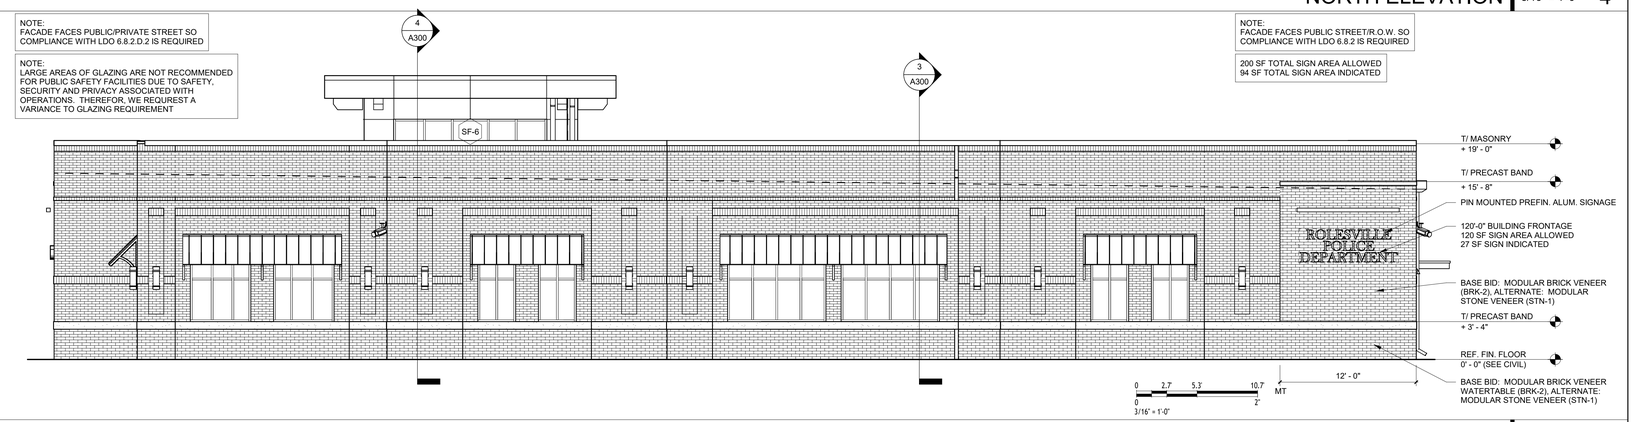

EAST ELEVATION 3/16" = 1'-0" 3

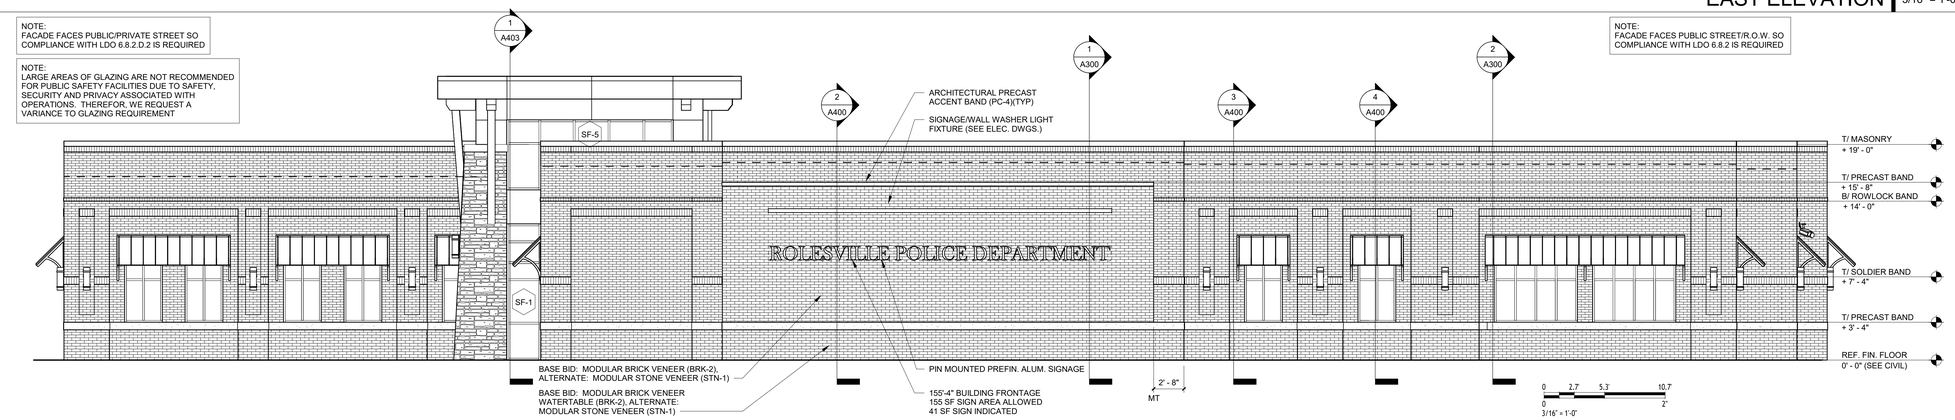

SOUTH ELEVATION 3/16" = 1'-0" 2

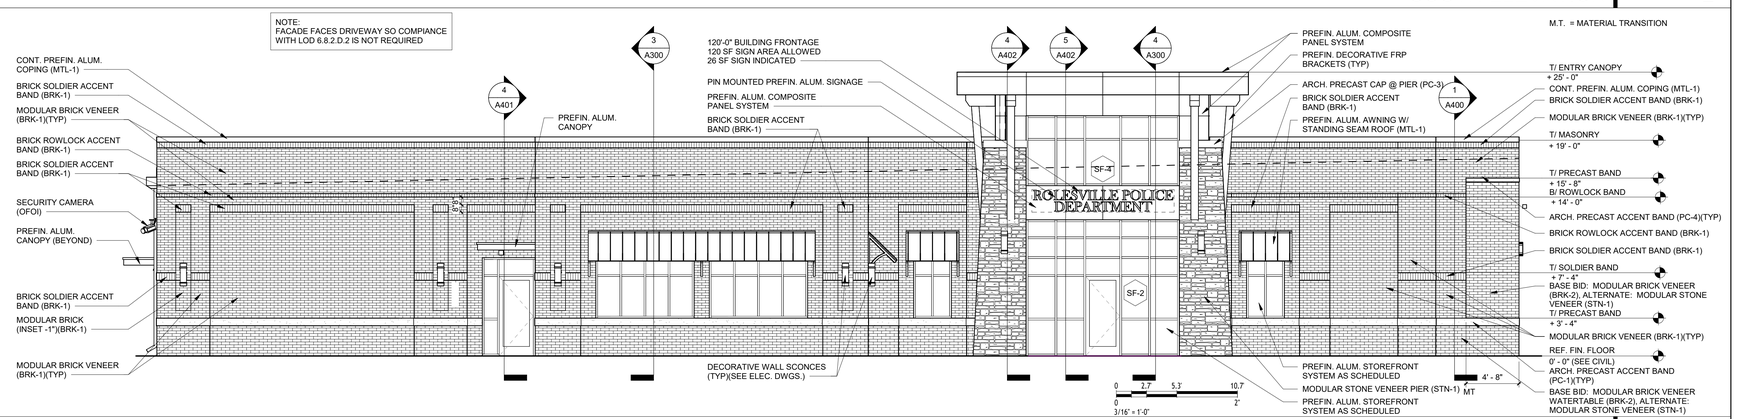

WEST ELEVATION 3/16" = 1'-0" 1

adwarchitects
environments for life
architecture planning interiors
2815 coliseum centre drive
suite 500
charlotte, nc 28217
704.379.1919
adwarchitects.com

Rolesville
Genuine Community • Capital Connection
Est. 1837

ROLESVILLE POLICE

TOWN OF ROLESVILLE POLICE DEPARTMENT

ROLESVILLE, NC 27571

EXTERIOR ELEVATIONS

DATE: 04-20-26
PROJECT NO: 24008

REVISIONS

NO:	DATE:	DESCRIPTION:

THIS DRAWING IS THE PROPERTY OF ADW ARCHITECTS, P.A. AND SHALL NOT BE REPRODUCED OR COPIED IN WHOLE OR PART. IT SHALL NOT BE USED ON ANY OTHER PROJECT OR GIVEN TO ANY OTHER COMPANY OR AGENCY WITHOUT THE CONSENT OF ADW ARCHITECTS, P.A.

SHEET NUMBER:
AR200

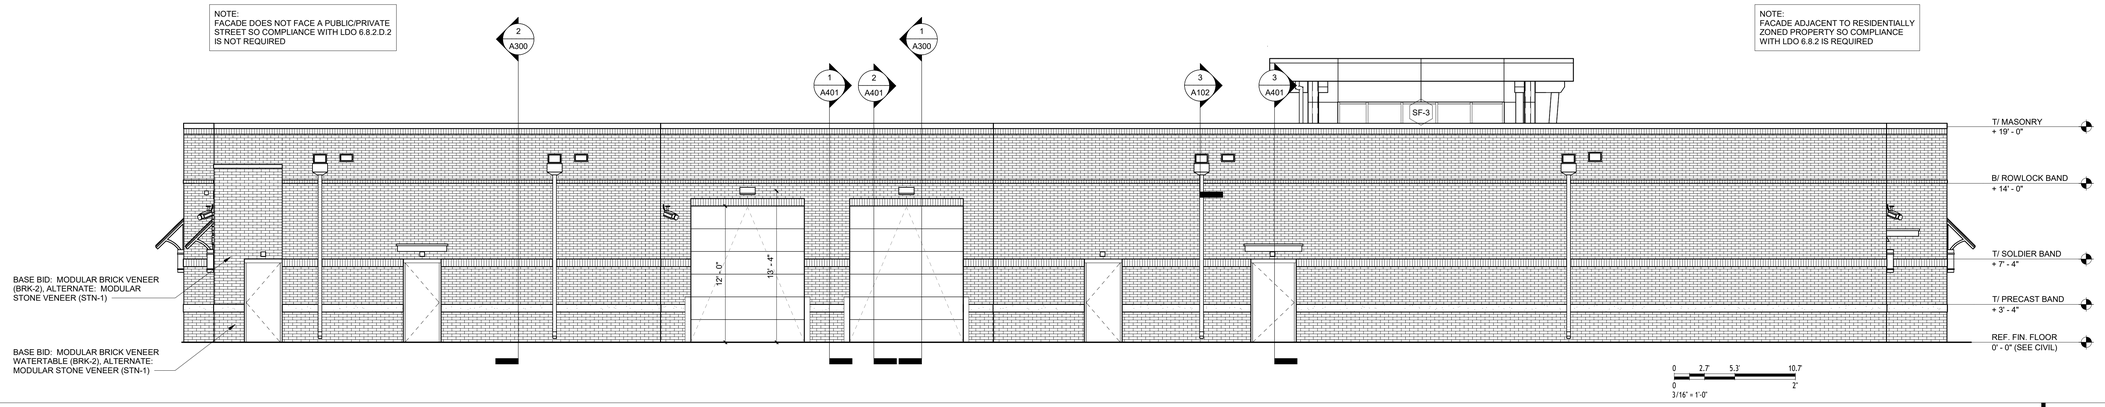

NORTH ELEVATION 3/16" = 1'-0" 4

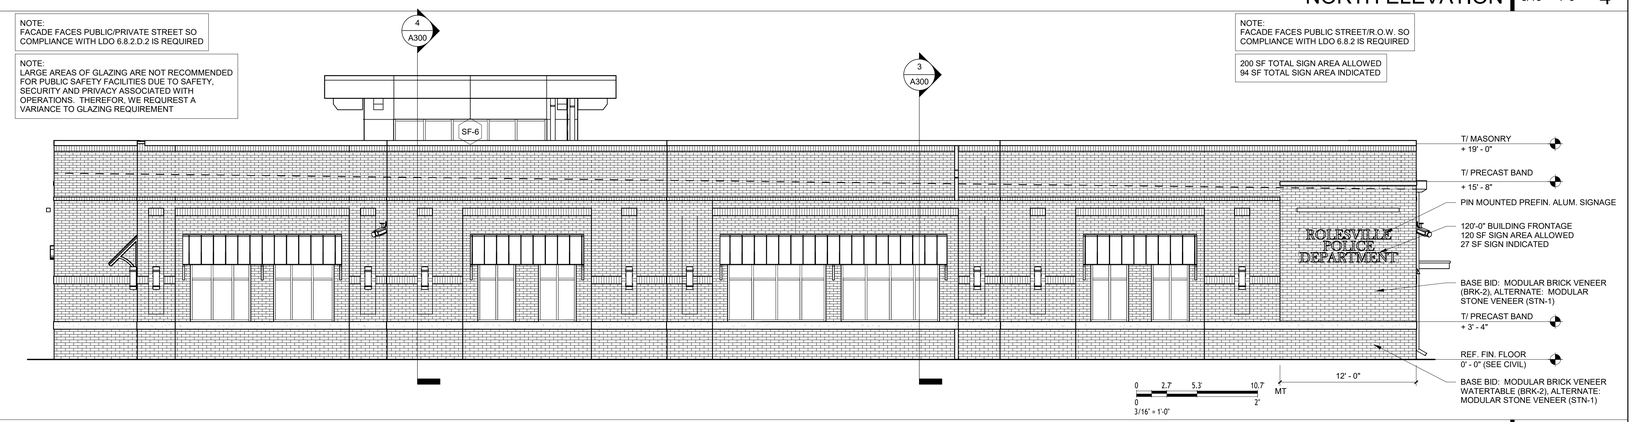

EAST ELEVATION 3/16" = 1'-0" 3

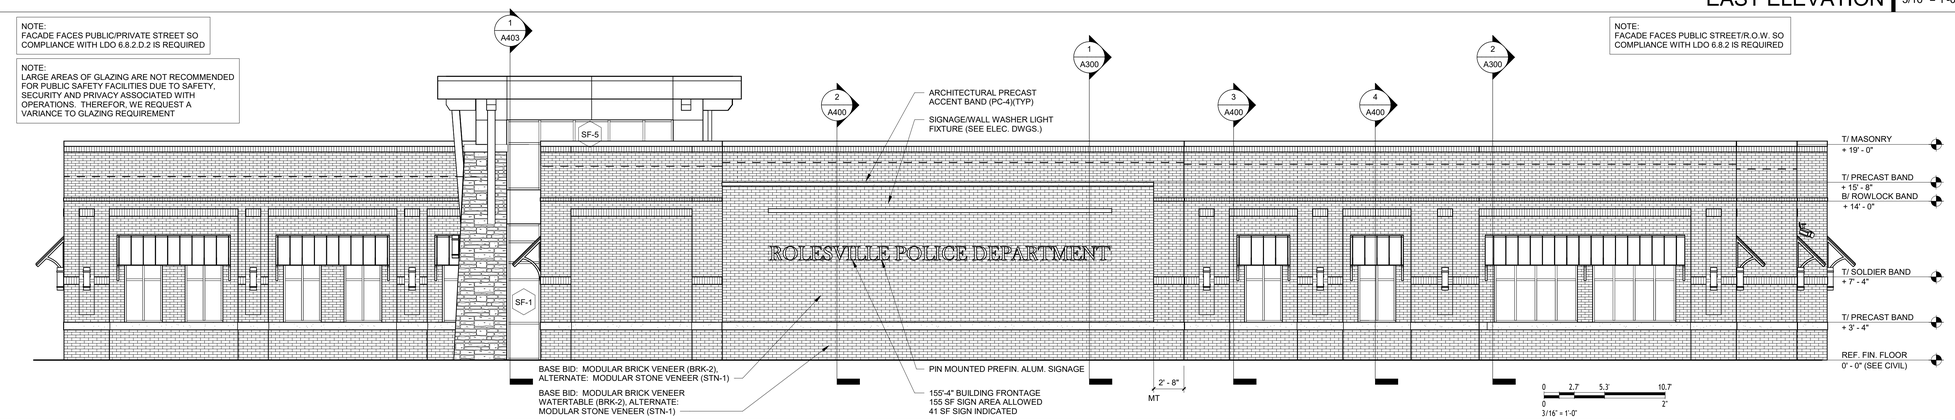

SOUTH ELEVATION 3/16" = 1'-0" 2

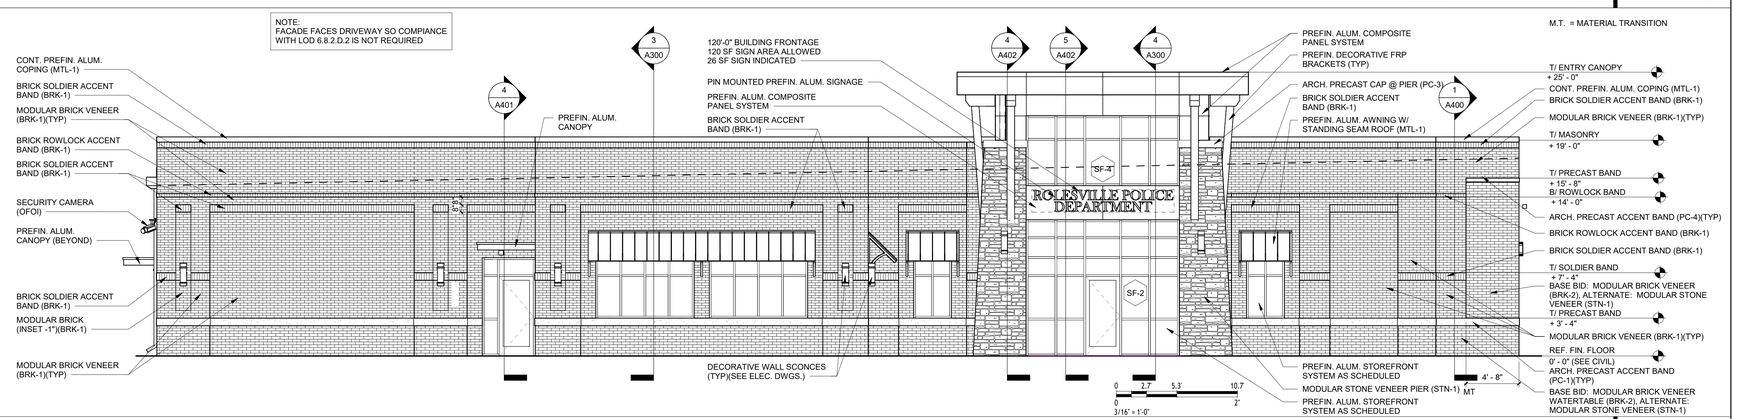

WEST ELEVATION 3/16" = 1'-0" 1

adwarchitects
environments for life
architecture planning interiors
2815 coliseum centre drive
suite 500
charlotte, nc 28217
704.379.1919
adwarchitects.com

Rolesville
Genuine Community • Capital Connection
Est. 1837

ROLESVILLE POLICE

TOWN OF ROLESVILLE POLICE DEPARTMENT

ROLESVILLE, NC 27571

EXTERIOR ELEVATIONS

DATE: 04-20-26
PROJECT NO: 24008

REVISIONS

NO:	DATE:	DESCRIPTION:

THIS DRAWING IS THE PROPERTY OF ADW ARCHITECTS, P.A. AND SHALL NOT BE REPRODUCED OR COPIED IN WHOLE OR PART. IT SHALL NOT BE USED ON ANY OTHER PROJECT OR GIVEN TO ANY OTHER COMPANY OR AGENCY WITHOUT THE CONSENT OF ADW ARCHITECTS, P.A.

SHEET NUMBER:
AR200