



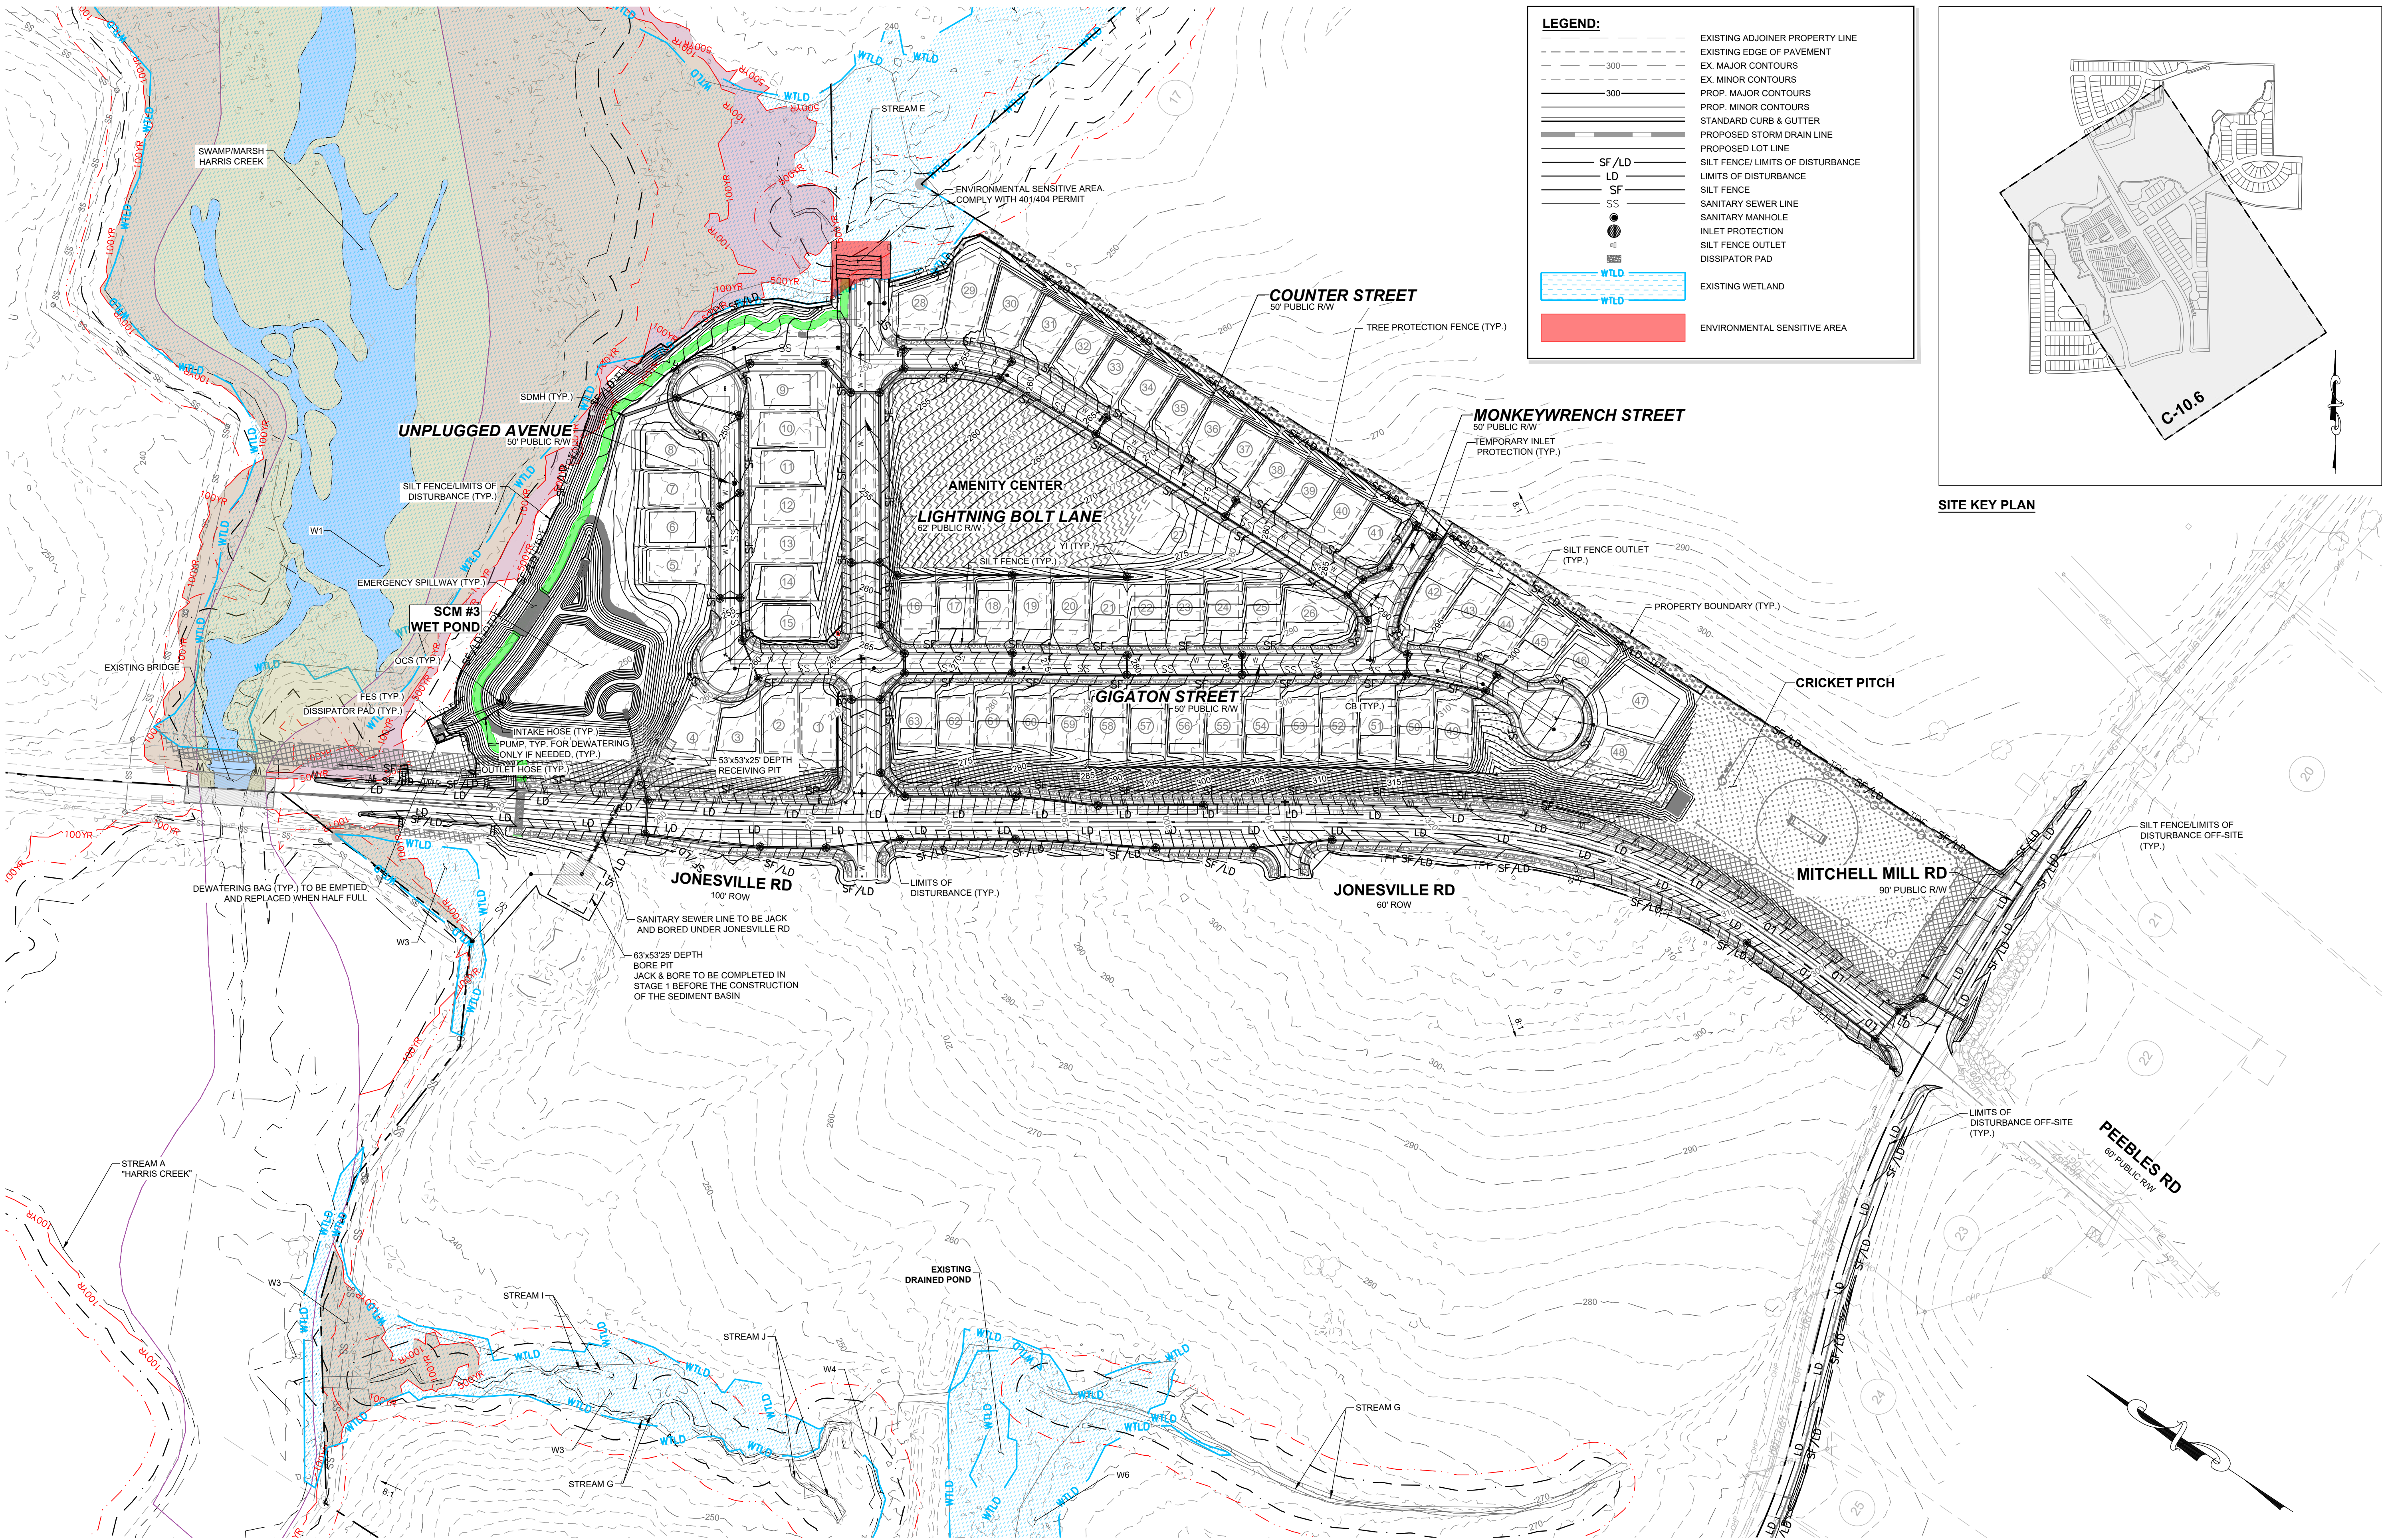

- NOTE:**
1. PHASE 1, ACREAGE: 23.38 AC.
 2. EROSION CONTROL NOTES: SEE SHEET C-10.0
 3. ALL LAND-DISTURBING ACTIVITIES MUST BE PLANNED AND CONDUCTED TO LIMIT THE EXPOSED AREA TO 50 ROLLING ACRES.
 4. STOCKPILE HEIGHT SHALL NOT EXCEED 35 FEET.

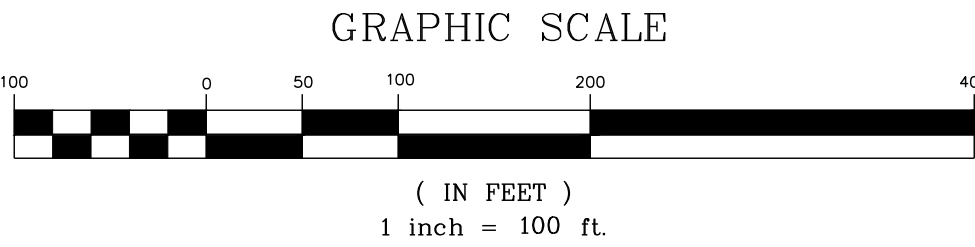

THIS PLANSET AND ANY ASSOCIATED DOCUMENTS ARE PRELIMINARY AND NOT AUTHORIZED FOR CONSTRUCTION UNTIL SIGNED, DATED, AND OFFICIALLY RELEASED FOR CONSTRUCTION BY THE ENGINEER OF RECORD.

CONSTRUCTION INFRASTRUCTURE DRAWINGS		SEAL:		NO.		REVISIONS		DATE		BY	
01	CID-24-04	08/04/2024	SREG								
02	TOWN OF ROLESVILLE CID-24-04 V2	11/01/2024	SREG								
03	TOWN OF ROLESVILLE CID-24-04 V3	02/01/2024	SREG								
04	TOWN OF ROLESVILLE CID-24-04 V4	08/02/2025	SREG								
05	TOWN OF ROLESVILLE CID-24-04 V5	08/02/2025	SREG								

STRONGROCK

ENGINEERING GROUP

STRONG ROCK ENGINEERING GROUP, PLLC | COMPANY LICENSE # P-2166
305 CHURCH AT NORTH HILLS STREET, SUITE 1110 RALEIGH, NC 27609 | INFORMATION@STRONGROCKGROUP.COM


RESERVE @ MITCHELL MILL
TOWN OF ROLESVILLE, WAKE COUNTY, NORTH CAROLINA
CONSTRUCTION PLANS
EROSION CONTROL PLAN
PHASE 1 - STAGE 3


DRAWING SHEET

C-10.6


ADJOINER INFORMATION		
1	CHARLES E. FERRELL AND WIFE GRETTA LOUISE FERRELL PIN: 1757481951 DB 1813 PG 421 ZONING: R-30 (WC) USE: SF	20 CECIL L. GOODNIGHT AND WIFE, JUDY J. GOODNIGHT PIN: 1757650296 DB 5344 PG 819 ZONING: R-30 (WC) USE: SF
2	ABRAHAM T. BURNHAM AND KYLA L. BURNHAM PIN: 1757481832 DB 19140 PG 734 ZONING: R-30 (WC) USE: SF	21 CECIL L. GOODNIGHT AND WIFE, JUDY J. GOODNIGHT PIN: 1757641415 DB 5344 PG 819 ZONING: R-30 (WC) USE: SF
3	JOE L. GREEN PIN: 1757483799 DB 15-E PG 2691 ZONING: R-30 (WC) USE: SF	22 CHRISTOPHER GHOLSON AND WIFE, KELLY GAITHER GHOLSON PIN: 1757556361 DB 17865 PG 457 LOT 4 - BM 2018 PG 1333 ZONING: R-30 (WC) USE: SF
4	CHARLES ALFONSA JONES AND WIFE ALLIE V. JONES PIN: 1757484608 DB 2305 PG 673 ZONING: R-30 (WC) USE: SF	23 ABAHOR ELIAS AND SPOUSE, SUSAN ELIAS PIN: 1757553215 DB 17220 PG 2508 LOT 3 - BM 2018 PG 1333 ZONING: R-30 (WC) USE: SF
5	BENJAMIN FERRELL PIN: 1757485713 DB 1697 PG 465 ZONING: R-30 (WC) USE: SF	24 TODD KENDALL HONEYCUTT PIN: 1757551202 DB 13474 PG 1974 LOT 2 - BM 2018 PG 1333 ZONING: R-30 (WC) USE: SF
6	ALESHIA FERRELL & ARRON WALKER PIN: 1757486733 DB 6374 PG 89 BM 1996 PG 08524 ZONING: R-30 (WC) USE: SF	25 CURTIS L. HONEYCUTT AND WIFE TODD KENDALL PIN: 1757540996 DB 19209 PG 2474 LOT 1 - BM 2018 PG 1333 ZONING: R-30 (WC) USE: SF
7	CHRIST HOLINESS CHURCH #1 PIN: 1757487793 DB 2928 PG 328 ZONING: R-30 (WC) USE: CH	26 PHETIS JONES BRADSHER PIN: 1757349473 DB 15208 PG 2320 BM 2013 PG 868 ZONING: R-30 (WC) USE: FO
8	CHRIST HOLINESS CHURCH #1 PIN: 1757489733 DB 4321 PG 788 ZONING: R-30 (WC) USE: VA	27 PHETIS JONES BRADSHER PIN: 1757349473 DB 15208 PG 2320 ZONING: R-30 (WC) USE: FO
9	CHRIST HOLINESS CHURCH #1 PIN: 1757580764 DB 9467 PG 430 ZONING: R-30 (WC) USE: VA	28 PERRY Y. ELWOOD RYAN PIN: 1757357582 DB 19292 PG 2780 ZONING: R-30 (WC) USE: MO
10	ALICIA BROWN & CARL T. JONES PIN: 1757582714 DB 16128 PG 183 ZONING: R-30 (WC) USE: SF	29 TOUTLOFF, KENNETH S. TOUTLOFF, BILLIE ANNE PIN: 1757357764 DB 9236 PG 2229 LOT 3 - BM 1990 PG 956 ZONING: R-30 (WC) USE: SF
11	RS RENTAL II LLC PIN: 1757584724 DB 16703 PG 2414 BM 1981 PG 894 ZONING: R-30 (WC) USE: SF	30 BERNARD MILLER PIN: 1757357665 DB 15416 PG 1651 LOT 4 - BM 1990 PG 956 ZONING: R-30 (WC) USE: SF
12	KAREN E. BASS PIN: 1757586704 DB 12560 PG 1626 BM 1984 PG 943 ZONING: R-30 (WC) USE: SF	31 MARCIE L. HOLDEN PIN: 1757358908 DB 15599 PG 1003 LOT 5 - BM 1990 PG 956 ZONING: R-30 (WC) USE: SF
13	JAMES K. WILLIAMS PIN: 1757588784 DB 16784 PG 1013 BM 1989 PG 01474 ZONING: R-30 (WC) USE: VA	32 MEGAN KULAWIAK PIN: 1757367367 DB 16226 PG 1133 LOT 6 BM 1990 PG 00387 ZONING: R-30 (WC) USE: VA
14	GRO PEG PROPERTIES LLC PIN: 1757684697 DB 18359 PG 1707 LOT 5 - BM 1980 PG 00396 ZONING: R-30 (WC) USE: VA	33 KENNETH INVESTMENT LLC. PIN: 1757368816 DB 19248 PG 1884 ZONING: R-30 (WC) USE: VA
15	SCOTT & THERESA CARLE PIN: 1757675786 DB 14863 PG 2493 LOT 4A - BM 1980 PG 00396 ZONING: R-30 (WC) USE: VA	34 KENNETH INVESTMENT LLC PIN: 1757471559 DB 19248 PG 1884 LOT - BM 2007 PG 01224 ZONING: R-30 (WC) USE: VA
16	GRO PEG PROPERTIES PIN: 1757684696 DB 19081 PG 2786 LOT 2A - BM 1982 PG 00581 ZONING: R-30 (WC) USE: VA	35 HENRY ALSTON PIN: 1757481376 DB 19248 PG 984 BM 1982 PG 721 ZONING: R-30 (WC) USE: SF
17	MT. CALVARY HOLINESS CHURCH OF WAKE CO. INC. PIN: 1757660324 DB 10124 PG 2778 LOT 1 - BM 2002 PG 991 ZONING: R-30 (WC) USE: VA	36 UNIVERSAL CHURCH OF PRAYER PIN: 1757388408 DB 15559 PG 1723 LOT - BM 2002 PG 00667 ZONING: R-30 (WC) USE: CH
18	G. ARCHIE UNDERHILL, JR. AND WIFE, TERESSA C. UNDERHILL PIN: 1757653765 DB 8443 PG 2129 BM 1999 PG 1357 ZONING: R-30 (WC) USE: SF	37 ROZELIA J. HARTSFIELD HEIRS PIN: 1757481740 DB 10-E PG 1220 ZONING: R-30 (WC) USE: VA
19	GENADIUS MAC PREDDY AND WIFE, MATTIE F. PREDDY PIN: 1757656586 DB 1882 PG 342 ZONING: R-30 (WC) USE: SF	

NOTE:

- PHASE 2, ACREAGE: 16.37 AC
- EROSION CONTROL NOTES: SEE SHEET C-10.0
- ALL LAND-DISTURBING ACTIVITIES MUST BE PLANNED AND CONDUCTED TO LIMIT THE EXPOSED AREA TO 50 ROLLING ACRES.
- STOCKPILE HEIGHT SHALL NOT EXCEED 35 FEET.

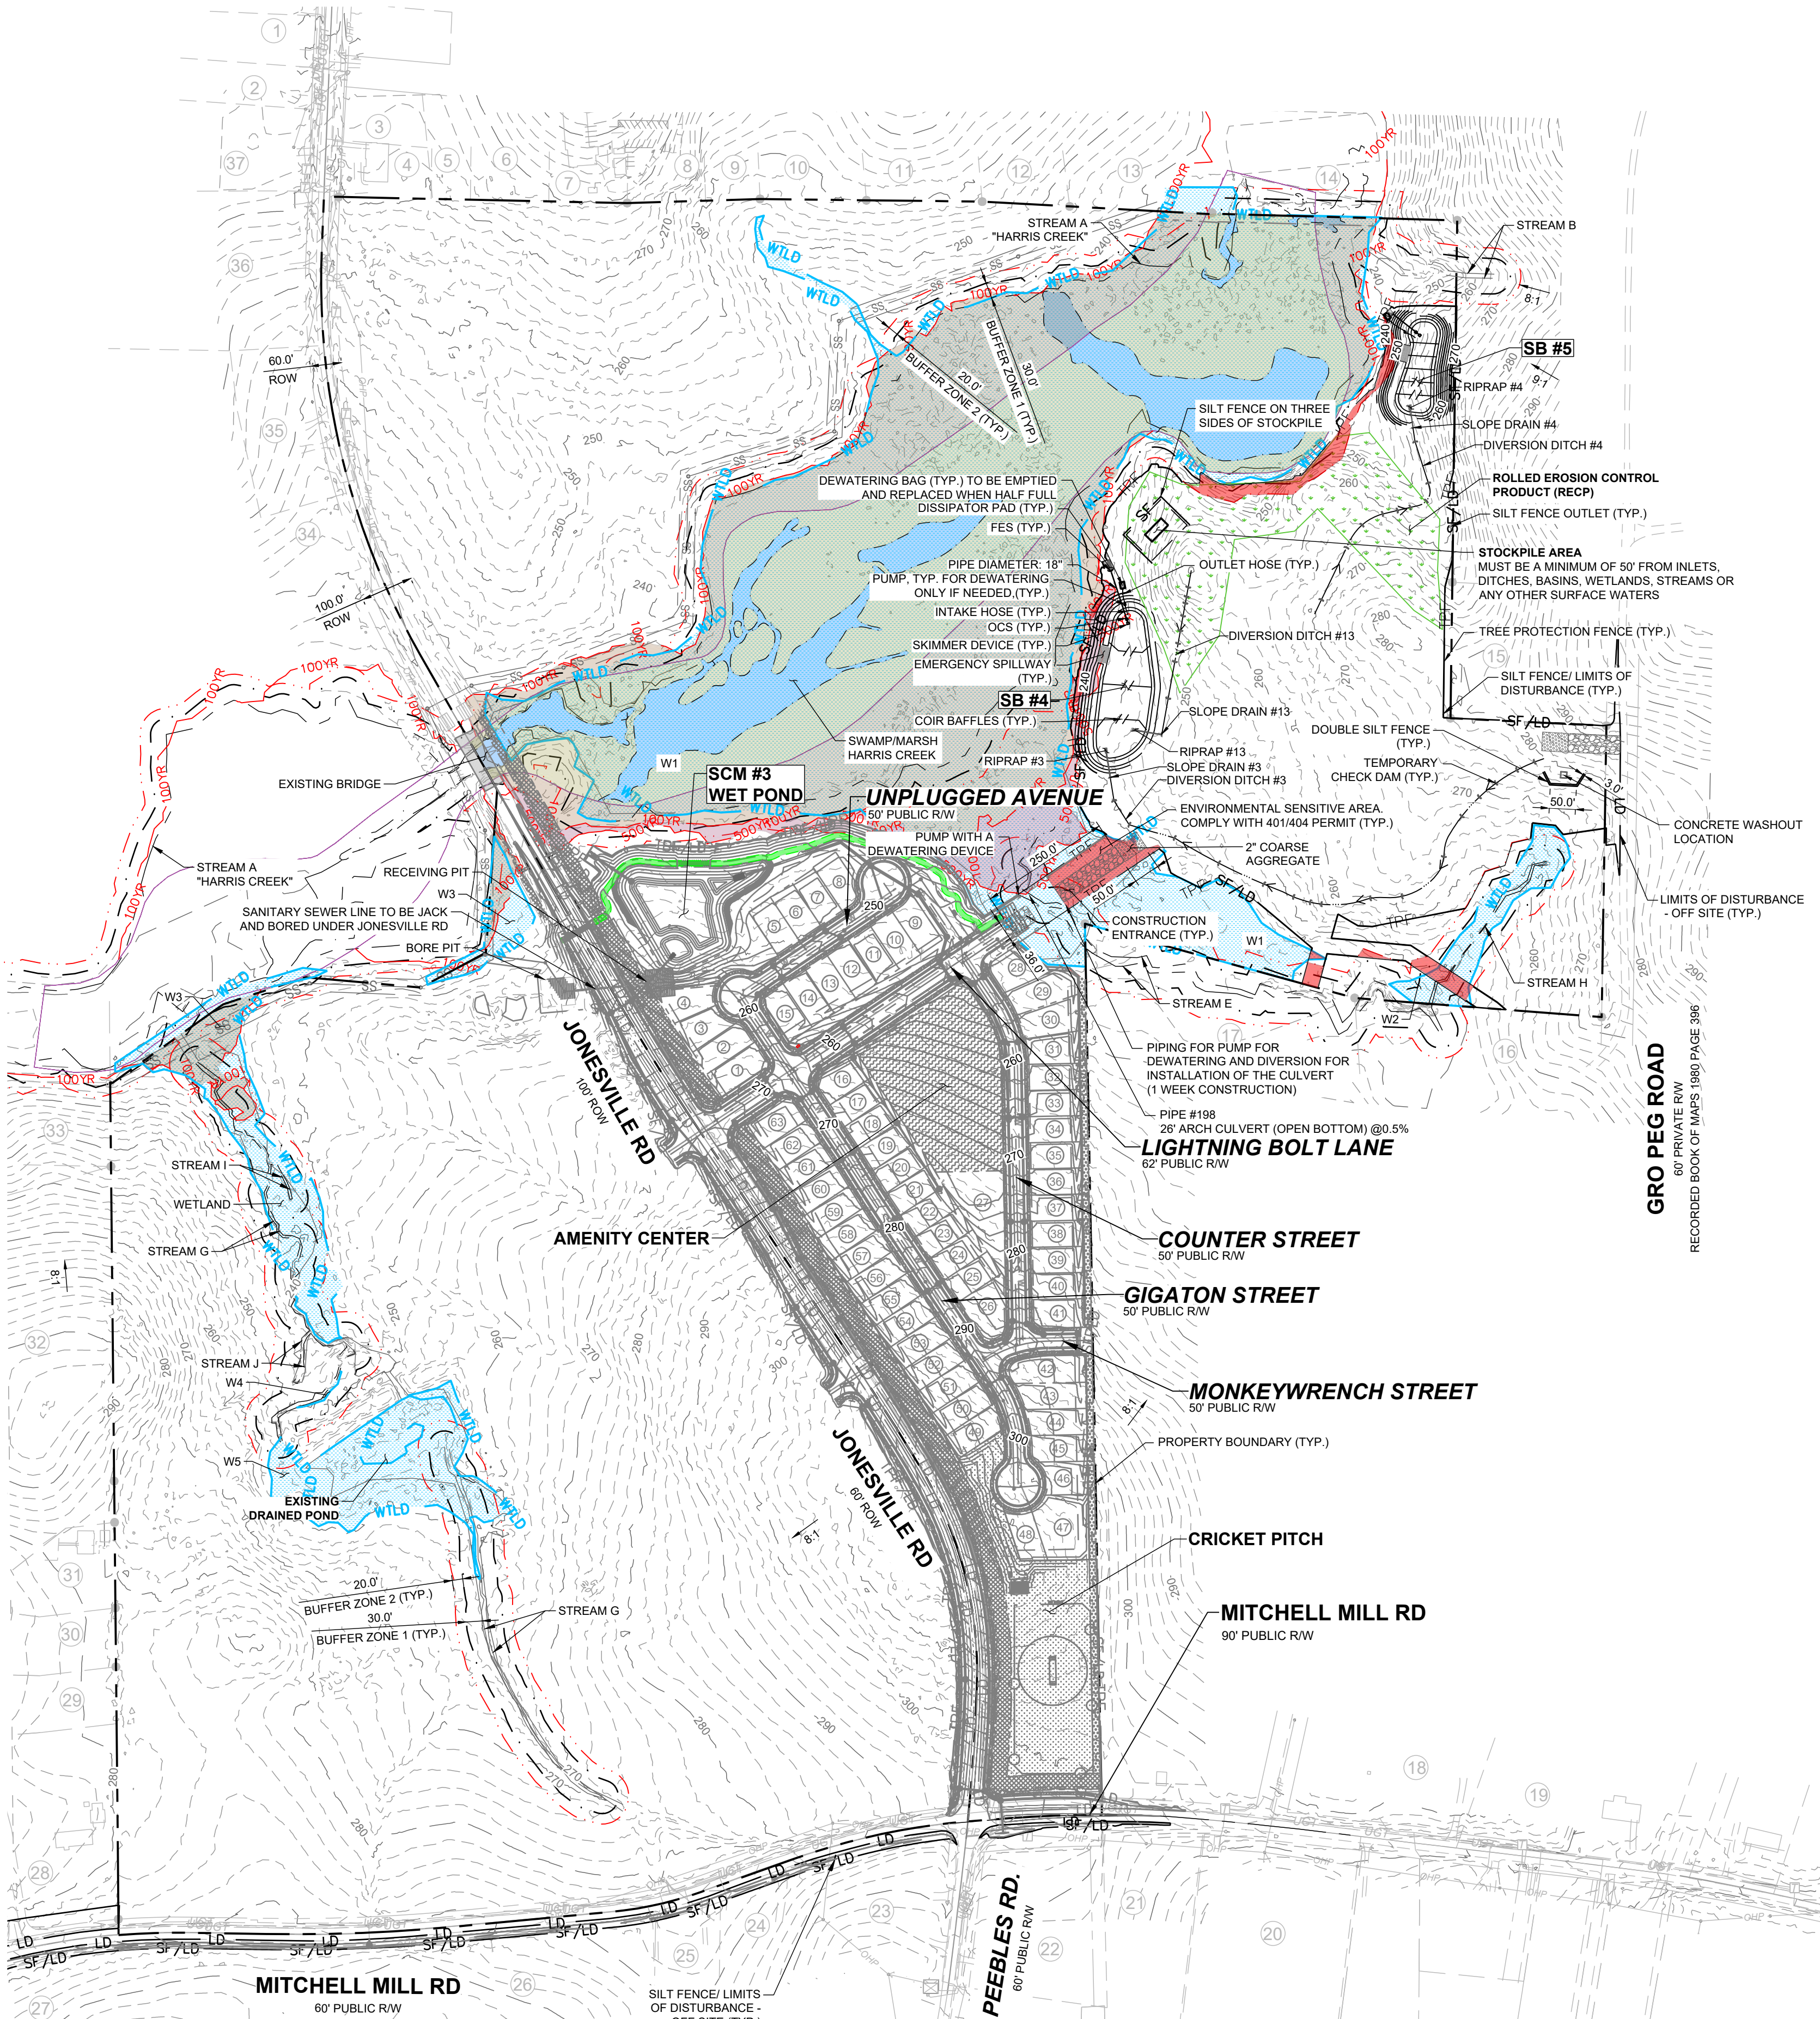

LEGEND:	
	EXISTING ADJOINER PROPERTY LINE
	EXISTING EDGE OF PAVEMENT
	EX. MAJOR CONTOURS
	EX. MINOR CONTOURS
	SILT FENCE/LIMITS OF DISTURBANCE
	LIMITS OF DISTURBANCE
	SILT FENCE
	TREE PROTECTION LINE
	TEMPORARY PROTECTION LINE
	BAFFLES
	TEMPORARY SLOPE DRAIN
	TEMPORARY SKIMMER
	SILT FENCE OUTLET
	CHECK DAM
	DISSIPATOR PAD
	CONSTRUCTION ENTRANCE
	EXISTING WETLAND
	ROLLED EROSION CONTROL
	ENVIRONMENTAL SENSITIVE AREA

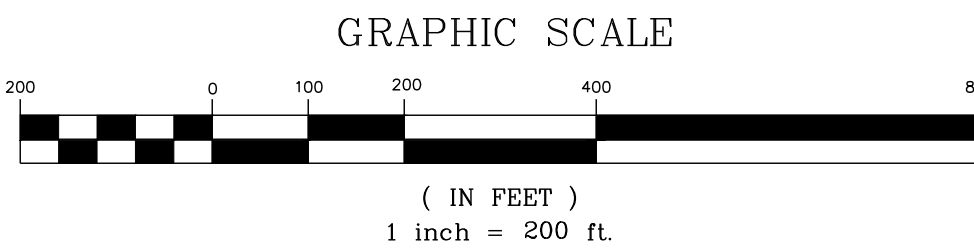

THIS PLANSET AND ANY ASSOCIATED DOCUMENTS ARE PRELIMINARY AND NOT AUTHORIZED FOR CONSTRUCTION UNTIL SIGNED, DATED, AND OFFICIALLY RELEASED FOR CONSTRUCTION BY THE ENGINEER OF RECORD.

STRONGROCK

ENGINEERING GROUP

STRONG ROCK ENGINEERING GROUP, PLLC | COMPANY LICENSE # P-2166
305 CHURCH AT NORTH HILLS STREET, SUITE 1110 RALEIGH, NC 27609 | INFORMATION@STRONGROCKGROUP.COM


STRONG ROCK PROJECT PSP-24-03	NOT FOR CONSTRUCTION	SCALE AS SHOWN	DESIGNED BY SRG	DRAWN BY SRG	CHECKED BY SRG
----------------------------------	-------------------------	-------------------	--------------------	-----------------	-------------------

RESERVE @ MITCHELL MILL
TOWN OF ROLESVILLE, WAKE COUNTY, NORTH CAROLINA
CONSTRUCTION PLANS
EROSION CONTROL PLAN OVERALL
PHASE 2 - STAGE 1

DRAWING
SHEET
C-10.7


66 OF 230

---------------	---------------	--------------

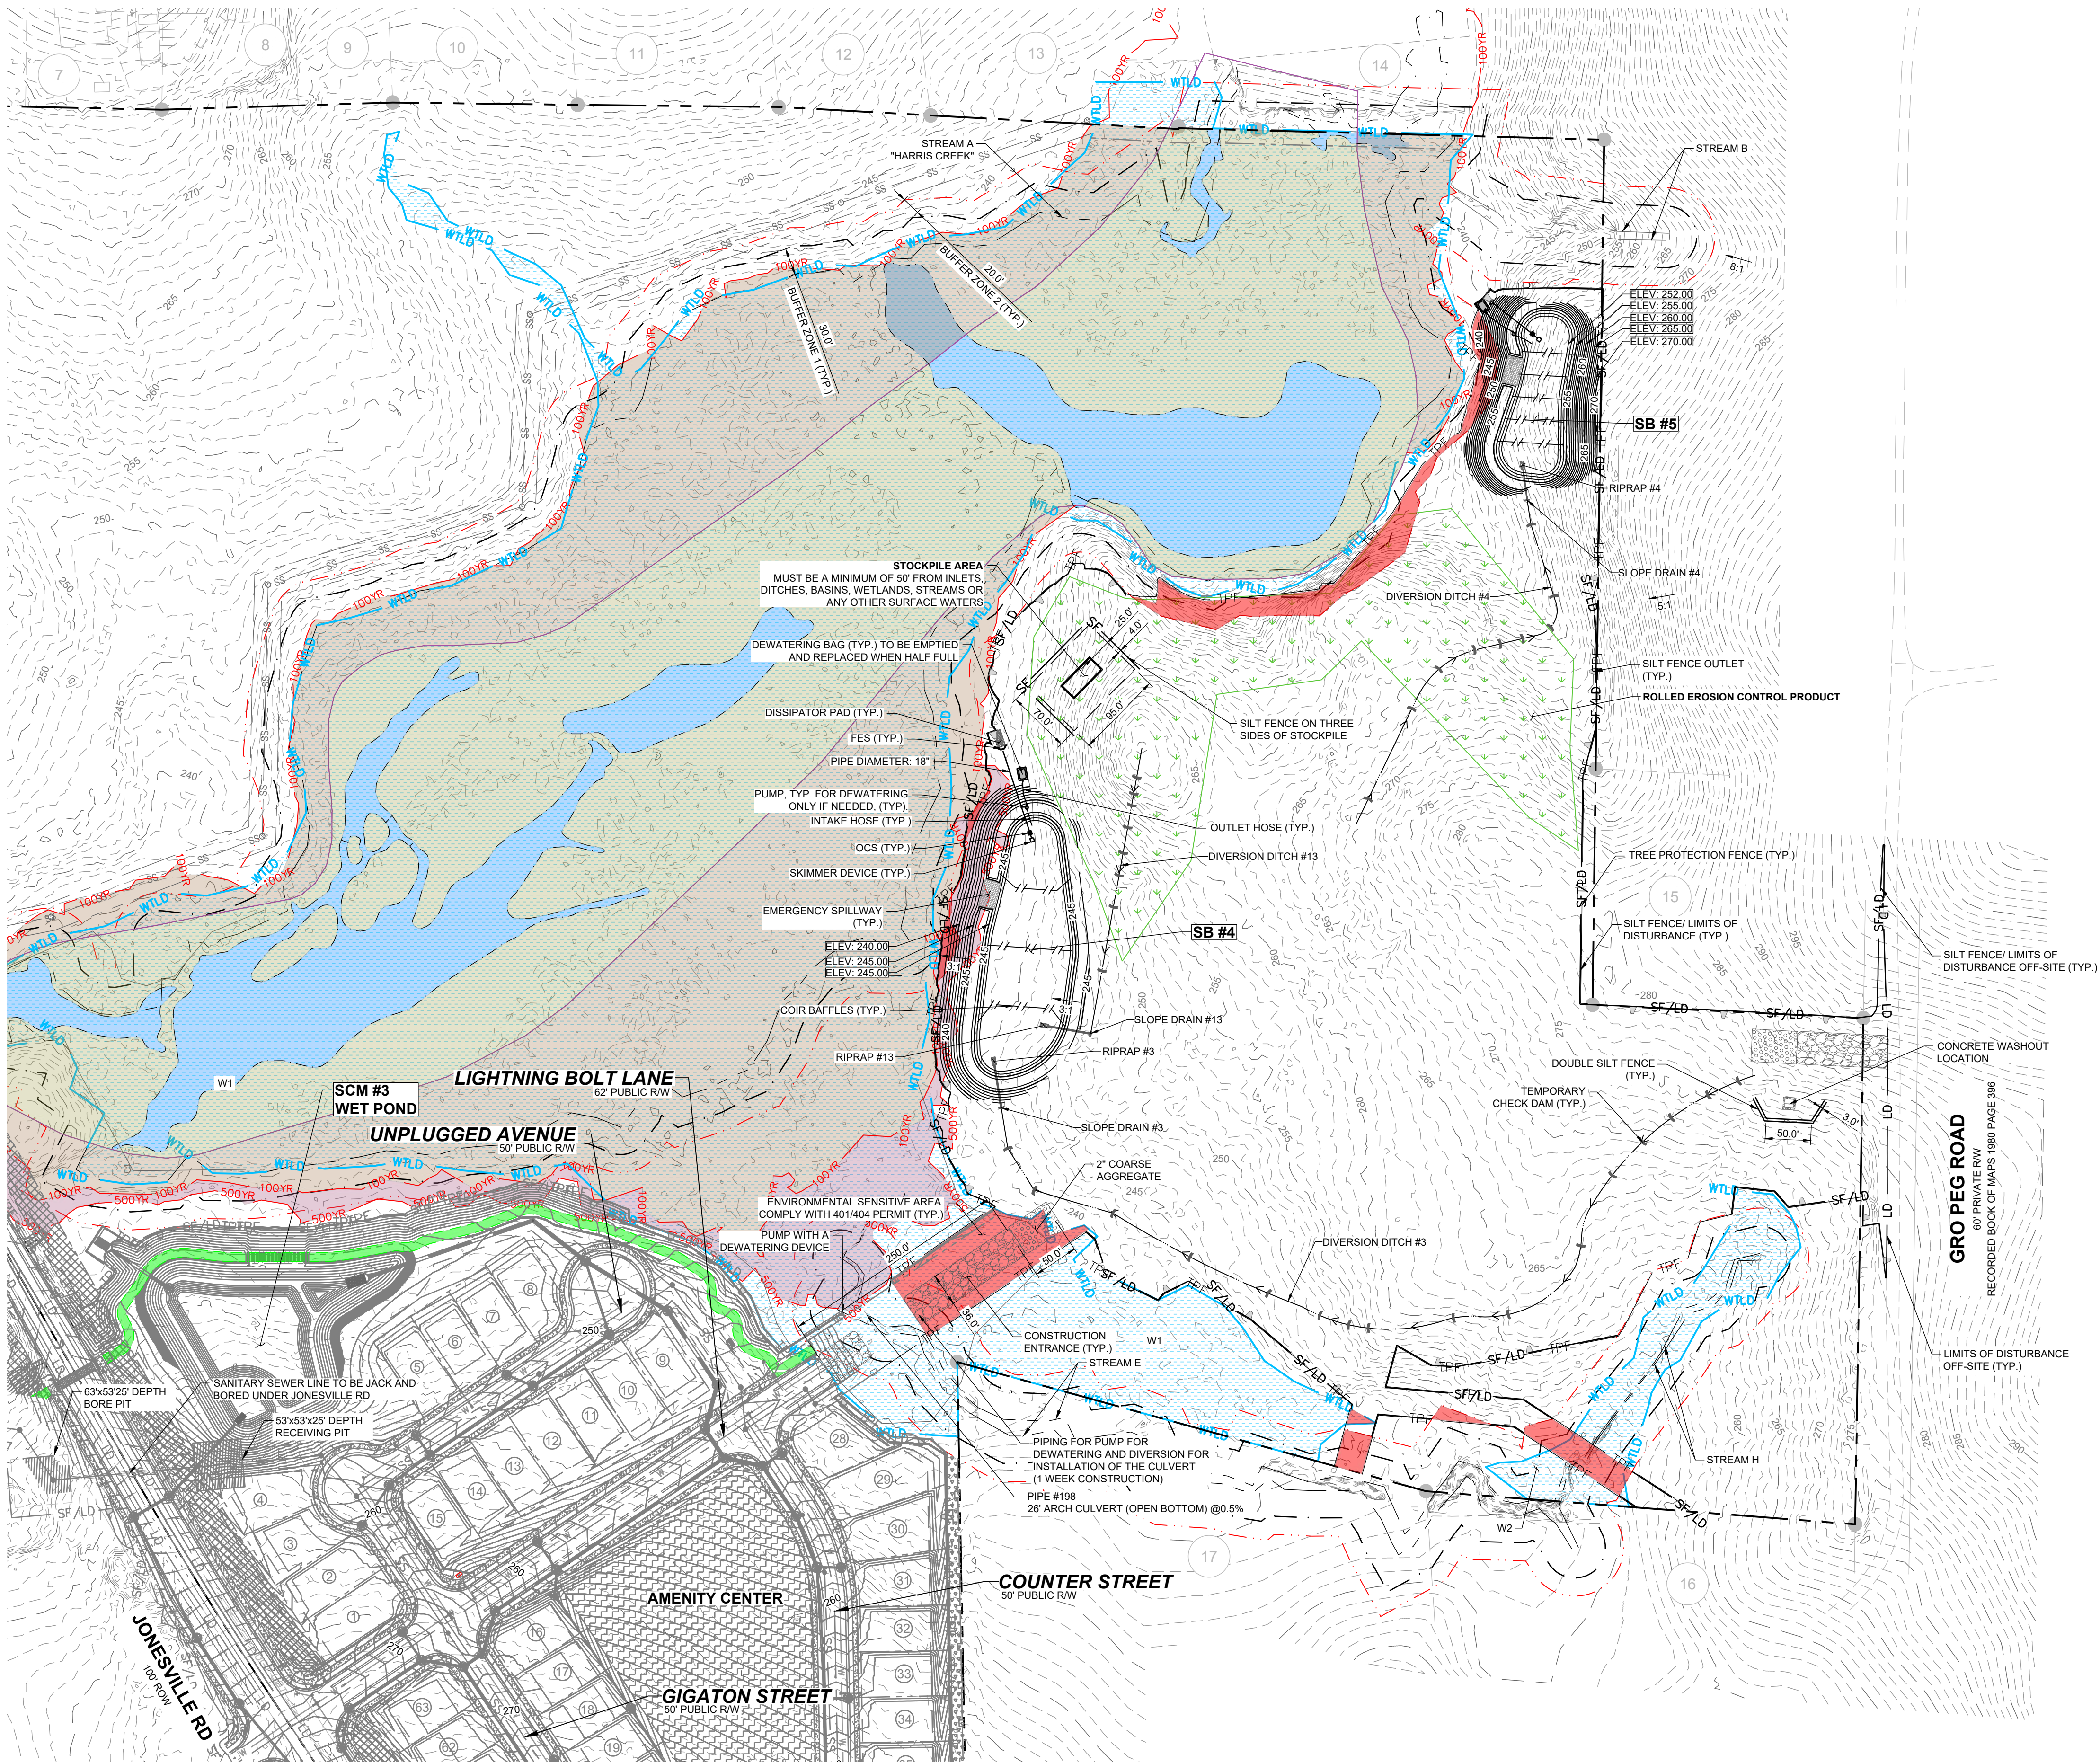


NOTE:

1. PHASE 2, ACREAGE: 16.37 AC.
2. EROSION CONTROL NOTES: SEE SHEET C-10.0
3. ALL LAND-DISTURBING ACTIVITIES MUST BE PLANNED AND CONDUCTED TO LIMIT THE EXPOSED AREA TO 50 ROLLING ACRES.
4. STOCKPILE HEIGHT SHALL NOT EXCEED 35 FEET.

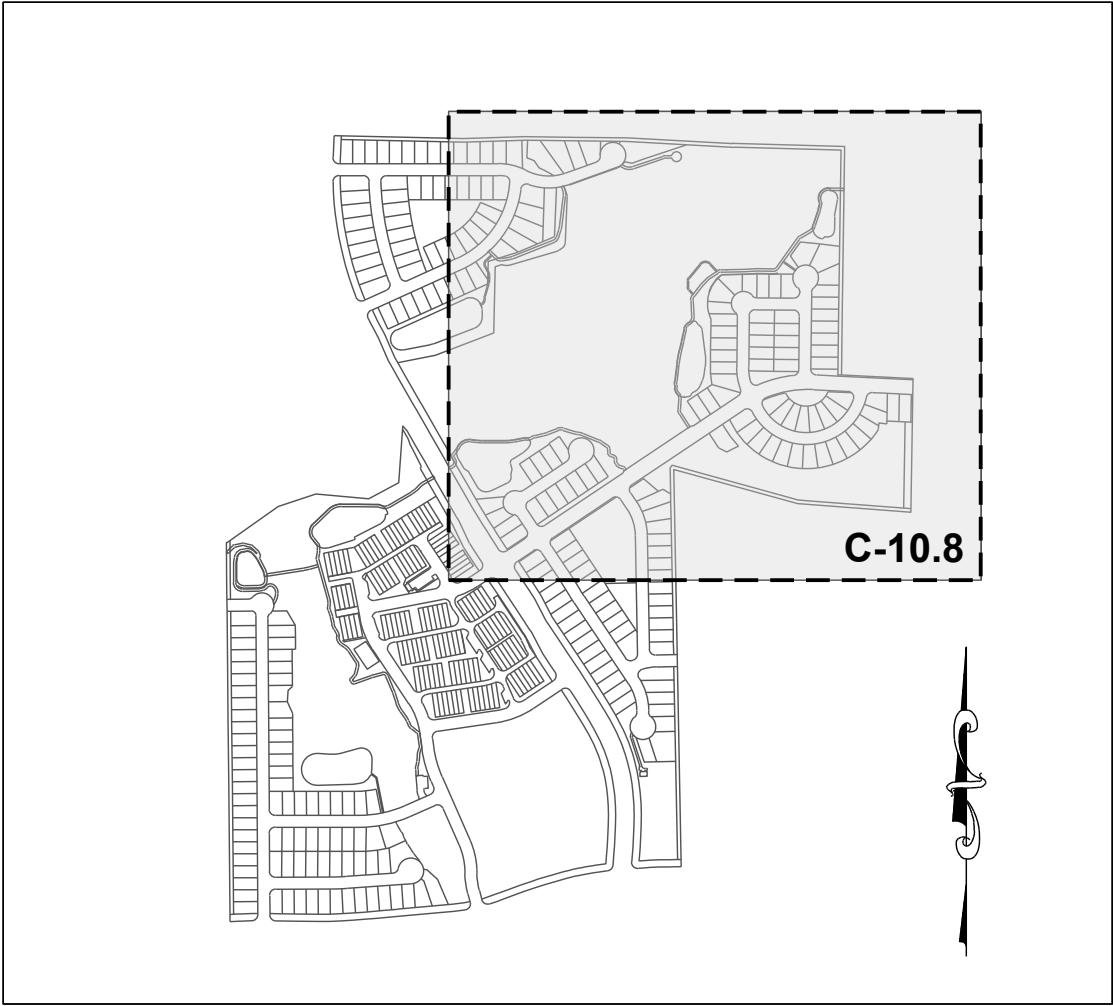

SITE KEY PLAN

LEGEND:	
---	EXISTING ADJOINER PROPERTY LINE
---	EXISTING EDGE OF PAVEMENT
---	EX. MAJOR CONTOURS
---	EX. MINOR CONTOURS
SF/LD	SILT FENCE/LIMITS OF DISTURBANCE
LD	LIMITS OF DISTURBANCE
SF	SILT FENCE
TPF	TREE PROTECTION FENCE
---	TEMPORARY DITCH
---	BAFFLES
---	TEMPORARY SLOPE DRAIN
---	TEMPORARY SKIMMER
---	SILT FENCE OUTLET
---	CHECK DAM
---	DISSIPATOR PAD
---	CONSTRUCTION ENTRANCE
---	EXISTING WETLAND
---	ROLLED EROSION CONTROL
---	ENVIRONMENTAL SENSITIVE AREA

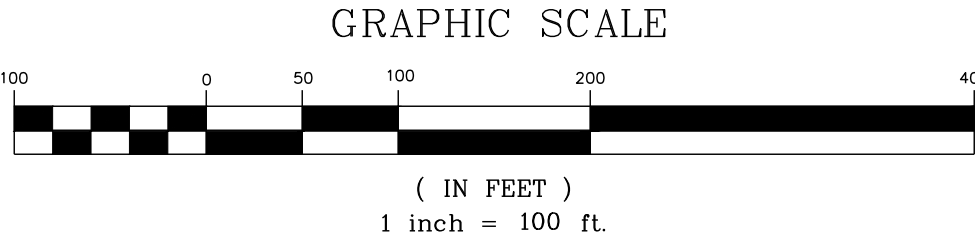

THIS PLANSET AND ANY ASSOCIATED DOCUMENTS ARE PRELIMINARY AND NOT AUTHORIZED FOR CONSTRUCTION UNTIL SIGNED, DATED, AND OFFICIALLY RELEASED FOR CONSTRUCTION BY THE ENGINEER OF RECORD.

CONSTRUCTION INFRASTRUCTURE DRAWINGS	
01	CID-24-04
02	TOWN OF ROLESVILLE CID-24-04 V2
03	TOWN OF ROLESVILLE CID-24-04 V3
04	TOWN OF ROLESVILLE CID-24-04 V4

STRONGROCK

ENGINEERING GROUP

STRONG ROCK ENGINEERING GROUP, PLLC | COMPANY LICENSE # P-2166
305 CHURCH AT NORTH HILLS STREET, SUITE 1110 RALEIGH, NC 27609 | INFORMATION@STRONGROCKGROUP.COM

STRONG ROCK PROJECT	STRONG ROCK PROJECT
PSP-24-03	PSP-24-03
NOT FOR CONSTRUCTION	NOT FOR CONSTRUCTION
SCALE AS SHOWN	SCALE AS SHOWN
DESIGNED BY SRG	DESIGNED BY SRG
DRAWN BY SRG	DRAWN BY SRG
CHECKED BY SRG	CHECKED BY SRG




RESERVE @ MITCHELL MILL
TOWN OF ROLESVILLE, WAKE COUNTY, NORTH CAROLINA
CONSTRUCTION PLANS
EROSION CONTROL PLAN
PHASE 2 - STAGE 1

DRAWING SHEET
C-10.8

ADJOINER INFORMATION			
1	CHARLES E. FERRELL AND WIFE GRETIA LOUISE FERRELL PIN: 1757481951 DB 1813 PG 421 ZONING: R-30 (WC) USE: SF	20	CECIL L. GOODNIGHT AND WIFE, JUDY J. GOODNIGHT PIN: 1757650296 DB 5344 PG 819 ZONING: R-30 (WC) USE: SF
2	ABRAHAM T. BURNHAM AND KYLA L. BURNHAM PIN: 1757481832 DB 1940 PG 734 ZONING: R-30 (WC) USE: SF	21	CECIL L. GOODNIGHT AND WIFE, JUDY J. GOODNIGHT PIN: 1757641415 DB 5344 PG 819 ZONING: R-30 (WC) USE: VA
3	JOE L. GREEN PIN: 1757483799 DB 15-E PG 2691 ZONING: R-30 (WC) USE: SF	22	CHRISTOPHER GHOLSON AND WIFE, KELLY GAITHER GHOLSON PIN: 1757555361 DB 17855 PG 457 LOT 4 - BM 2018 PG 1333 ZONING: R-30 (WC) USE: SF
4	CHARLES ALFONSA JONES AND WIFE ALLIE V. JONES PIN: 1757484609 DB 2305 PG 673 ZONING: R-30 (WC) USE: SF	23	ABAHOR ELIAS AND SPOUSE, SUSAN ELIAS PIN: 1757553215 DB 17220 PG 2609 LOT 3 - BM 2018 PG 1333 ZONING: R-30 (WC) USE: SF
5	BENJAMIN FERRELL PIN: 1757485713 DB 1697 PG 465 ZONING: R-30 (WC) USE: SF	24	TODD KENDALL HONEYCUTT PIN: 1757551202 DB 13474 PG 1974 LOT 2 - BM 2018 PG 1333 ZONING: R-30 (WC) USE: SF
6	ALESIA FERRELL & ARRON WALKER PIN: 1757489733 DB 6374 PG 89 BM 1996 PG 00524 ZONING: R-30 (WC) USE: SF	25	CURTIS L. HONEYCUTT AND WIFE TODD KENDALL PIN: 1757540996 DB 19269 PG 2474 LOT 1 - BM 2018 PG 1333 ZONING: R-30 (WC) USE: SF
7	CHRIST HOLINESS CHURCH #1 PIN: 1757487783 DB 2928 PG 328 ZONING: R-30 (WC) USE: CH	26	PHETIS JONES BRADSHER PIN: 1757349473 DB 15208 PG 2320 BM 2013 PG 868 ZONING: R-30 (WC) USE: FO
8	CHRIST HOLINESS CHURCH #1 PIN: 1757489733 DB 4321 PG 788 ZONING: R-30 (WC) USE: VA	27	PHETIS JONES BRADSHER PIN: 1757349473 DB 15208 PG 2320 ZONING: R-30 (WC) USE: FO
9	CHRIST HOLINESS CHURCH #1 PIN: 1757580764 DB 8467 PG 430 ZONING: R-30 (WC) USE: VA	28	PERR Y. ELWOOD RYAN PIN: 1757357592 DB 19292 PG 2780 ZONING: R-30 (WC) USE: MO
10	ALICIA BROWN & CARL T. JONES PIN: 1757582714 DB 18128 PG 183 ZONING: R-30 (WC) USE: SF	29	TOUTLOFF, KENNETH S. TOUTLOFF, BILLIE ANNE PIN: 1757357764 DB 9236 PG 2229 LOT 3 - BM 1990 PG 956 ZONING: R-30 (WC) USE: SF
11	RS RENTAL II LLC PIN: 1757584724 DB 18703 PG 2414 BM 1981 PG 894 ZONING: R-30 (WC) USE: SF	30	BERNARD MILLER PIN: 1757357865 DB 15416 PG 1651 LOT 4 - BM 1990 PG 956 ZONING: R-30 (WC) USE: SF
12	KAREN E. BASS PIN: 1757585704 DB 12560 PG 1626 BM 1984 PG 943 ZONING: R-30 (WC) USE: SF	31	MARCIE L. HOLDEN PIN: 1757358908 DB 15589 PG 1003 LOT 5 - BM 1990 PG 956 ZONING: R-30 (WC) USE: SF
13	JAMES K. WILLIAMS PIN: 1757585784 DB 16784 PG 1013 BM 1989 PG 01474 ZONING: R-30 (WC) USE: VA	32	MEGAN KULAWIAK PIN: 1757387367 DB 16226 PG 1133 LOT 6 BM 1989 PG 00387 ZONING: R-30 (WC) USE: VA
14	GRO PEG PROPERTIES LLC PIN: 1757684897 DB 18359 PG 1707 LOT 5 - BM 1980 PG 00396 ZONING: R-30 (WC) USE: VA	33	KENNETH INVESTMENT LLC PIN: 1757368816 DB 19248 PG 1884 ZONING: R-30 (WC) USE: VA
15	SCOTT & THERESA CARLE PIN: 1757678786 DB 14863 PG 2493 LOT 4A - BM 1980 PG 00396 ZONING: R-30 (WC) USE: VA	34	KENNETH INVESTMENT LLC PIN: 1757471559 DB 19248 PG 1884 LOT - BM 2007 PG 01224 ZONING: R-30 (WC) USE: VA
16	GRO PEG PROPERTIES PIN: 1757664956 DB 19081 PG 2786 LOT 2A - BM 1982 PG 00581 ZONING: R-30 (WC) USE: VA	35	HENRY ALSTON PIN: 1757481376 DB 19248 PG 984 BM 1982 PG 721 ZONING: R-30 (WC) USE: SF
17	MT. CALVARY HOLINESS CHURCH OF WAKE CO. INC PIN: 1757660324 DB 10124 PG 2778 LOT 1 - BM 2002 PG 991 ZONING: R-30 (WC) USE: VA	36	UNIVERSAL CHURCH OF PRAYER PIN: 1757388408 DB 19559 PG 1723 LOT - BM 2002 PG 00667 ZONING: R-30 (WC) USE: CH
18	G. ARCHIE UNDERHILL, JR. AND WIFE, TERESSA C. UNDERHILL PIN: 1757653765 DB 8443 PG 2129 BM 1999 PG 1357 ZONING: R-30 (WC) USE: SF	37	ROZELIA J. HARTSFIELD HEIRS PIN: 1757481740 DB 10-E PG 1220 ZONING: R-30 (WC) USE: VA
19	GENADIUS MAC PREDDY AND WIFE, MATTIE F. PREDDY PIN: 1757656586 DB 1882 PG 342 ZONING: R-30 (WC) USE: SF		

NOTE:

- PHASE 2, ACREAGE: 16.37 AC
- EROSION CONTROL NOTES: SEE SHEET C-10.0
- ALL LAND-DISTURBING ACTIVITIES MUST BE PLANNED AND CONDUCTED TO LIMIT THE EXPOSED AREA TO 50 ROLLING ACRES.
- STOCKPILE HEIGHT SHALL NOT EXCEED 35 FEET.

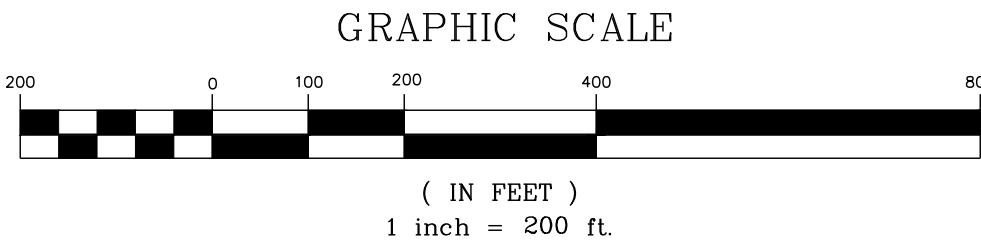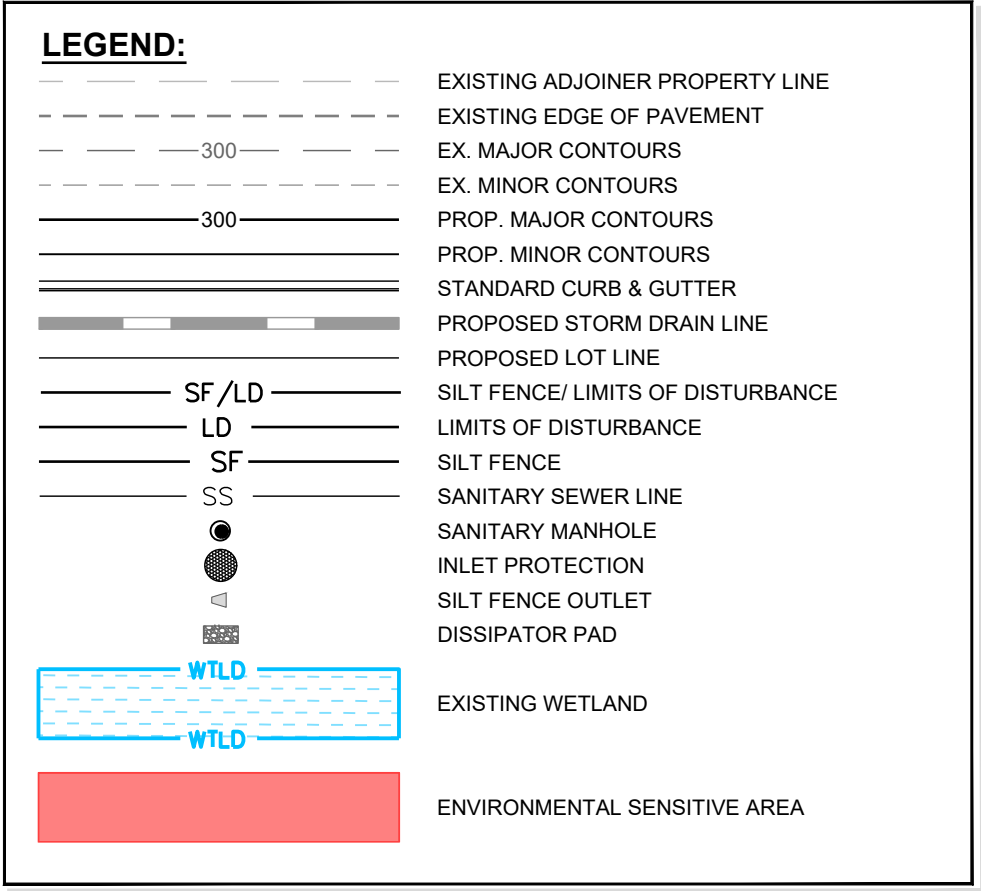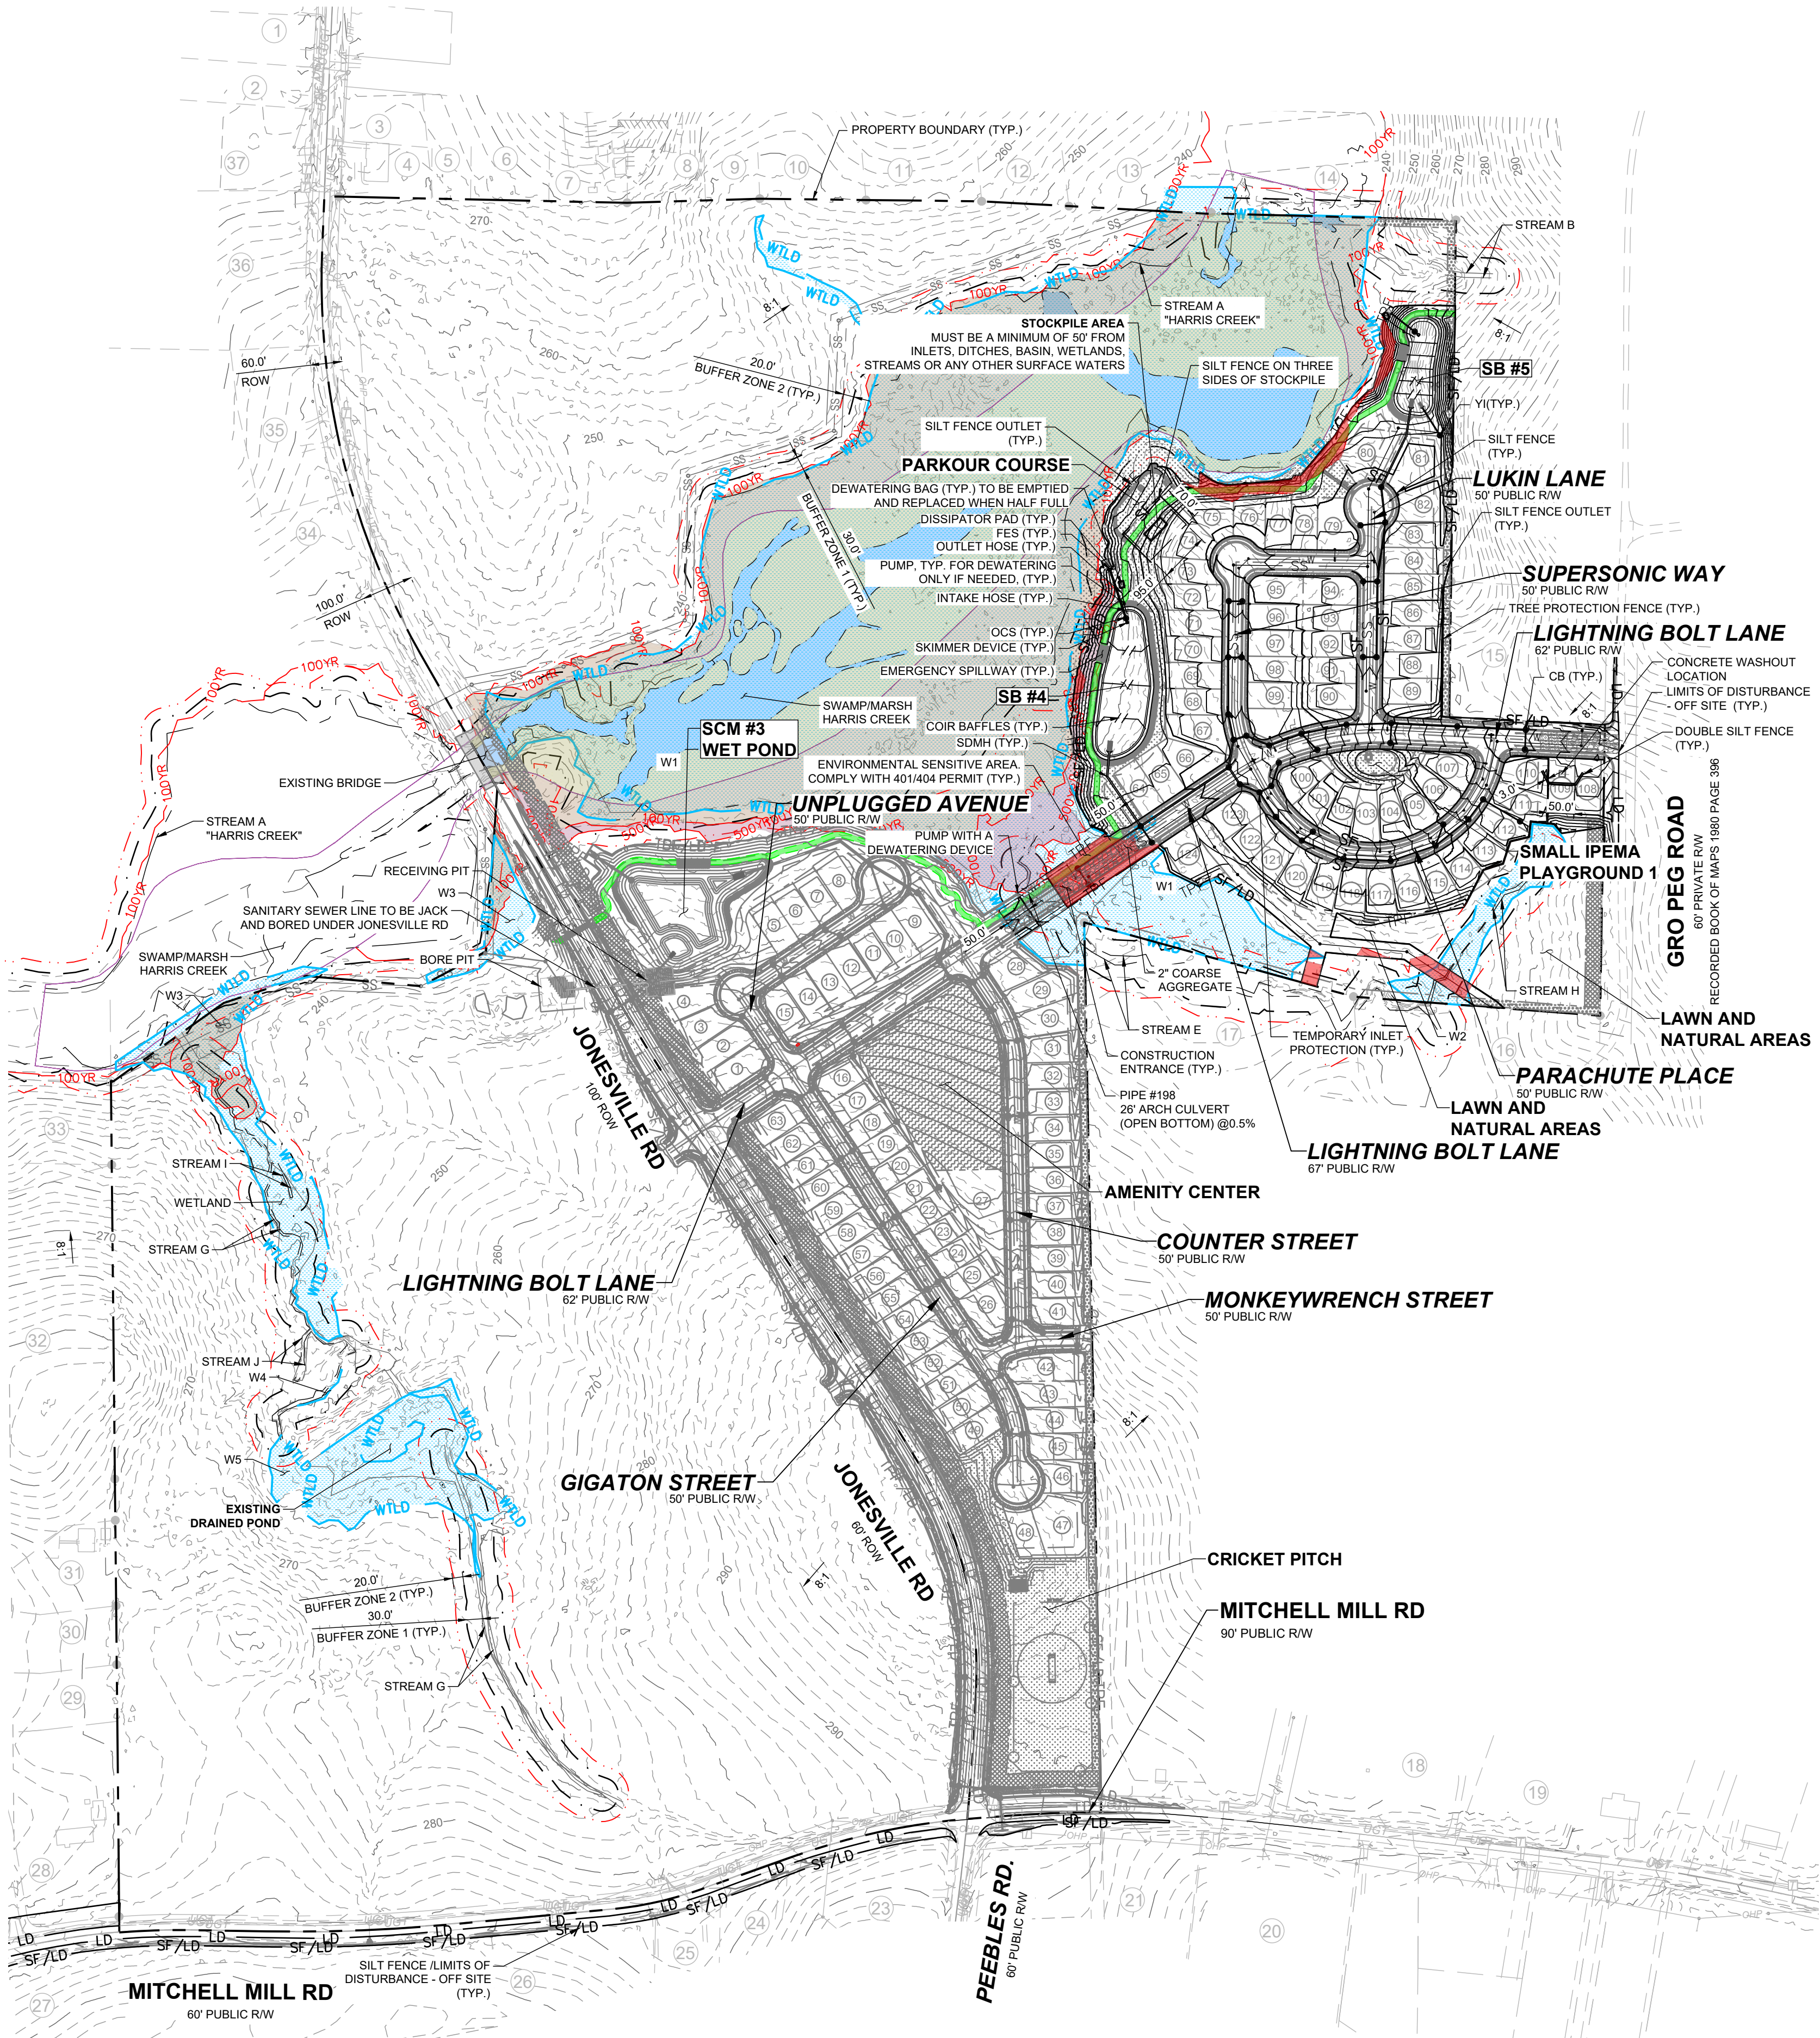

THIS PLANSET AND ANY ASSOCIATED DOCUMENTS ARE PRELIMINARY AND NOT AUTHORIZED FOR CONSTRUCTION UNTIL SIGNED, DATED, AND OFFICIALLY RELEASED FOR CONSTRUCTION BY THE ENGINEER OF RECORD.

CONSTRUCTION INFRASTRUCTURE DRAWINGS	CD-34-04	CD-34-04 V2	CD-34-04 V3	CD-34-04 V4	CD-34-04 V5	DATE
01	08/04/2024	11/01/2024	02/01/2024	08/02/2025	09/02/2025	
02						
03						
04						
05						
No.						

STRONGROCK

ENGINEERING GROUP

STRONG ROCK ENGINEERING GROUP, PLLC | COMPANY LICENSE # P-2166
305 CHURCH AT NORTH HILLS STREET, SUITE 1110 RALEIGH, NC 27609 | INFORMATION@STRONGROCKGROUP.COM



STRONG ROCK PROJECT	NOT FOR CONSTRUCTION	SCALE	AS SHOWN	SRG	SRG	SRG
PSP-24-03				DESIGNED BY	DRAWN BY	CHECKED BY

RESERVE @ MITCHELL MILL
TOWN OF ROLESVILLE, WAKE COUNTY, NORTH CAROLINA
CONSTRUCTION PLANS
EROSION CONTROL PLAN OVERALL
PHASE 2 - STAGE 2

DRAWING SHEET

C-10.9

68 OF 230

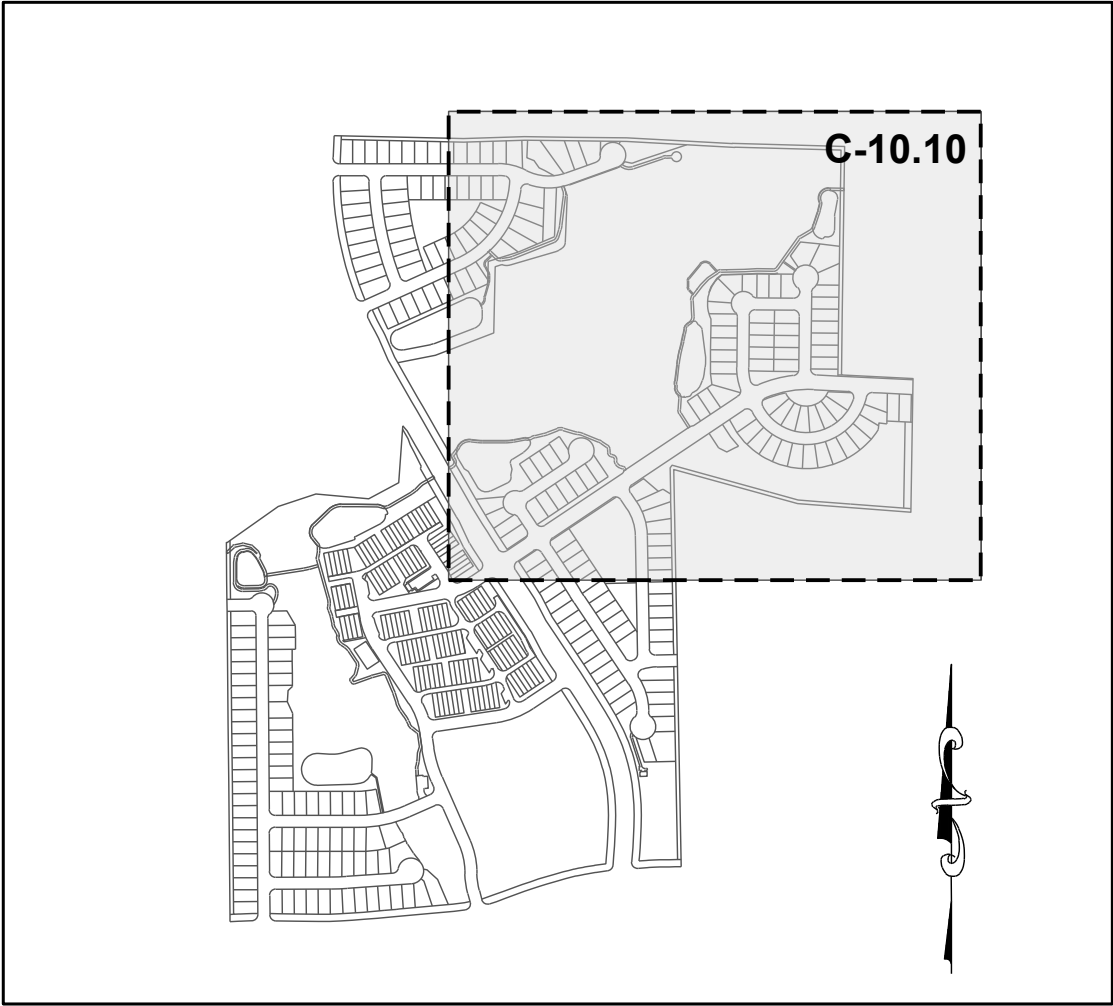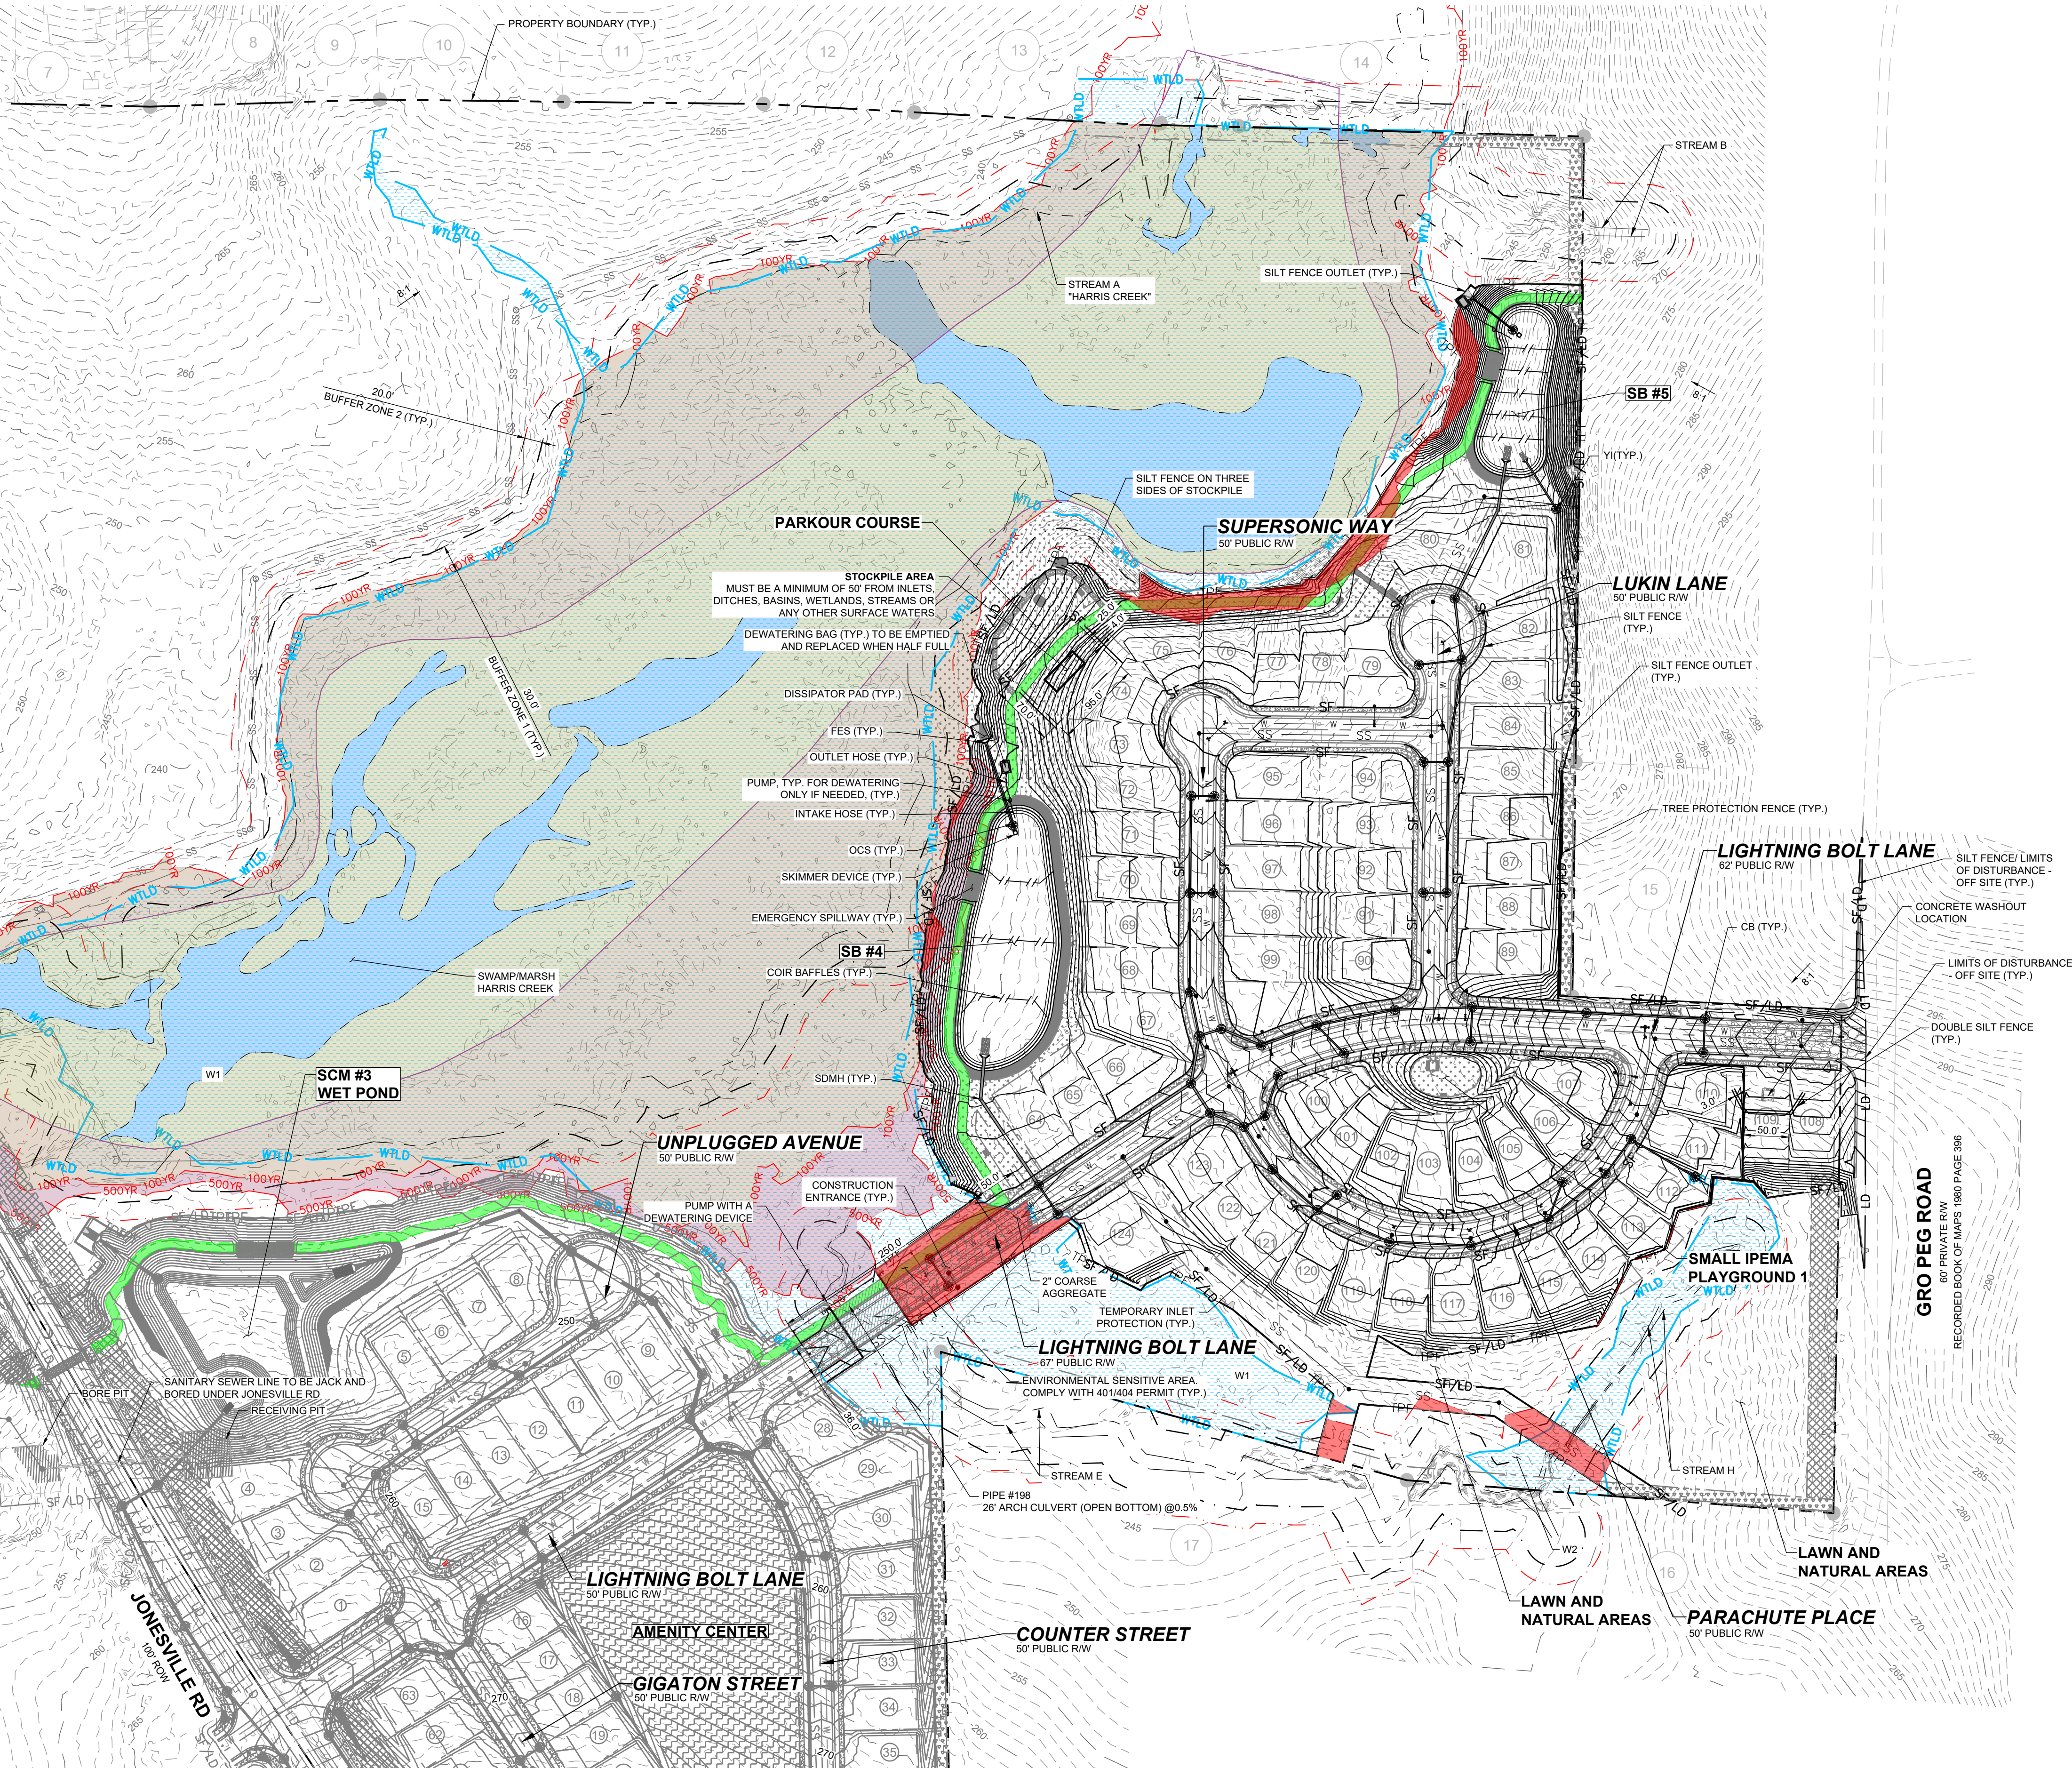


SITE KEY PLAN

LEGEND:

---	EXISTING ADJOINER PROPERTY LINE
---	EXISTING EDGE OF PAVEMENT
---	EX. MAJOR CONTOURS
---	EX. MINOR CONTOURS
---	PROP. MAJOR CONTOURS
---	PROP. MINOR CONTOURS
---	STANDARD CURB & GUTTER
---	PROPOSED STORM DRAIN LINE
---	PROPOSED LOT LINE
SF/LD	SILT FENCE/LIMITS OF DISTURBANCE
LD	LIMITS OF DISTURBANCE
SF	SILT FENCE
SS	SANITARY SEWER LINE
●	SANITARY MANHOLE
△	INLET PROTECTION
△	SILT FENCE OUTLET
△	DISSIPATOR PAD
WTLD	EXISTING WETLAND
WTLD	WTLD
Red Area	ENVIRONMENTAL SENSITIVE AREA

NOTE:

- PHASE 2, ACREAGE: 16.37 AC
- EROSION CONTROL NOTES: SEE SHEET C-10.0
- ALL LAND-DISTURBING ACTIVITIES MUST BE PLANNED AND CONDUCTED TO LIMIT THE EXPOSED AREA TO 50 ROLLING ACRES.
- STOCKPILE HEIGHT SHALL NOT EXCEED 35 FEET.

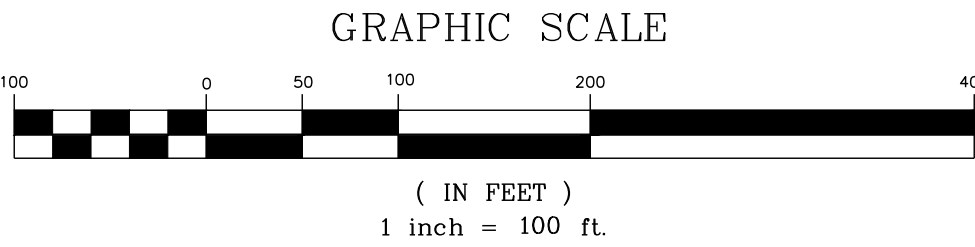

THIS PLANSET AND ANY ASSOCIATED DOCUMENTS ARE PRELIMINARY AND NOT AUTHORIZED FOR CONSTRUCTION UNTIL SIGNED, DATED, AND OFFICIALLY RELEASED FOR CONSTRUCTION BY THE ENGINEER OF RECORD.

CONSTRUCTION INFRASTRUCTURE DRAWINGS		DATE	BY
01	CID-24-04	08/04/2024	SRG
02	TOWN OF ROLESVILLE CID-24-04 V2	11/07/2024	SRG
03	TOWN OF ROLESVILLE CID-24-04 V3	02/07/2024	SRG
04	TOWN OF ROLESVILLE CID-24-04 V4	08/02/2025	SRG
05	TOWN OF ROLESVILLE CID-24-04 V5	08/02/2025	SRG
REVISIONS			
No.			



STRONGROCK
ENGINEERING GROUP
STRONG ROCK ENGINEERING GROUP, PLLC | COMPANY LICENSE # P-2166
305 CHURCH AT NORTH HILLS STREET, SUITE 1110 RALEIGH, NC 27609 | INFORMATION@STRONGROCKGROUP.COM

STRONG ROCK PROJECT	STRONG ROCK PROJECT
PSP-24-03	PSP-24-03
NOT FOR CONSTRUCTION	NOT FOR CONSTRUCTION
SCALE AS SHOWN	SCALE AS SHOWN
DESIGNED BY SRG	DESIGNED BY SRG
DRAWN BY SRG	DRAWN BY SRG
CHECKED BY SRG	CHECKED BY SRG

RESERVE @ MITCHELL MILL
TOWN OF ROLESVILLE, WAKE COUNTY, NORTH CAROLINA
CONSTRUCTION PLANS
EROSION CONTROL PLAN
PHASE 2 - STAGE 2

DRAWING SHEET

C-10.10

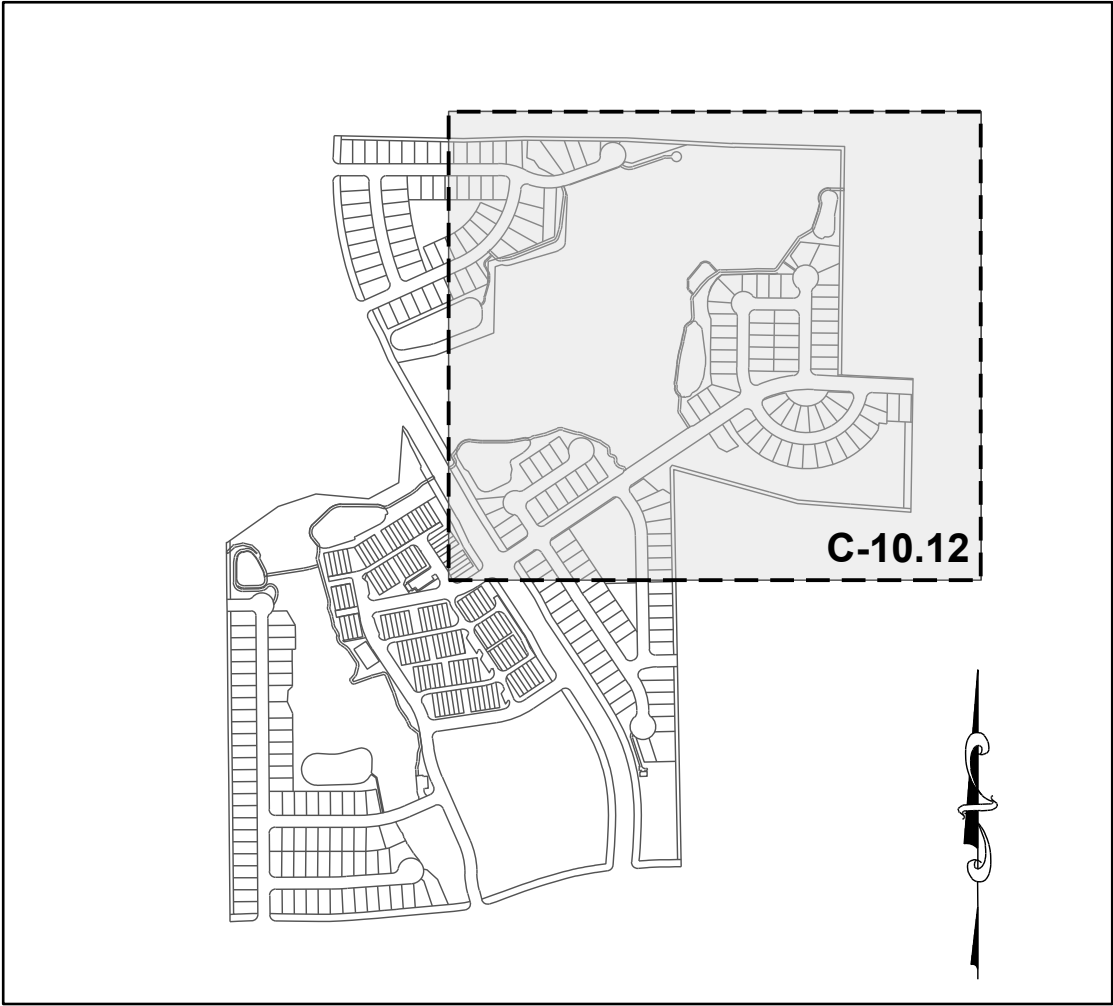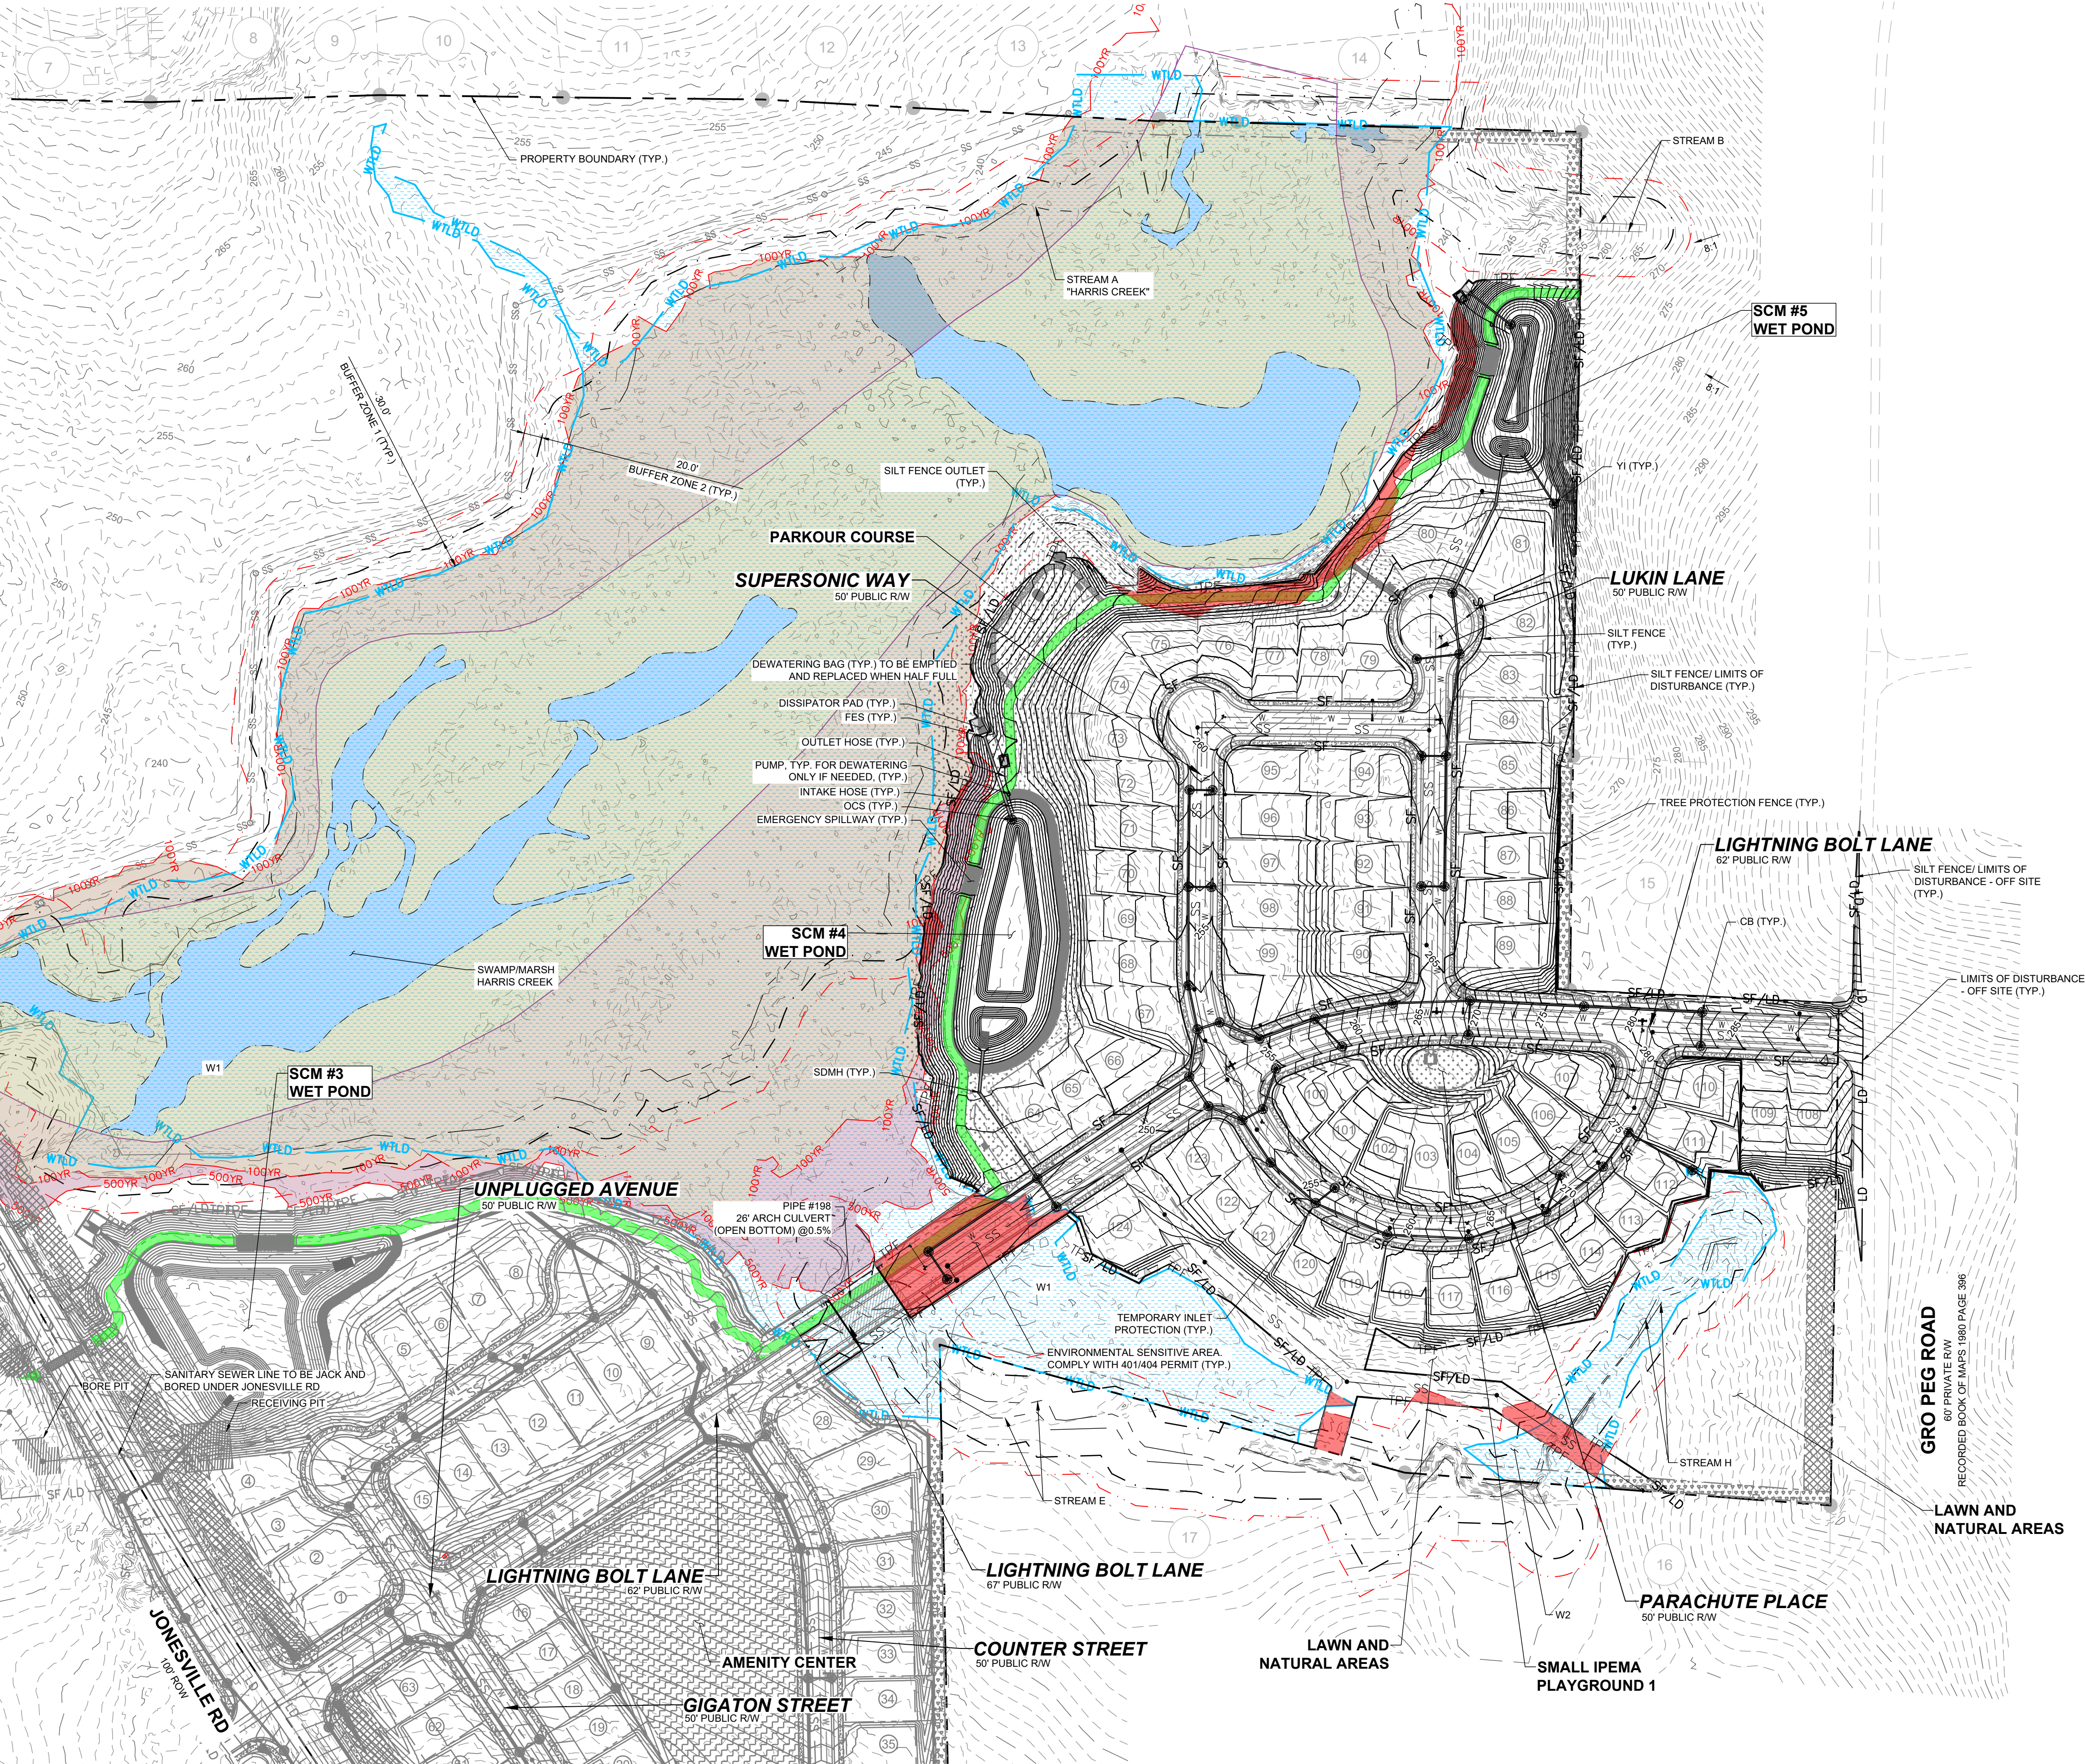


SITE KEY PLAN

LEGEND:	
	EXISTING ADJOINER PROPERTY LINE
	EXISTING EDGE OF PAVEMENT
	EX. MAJOR CONTOURS
	EX. MINOR CONTOURS
	PROP. MAJOR CONTOURS
	PROP. MINOR CONTOURS
	STANDARD CURB & GUTTER
	PROPOSED STORM DRAIN LINE
	PROPOSED LOT LINE
	SILT FENCE/ LIMITS OF DISTURBANCE
	LIMITS OF DISTURBANCE
	SILT FENCE
	SANITARY SEWER LINE
	SANITARY MANHOLE
	INLET PROTECTION
	SILT FENCE OUTLET
	DISSIPATOR PAD
	EXISTING WETLAND
	ENVIRONMENTAL SENSITIVE AREA

NOTE:

1. PHASE 2, ACREAGE: 16.37 AC
2. EROSION CONTROL NOTES: SEE SHEET C-10.0
3. ALL LAND-DISTURBING ACTIVITIES MUST BE PLANNED AND CONDUCTED TO LIMIT THE EXPOSED AREA TO 50 ROLLING ACRES.
4. STOCKPILE HEIGHT SHALL NOT EXCEED 35 FEET.

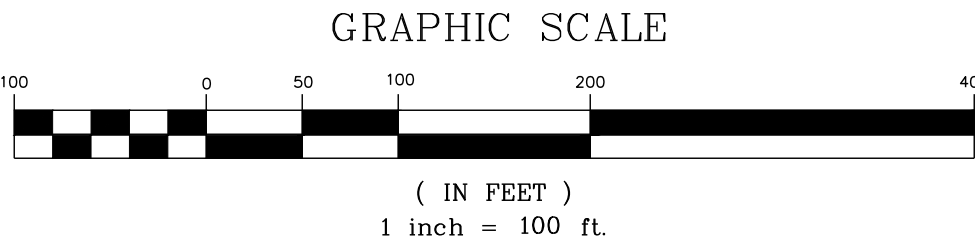

THIS PLANSET AND ANY ASSOCIATED DOCUMENTS ARE PRELIMINARY AND NOT AUTHORIZED FOR CONSTRUCTION UNTIL SIGNED, DATED, AND OFFICIALLY RELEASED FOR CONSTRUCTION BY THE ENGINEER OF RECORD.

CONSTRUCTION INFRASTRUCTURE DRAWINGS		DATE	BY
01	CID-24-04	08/04/2024	SRG
02	TOWN OF ROLESVILLE CID-24-04 V2	11/07/2024	SRG
03	TOWN OF ROLESVILLE CID-24-04 V3	02/07/2024	SRG
04	TOWN OF ROLESVILLE CID-24-04 V4	08/02/2025	SRG
05	TOWN OF ROLESVILLE CID-24-04 V5	09/02/2025	SRG
REVISIONS			
No.			

STRONGROCK

ENGINEERING GROUP

STRONG ROCK ENGINEERING GROUP, PLLC | COMPANY LICENSE # P-2166
305 CHURCH AT NORTH HILLS STREET, SUITE 1110 RALEIGH, NC 27609 | INFORMATION@STRONGROCKGROUP.COM

STRONG ROCK PROJECT	STRONG ROCK PROJECT
PSP-24-03	PSP-24-03
NOT FOR CONSTRUCTION	NOT FOR CONSTRUCTION
SCALE AS SHOWN	SCALE AS SHOWN
DESIGNED BY SRG	DESIGNED BY SRG
DRAWN BY SRG	DRAWN BY SRG
CHECKED BY SRG	CHECKED BY SRG



RESERVE @ MITCHELL MILL
TOWN OF ROLESVILLE, WAKE COUNTY, NORTH CAROLINA
CONSTRUCTION PLANS
EROSION CONTROL PLAN
PHASE 2 - STAGE 3

DRAWING SHEET

C-10.12

NOTE:

1. PHASE 3, ACREAGE: 17.64 AC
2. EROSION CONTROL NOTES: SEE SHEET C-10.0
3. ALL LAND-DISTURBING ACTIVITIES MUST BE PLANNED AND CONDUCTED TO LIMIT THE EXPOSED AREA TO 50 ROLLING ACRES.
4. STOCKPILE HEIGHT SHALL NOT EXCEED 35 FEET.

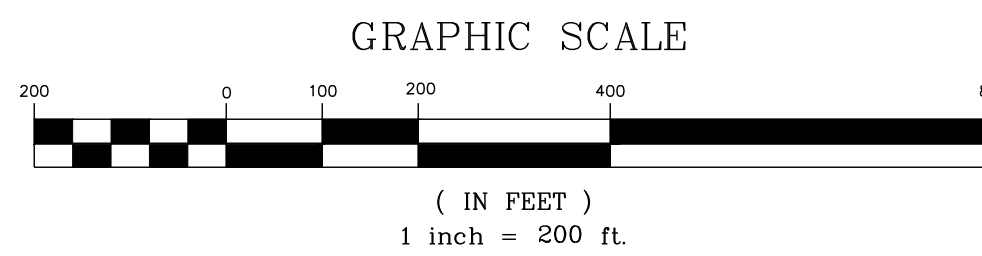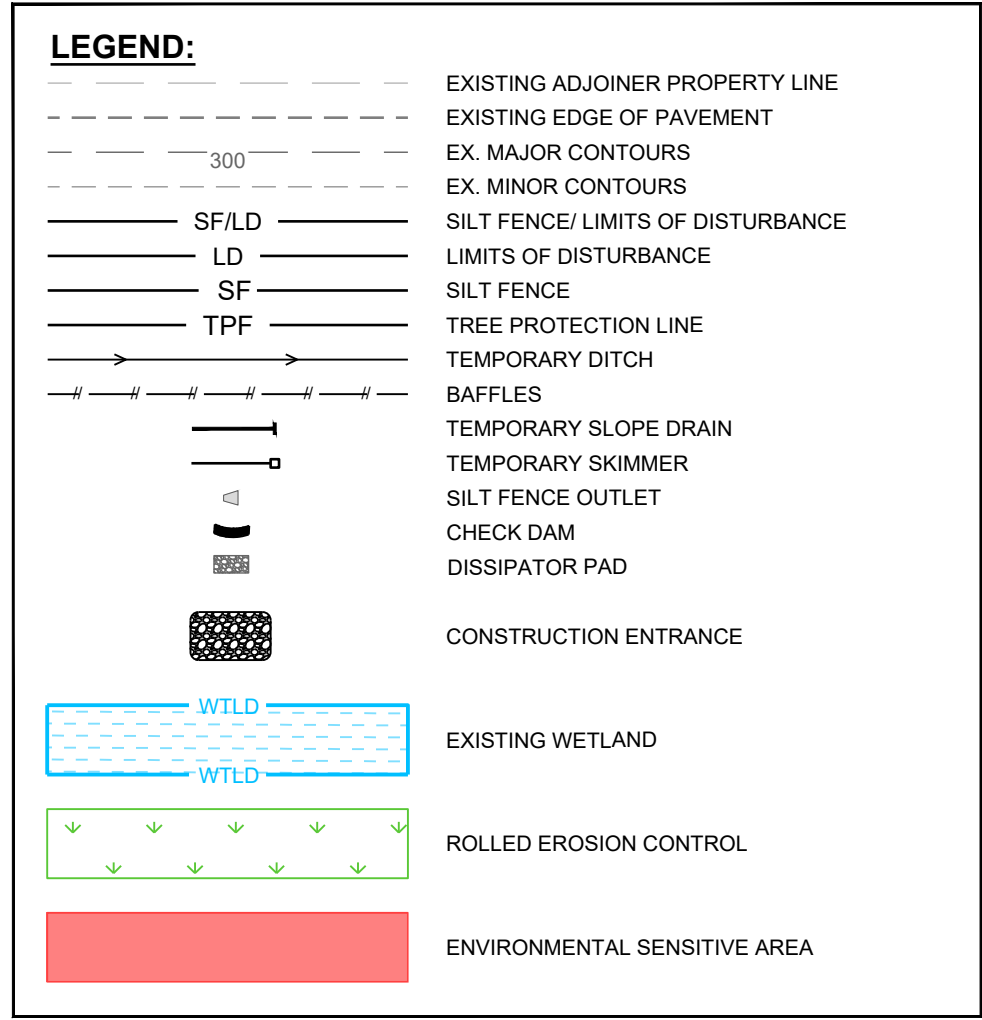

STRONGROCK
ENGINEERING GROUP


STRONG ROCK ENGINEERING GROUP, PLLC | COMPANY LICENSE # P-2766
1000 CHURCH AT NORTH HILLS STREET SUITE 1110 RALEIGH, NC 27609 | INFORMATION@STRONGROCKGROUP.COM

RESERVE @ MITCHELL MILL
TOWN OF ROLESVILLE, WAKE COUNTY, NORTH CAROLINA


CONSTRUCTION PLANS

EROSION CONTROL PLAN OVERALL
PHASE 3 - STAGE 1

72 OF 230

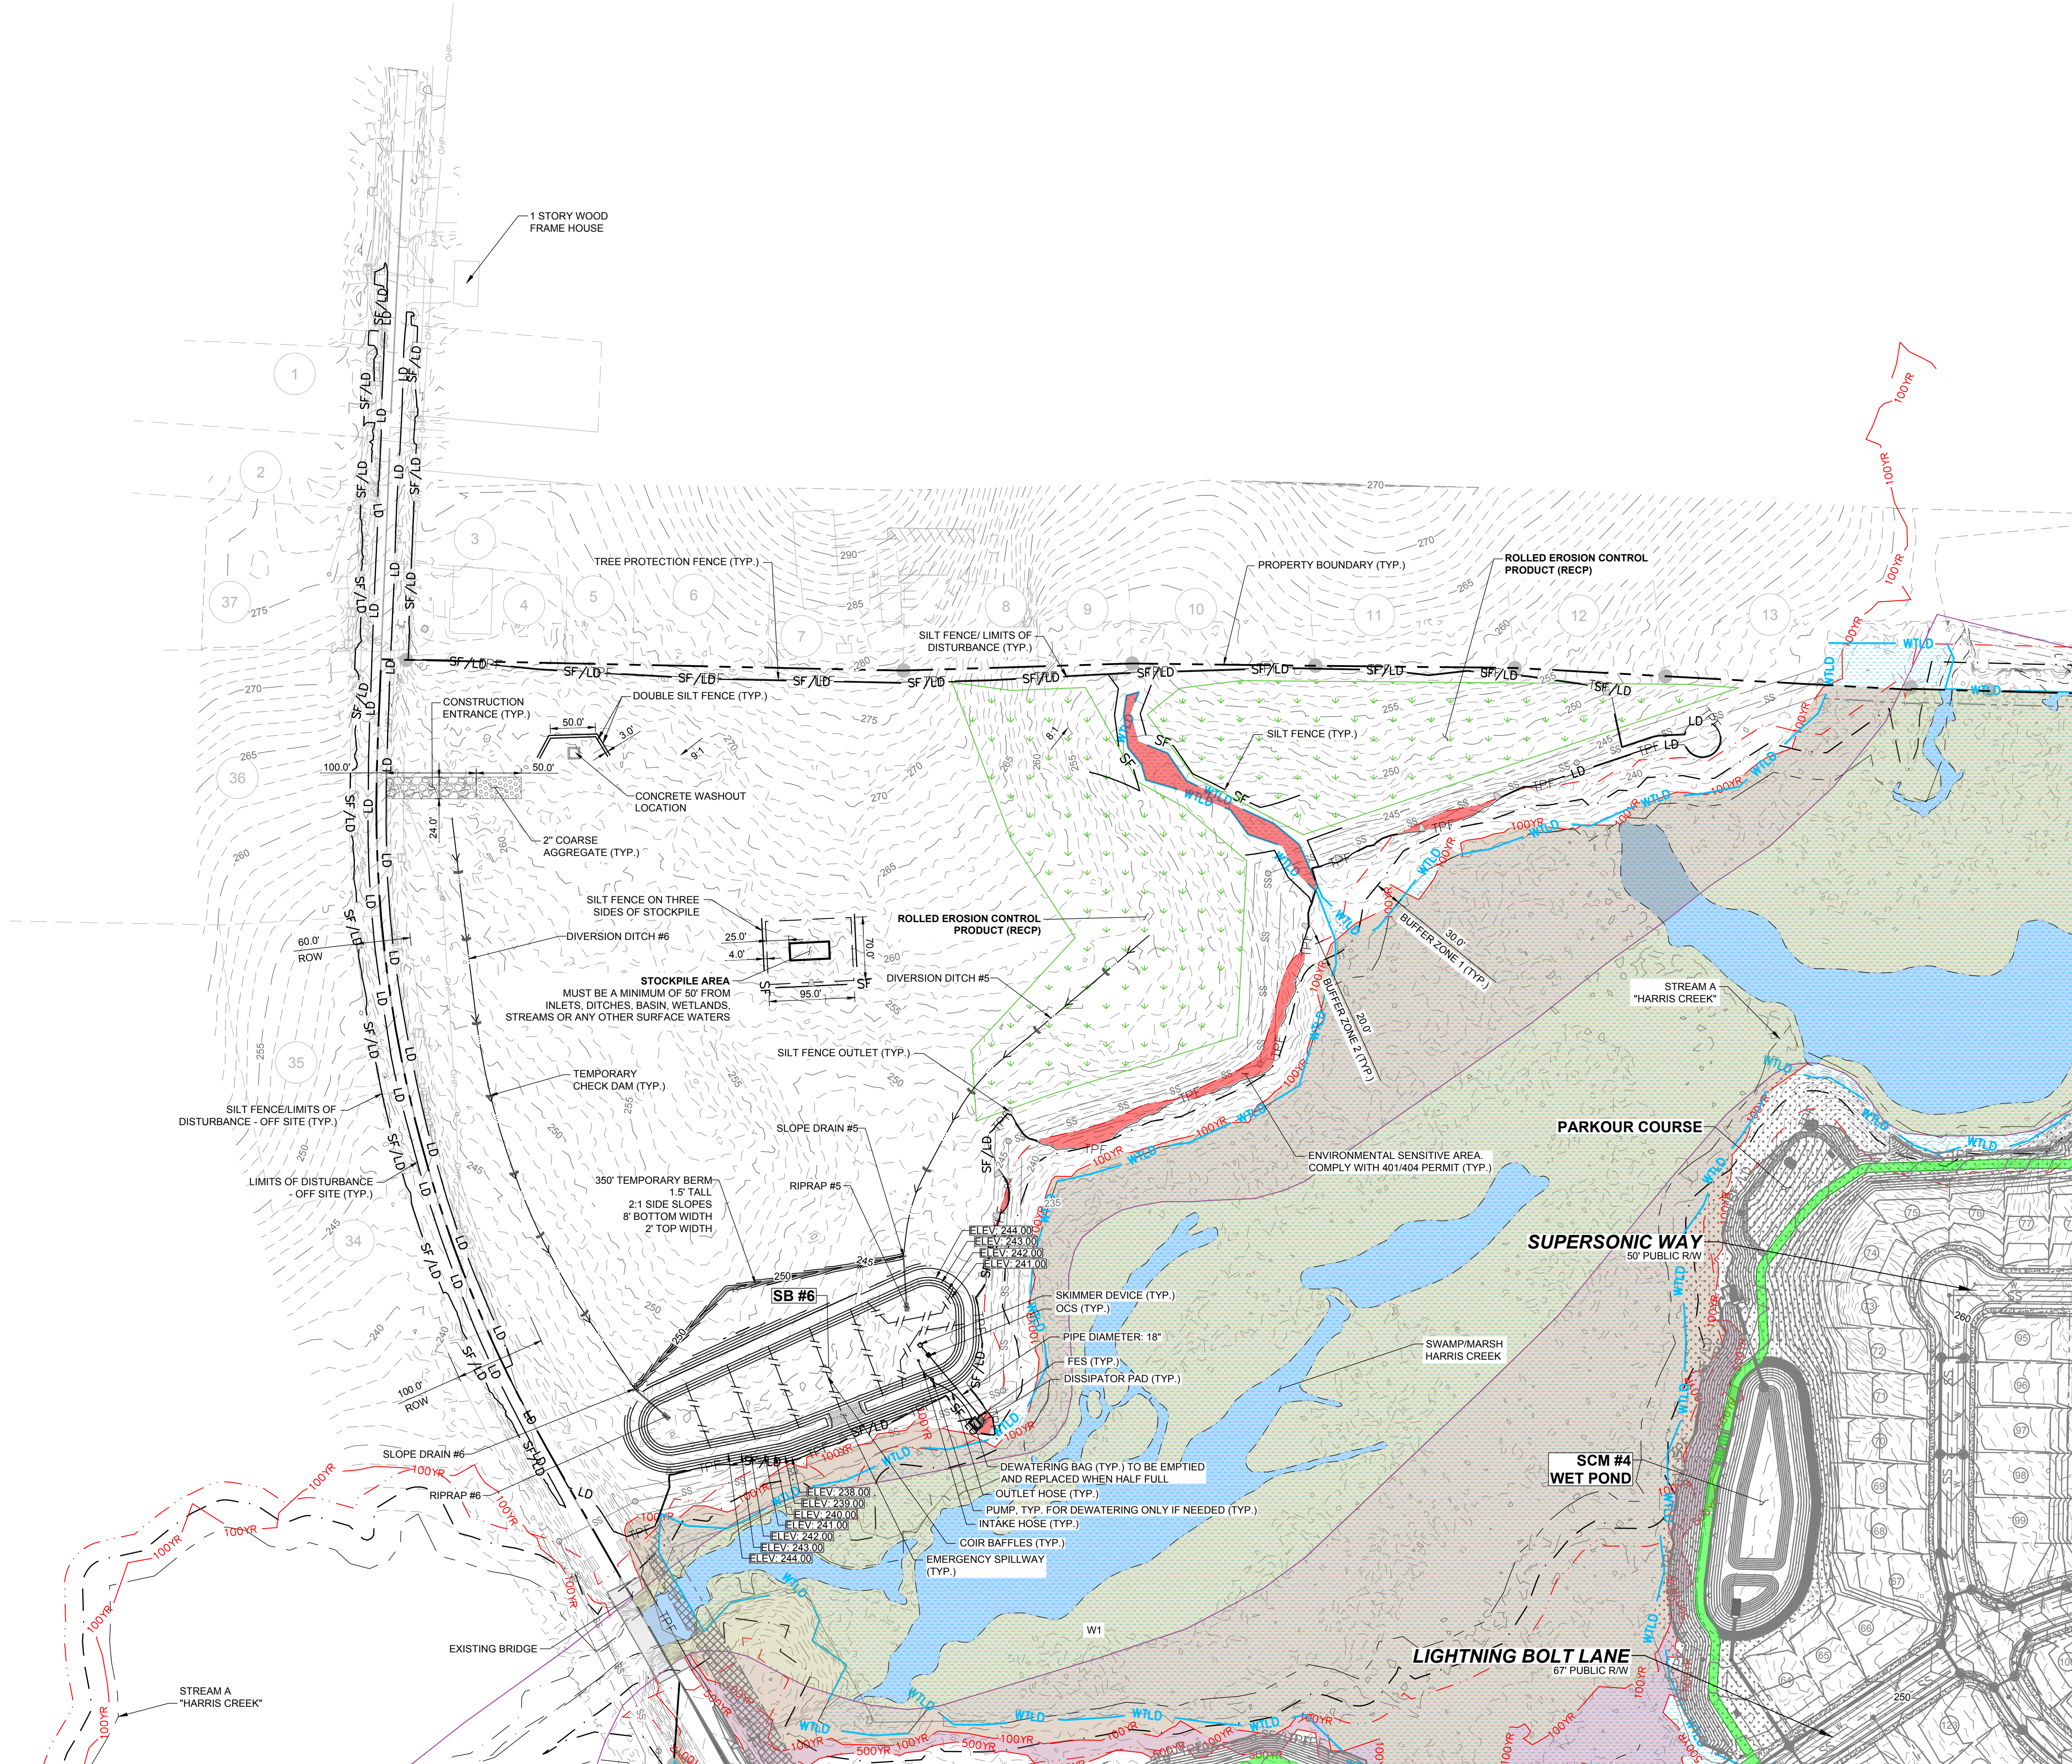


- NOTE:**
1. PHASE 3, ACREAGE: 17.64 AC
 2. EROSION CONTROL NOTES: SEE SHEET C-10.0
 3. ALL LAND-DISTURBING ACTIVITIES MUST BE PLANNED AND CONDUCTED TO LIMIT THE EXPOSED AREA TO 50 ROLLING ACRES.
 4. STOCKPILE HEIGHT SHALL NOT EXCEED 35 FEET.

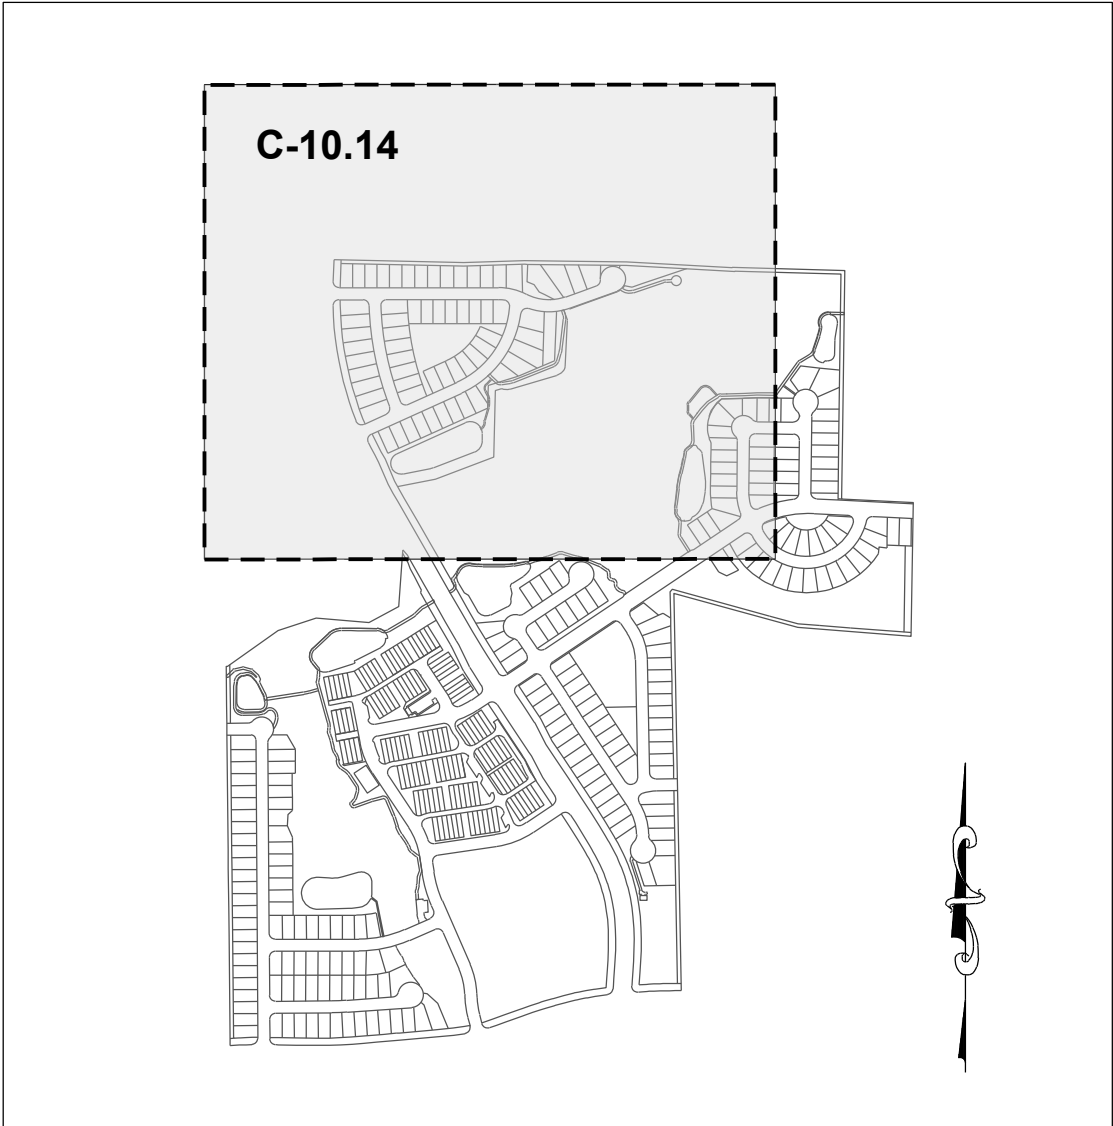

SITE KEY PLAN

LEGEND:


- EXISTING ADJOINER PROPERTY LINE
- EXISTING EDGE OF PAVEMENT
- EX. MAJOR CONTOURS
- EX. MINOR CONTOURS
- SILT FENCE/ LIMITS OF DISTURBANCE
- LIMITS OF DISTURBANCE
- SILT FENCE
- TREE PROTECTION LINE
- TEMPORARY DITCH
- BAFFLES
- TEMPORARY SLOPE DRAIN
- TEMPORARY SKIMMER
- SILT FENCE OUTLET
- CHECK DAM
- DISSIPATOR PAD
- CONSTRUCTION ENTRANCE
- EXISTING WETLAND
- ROLLED EROSION CONTROL
- ENVIRONMENTAL SENSITIVE AREA

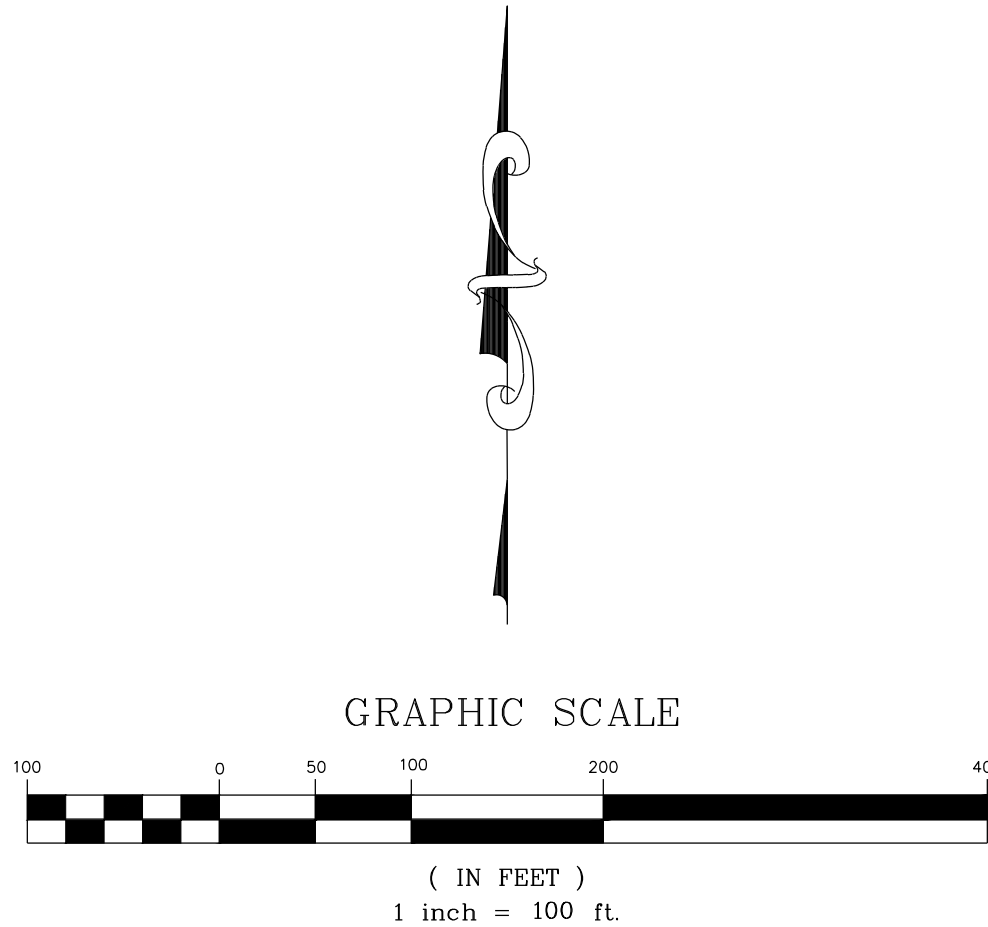

THIS PLANSET AND ANY ASSOCIATED DOCUMENTS ARE PRELIMINARY AND NOT AUTHORIZED FOR CONSTRUCTION UNTIL SIGNED, DATED, AND OFFICIALLY RELEASED FOR CONSTRUCTION BY THE ENGINEER OF RECORD.



STRONG ROCK		ENGINEERING GROUP		STRONG ROCK ENGINEERING GROUP, PLLC COMPANY LICENSE # P-2166 305 CHURCH AT NORTH HILLS STREET, SUITE 1110 RALEIGH, NC 27609 INFORMATION@STRONGROCKGROUP.COM	
RESERVE @ MITCHELL MILL TOWN OF ROLESVILLE, WAKE COUNTY, NORTH CAROLINA		CONSTRUCTION PLANS		EROSION CONTROL PLAN PHASE 3 - STAGE 1	
DRAWING SHEET		C-10.14		73 OF 230	
CONSTRUCTION INFRASTRUCTURE DRAWINGS CID-24-04		01		02	
TOWN OF ROLESVILLE CID-24-04 V2		03		04	
TOWN OF ROLESVILLE CID-24-04 V3		05		06	
TOWN OF ROLESVILLE CID-24-04 V4		07		08	

ADJOINER INFORMATION		
1	CHARLES E. FERRELL AND WIFE GRETIA LOUISE FERRELL PIN: 1757481951 DB 1813 PG 421 ZONING: R-30 (WC) USE: SF	20 CECIL L. GOODNIGHT AND WIFE, JUDY J. GOODNIGHT PIN: 1757650296 DB 5344 PG 819 ZONING: R-30 (WC) USE: SF
2	ABRAHAM T. BURNHAM AND KYLA L. BURNHAM PIN: 1757481832 DB 19140 PG 734 ZONING: R-30 (WC) USE: SF	21 CECIL L. GOODNIGHT AND WIFE, JUDY J. GOODNIGHT PIN: 1757641415 DB 5344 PG 819 ZONING: R-30 (WC) USE: VA
3	JOE L. GREEN PIN: 1757483799 DB 15-E PG 2691 ZONING: R-30 (WC) USE: SF	22 CHRISTOPHER GHOLSON AND WIFE, KELLY GAITHER GHOLSON PIN: 1757555361 DB 17855 PG 457 LOT 4 - BM 2018 PG 1333 ZONING: R-30 (WC) USE: SF
4	CHARLES ALFONSA JONES AND WIFE ALLIE V. JONES PIN: 1757484609 DB 2305 PG 673 ZONING: R-30 (WC) USE: SF	23 ABAHOR ELIAS AND SPOUSE, SUSAN ELIAS PIN: 1757553215 DB 17220 PG 2609 LOT 3 - BM 2018 PG 1333 ZONING: R-30 (WC) USE: SF
5	BENJAMIN FERRELL PIN: 1757485713 DB 1697 PG 465 ZONING: R-30 (WC) USE: SF	24 TODD KENDALL HONEYCUTT PIN: 1757551202 DB 13474 PG 1974 LOT 2 - BM 2018 PG 1333 ZONING: R-30 (WC) USE: SF
6	ALESIA FERRELL & ARRON WALKER PIN: 1757489733 DB 6374 PG 89 BM 1996 PG 00524 ZONING: R-30 (WC) USE: SF	25 CURTIS L. HONEYCUTT AND WIFE TODD KENDALL PIN: 1757540996 DB 19269 PG 2474 LOT 1 - BM 2018 PG 1333 ZONING: R-30 (WC) USE: SF
7	CHRIST HOLINESS CHURCH #1 PIN: 1757487783 DB 2928 PG 328 ZONING: R-30 (WC) USE: CH	26 PHETIS JONES BRADSHER PIN: 1757349473 DB 15208 PG 2320 BM 2013 PG 868 ZONING: R-30 (WC) USE: FO
8	CHRIST HOLINESS CHURCH #1 PIN: 1757489733 DB 4321 PG 788 ZONING: R-30 (WC) USE: VA	27 PHETIS JONES BRADSHER PIN: 1757349473 DB 15208 PG 2320 ZONING: R-30 (WC) USE: FO
9	CHRIST HOLINESS CHURCH #1 PIN: 1757580764 DB 8467 PG 430 ZONING: R-30 (WC) USE: VA	28 PERR Y. ELWOOD RYAN PIN: 1757357582 DB 19202 PG 2780 ZONING: R-30 (WC) USE: MO
10	ALICIA BROWN & CARL T. JONES PIN: 1757582714 DB 18703 PG 183 ZONING: R-30 (WC) USE: SF	29 TOUTLOFF, KENNETH S. TOUTLOFF, BILLIE ANNE PIN: 1757357764 DB 9236 PG 2229 LOT 3 - BM 1990 PG 956 ZONING: R-30 (WC) USE: SF
11	RS RENTAL II LLC PIN: 1757584724 DB 18703 PG 2414 BM 1981 PG 894 ZONING: R-30 (WC) USE: SF	30 BERNARD MILLER PIN: 1757357865 DB 15416 PG 1651 LOT 4 - BM 1990 PG 956 ZONING: R-30 (WC) USE: SF
12	KAREN E. BASS PIN: 1757585704 DB 12560 PG 1626 BM 1984 PG 943 ZONING: R-30 (WC) USE: SF	31 MARCIE L. HOLDEN PIN: 1757358908 DB 15599 PG 1003 LOT 5 - BM 1990 PG 956 ZONING: R-30 (WC) USE: SF
13	JAMES K. WILLIAMS PIN: 1757585784 DB 16784 PG 1013 BM 1989 PG 01474 ZONING: R-30 (WC) USE: VA	32 MEGAN KULAWIAK PIN: 1757367367 DB 16226 PG 1133 LOT 6 BM 1989 PG 00387 ZONING: R-30 (WC) USE: VA
14	GRO PEG PROPERTIES LLC PIN: 1757684897 DB 18359 PG 1707 LOT 5 - BM 1980 PG 00396 ZONING: R-30 (WC) USE: VA	33 KENNETH INVESTMENT LLC PIN: 1757368816 DB 19248 PG 1884 ZONING: R-30 (WC) USE: VA
15	SCOTT & THERESA CARLE PIN: 1757679786 DB 14863 PG 2493 LOT 4A - BM 1980 PG 00396 ZONING: R-30 (WC) USE: VA	34 KENNETH INVESTMENT LLC PIN: 1757471559 DB 19248 PG 1884 LOT - BM 2007 PG 01224 ZONING: R-30 (WC) USE: VA
16	GRO PEG PROPERTIES PIN: 1757664956 DB 19081 PG 2786 LOT 2A - BM 1982 PG 00581 ZONING: R-30 (WC) USE: VA	35 HENRY ALSTON PIN: 1757481376 DB 19248 PG 984 BM 1982 PG 721 ZONING: R-30 (WC) USE: SF
17	MT. CALVARY HOLINESS CHURCH OF WAKE CO. INC PIN: 1757660324 DB 10124 PG 2778 LOT 1 - BM 2002 PG 991 ZONING: R-30 (WC) USE: VA	36 UNIVERSAL CHURCH OF PRAYER PIN: 1757388408 DB 19559 PG 1723 LOT - BM 2002 PG 00667 ZONING: R-30 (WC) USE: CH
18	G. ARCHIE UNDERHILL, JR. AND WIFE, TERESSA C. UNDERHILL PIN: 1757653765 DB 8443 PG 2129 BM 1999 PG 1357 ZONING: R-30 (WC) USE: SF	37 ROZELIA J. HARTSFIELD HEIRS PIN: 1757481740 DB 10-E PG 1220 ZONING: R-30 (WC) USE: VA
19	GENADIUS MAC PREDDY AND WIFE, MATTIE F. PREDDY PIN: 1757656586 DB 1882 PG 342 ZONING: R-30 (WC) USE: SF	

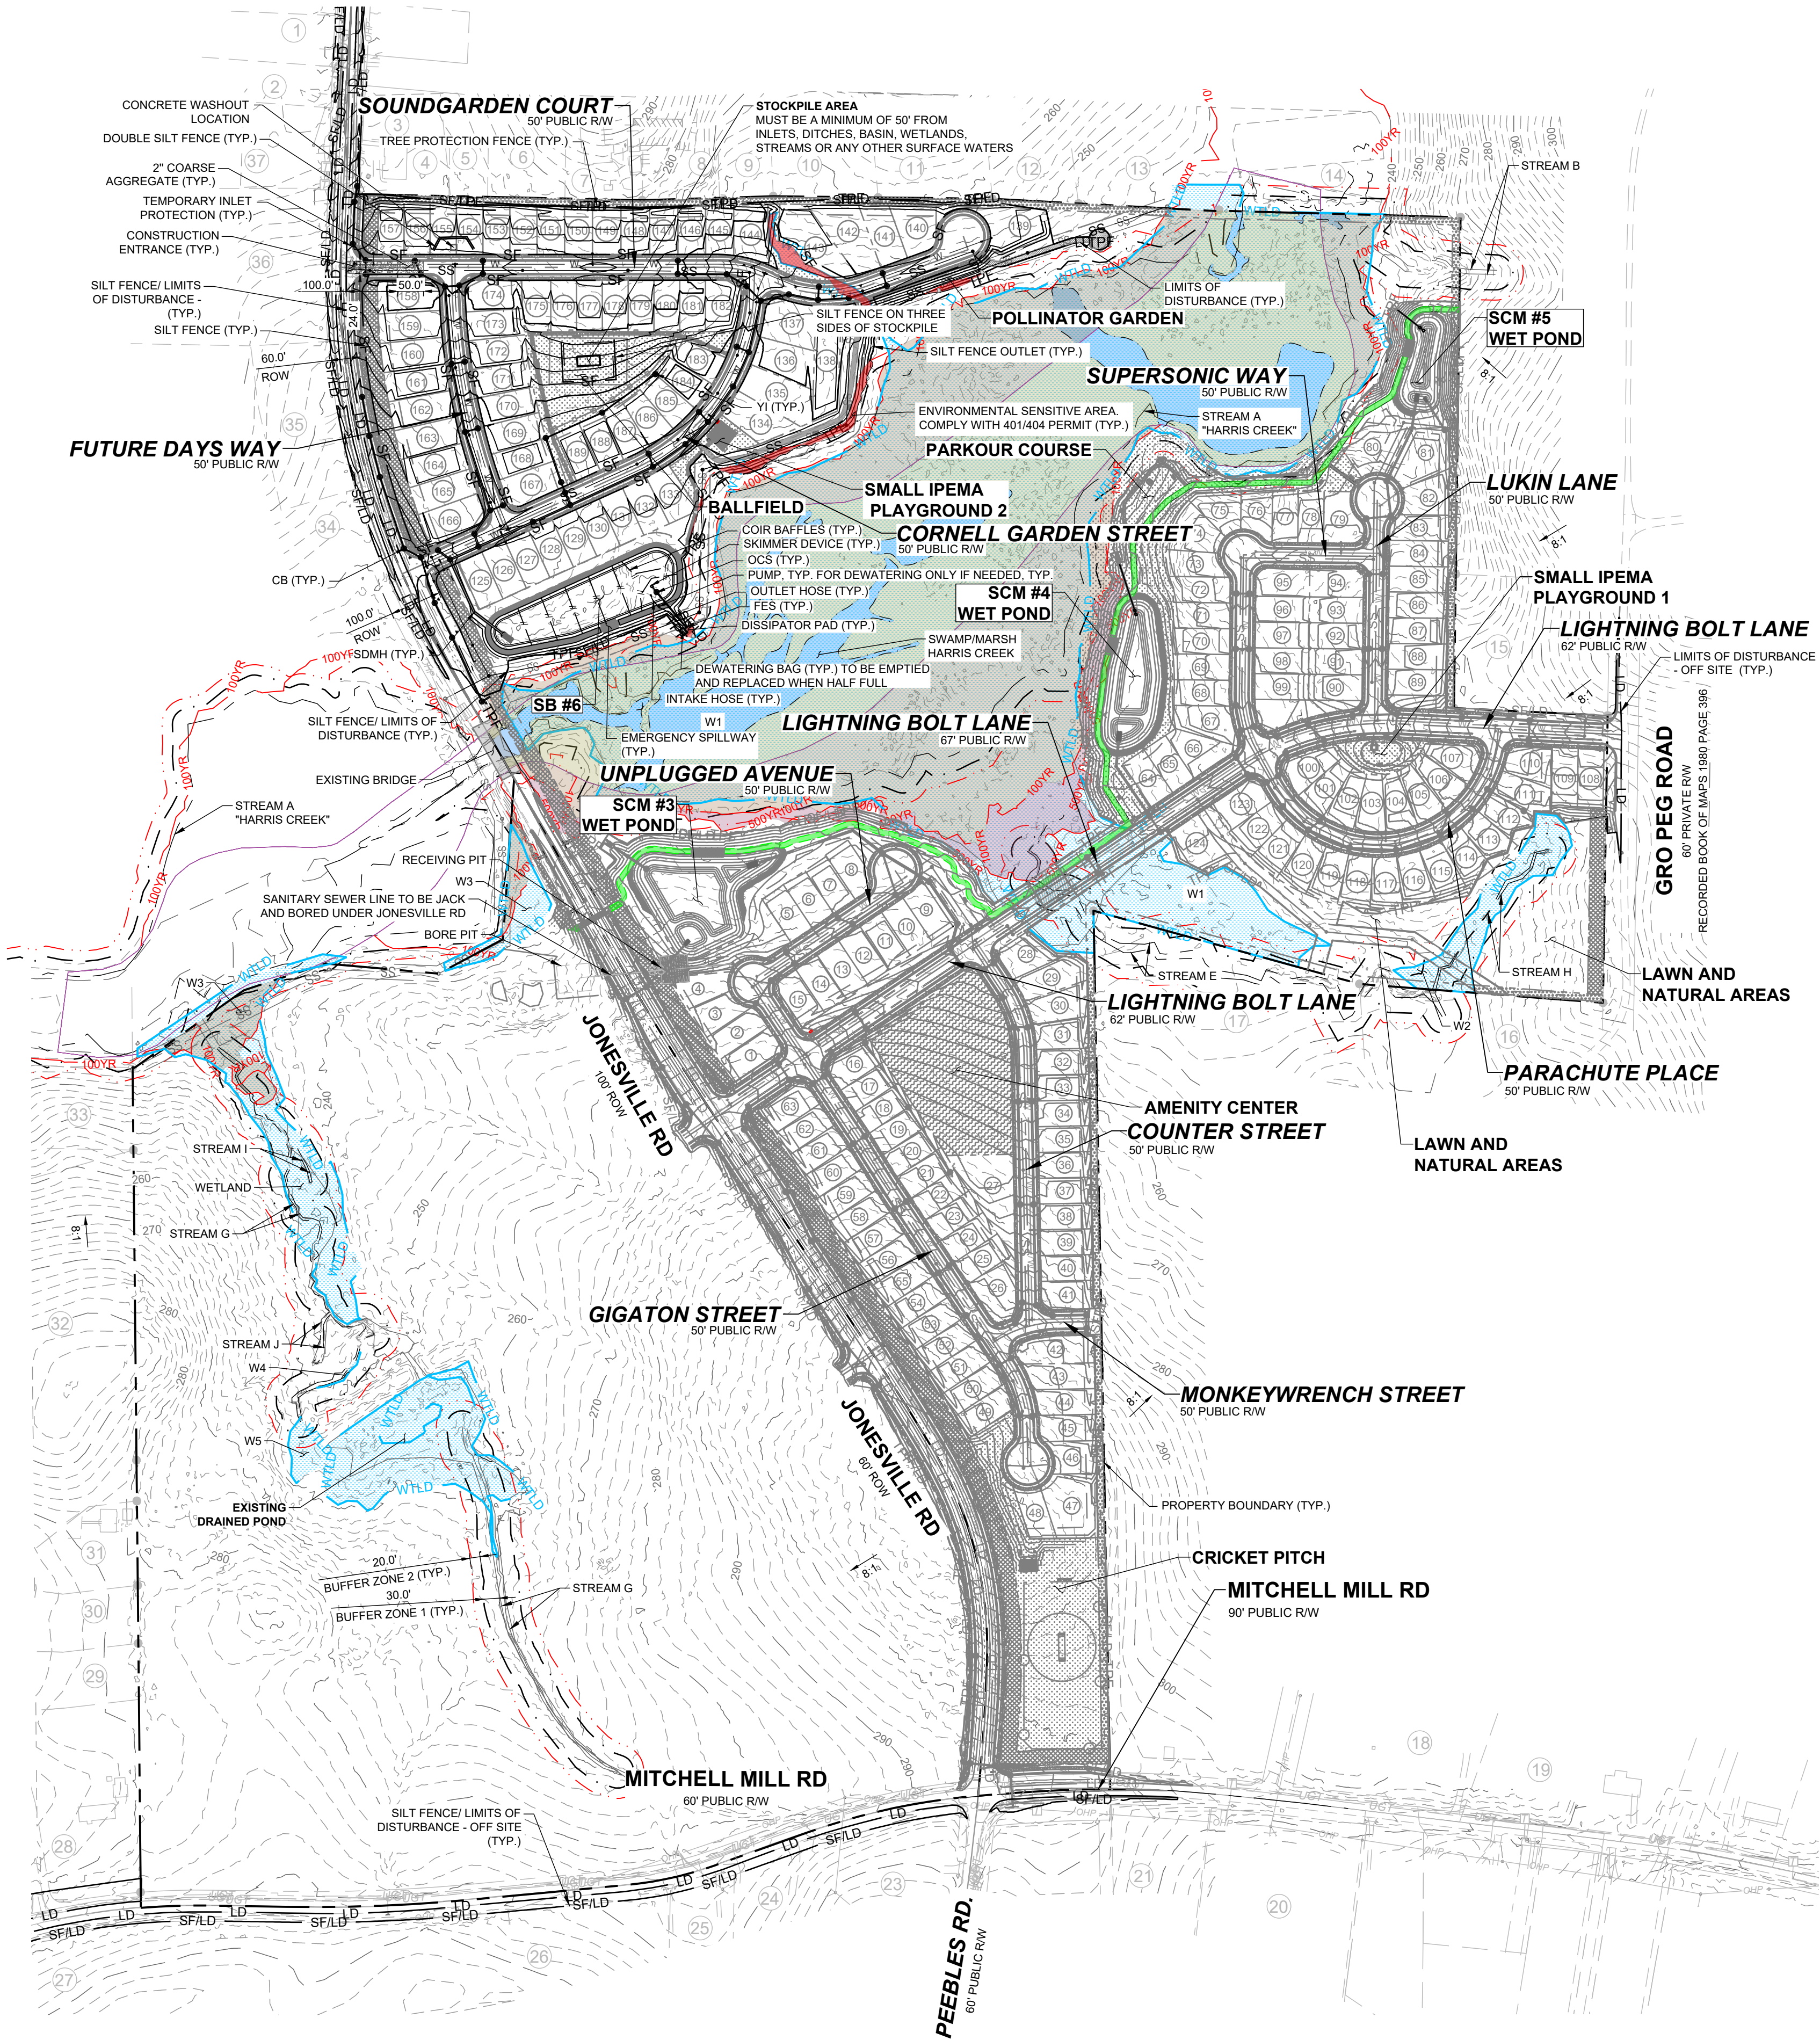

NOTE:

1. PHASE 3, ACREAGE: 17.64 AC
2. EROSION CONTROL NOTES: SEE SHEET C-10.0
3. ALL LAND-DISTURBING ACTIVITIES MUST BE PLANNED AND CONDUCTED TO LIMIT THE EXPOSED AREA TO 50 ROLLING ACRES.
4. STOCKPILE HEIGHT SHALL NOT EXCEED 35 FEET.

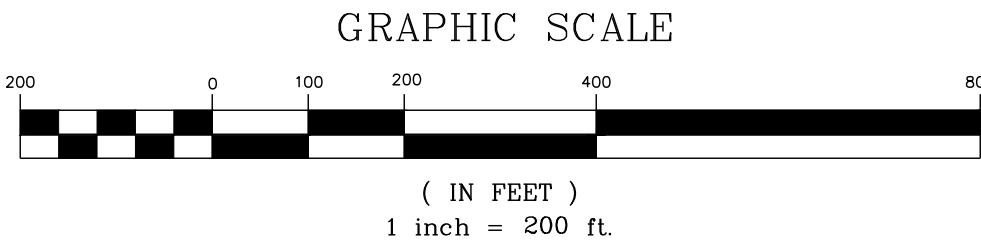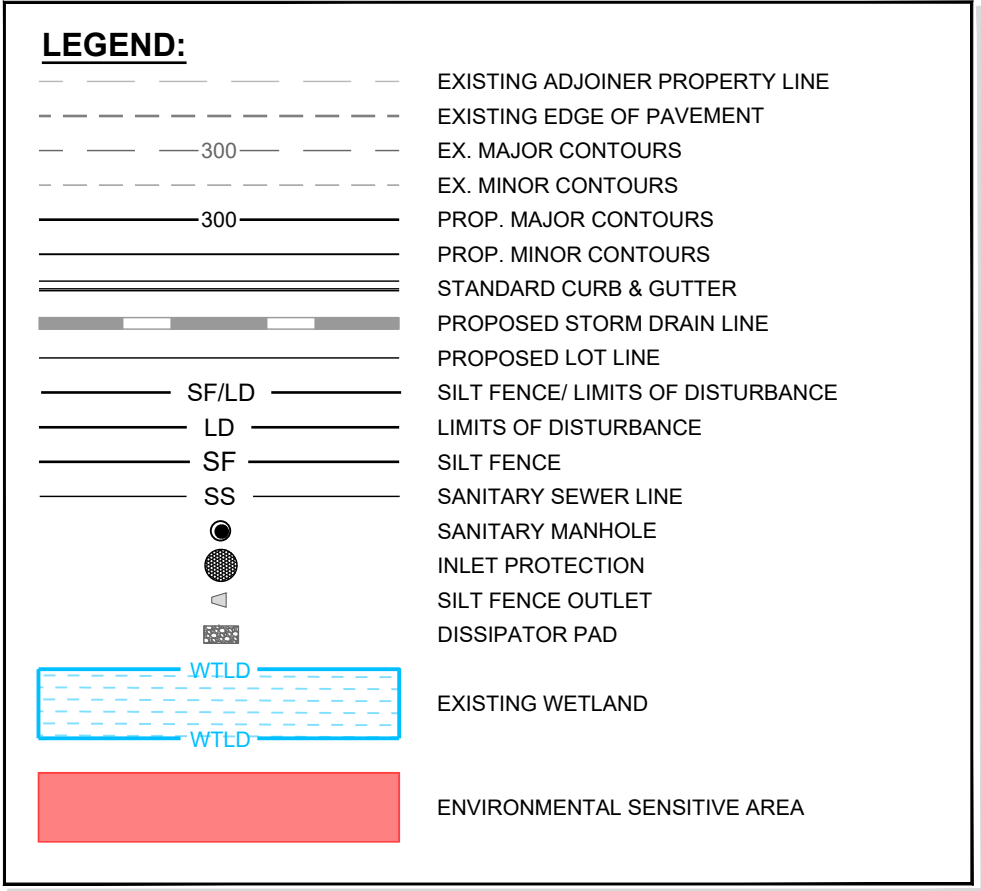

THIS PLANSET AND ANY ASSOCIATED DOCUMENTS ARE PRELIMINARY AND NOT AUTHORIZED FOR CONSTRUCTION UNTIL SIGNED, DATED, AND OFFICIALLY RELEASED FOR CONSTRUCTION BY THE ENGINEER OF RECORD.

STRONGROCK

ENGINEERING GROUP



STRONG ROCK ENGINEERING GROUP, PLLC | COMPANY LICENSE # P-2766
305 CHURCH AT NORTH HILLS STREET, SUITE 1110 RALEIGH, NC 27609 | INFORMATION@STRONGROCKGROUP.COM

RESERVE @ MITCHELL MILL
TOWN OF ROLESVILLE, WAKE COUNTY, NORTH CAROLINA
CONSTRUCTION PLANS
EROSION CONTROL PLAN OVERALL
PHASE 3 - STAGE 2

DRAWING SHEET
C-10.15

74 OF 230



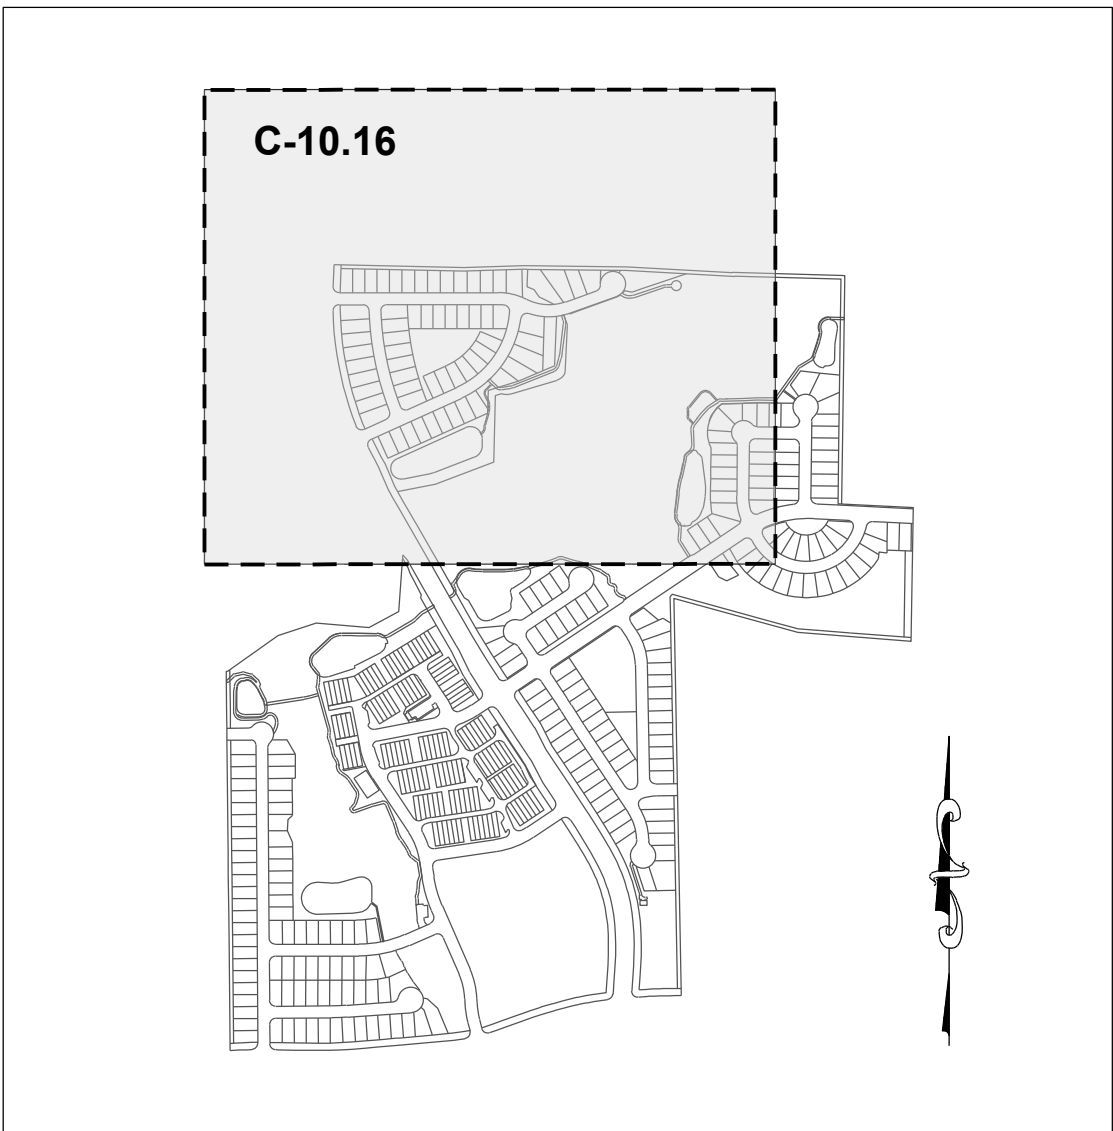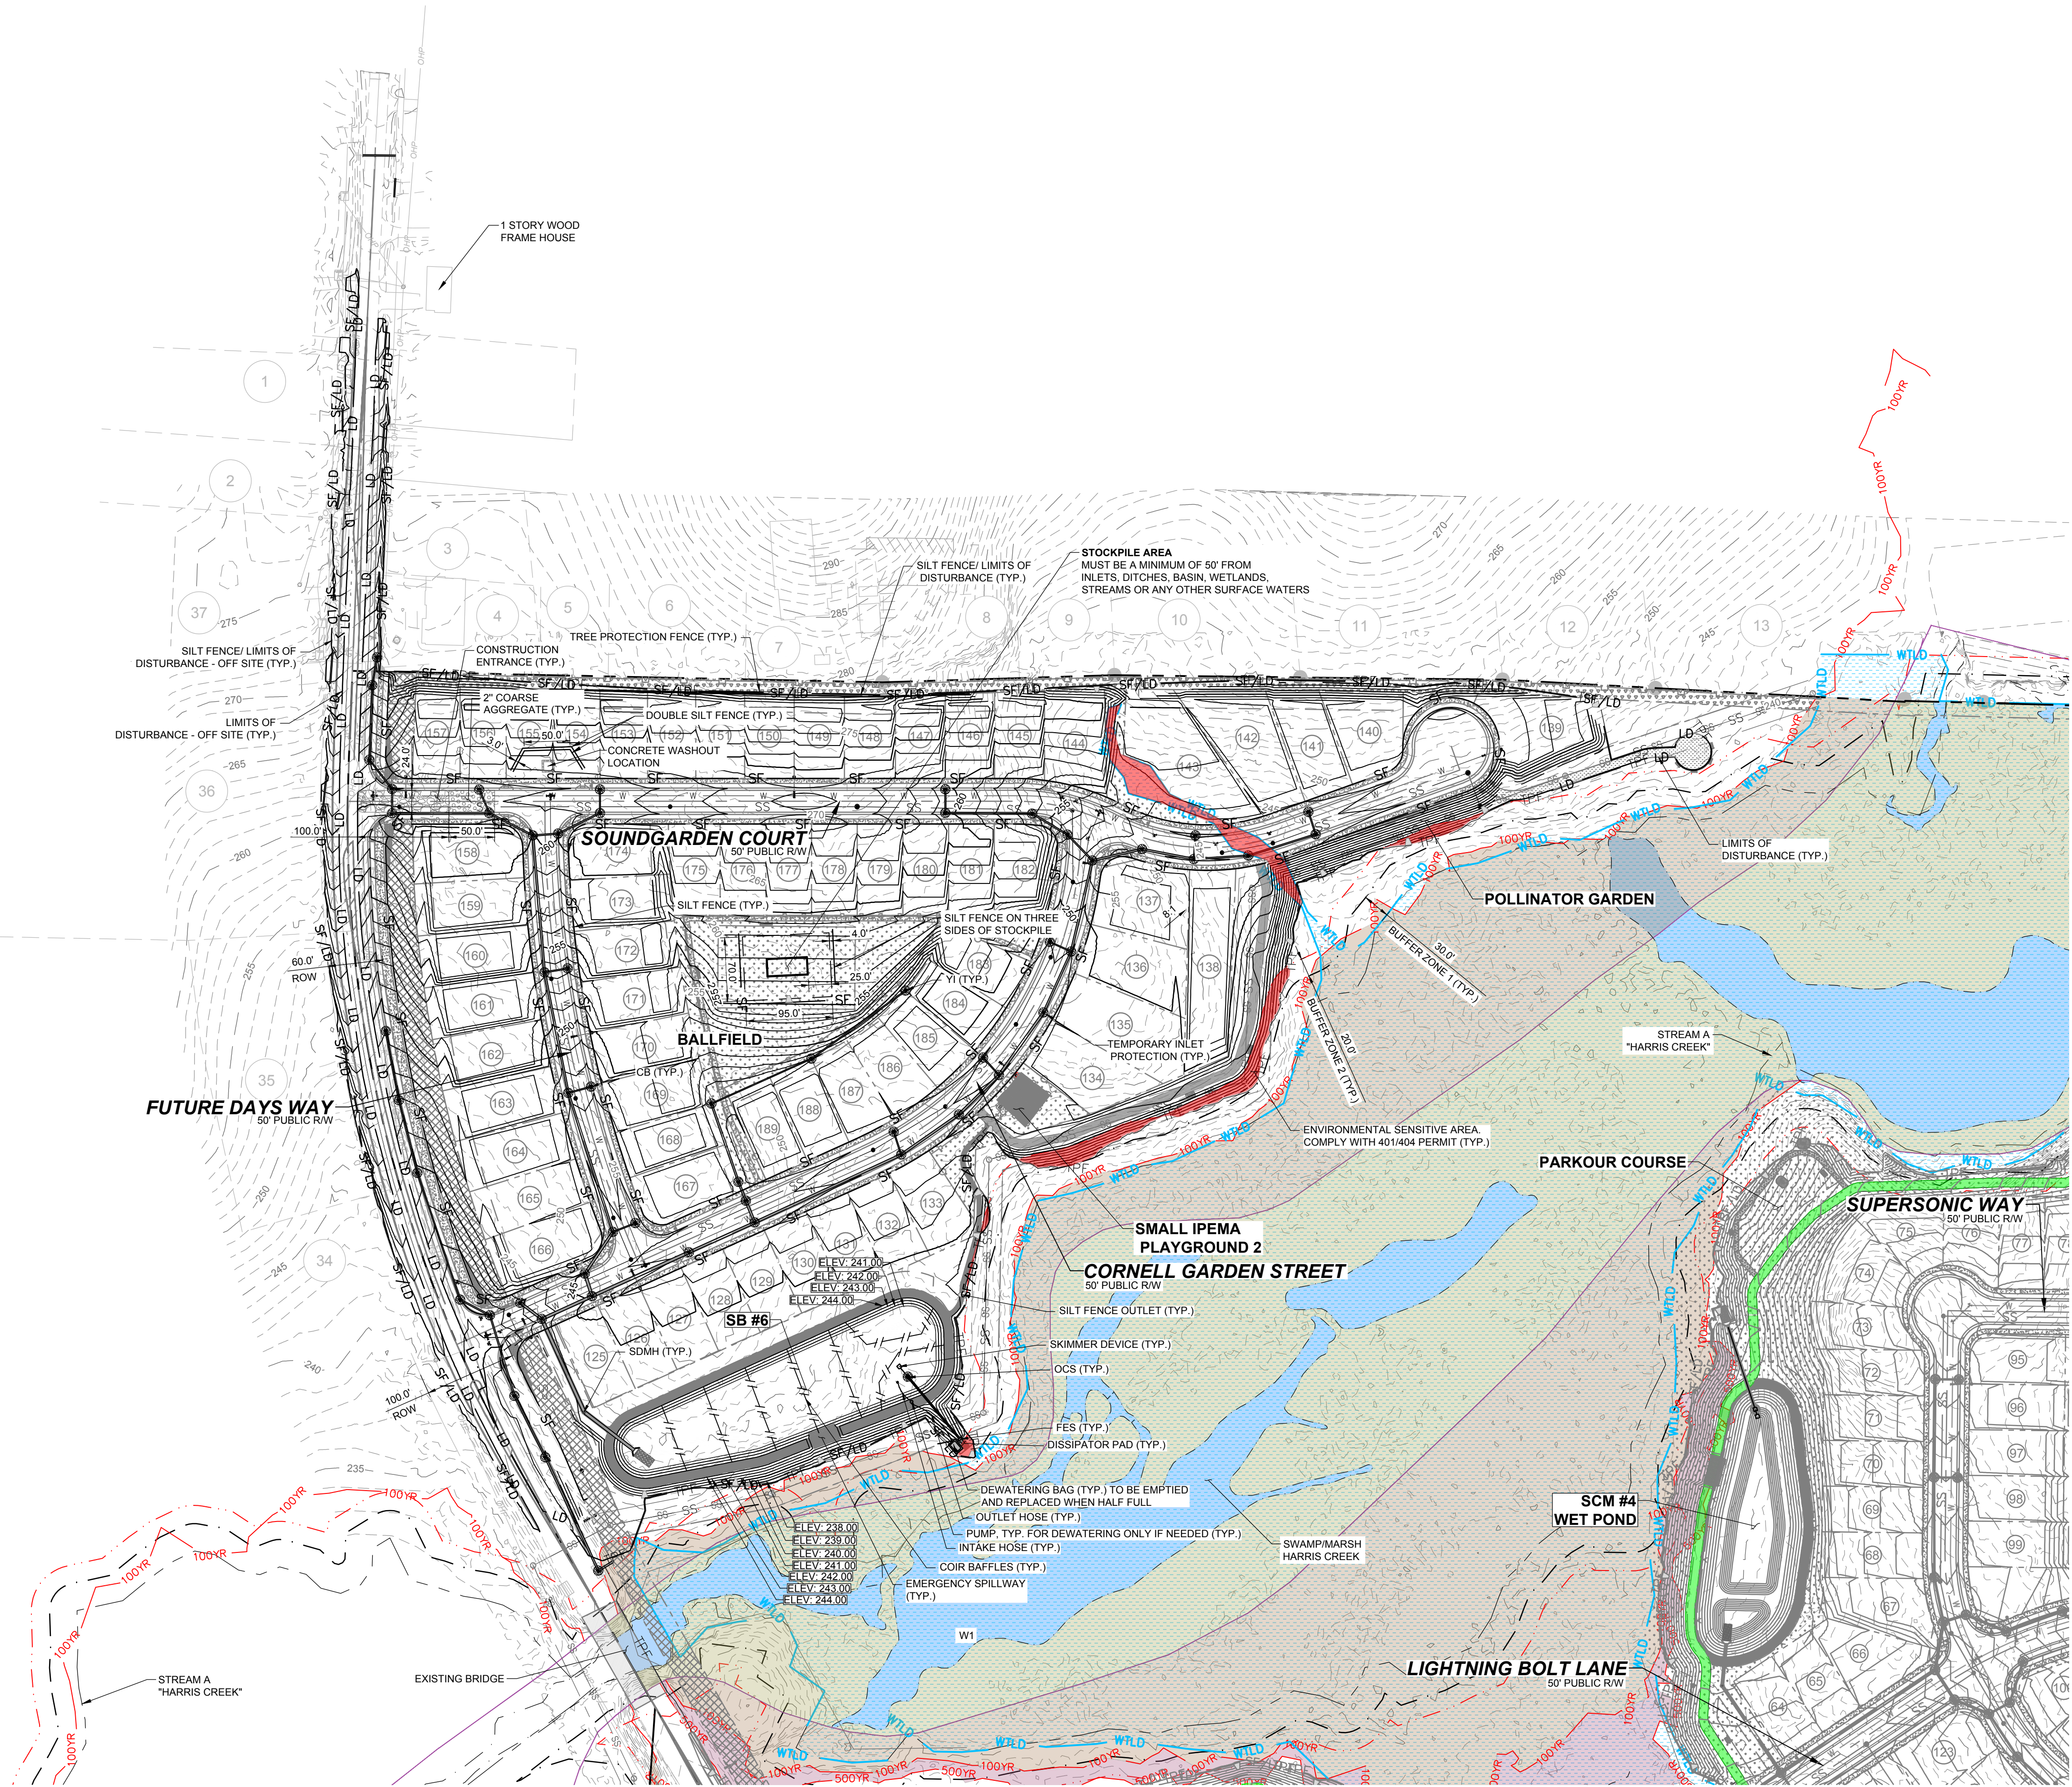


SITE KEY PLAN

LEGEND:

- EXISTING ADJOINER PROPERTY LINE
- EXISTING EDGE OF PAVEMENT
- EX. MAJOR CONTOURS
- EX. MINOR CONTOURS
- PROP. MAJOR CONTOURS
- PROP. MINOR CONTOURS
- STANDARD CURB & GUTTER
- PROPOSED STORM DRAIN LINE
- PROPOSED LOT LINE
- SILT FENCE/LIMITS OF DISTURBANCE
- LIMITS OF DISTURBANCE
- SILT FENCE
- SANITARY SEWER LINE
- SANITARY MANHOLE
- INLET PROTECTION
- SILT FENCE OUTLET
- DISSIPATOR PAD
- EXISTING WETLAND
- ENVIRONMENTAL SENSITIVE AREA

NOTE:

- PHASE 3, ACREAGE: 17.64 AC
- EROSION CONTROL NOTES: SEE SHEET C-10.0
- ALL LAND-DISTURBING ACTIVITIES MUST BE PLANNED AND CONDUCTED TO LIMIT THE EXPOSED AREA TO 50 ROLLING ACRES.
- STOCKPILE HEIGHT SHALL NOT EXCEED 35 FEET.

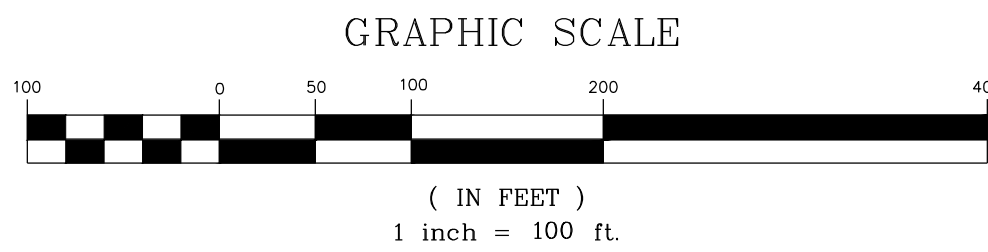

THIS PLANSET AND ANY ASSOCIATED DOCUMENTS ARE PRELIMINARY AND NOT AUTHORIZED FOR CONSTRUCTION UNTIL SIGNED, DATED, AND OFFICIALLY RELEASED FOR CONSTRUCTION BY THE ENGINEER OF RECORD.

CONSTRUCTION INFRASTRUCTURE DRAWINGS		DRAWINGS		DATE	
01	CID-24-04	08/04/2024	SREG		BY
02	TOWN OF ROLESVILLE CID-24-04 V2	11/07/2024	SREG		
03	TOWN OF ROLESVILLE CID-24-04 V3	02/07/2024	SREG		
04	TOWN OF ROLESVILLE CID-24-04 V4	06/02/2025	SREG		
05	TOWN OF ROLESVILLE CID-24-04 V5	08/02/2025	SREG		
		REVISIONS		DATE	
No.					

STRONGROCK

ENGINEERING GROUP

STRONG ROCK ENGINEERING GROUP, PLLC | COMPANY LICENSE # P-2166
305 CHURCH AT NORTH HILLS STREET, SUITE 1110 RALEIGH, NC 27609 | INFORMATION@STRONGROCKGROUP.COM

PSP-24-03	NOT FOR CONSTRUCTION	SCALE AS SHOWN	SRG	SRG	SRG
		DESIGNED BY	DRAWN BY	CHECKED BY	

RESERVE @ MITCHELL MILL
TOWN OF ROLESVILLE, WAKE COUNTY, NORTH CAROLINA
CONSTRUCTION PLANS
EROSION CONTROL PLAN
PHASE 3 - STAGE 2

DRAWING SHEET


C-10.16

75 OF 230

ADJOINER INFORMATION		
1	CHARLES E. FERRELL AND WIFE GRETIA LOUISE FERRELL PIN: 1757481951 DB 1813 PG 421 ZONING: R-30 (WC) USE: SF	20 CECIL L. GOODNIGHT AND WIFE, JUDY J. GOODNIGHT PIN: 1757650296 DB 5344 PG 819 ZONING: R-30 (WC) USE: SF
2	ABRAHAM T. BURNHAM AND KYLA L. BURNHAM PIN: 1757481832 DB 19140 PG 734 ZONING: R-30 (WC) USE: SF	21 CECIL L. GOODNIGHT AND WIFE, JUDY J. GOODNIGHT PIN: 1757641415 DB 5344 PG 819 ZONING: R-30 (WC) USE: VA
3	JOE L. GREEN PIN: 1757483799 DB 15-E PG 2691 ZONING: R-30 (WC) USE: SF	22 CHRISTOPHER GHOLSON AND WIFE, KELLY GAITHER GHOLSON PIN: 1757555361 DB 17855 PG 457 LOT 4 - BM 2018 PG 1333 ZONING: R-30 (WC) USE: SF
4	CHARLES ALFONSA JONES AND WIFE ALLIE V. JONES PIN: 1757484609 DB 2305 PG 673 ZONING: R-30 (WC) USE: SF	23 ABAHOR ELIAS AND SPOUSE, SUSAN ELIAS PIN: 1757553215 DB 17220 PG 2609 LOT 3 - BM 2018 PG 1333 ZONING: R-30 (WC) USE: SF
5	BENJAMIN FERRELL PIN: 1757485713 DB 1697 PG 465 ZONING: R-30 (WC) USE: SF	24 TODD KENDALL HONEYCUTT PIN: 1757551202 DB 13474 PG 1974 LOT 2 - BM 2018 PG 1333 ZONING: R-30 (WC) USE: SF
6	ALESHIA FERRELL & ARRON WALKER PIN: 1757489733 DB 6374 PG 89 BM 1996 PG 00524 ZONING: R-30 (WC) USE: SF	25 CURTIS L. HONEYCUTT AND WIFE TODD KENDALL PIN: 1757540996 DB 19269 PG 2474 LOT 1 - BM 2018 PG 1333 ZONING: R-30 (WC) USE: SF
7	CHRIST HOLINESS CHURCH #1 PIN: 1757489783 DB 2928 PG 328 ZONING: R-30 (WC) USE: CH	26 PHETIS JONES BRADSHER PIN: 1757349473 DB 15208 PG 2320 BM 2013 PG 868 ZONING: R-30 (WC) USE: FO
8	CHRIST HOLINESS CHURCH #1 PIN: 1757489733 DB 4321 PG 788 ZONING: R-30 (WC) USE: VA	27 PHETIS JONES BRADSHER PIN: 1757349473 DB 15208 PG 2320 ZONING: R-30 (WC) USE: FO
9	CHRIST HOLINESS CHURCH #1 PIN: 1757580764 DB 8467 PG 430 ZONING: R-30 (WC) USE: VA	28 PERR Y. ELWOOD RYAN PIN: 1757357592 DB 19232 PG 2780 ZONING: R-30 (WC) USE: MO
10	ALICIA BROWN & CARL T. JONES PIN: 1757582714 DB 18128 PG 183 ZONING: R-30 (WC) USE: SF	29 TOUTLOFF, KENNETH S. TOUTLOFF, BILLIE ANNE PIN: 1757357764 DB 9236 PG 2229 LOT 3 - BM 1990 PG 956 ZONING: R-30 (WC) USE: SF
11	RS RENTAL II LLC PIN: 1757584724 DB 18703 PG 2414 BM 1981 PG 894 ZONING: R-30 (WC) USE: SF	30 BERNARD MILLER PIN: 1757357865 DB 15416 PG 1651 LOT 4 - BM 1990 PG 956 ZONING: R-30 (WC) USE: SF
12	KAREN E. BASS PIN: 1757585704 DB 12560 PG 1626 BM 1984 PG 943 ZONING: R-30 (WC) USE: SF	31 MARCIE L. HOLDEN PIN: 1757358908 DB 15589 PG 1003 LOT 5 - BM 1990 PG 956 ZONING: R-30 (WC) USE: SF
13	JAMES K. WILLIAMS PIN: 1757585784 DB 16784 PG 1013 BM 1989 PG 01474 ZONING: R-30 (WC) USE: VA	32 MEGAN KULAWIAK PIN: 1757367367 DB 16226 PG 1133 LOT 6 BM 1989 PG 00387 ZONING: R-30 (WC) USE: VA
14	GRO PEG PROPERTIES LLC PIN: 1757684897 DB 18359 PG 1707 LOT 5 - BM 1980 PG 00396 ZONING: R-30 (WC) USE: VA	33 KENNETH INVESTMENT LLC PIN: 1757368816 DB 19248 PG 1884 ZONING: R-30 (WC) USE: VA
15	SCOTT & THERESA CARLE PIN: 1757679786 DB 14863 PG 2493 LOT 4A - BM 1980 PG 00396 ZONING: R-30 (WC) USE: VA	34 KENNETH INVESTMENT LLC PIN: 1757471559 DB 19248 PG 1884 LOT - BM 2007 PG 01224 ZONING: R-30 (WC) USE: VA
16	GRO PEG PROPERTIES PIN: 1757664956 DB 19081 PG 2786 LOT 2A - BM 1982 PG 00581 ZONING: R-30 (WC) USE: VA	35 HENRY ALSTON PIN: 1757481376 DB 19248 PG 984 BM 1982 PG 721 ZONING: R-30 (WC) USE: SF
17	MT. CALVARY HOLINESS CHURCH OF WAKE CO. INC. PIN: 1757660324 DB 10124 PG 2778 LOT 1 - BM 2002 PG 991 ZONING: R-30 (WC) USE: VA	36 UNIVERSAL CHURCH OF PRAYER PIN: 1757388408 DB 19559 PG 1723 LOT - BM 2002 PG 00667 ZONING: R-30 (WC) USE: CH
18	G. ARCHIE UNDERHILL, JR. AND WIFE, TERESSA C. UNDERHILL PIN: 1757653765 DB 8443 PG 2129 BM 1999 PG 1357 ZONING: R-30 (WC) USE: SF	37 ROZELIA J. HARTSFIELD HEIRS PIN: 1757481740 DB 10-E PG 1220 ZONING: R-30 (WC) USE: VA
19	GENADIUS MAC PREDDY AND WIFE, MATTIE F. PREDDY PIN: 1757656586 DB 1882 PG 342 ZONING: R-30 (WC) USE: SF	

NOTE:


1. PHASE 3, ACREAGE: 17.64 AC
2. EROSION CONTROL NOTES: SEE SHEET C-10.0
3. ALL LAND-DISTURBING ACTIVITIES MUST BE PLANNED AND CONDUCTED TO LIMIT THE EXPOSED AREA TO 50 ROLLING ACRES.
4. STOCKPILE HEIGHT SHALL NOT EXCEED 35 FEET.

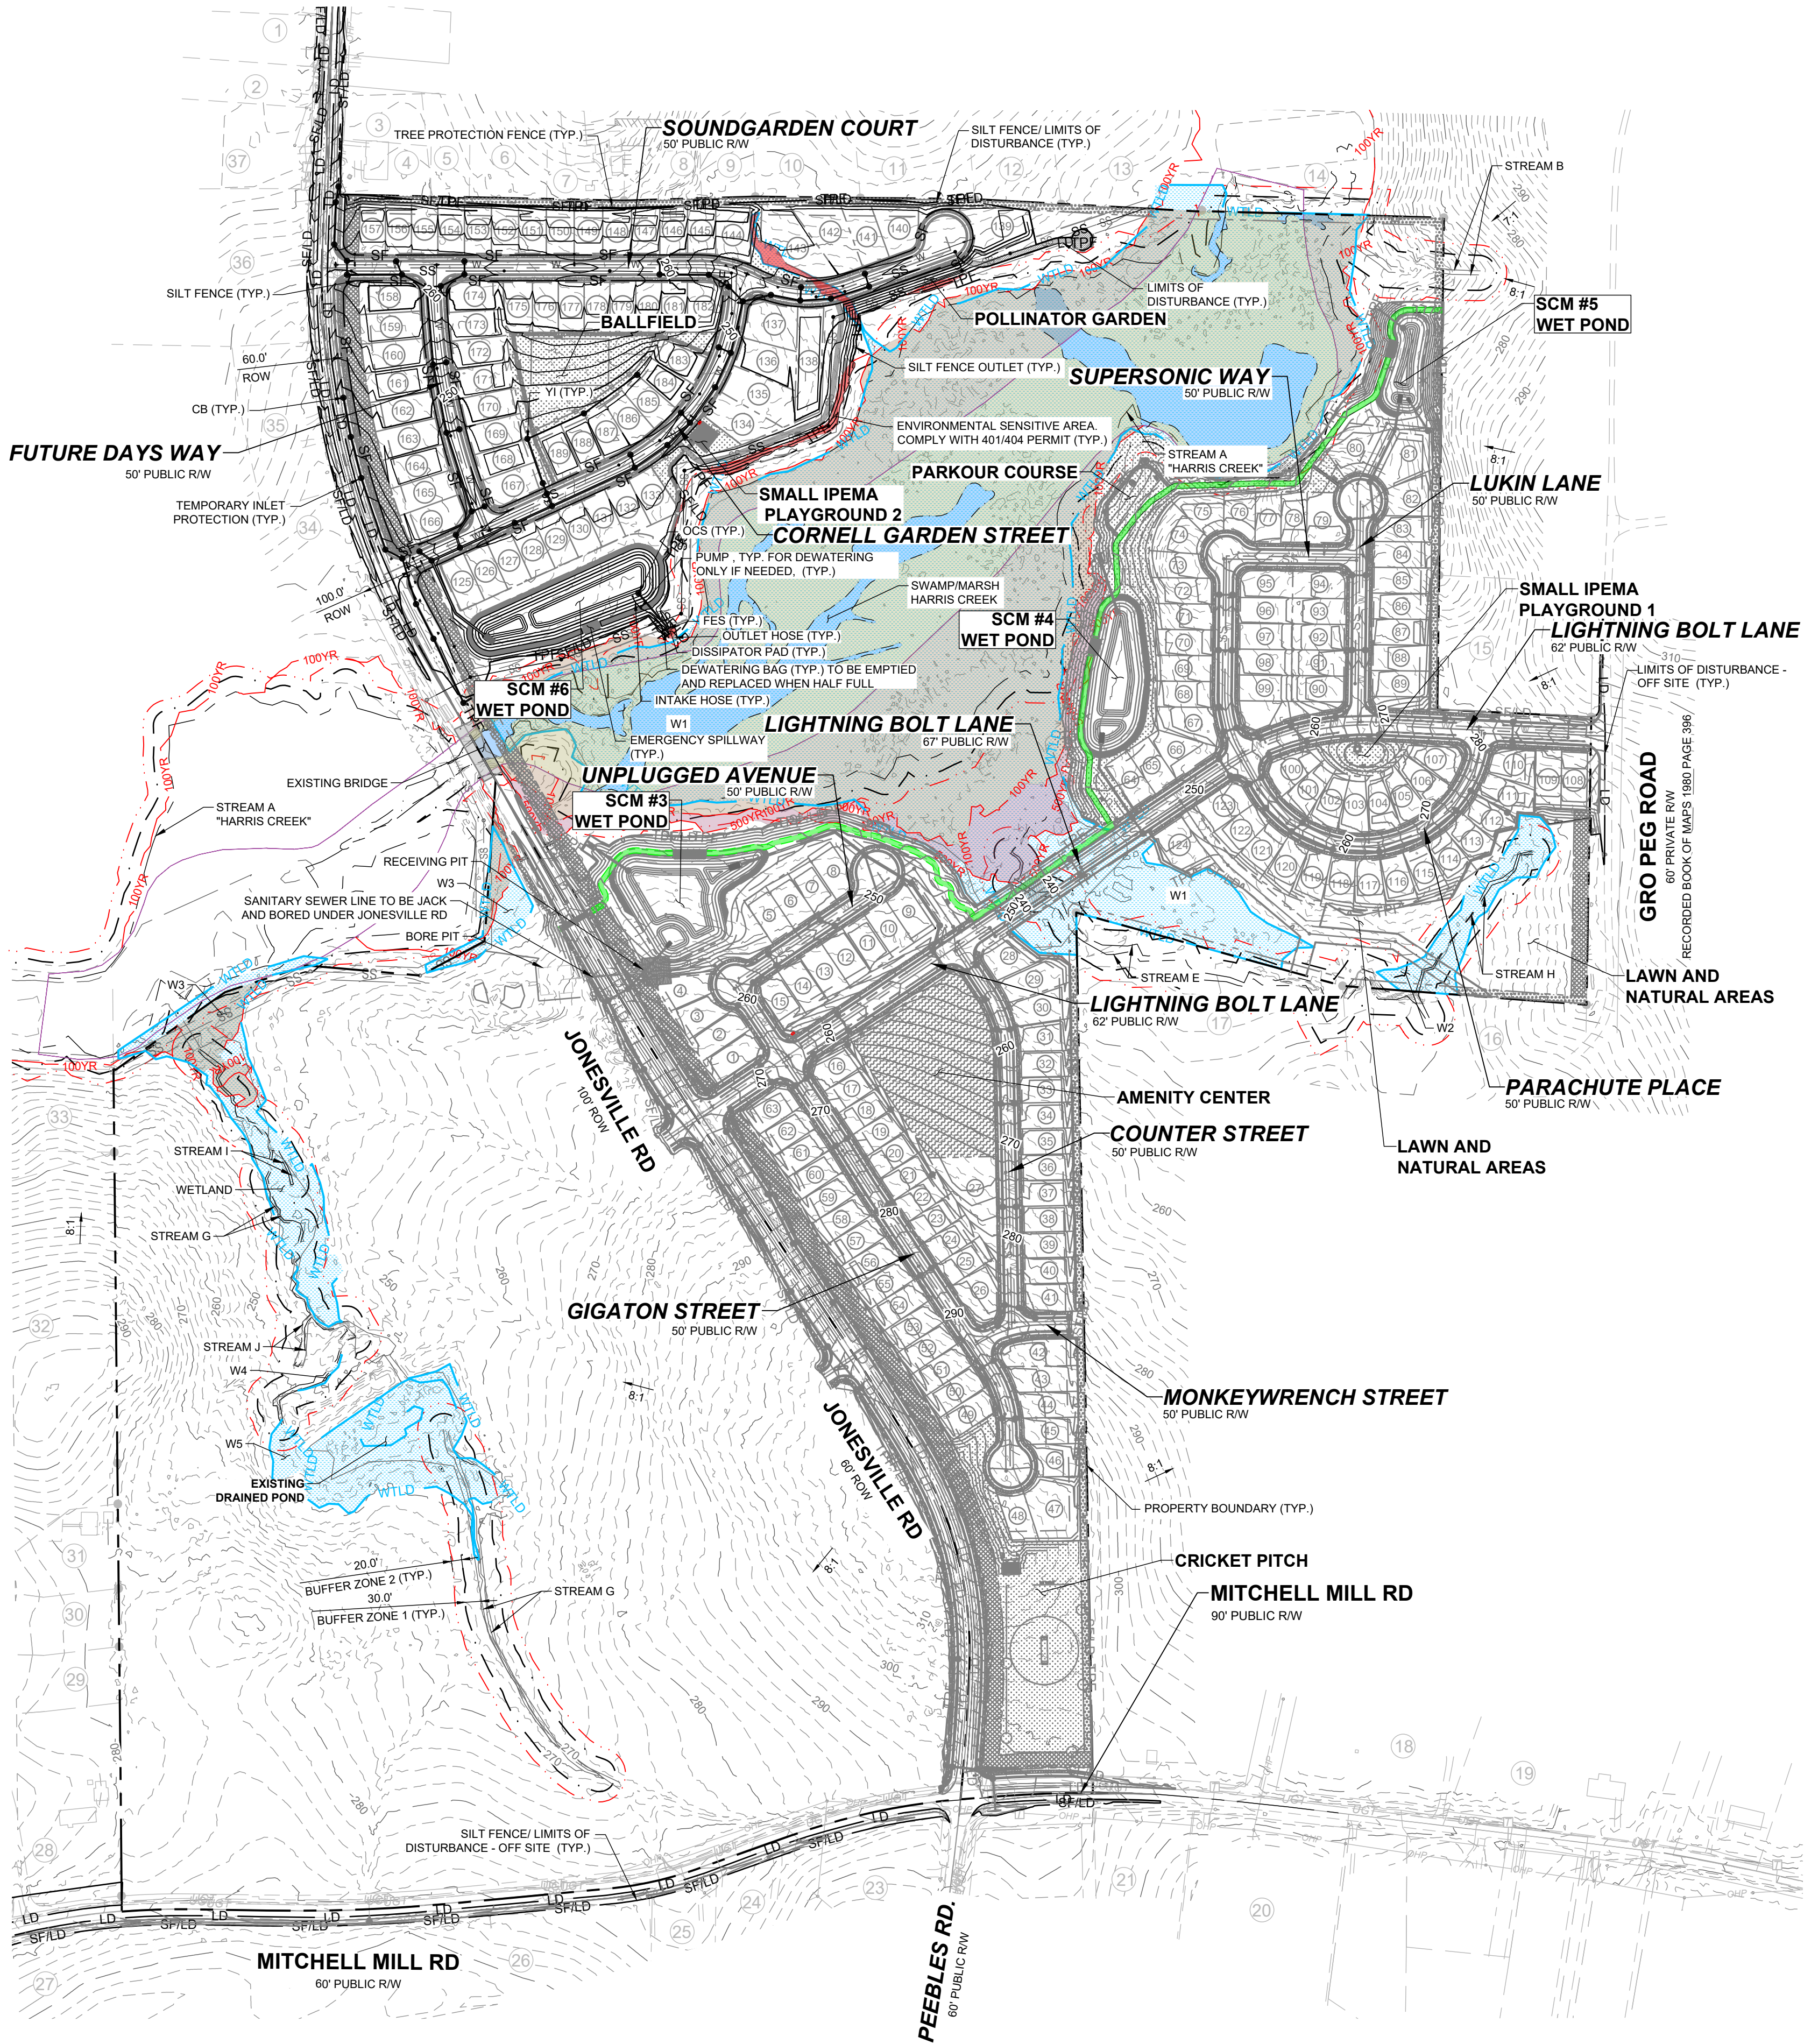

LEGEND:

- EXISTING ADJOINER PROPERTY LINE
- EXISTING EDGE OF PAVEMENT
- EX. MAJOR CONTOURS
- EX. MINOR CONTOURS
- PROP. MAJOR CONTOURS
- PROP. MINOR CONTOURS
- STANDARD CURB & GUTTER
- PROPOSED STORM DRAIN LINE
- PROPOSED LOT LINE
- SILT FENCE/LIMITS OF DISTURBANCE
- SILT FENCE
- SANITARY SEWER LINE
- SANITARY MANHOLE
- INLET PROTECTION
- SILT FENCE OUTLET
- DISSIPATOR PAD
- EXISTING WETLAND
- ENVIRONMENTAL SENSITIVE AREA

GRAPHIC SCALE

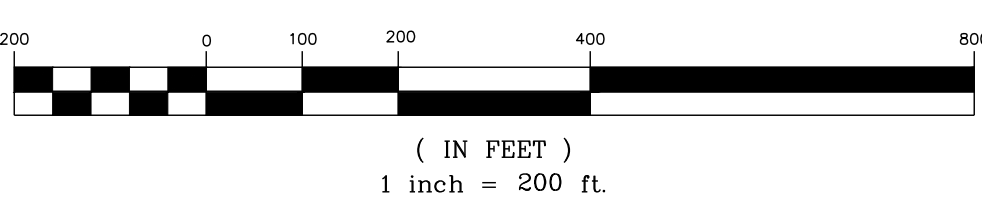

THIS PLANSET AND ANY ASSOCIATED DOCUMENTS ARE PRELIMINARY AND NOT AUTHORIZED FOR CONSTRUCTION UNTIL SIGNED, DATED, AND OFFICIALLY RELEASED FOR CONSTRUCTION BY THE ENGINEER OF RECORD.

STRONGROCK
ENGINEERING GROUP

STRONG ROCK ENGINEERING GROUP, PLLC | COMPANY LICENSE # P-2766
305 CHURCH AT NORTH HILLS STREET, SUITE 1110 RALEIGH, NC 27609 | INFORMATION@STRONGROCKGROUP.COM

RESERVE @ MITCHELL MILL
TOWN OF ROLESVILLE, WAKE COUNTY, NORTH CAROLINA
CONSTRUCTION PLANS
EROSION CONTROL PLAN OVERALL
PHASE 3 - STAGE 3


DRAWING SHEET

C-10.17

76 OF 230

SEAL:

CONSTRUCTION INFRASTRUCTURE DRAWINGS	DATE	REVISIONS	BY
01	08/04/2024		
02	11/07/2024		
03	02/07/2024		
04	08/02/2025		
05	09/02/2025		
No.			

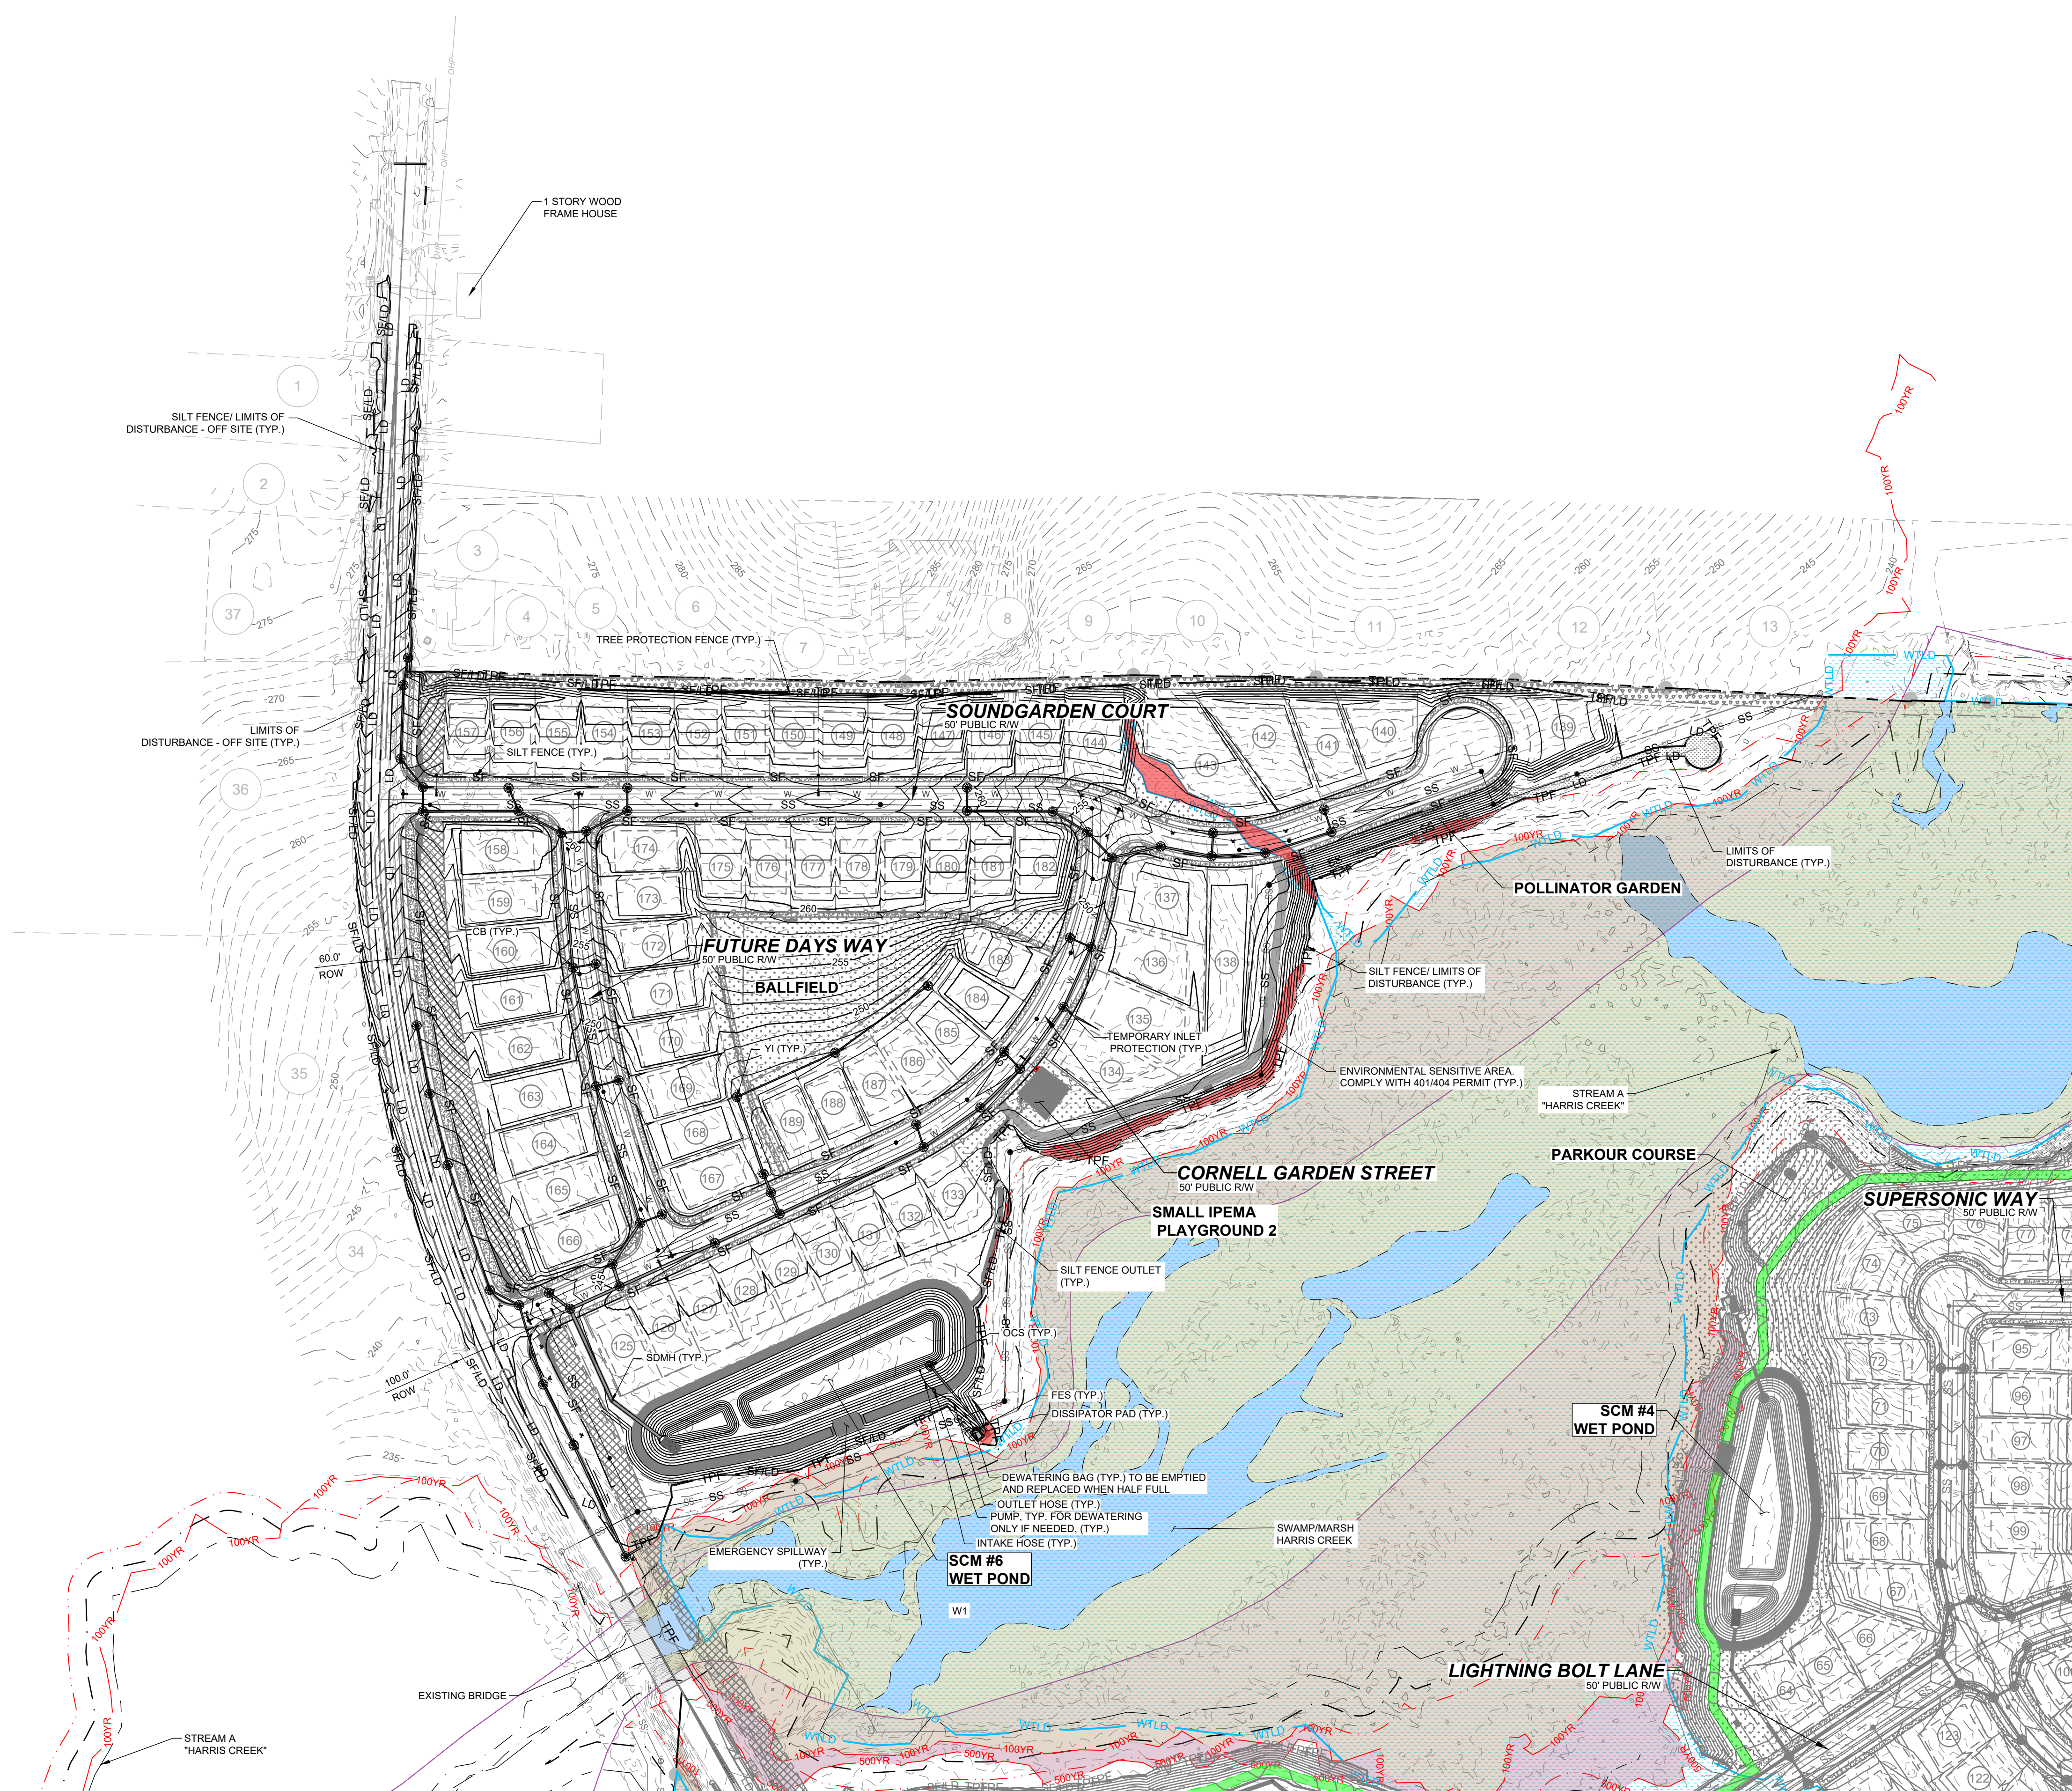

1 STORY WOOD FRAME HOUSE

SILT FENCE/ LIMITS OF DISTURBANCE - OFF SITE (TYP.)

1

2

3

4

5

6

7

8

9

10

11

12

13

14

15

16

17

18

19

20

21

22

23

24

25

26

27

28

29

30

31

32


33

34

35

36


37

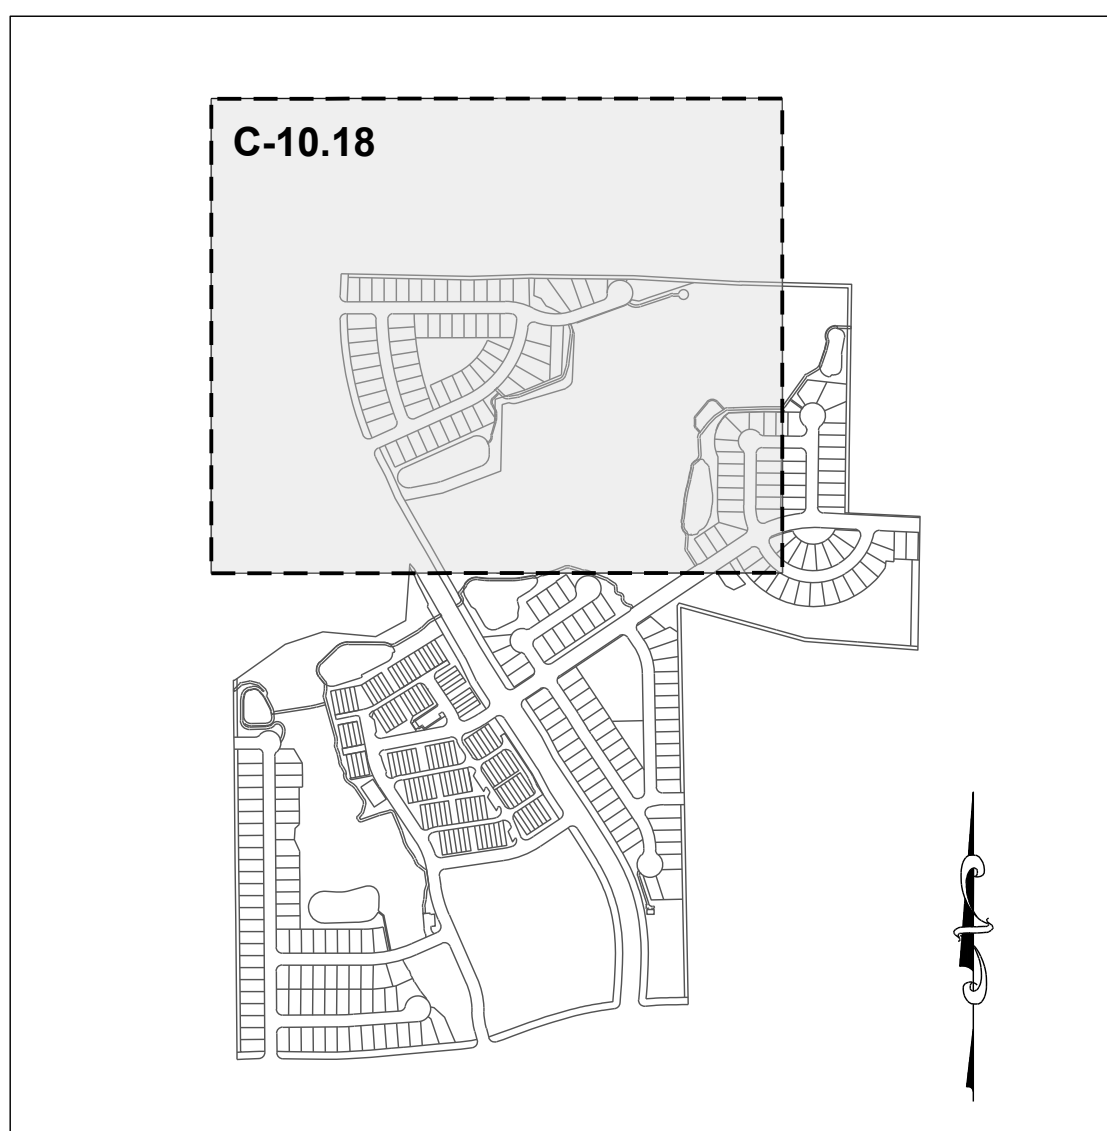

SITE KEY PLAN

LEGEND:	
	EXISTING ADJOINER PROPERTY LINE
	EXISTING EDGE OF PAVEMENT
	EX. MAJOR CONTOURS
	EX. MINOR CONTOURS
	PROP. MAJOR CONTOURS
	PROP. MINOR CONTOURS
	STANDARD CURB & GUTTER
	PROPOSED STORM DRAIN LINE
	PROPOSED LOT LINE
	SILT FENCE/ LIMITS OF DISTURBANCE
	LIMITS OF DISTURBANCE
	SILT FENCE
	SANITARY SEWER LINE
	SANITARY MANHOLE
	INLET PROTECTION
	SILT FENCE OUTLET
	DISSIPATOR PAD
	EXISTING WETLAND
	ENVIRONMENTAL SENSITIVE AREA

- NOTE:**
1. PHASE 3, ACREAGE: 17.64 AC
 2. EROSION CONTROL NOTES: SEE SHEET C-10.0
 3. ALL LAND-DISTURBING ACTIVITIES MUST BE PLANNED AND CONDUCTED TO LIMIT THE EXPOSED AREA TO 50 ROLLING ACRES.
 4. STOCKPILE HEIGHT SHALL NOT EXCEED 35 FEET.

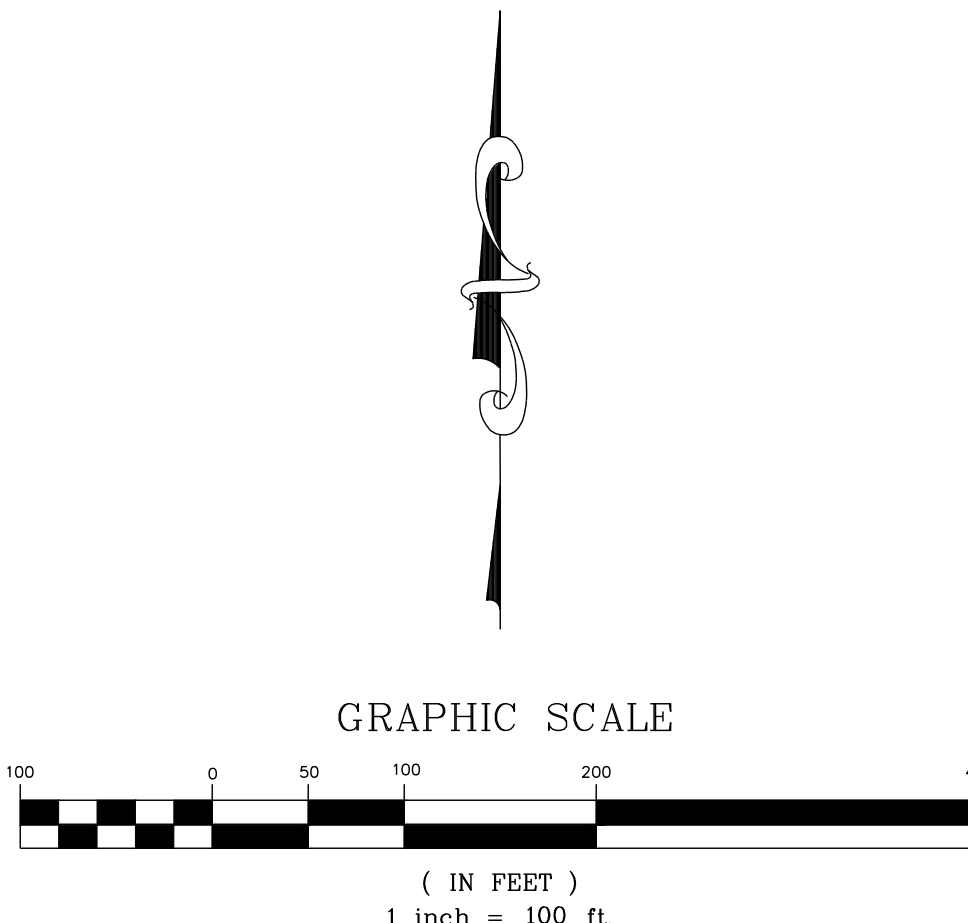

THIS PLANSET AND ANY ASSOCIATED DOCUMENTS ARE PRELIMINARY AND NOT AUTHORIZED FOR CONSTRUCTION UNTIL SIGNED, DATED, AND OFFICIALLY RELEASED FOR CONSTRUCTION BY THE ENGINEER OF RECORD.

STRONGROCK

ENGINEERING GROUP

STRONG ROCK ENGINEERING GROUP, PLLC | COMPANY LICENSE # P-2166
305 CHURCH AT NORTH HILLS STREET, SUITE 1110 RALEIGH, NC 27609 | INFORMATION@STRONGROCKGROUP.COM

STRONG ROCK PROJECT
PSP-24-03

NOT FOR
CONSTRUCTION

SCALE
AS SHOWN

DESIGNED BY
SRG

DRAWN BY
SRG

CHECKED BY
SRG

RESERVE @ MITCHELL MILL
TOWN OF ROLESVILLE, WAKE COUNTY, NORTH CAROLINA
CONSTRUCTION PLANS
EROSION CONTROL PLAN
PHASE 3 - STAGE 3

DRAWING
SHEET
C-10.18


77 OF 230

CONSTRUCTION INFRASTRUCTURE DRAWINGS		DRAWINGS		DATE	
01	CID-24-04	08/04/2024	SRG		BY
02	TOWN OF ROLESVILLE CID-24-04 V2	11/01/2024	SRG		
03	TOWN OF ROLESVILLE CID-24-04 V3	02/07/2024	SRG		
04	TOWN OF ROLESVILLE CID-24-04 V4	08/02/2025	SRG		
05	TOWN OF ROLESVILLE CID-24-04 V5	09/02/2025	SRG		
REVISIONS				DATE	BY
No.					


ADJOINER INFORMATION			
1	CHARLES E. FERRELL AND WIFE GRETIA LOUISE FERRELL PIN: 1757481951 DB 1813 PG 421 ZONING: R-30 (WC) USE: SF	20	CECIL L. GOODNIGHT AND WIFE, JUDY J. GOODNIGHT PIN: 1757650296 DB 5344 PG 819 ZONING: R-30 (WC) USE: SF
2	ABRAHAM T. BURNHAM AND KYLA L. BURNHAM PIN: 1757481832 DB 19140 PG 734 ZONING: R-30 (WC) USE: SF	21	CECIL L. GOODNIGHT AND WIFE, JUDY J. GOODNIGHT PIN: 1757641415 DB 5344 PG 819 ZONING: R-30 (WC) USE: VA
3	JOE L. GREEN PIN: 1757483799 DB 15-E PG 2691 ZONING: R-30 (WC) USE: SF	22	CHRISTOPHER GHOLSON AND WIFE, KELLY GAITHER GHOLSON PIN: 1757555361 DB 17855 PG 457 LOT 4 - BM 2018 PG 1333 ZONING: R-30 (WC) USE: SF
4	CHARLES ALFONSA JONES AND WIFE ALLIE V. JONES PIN: 1757484609 DB 2305 PG 673 ZONING: R-30 (WC) USE: SF	23	ABAHOR ELIAS AND SPOUSE, SUSAN ELIAS PIN: 175753215 DB 17220 PG 2609 LOT 3 - BM 2018 PG 1333 ZONING: R-30 (WC) USE: SF
5	BENJAMIN FERRELL PIN: 1757485713 DB 1697 PG 465 ZONING: R-30 (WC) USE: SF	24	TODD KENDALL HONEYCUTT PIN: 1757551202 DB 13474 PG 1974 LOT 2 - BM 2018 PG 1333 ZONING: R-30 (WC) USE: SF
6	ALESIA FERRELL & ARRON WALKER PIN: 175748733 DB 6374 PG 89 BM 1996 PG 00524 ZONING: R-30 (WC) USE: SF	25	CURTIS L. HONEYCUTT AND WIFE TODD KENDALL PIN: 1757540996 DB 19269 PG 2474 LOT 1 - BM 2018 PG 1333 ZONING: R-30 (WC) USE: SF
7	CHRIST HOLINESS CHURCH #1 PIN: 1757487783 DB 2928 PG 328 ZONING: R-30 (WC) USE: CH	26	PHETIS JONES BRADSHER PIN: 1757349473 DB 15208 PG 2320 BM 2013 PG 868 ZONING: R-30 (WC) USE: FO
8	CHRIST HOLINESS CHURCH #1 PIN: 1757489733 DB 4321 PG 788 ZONING: R-30 (WC) USE: VA	27	PHETIS JONES BRADSHER PIN: 1757349473 DB 15208 PG 2320 ZONING: R-30 (WC) USE: FO
9	CHRIST HOLINESS CHURCH #1 PIN: 1757580764 DB 8467 PG 430 ZONING: R-30 (WC) USE: VA	28	PERR Y. ELWOOD RYAN PIN: 1757587562 DB 19232 PG 2780 ZONING: R-30 (WC) USE: MO
10	ALICIA BROWN & CARL T. JONES PIN: 1757582714 DB 18128 PG 183 ZONING: R-30 (WC) USE: SF	29	TOUTLOFF, KENNETH S. TOUTLOFF, BILLIE ANNE PIN: 1757357764 DB 9236 PG 2229 LOT 3 - BM 1990 PG 956 ZONING: R-30 (WC) USE: SF
11	RS RENTAL II LLC PIN: 1757584724 DB 18703 PG 2414 BM 1981 PG 894 ZONING: R-30 (WC) USE: SF	30	BERNARD MILLER PIN: 1757357865 DB 15416 PG 1651 LOT 4 - BM 1990 PG 956 ZONING: R-30 (WC) USE: SF
12	KAREN E. BASS PIN: 1757588704 DB 12560 PG 1636 BM 1984 PG 943 ZONING: R-30 (WC) USE: SF	31	MARCIE L. HOLDEN PIN: 1757358908 DB 15589 PG 1003 LOT 5 - BM 1990 PG 956 ZONING: R-30 (WC) USE: SF
13	JAMES K. WILLIAMS PIN: 1757588784 DB 18784 PG 1013 BM 1989 PG 01474 ZONING: R-30 (WC) USE: VA	32	MEGAN KULAWIAK PIN: 1757387387 DB 16226 PG 1133 LOT 6 BM 1989 PG 00387 ZONING: R-30 (WC) USE: VA
14	GRO PEG PROPERTIES LLC PIN: 1757684897 DB 18359 PG 1707 LOT 5 - BM 1980 PG 00396 ZONING: R-30 (WC) USE: VA	33	KENNETH INVESTMENT LLC. PIN: 1757368816 DB 19248 PG 1884 ZONING: R-30 (WC) USE: VA
15	SCOTT & THERESA CARLE PIN: 1757678786 DB 14863 PG 2493 LOT 4A - BM 1980 PG 00396 ZONING: R-30 (WC) USE: VA	34	KENNETH INVESTMENT LLC PIN: 1757471559 DB 19248 PG 1884 LOT - BM 2007 PG 01224 ZONING: R-30 (WC) USE: VA
16	GRO PEG PROPERTIES PIN: 1757664956 DB 19081 PG 2786 LOT 2A - BM 1982 PG 00581 ZONING: R-30 (WC) USE: VA	35	HENRY ALSTON PIN: 1757481376 DB 19248 PG 984 BM 1982 PG 721 ZONING: R-30 (WC) USE: SF
17	MT. CALVARY HOLINESS CHURCH OF WAKE CO. INC PIN: 1757660324 DB 10124 PG 2778 LOT 1 - BM 2002 PG 991 ZONING: R-30 (WC) USE: VA	36	UNIVERSAL CHURCH OF PRAYER PIN: 1757388408 DB 19559 PG 1723 LOT - BM 2002 PG 00667 ZONING: R-30 (WC) USE: CH
18	G. ARCHIE UNDERHILL, JR. AND WIFE, TERESSA C. UNDERHILL PIN: 1757653765 DB 8443 PG 2129 BM 1999 PG 1357 ZONING: R-30 (WC) USE: SF	37	ROZELIA J. HARTSFIELD HEIRS PIN: 1757481740 DB 10-E PG 1220 ZONING: R-30 (WC) USE: VA
19	GENADIUS MAC PREDDY AND WIFE, MATTIE F. PREDDY PIN: 1757656586 DB 1882 PG 342 ZONING: R-30 (WC) USE: SF		

NOTE:

- PHASE 4, ACREAGE: 13.58 AC
- EROSION CONTROL NOTES: SEE SHEET C-10.0
- ALL LAND-DISTURBING ACTIVITIES MUST BE PLANNED AND CONDUCTED TO LIMIT THE EXPOSED AREA TO 50 ROLLING ACRES.
- STOCKPILE HEIGHT SHALL NOT EXCEED 35 FEET.
- PORTIONS OF PHASE 5 MAY BE REQUIRED TO BE INSTALLED TO PROVIDE PHASE 4 WITH SUFFICIENT ACCESS.

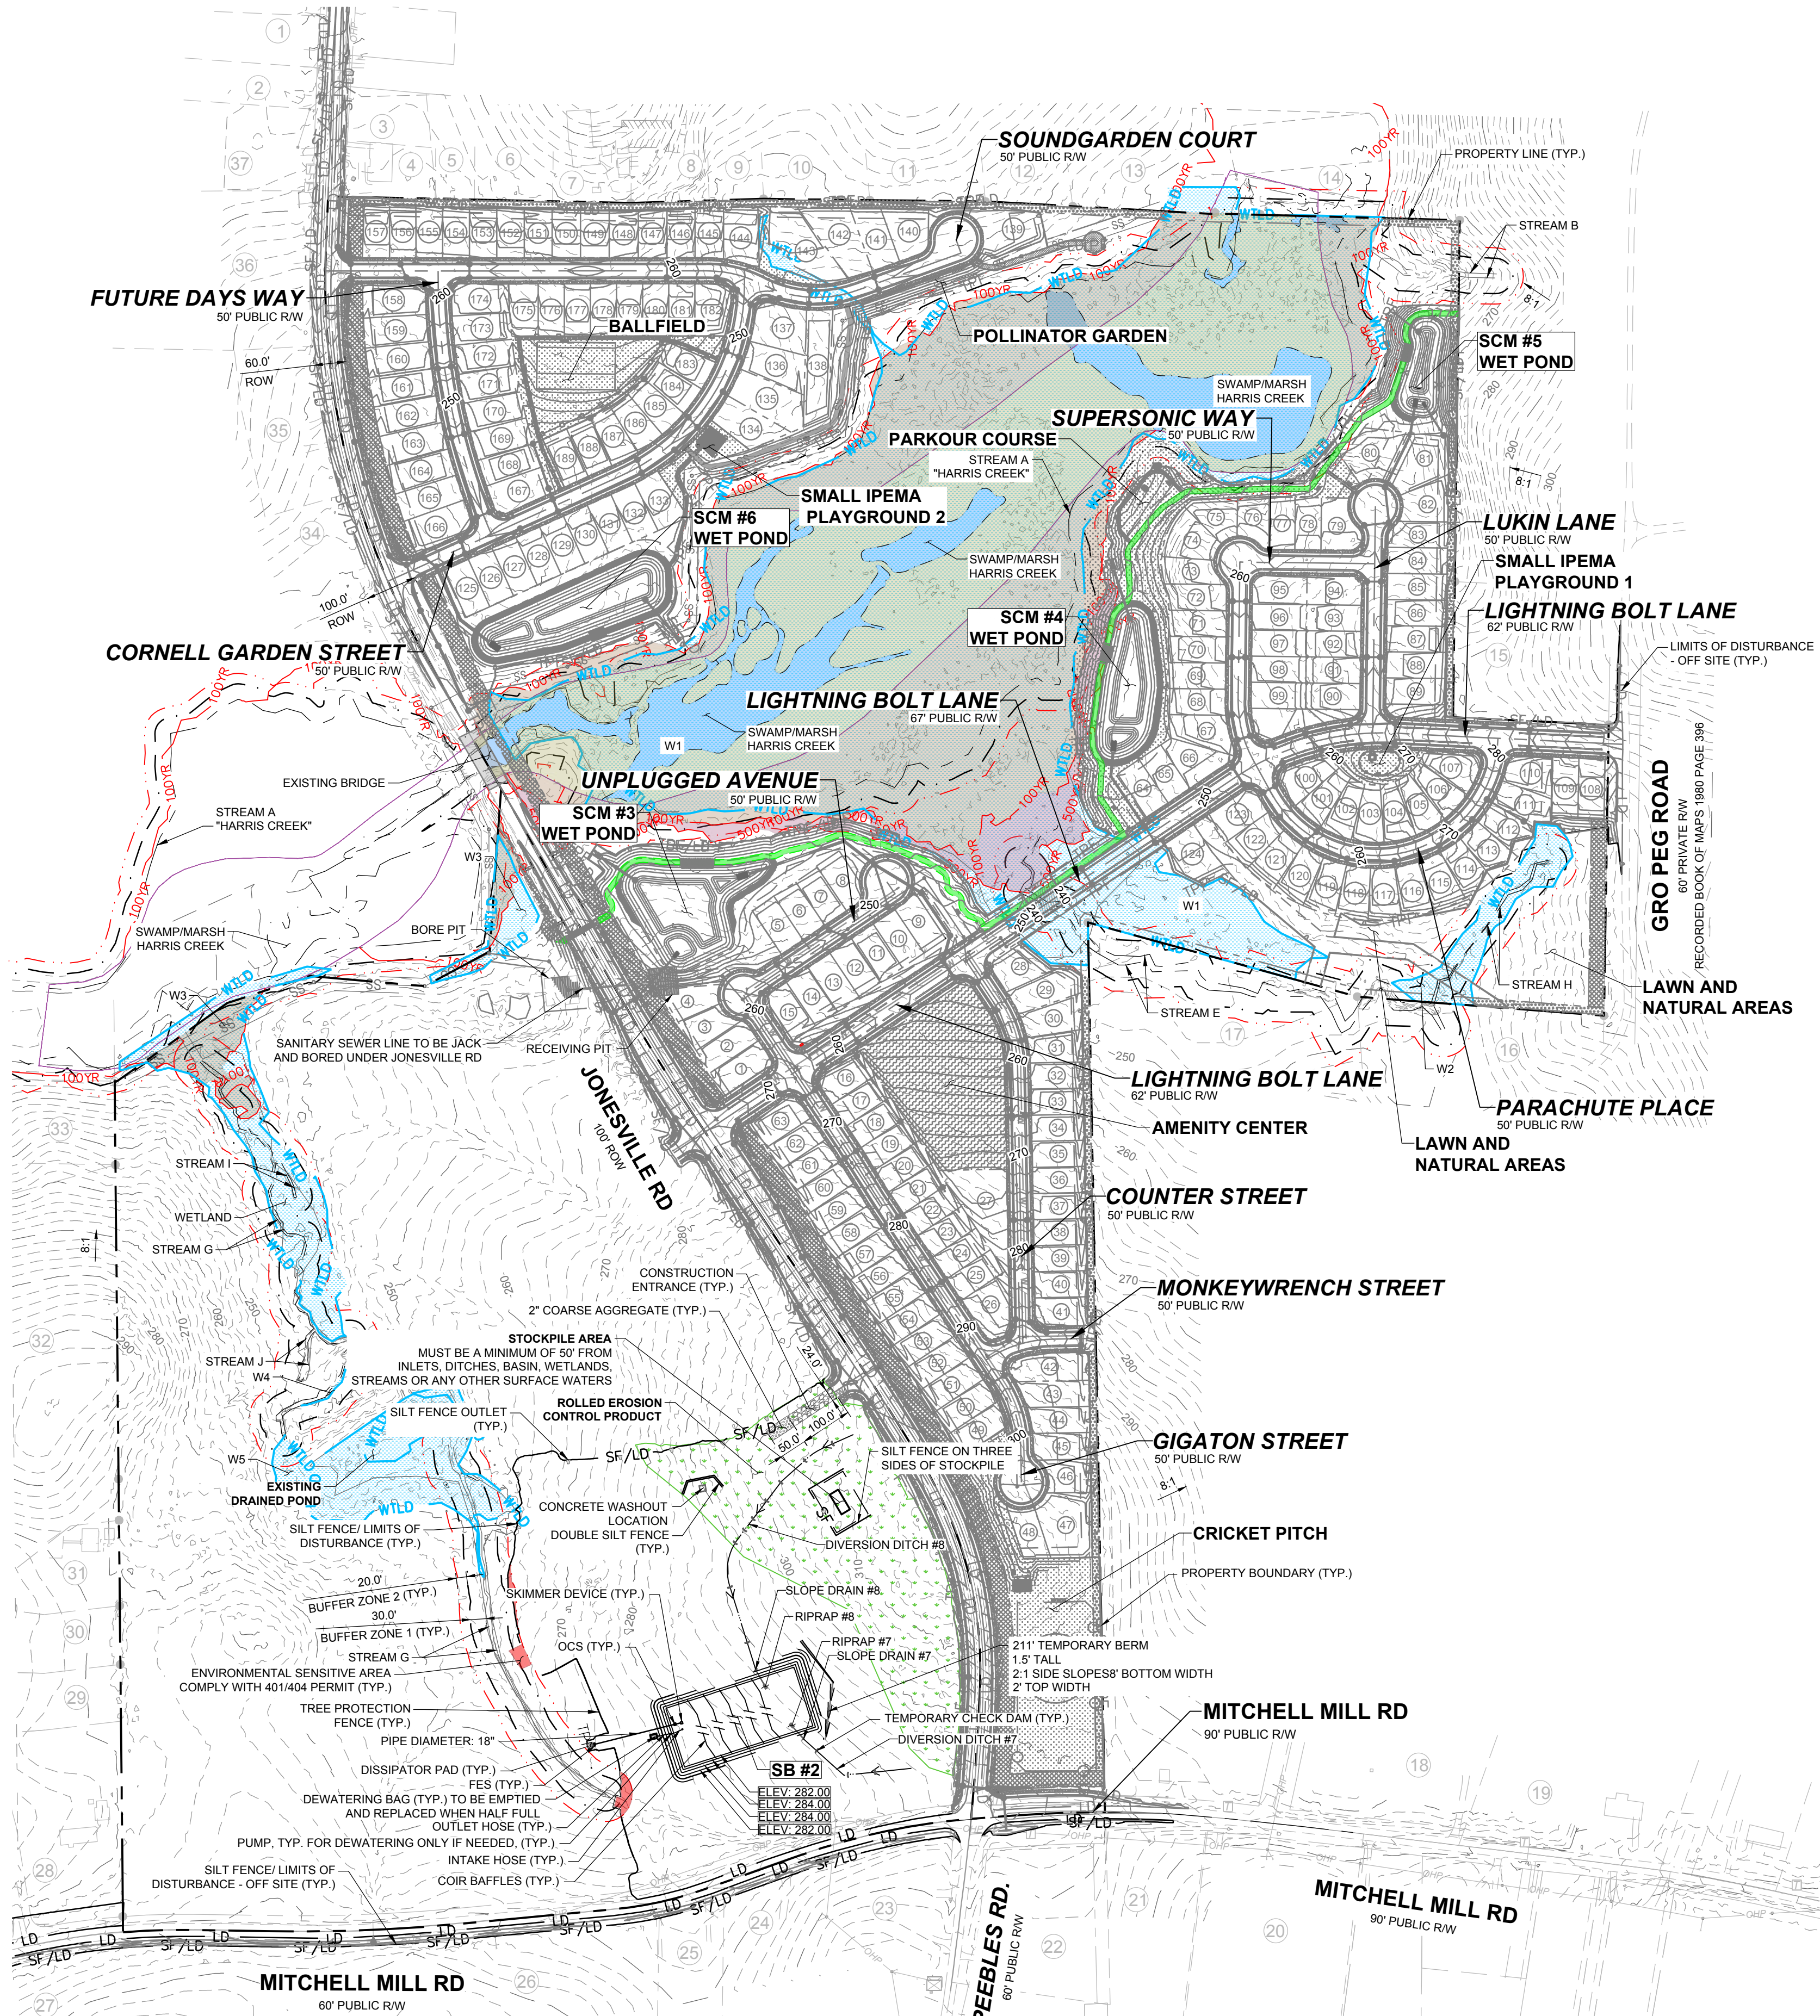

LEGEND:	
---	EXISTING ADJOINER PROPERTY LINE
---	EXISTING EDGE OF PAVEMENT
---	EX. MAJOR CONTOURS
---	EX. MINOR CONTOURS
---	SILT FENCE/ LIMITS OF DISTURBANCE
---	LIMITS OF DISTURBANCE
---	SILT FENCE
---	TREE PROTECTION LINE
---	TEMPORARY DITCH
---	BAFFLES
---	TEMPORARY SLOPE DRAIN
---	TEMPORARY SKIMMER
---	SILT FENCE OUTLET
---	CHECK DAM
---	DISSIPATOR PAD
---	CONSTRUCTION ENTRANCE
---	EXISTING WETLAND
---	ROLLED EROSION CONTROL
---	ENVIRONMENTAL SENSITIVE AREA

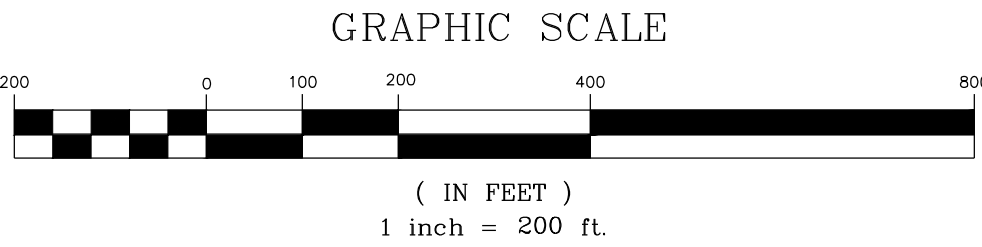

THIS PLANSET AND ANY ASSOCIATED DOCUMENTS ARE PRELIMINARY AND NOT AUTHORIZED FOR CONSTRUCTION UNTIL SIGNED, DATED, AND OFFICIALLY RELEASED FOR CONSTRUCTION BY THE ENGINEER OF RECORD.

STRONGROCK


ENGINEERING GROUP

STRONG ROCK ENGINEERING GROUP, PLLC | COMPANY LICENSE # P-2166
305 CHURCH AT NORTH HILLS STREET, SUITE 1110 RALEIGH, NC 27609 | INFORMATION@STRONGROCKGROUP.COM


RESERVE @ MITCHELL MILL
TOWN OF ROLESVILLE, WAKE COUNTY, NORTH CAROLINA
CONSTRUCTION PLANS
EROSION CONTROL PLAN OVERALL
PHASE 4 - STAGE 1

DRAWING SHEET
C-10.19
78 OF 230

CONSTRUCTION INFRASTRUCTURE DRAWINGS	08/04/2024	SRG	BY
No.			DATE
			REVISIONS

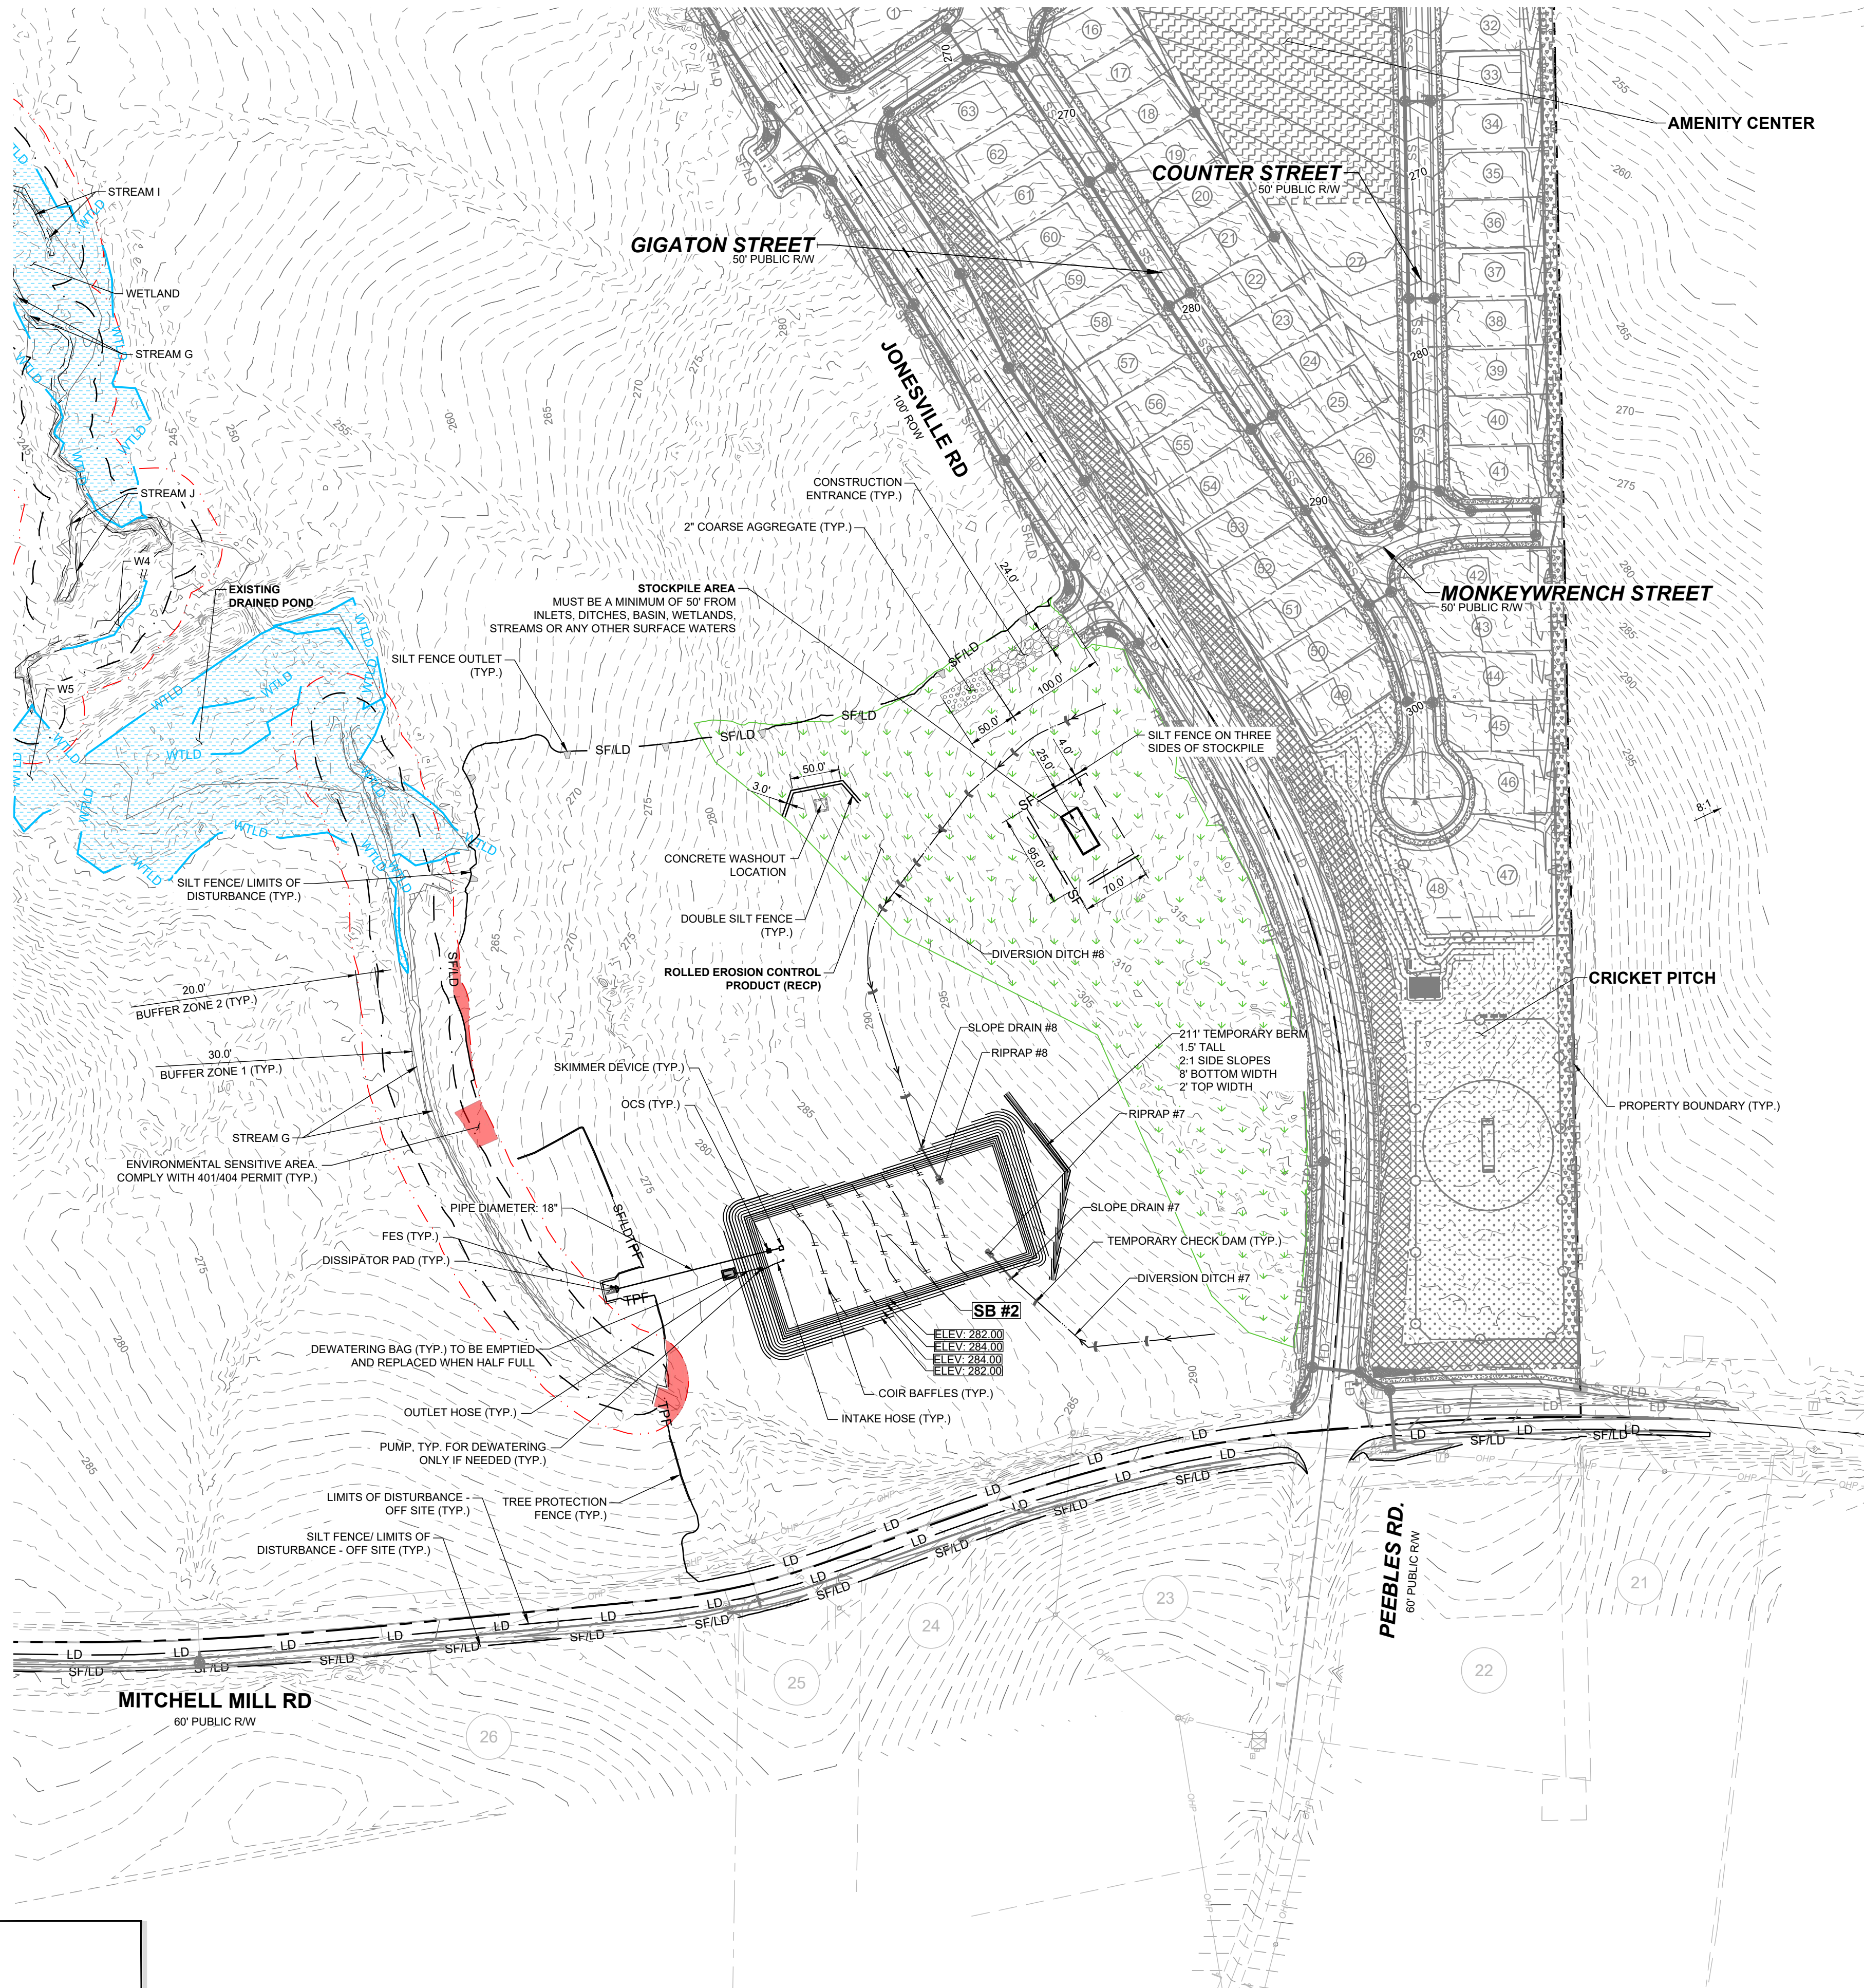


- NOTE:**
1. PHASE 4, ACREAGE: 13.58 AC
 2. EROSION CONTROL NOTES: SEE SHEET C-10.0
 3. ALL LAND-DISTURBING ACTIVITIES MUST BE PLANNED AND CONDUCTED TO LIMIT THE EXPOSED AREA TO 50 ROLLING ACRES.
 4. STOCKPILE HEIGHT SHALL NOT EXCEED 35 FEET.
 5. PORTIONS OF PHASE 5 MAY BE REQUIRED TO BE INSTALLED TO PROVIDE PHASE 4 WITH SUFFICIENT ACCESS.

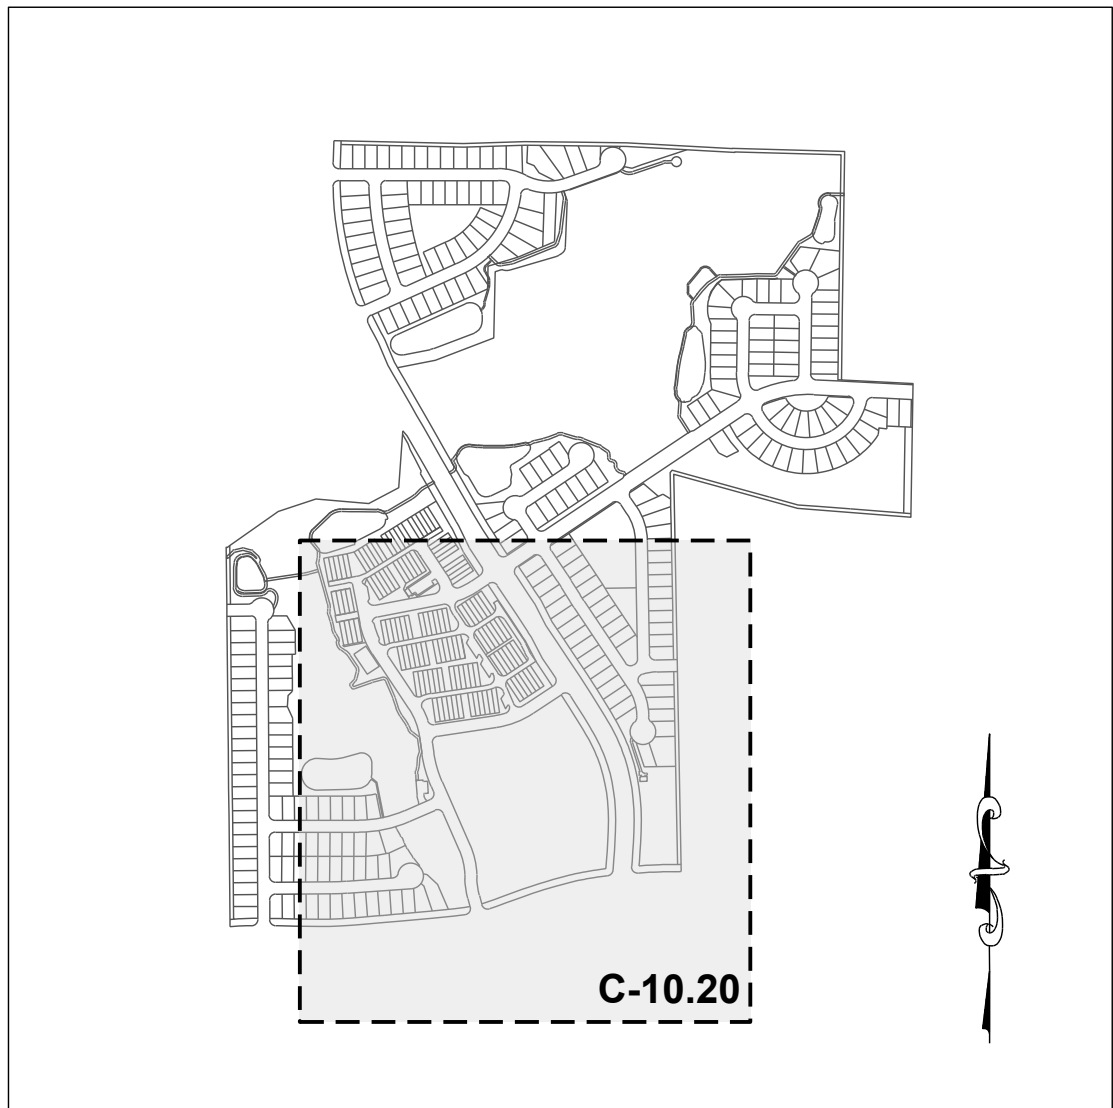

SITE KEY PLAN

LEGEND:	
---	EXISTING ADJOINER PROPERTY LINE
---	EXISTING EDGE OF PAVEMENT
---	EX. MAJOR CONTOURS
---	EX. MINOR CONTOURS
SF/LD	SILT FENCE/LIMITS OF DISTURBANCE
LD	LIMITS OF DISTURBANCE
SF	SILT FENCE
TPF	TREE PROTECTION LINE
---	TEMPORARY DITCH
---	BAFFLES
---	TEMPORARY SLOPE DRAIN
---	TEMPORARY SKIMMER
---	SILT FENCE OUTLET
---	CHECK DAM
---	DISSIPATOR PAD
---	CONSTRUCTION ENTRANCE
---	EXISTING WETLAND
---	ROLLED EROSION CONTROL
---	ENVIRONMENTAL SENSITIVE AREA

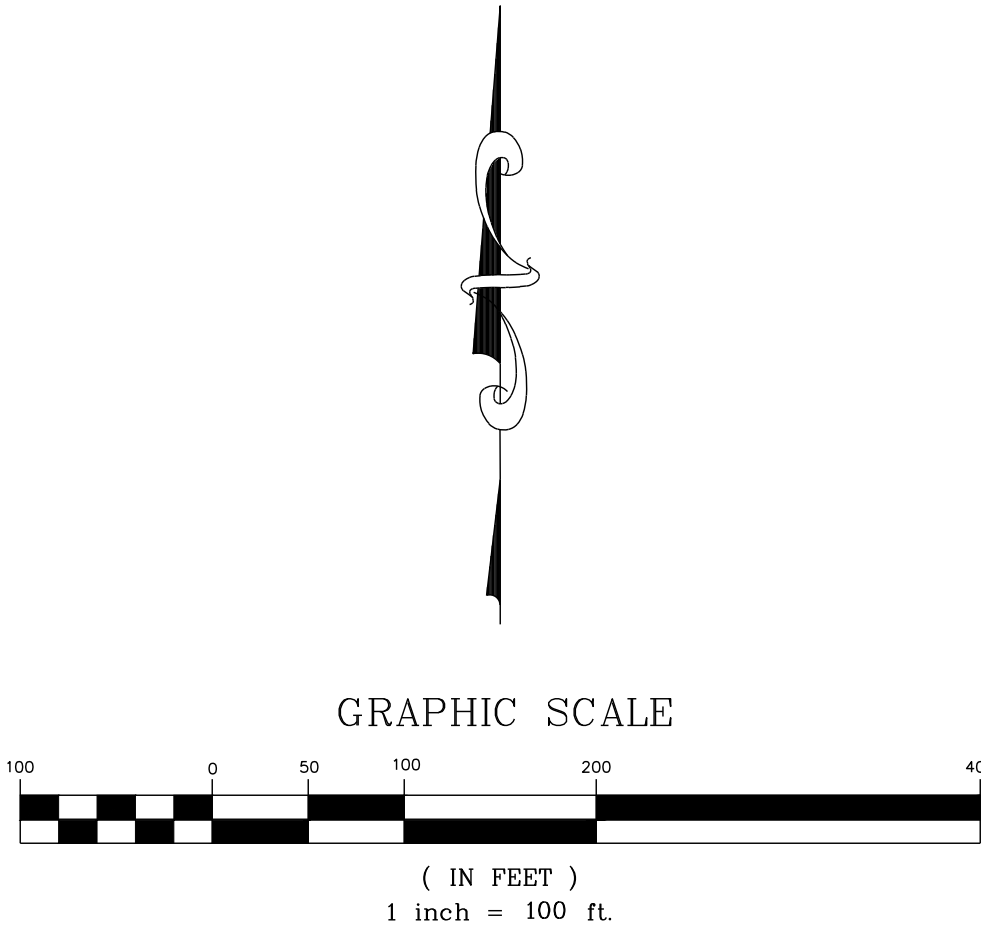

THIS PLANSET AND ANY ASSOCIATED DOCUMENTS ARE PRELIMINARY AND NOT AUTHORIZED FOR CONSTRUCTION UNTIL SIGNED, DATED, AND OFFICIALLY RELEASED FOR CONSTRUCTION BY THE ENGINEER OF RECORD.

CONSTRUCTION INFRASTRUCTURE DRAWINGS		DATE	BY
01	CID-24-04	08/04/2024	SRG
02	TOWN OF ROLESVILLE CID-24-04 V2	11/07/2024	SRG
03	TOWN OF ROLESVILLE CID-24-04 V3	02/07/2024	SRG
04	TOWN OF ROLESVILLE CID-24-04 V4	08/02/2025	SRG
05	TOWN OF ROLESVILLE CID-24-04 V5	09/02/2025	SRG
REVISIONS		DATE	BY
No.			

STRONGROCK

ENGINEERING GROUP

STRONG ROCK ENGINEERING GROUP, PLLC | COMPANY LICENSE # P-2166
305 CHURCH AT NORTH HILLS STREET, SUITE 1110 RALEIGH, NC 27609 | INFORMATION@STRONGROCKGROUP.COM

STRONG ROCK PROJECT	NOT FOR CONSTRUCTION	SCALE	AS SHOWN	DESIGNED BY	SRG	DRAWN BY	SRG	CHECKED BY	SRG
---------------------	----------------------	-------	----------	-------------	-----	----------	-----	------------	-----

RESERVE @ MITCHELL MILL
TOWN OF ROLESVILLE, WAKE COUNTY, NORTH CAROLINA
CONSTRUCTION PLANS
EROSION CONTROL PLAN
PHASE 4 - STAGE 1



DRAWING
SHEET

C-10.20



79 OF 230

NOTE:


1. PHASE 4, ACREAGE: 13.58 AC
2. EROSION CONTROL NOTES: SEE SHEET C-10.0
3. ALL LAND-DISTURBING ACTIVITIES MUST BE PLANNED AND CONDUCTED TO LIMIT THE EXPOSED AREA TO 50 ROLLING ACRES.
4. STOCKPILE HEIGHT SHALL NOT EXCEED 35 FEET.
5. PORTIONS OF PHASE 5 MAY BE REQUIRED TO BE INSTALLED TO PROVIDE PHASE 4 WITH SUFFICIENT ACCESS.

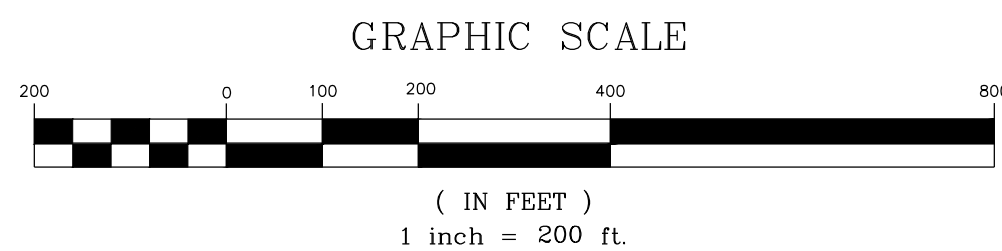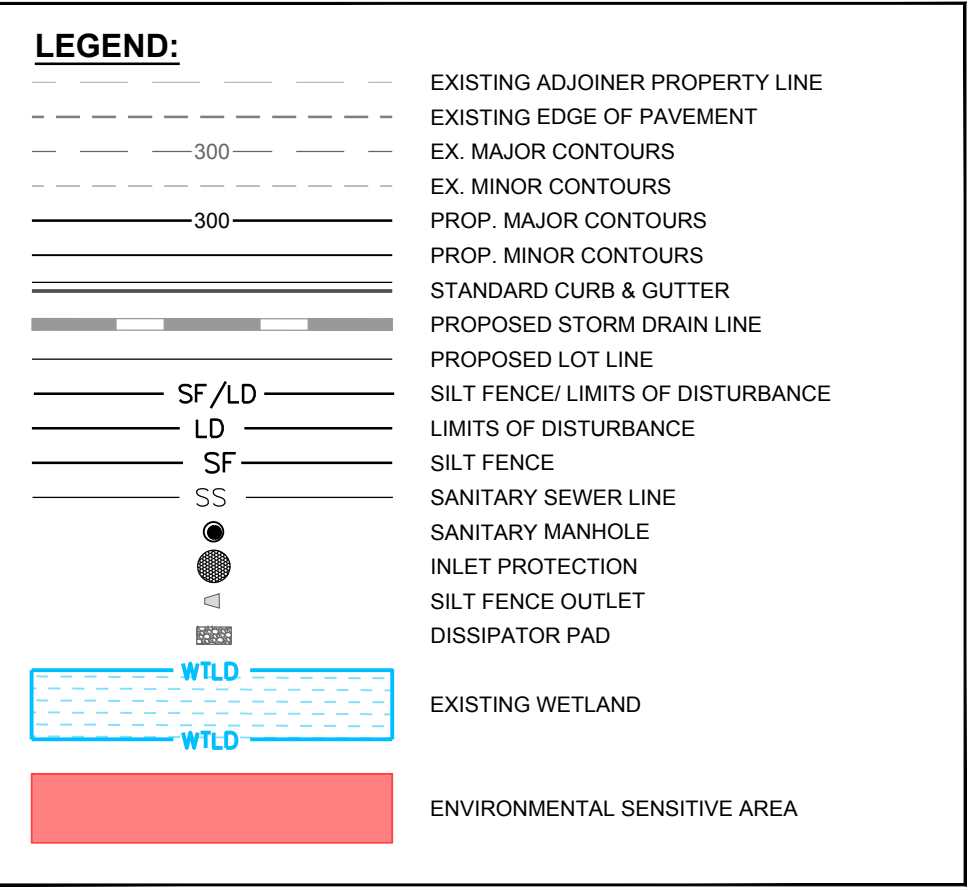

THIS PLANSET AND ANY ASSOCIATED DOCUMENTS ARE PRELIMINARY AND NOT AUTHORIZED FOR CONSTRUCTION UNTIL SIGNED, DATED, AND OFFICIALLY RELEASED FOR CONSTRUCTION BY THE ENGINEER OF RECORD.

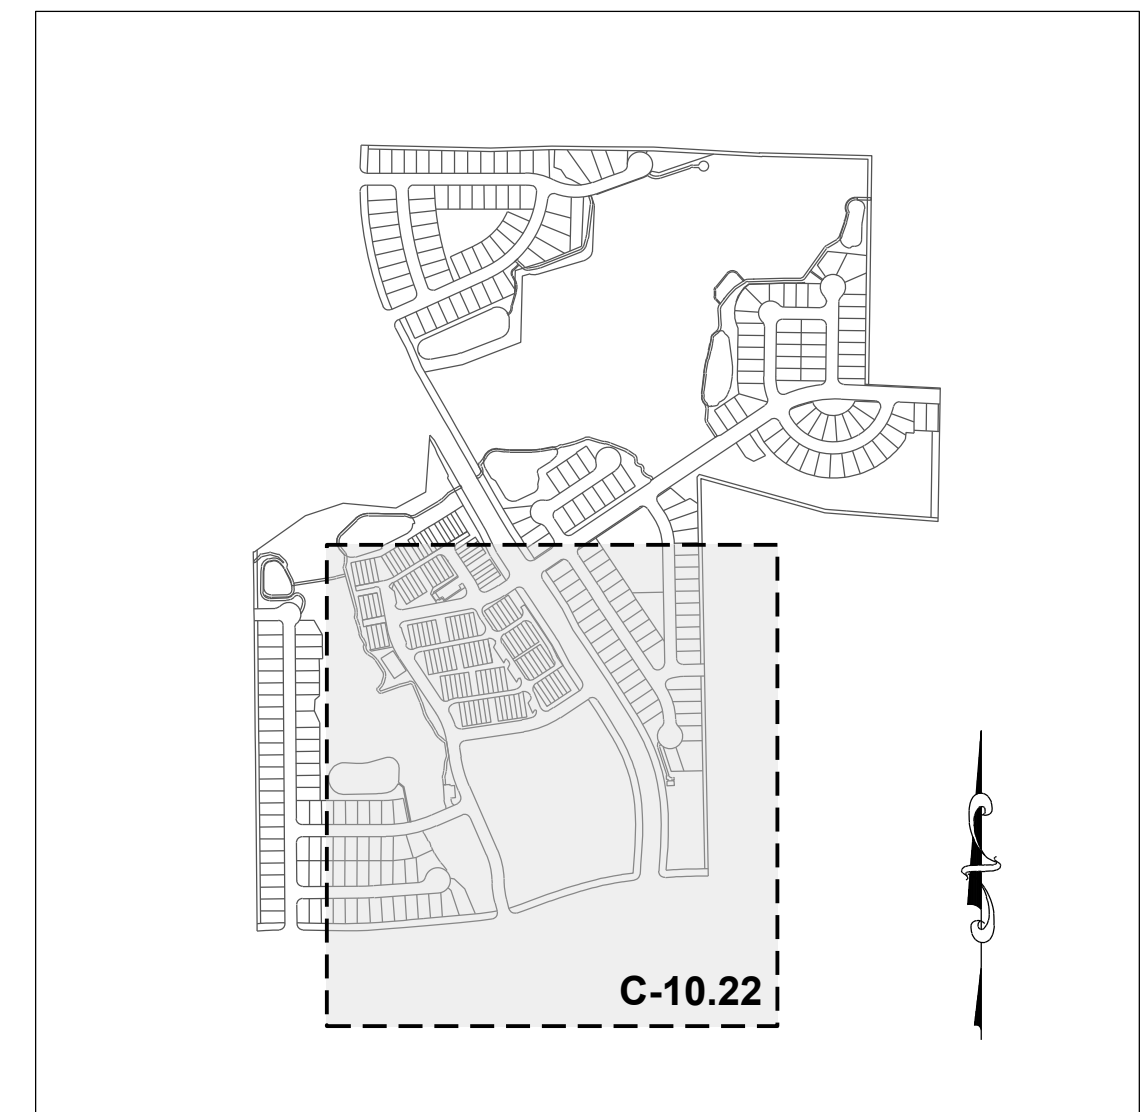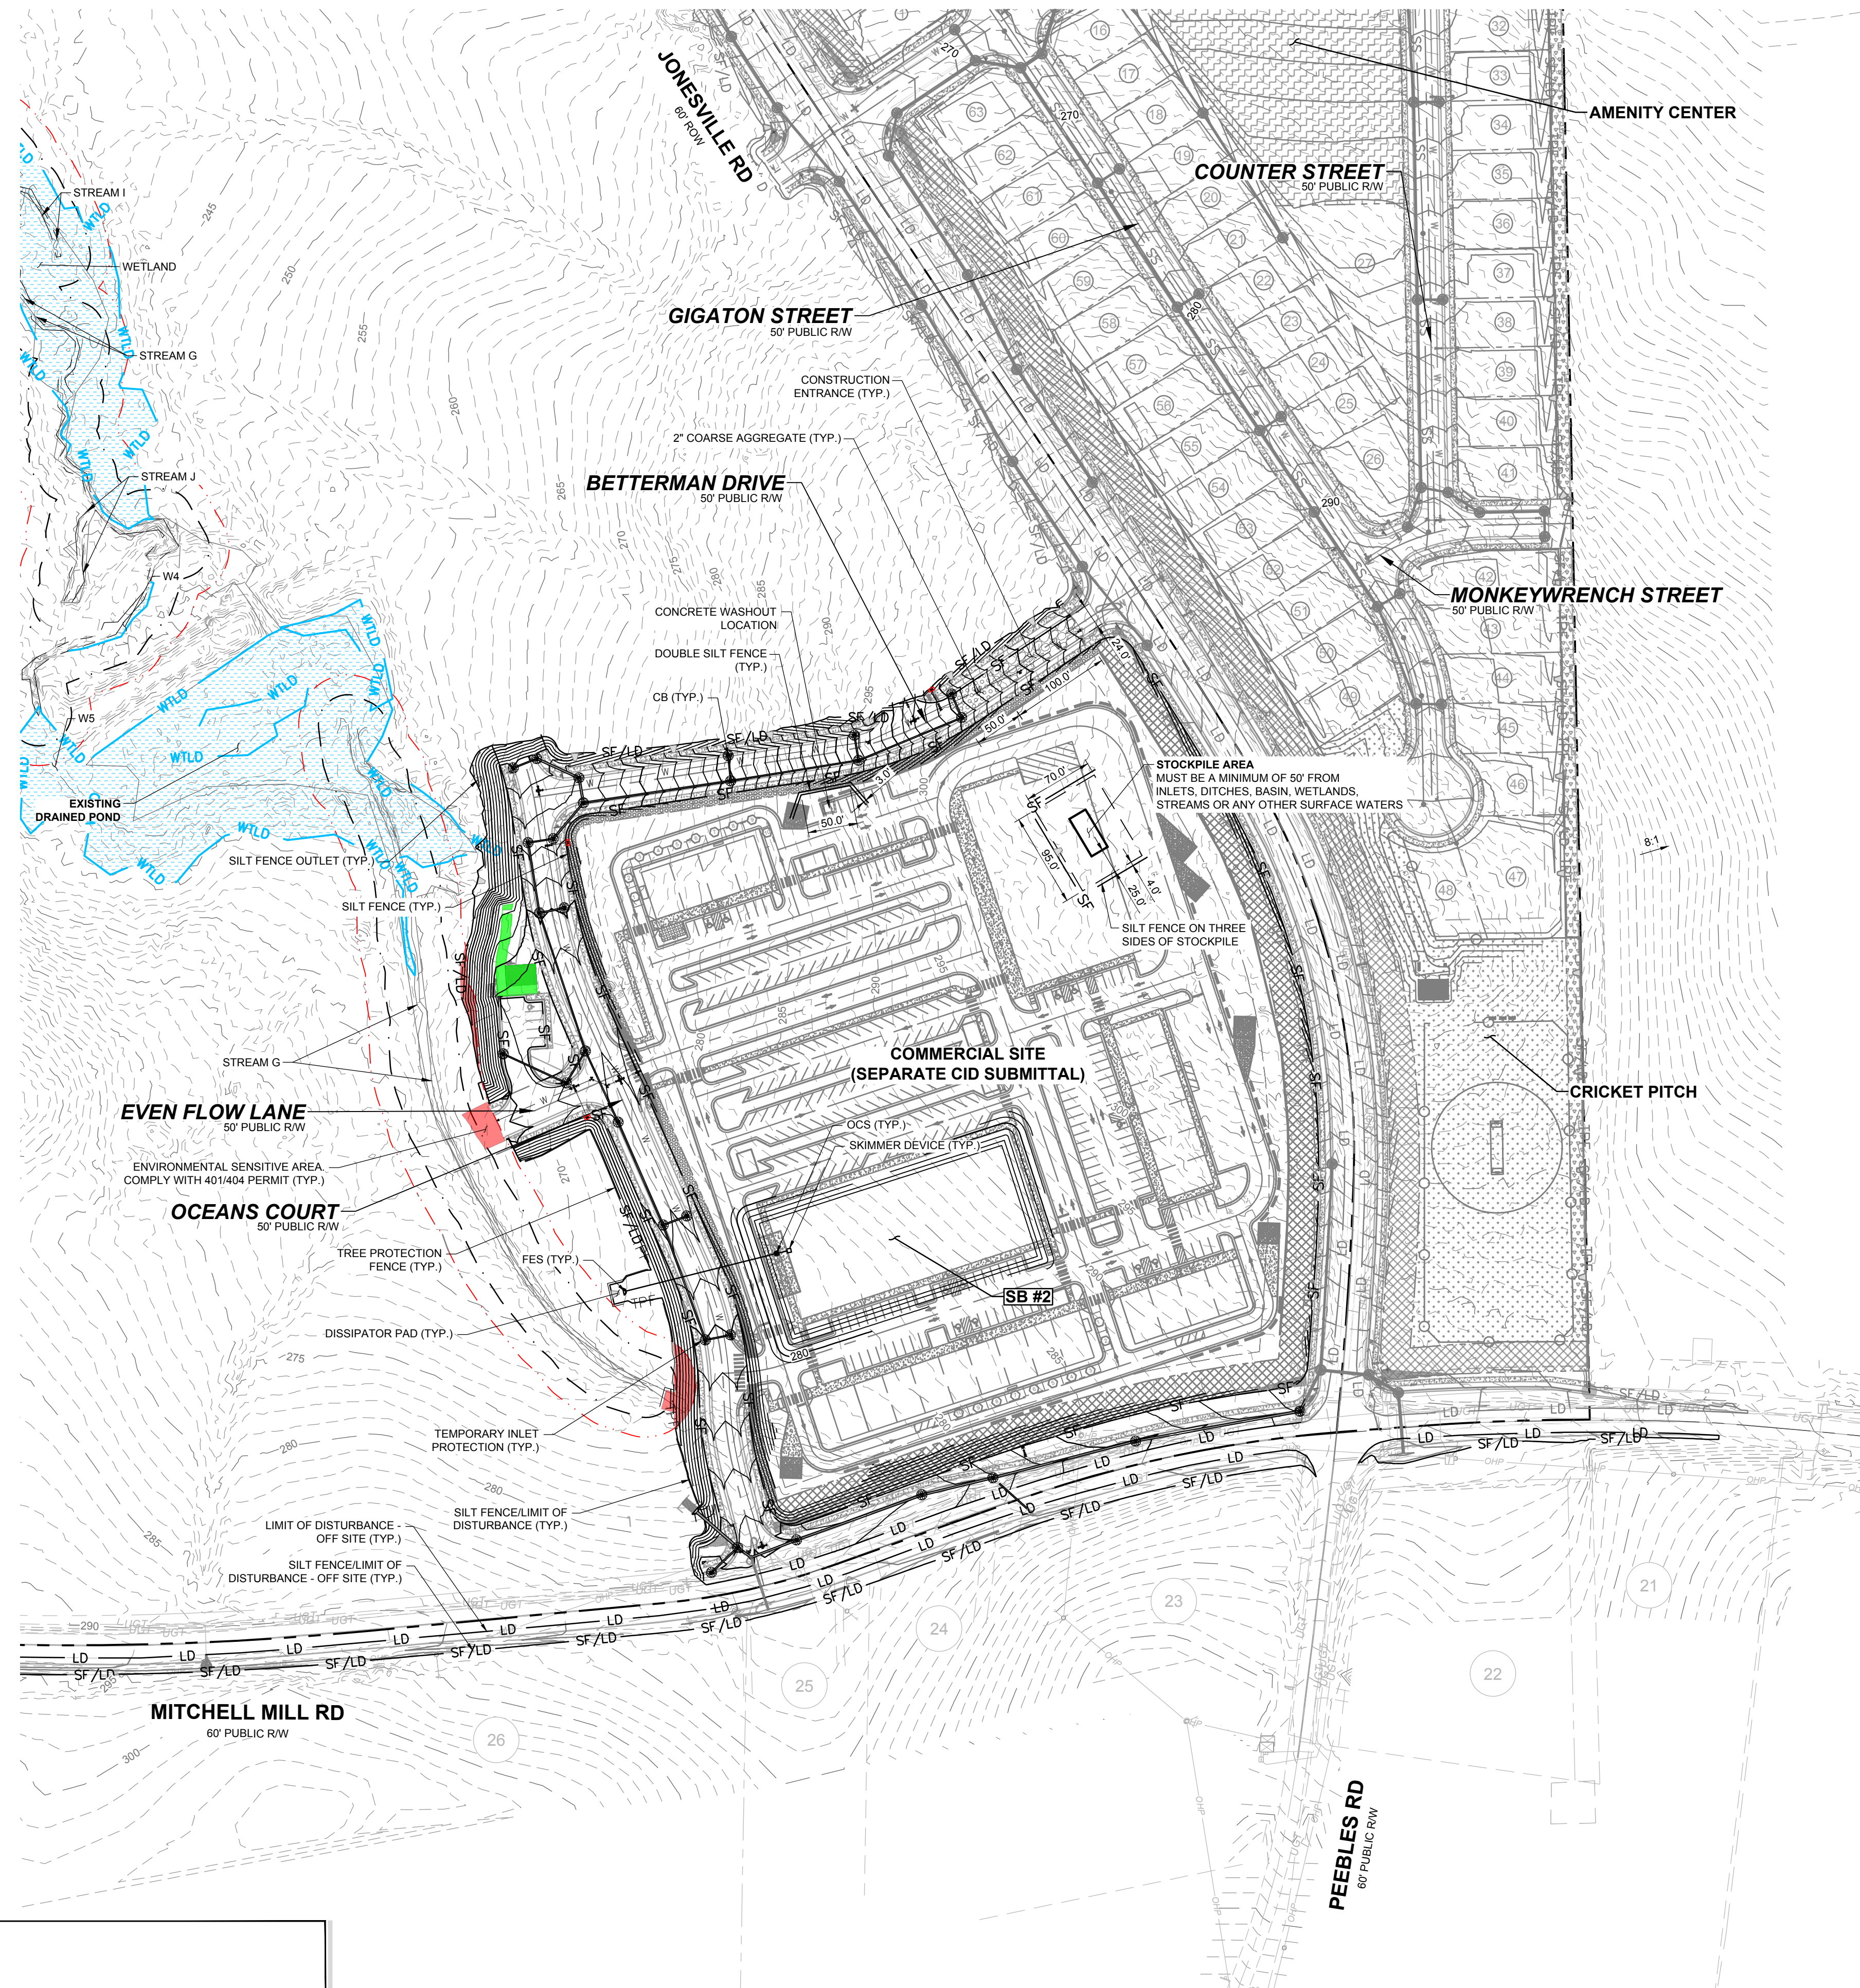


SITE KEY PLAN

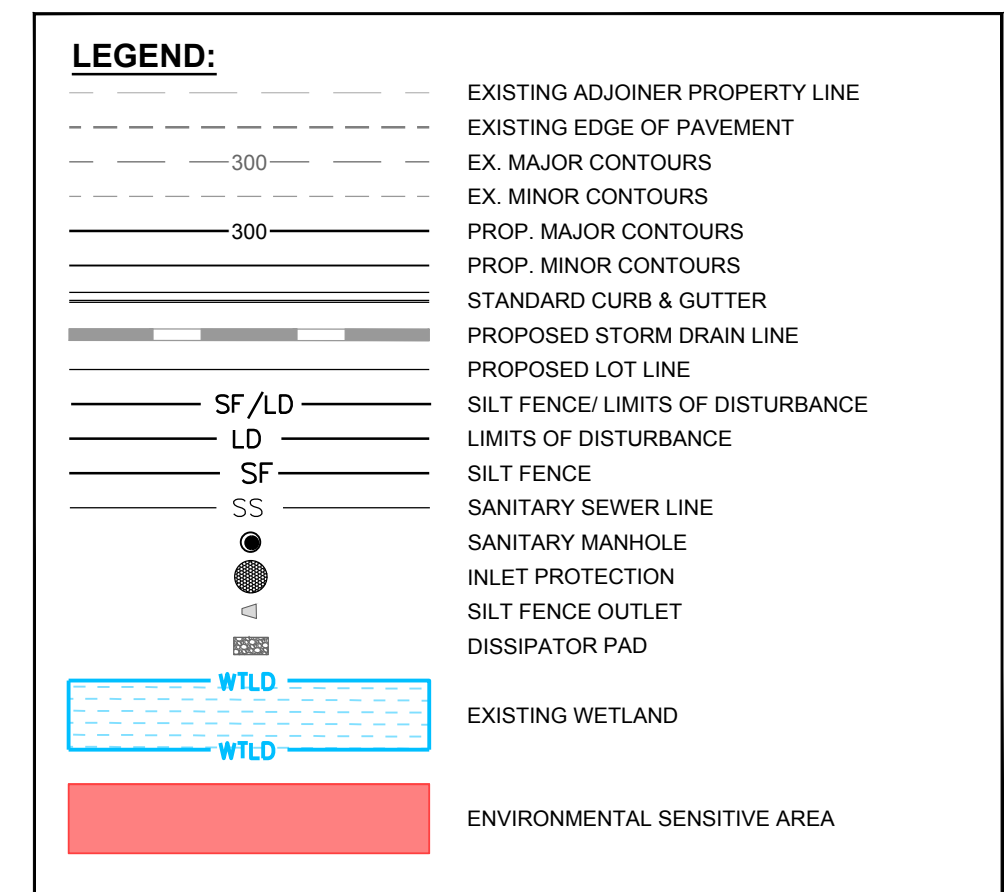

NOTE:

1. PHASE 4, ACREAGE: 13.58 AC
2. EROSION CONTROL NOTES: SEE SHEET C-10.0
3. ALL LAND-DISTURBING ACTIVITIES MUST BE PLANNED AND CONDUCTED TO LIMIT THE EXPOSED AREA TO 50 ROLLING ACRES.
4. STOCKPILE HEIGHT SHALL NOT EXCEED 35 FEET.
5. PORTIONS OF PHASE 5 MAY BE REQUIRED TO BE INSTALLED TO PROVIDE PHASE 4 WITH SUFFICIENT ACCESS.

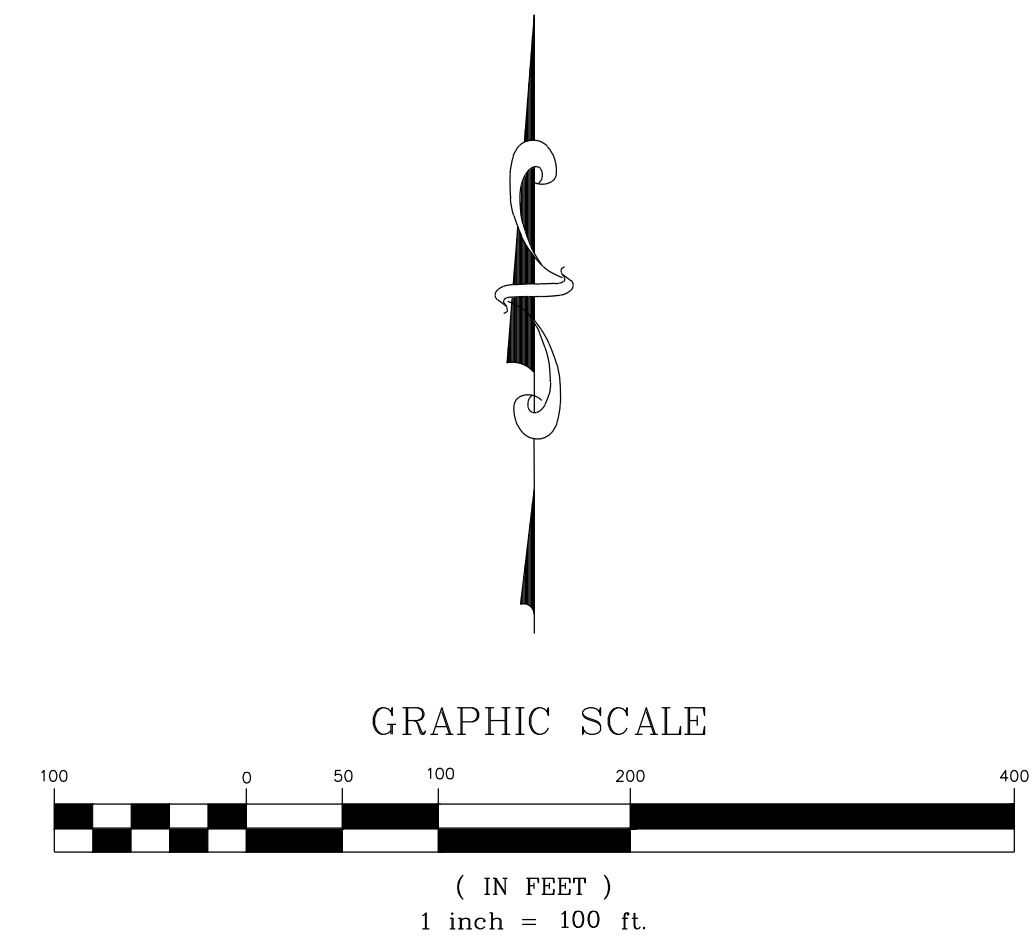

THIS PLANSET AND ANY ASSOCIATED DOCUMENTS ARE PRELIMINARY AND NOT AUTHORIZED FOR CONSTRUCTION UNTIL SIGNED, DATED, AND OFFICIALLY RELEASED FOR CONSTRUCTION BY THE ENGINEER OF RECORD.

81 OF 230	C-10.22	DRAWING SHEET	RESERVE @ MITCHELL MILL TOWN OF ROLESVILLE, WAKE COUNTY, NORTH CAROLINA CONSTRUCTION PLANS EROSION CONTROL PLAN PHASE 4 - STAGE 2	STRONG ROCK PROJECT PSP-23-03	STRONG ROCK ENGINEERING GROUP STRONG ROCK ENGINEERING GROUP, PLLC COMPANY LICENSE # P-2146 305 CHURCH AT NORTH HILLS STREET, SUITE 110 RALEIGH, NC 27603 INFORMATION@STRONGROCKGROUP.COM					SEAL:	
				NOT FOR CONSTRUCTION							01	CONSTRUCTION INFRASTRUCTURE DRAWINGS CID-24-04	06/04/2024	SRG	
				SCALE	AS SHOWN						02	TOWN OF ROLESVILLE CID-24-04 V2	11/01/2024	SRG	
				DESIGNED BY	SRG						03	TOWN OF ROLESVILLE CID-24-04 V3	02/01/2024	SRG	
				DRAWN BY	SRG						04	TOWN OF ROLESVILLE CID-24-04 V4	06/02/2025	SRG	
		CHECKED BY	SRG					05	TOWN OF ROLESVILLE CID-24-04 V5	09/02/2025	SRG	


ADJOINER INFORMATION			
1	CHARLES E. FERRELL AND WIFE GRETTE LOUISE FERRELL PIN: 1757481951 DB 1813 PG 421 ZONING: R-30 (WC) USE: SF	20	CECIL L. GOODNIGHT AND WIFE, JUDY J. GOODNIGHT PIN: 1757650296 DB 5344 PG 819 ZONING: R-30 (WC) USE: SF
2	ABRAHAM T. BURNHAM AND KYLA L. BURNHAM PIN: 1757481832 DB 19140 PG 734 ZONING: R-30 (WC) USE: SF	21	CECIL L. GOODNIGHT AND WIFE, JUDY J. GOODNIGHT PIN: 1757641415 DB 5344 PG 819 ZONING: R-30 (WC) USE: VA
3	JOE L. GREEN PIN: 1757483799 DB 15-E PG 2691 ZONING: R-30 (WC) USE: SF	22	CHRISTOPHER GHOLSON AND WIFE, KELLY GAITHER GHOLSON PIN: 1757555361 DB 17855 PG 457 LOT 4 - BM 2018 PG 1333 ZONING: R-30 (WC) USE: SF
4	CHARLES ALFONSA JONES AND WIFE ALLIE V. JONES PIN: 1757484609 DB 2305 PG 673 ZONING: R-30 (WC) USE: SF	23	ABAHOR ELIAS AND SPOUSE, SUSAN ELIAS PIN: 1757553215 DB 17220 PG 2609 LOT 3 - BM 2018 PG 1333 ZONING: R-30 (WC) USE: SF
5	BENJAMIN FERRELL PIN: 1757485713 DB 1697 PG 465 ZONING: R-30 (WC) USE: SF	24	TODD KENDALL HONEYCUTT PIN: 1757551202 DB 13474 PG 1974 LOT 2 - BM 2018 PG 1333 ZONING: R-30 (WC) USE: SF
6	ALESIA FERRELL & ARRON WALKER PIN: 1757489733 DB 6374 PG 89 BM 1996 PG 00524 ZONING: R-30 (WC) USE: SF	25	CURTIS L. HONEYCUTT AND WIFE TODD KENDALL PIN: 1757540996 DB 19269 PG 2474 LOT 1 - BM 2018 PG 1333 ZONING: R-30 (WC) USE: SF
7	CHRIST HOLINESS CHURCH #1 PIN: 1757487783 DB 2928 PG 328 ZONING: R-30 (WC) USE: CH	26	PHETIS JONES BRADSHER PIN: 1757349473 DB 15208 PG 2320 BM 2013 PG 868 ZONING: R-30 (WC) USE: FO
8	CHRIST HOLINESS CHURCH #1 PIN: 1757489733 DB 4321 PG 788 ZONING: R-30 (WC) USE: VA	27	PHETIS JONES BRADSHER PIN: 1757349473 DB 15208 PG 2320 ZONING: R-30 (WC) USE: FO
9	CHRIST HOLINESS CHURCH #1 PIN: 1757580764 DB 8467 PG 430 ZONING: R-30 (WC) USE: VA	28	PERR Y. ELWOOD RYAN PIN: 1757587562 DB 19292 PG 2780 ZONING: R-30 (WC) USE: MO
10	ALICIA BROWN & CARL T. JONES PIN: 1757582714 DB 18128 PG 183 ZONING: R-30 (WC) USE: SF	29	TOUTLOFF, KENNETH S. TOUTLOFF, BILLIE ANNE PIN: 1757357764 DB 9236 PG 2229 LOT 3 - BM 1990 PG 956 ZONING: R-30 (WC) USE: SF
11	RS RENTAL II LLC PIN: 1757584724 DB 18703 PG 2414 BM 1981 PG 894 ZONING: R-30 (WC) USE: SF	30	BERNARD MILLER PIN: 1757357865 DB 15416 PG 1651 LOT 4 - BM 1990 PG 956 ZONING: R-30 (WC) USE: SF
12	KAREN E. BASS PIN: 1757588704 DB 12560 PG 1626 BM 1984 PG 943 ZONING: R-30 (WC) USE: SF	31	MARCIE L. HOLDEN PIN: 1757358908 DB 15599 PG 1003 LOT 5 - BM 1990 PG 956 ZONING: R-30 (WC) USE: SF
13	JAMES K. WILLIAMS PIN: 1757588784 DB 18784 PG 1013 BM 1989 PG 01474 ZONING: R-30 (WC) USE: VA	32	MEGAN KULAWIAK PIN: 1757387387 DB 16226 PG 1133 LOT 6 BM 1989 PG 00387 ZONING: R-30 (WC) USE: VA
14	GRO PEG PROPERTIES LLC PIN: 1757684897 DB 18359 PG 1707 LOT 5 - BM 1980 PG 00396 ZONING: R-30 (WC) USE: VA	33	KENNETH INVESTMENT LLC PIN: 1757368816 DB 19248 PG 1884 ZONING: R-30 (WC) USE: VA
15	SCOTT & THERESA CARLE PIN: 1757678786 DB 14863 PG 2493 LOT 4A - BM 1980 PG 00396 ZONING: R-30 (WC) USE: VA	34	KENNETH INVESTMENT LLC PIN: 1757471559 DB 19248 PG 1884 LOT - BM 2007 PG 01224 ZONING: R-30 (WC) USE: VA
16	GRO PEG PROPERTIES PIN: 1757664956 DB 19081 PG 2786 LOT 2A - BM 1982 PG 00581 ZONING: R-30 (WC) USE: VA	35	HENRY ALSTON PIN: 1757481376 DB 19248 PG 984 BM 1982 PG 721 ZONING: R-30 (WC) USE: SF
17	MT. CALVARY HOLINESS CHURCH OF WAKE CO. INC PIN: 1757660324 DB 10124 PG 2778 LOT 1 - BM 2002 PG 991 ZONING: R-30 (WC) USE: VA	36	UNIVERSAL CHURCH OF PRAYER PIN: 1757388408 DB 19559 PG 1723 LOT - BM 2002 PG 00667 ZONING: R-30 (WC) USE: CH
18	G. ARCHIE UNDERHILL, JR. AND WIFE, TERESSA C. UNDERHILL PIN: 1757633765 DB 8443 PG 2129 BM 1999 PG 1357 ZONING: R-30 (WC) USE: SF	37	ROZELIA J. HARTSFIELD HEIRS PIN: 1757481740 DB 10-E PG 1220 ZONING: R-30 (WC) USE: VA
19	GENADIUS MAC PREDDY AND WIFE, MATTIE F. PREDDY PIN: 1757656586 DB 1882 PG 342 ZONING: R-30 (WC) USE: SF		

NOTE:

- PHASE 4, ACREAGE: 13.58 AC
- EROSION CONTROL NOTES: SEE SHEET C-10.0
- ALL LAND-DISTURBING ACTIVITIES MUST BE PLANNED AND CONDUCTED TO LIMIT THE EXPOSED AREA TO 50 ROLLING ACRES.
- STOCKPILE HEIGHT SHALL NOT EXCEED 35 FEET.
- PORTIONS OF PHASE 5 MAY BE REQUIRED TO BE INSTALLED TO PROVIDE PHASE 4 WITH SUFFICIENT ACCESS.





LEGEND:	
	EXISTING ADJOINER PROPERTY LINE
	EXISTING EDGE OF PAVEMENT
	EX. MAJOR CONTOURS
	EX. MINOR CONTOURS
	PROP. MAJOR CONTOURS
	PROP. MINOR CONTOURS
	STANDARD CURB & GUTTER
	PROPOSED STORM DRAIN LINE
	PROPOSED LOT LINE
	SILT FENCE/LIMITS OF DISTURBANCE
	LIMITS OF DISTURBANCE
	SILT FENCE
	SANITARY SEWER LINE
	SANITARY MANHOLE
	INLET PROTECTION
	SILT FENCE OUTLET
	DISSEIPATOR PAD
	EXISTING WETLAND
	ENVIRONMENTAL SENSITIVE AREA

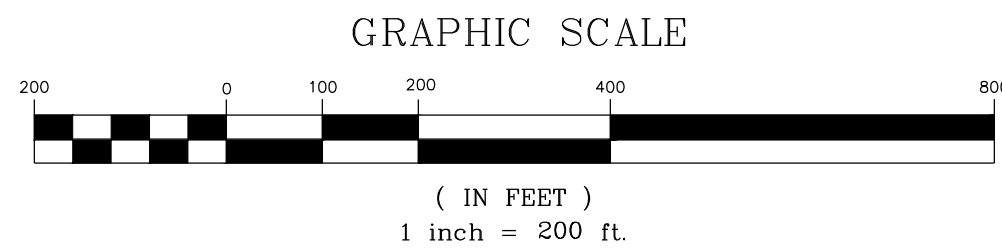

THIS PLANSET AND ANY ASSOCIATED DOCUMENTS ARE PRELIMINARY AND NOT AUTHORIZED FOR CONSTRUCTION UNTIL SIGNED, DATED, AND OFFICIALLY RELEASED FOR CONSTRUCTION BY THE ENGINEER OF RECORD.

CONSTRUCTION INFRASTRUCTURE DRAWINGS		BY	
01	08/04/2024		
02	11/07/2024		
03	02/07/2024		
04	06/02/2025		
05	08/02/2025		
		REVISIONS	
		No.	DATE
SEAL:			
STRONGROCK ENGINEERING GROUP STRONG ROCK ENGINEERING GROUP, PLLC COMPANY LICENSE # P-2166 305 CHURCH AT NORTH HILLS STREET, SUITE 1110 RALEIGH, NC 27609 INFORMATION@STRONGROCKGROUP.COM			
STRONG ROCK PROJECT PSP-24-03	NOT FOR CONSTRUCTION	SCALE AS SHOWN	SRG DESIGNED BY
			SRG DRAWN BY
			SRG CHECKED BY
RESERVE @ MITCHELL MILL TOWN OF ROLESVILLE, WAKE COUNTY, NORTH CAROLINA CONSTRUCTION PLANS EROSION CONTROL PLAN OVERALL PHASE 4 - STAGE 3			
DRAWING SHEET			
C-10.23			
82 OF 230			

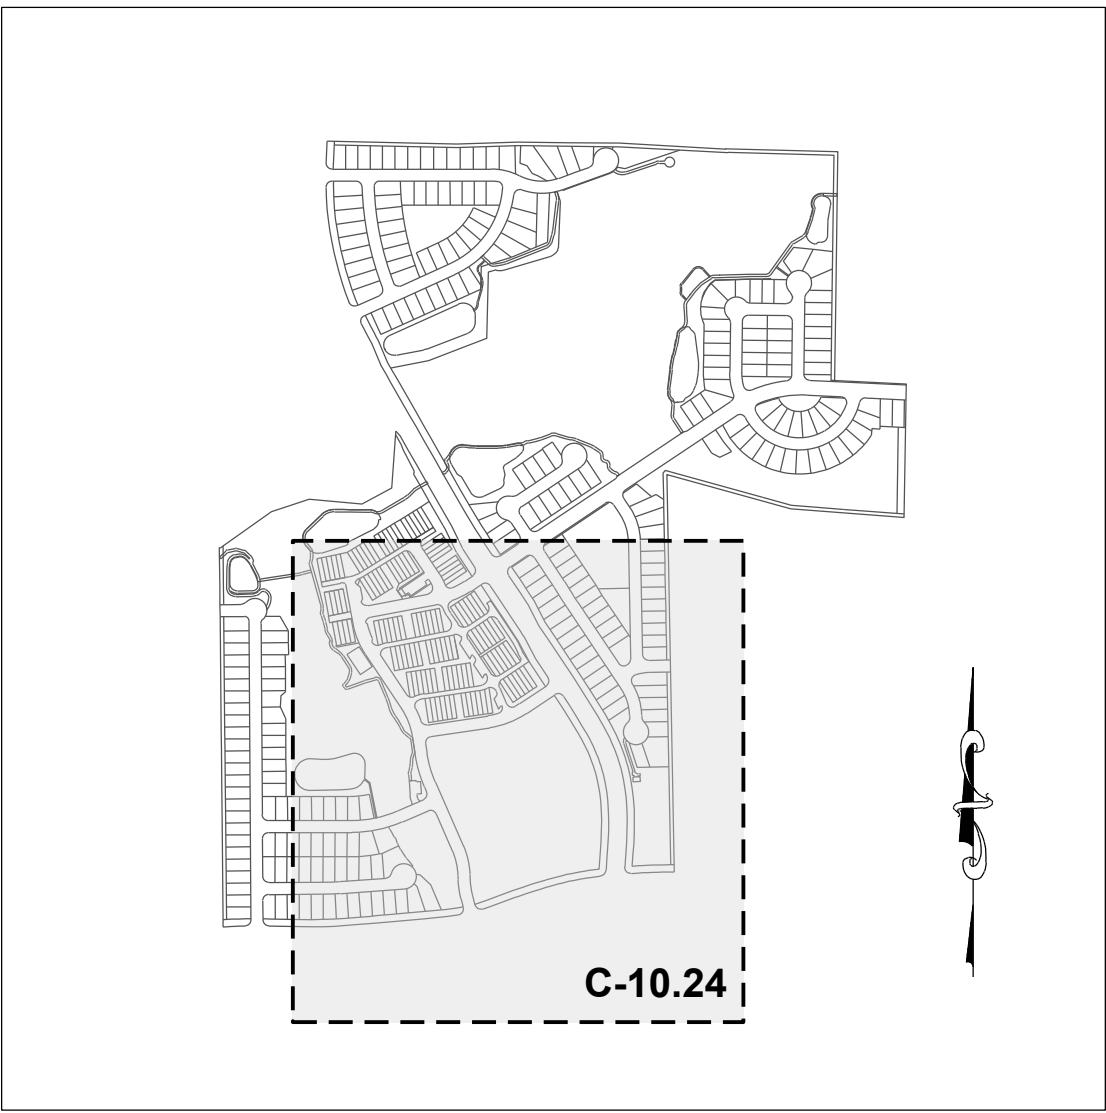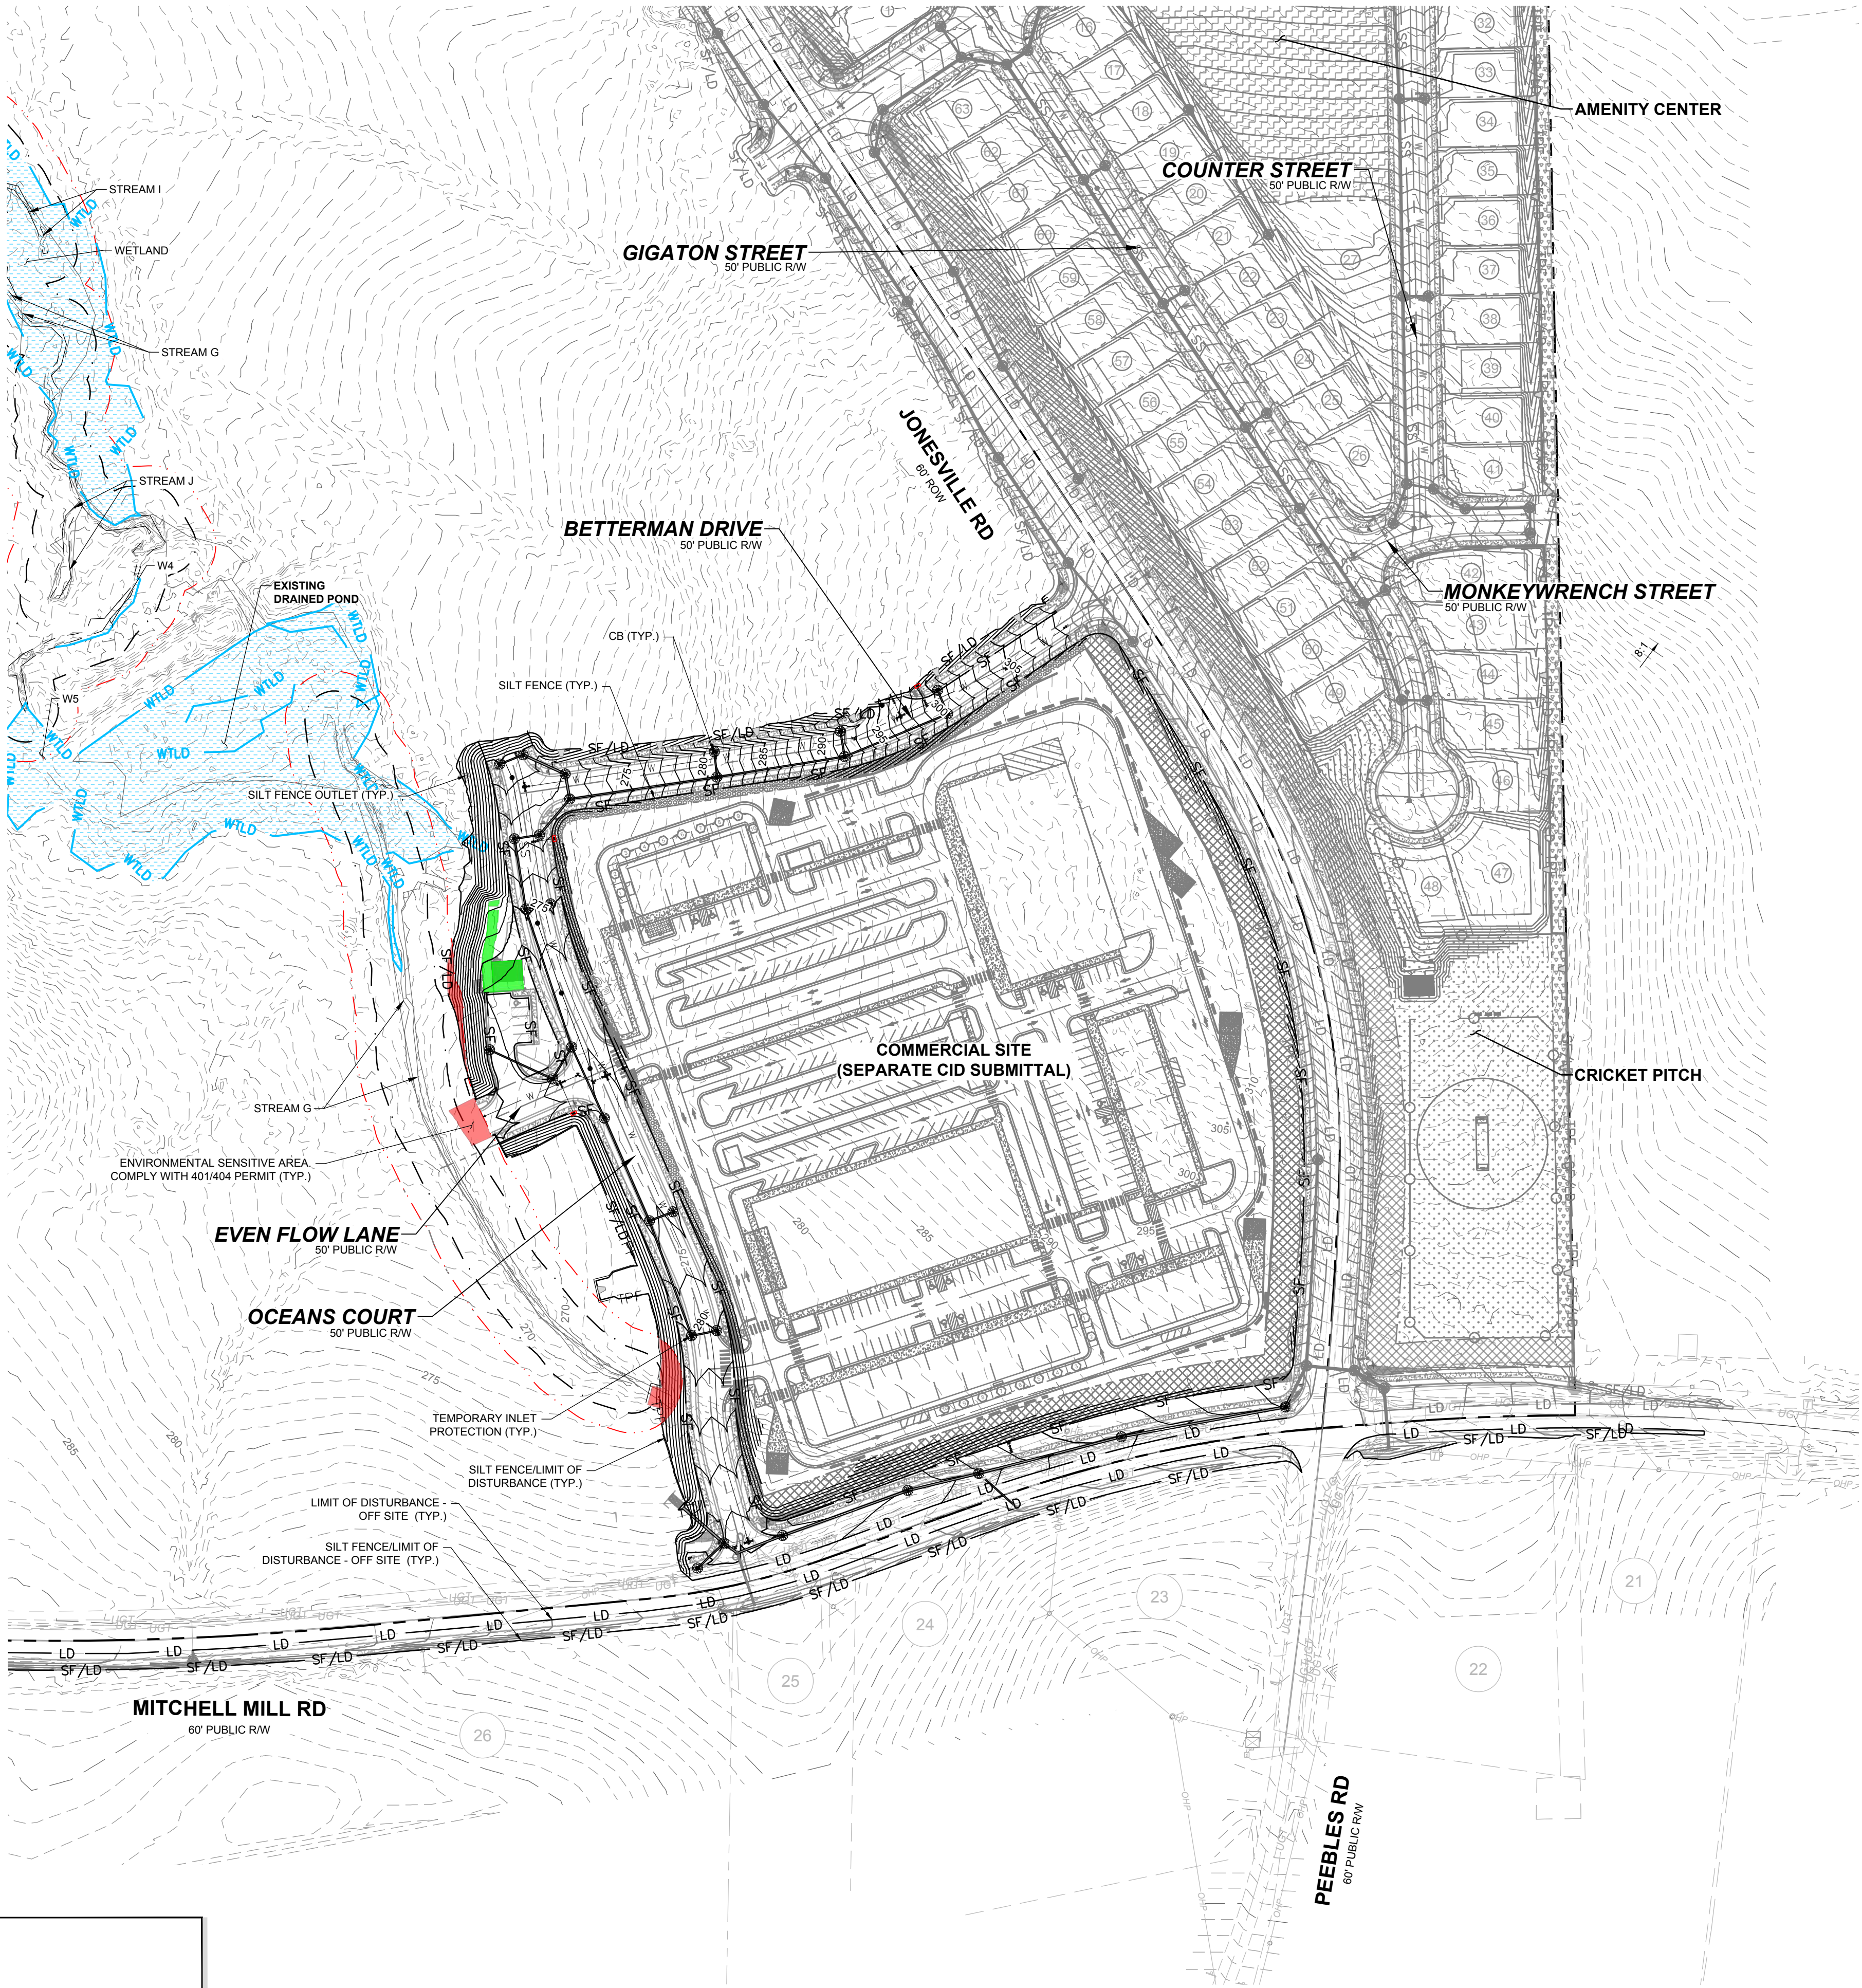

SITE KEY PLAN

LEGEND:	
	EXISTING ADJOINER PROPERTY LINE
	EXISTING EDGE OF PAVEMENT
	EX. MAJOR CONTOURS
	EX. MINOR CONTOURS
	PROP. MAJOR CONTOURS
	PROP. MINOR CONTOURS
	STANDARD CURB & GUTTER
	PROPOSED STORM DRAIN LINE
	PROPOSED LOT LINE
	SILT FENCE/LIMITS OF DISTURBANCE
	LIMITS OF DISTURBANCE
	SILT FENCE
	SANITARY SEWER LINE
	SANITARY MANHOLE
	INLET PROTECTION
	SILT FENCE OUTLET
	DISSIPATOR PAD
	EXISTING WETLAND
	ENVIRONMENTAL SENSITIVE AREA

NOTE:

1. PHASE 4, ACREAGE: 13.58 AC
2. EROSION CONTROL NOTES: SEE SHEET C-10.0
3. ALL LAND-DISTURBING ACTIVITIES MUST BE PLANNED AND CONDUCTED TO LIMIT THE EXPOSED AREA TO 50 ROLLING ACRES.
4. STOCKPILE HEIGHT SHALL NOT EXCEED 35 FEET.
5. PORTIONS OF PHASE 5 MAY BE REQUIRED TO BE INSTALLED TO PROVIDE PHASE 4 WITH SUFFICIENT ACCESS.

CONSTRUCTION INFRASTRUCTURE DRAWINGS		DATE	BY
01	CID-24-04	08/04/2024	SRG
02	TOWN OF ROLESVILLE CID-24-04 V2	11/07/2024	SRG
03	TOWN OF ROLESVILLE CID-24-04 V3	02/07/2024	SRG
04	TOWN OF ROLESVILLE CID-24-04 V4	06/02/2025	SRG
05	TOWN OF ROLESVILLE CID-24-04 V5	08/02/2025	SRG
REVISIONS		DATE	BY
No.			

STRONGROCK

ENGINEERING GROUP

STRONG ROCK ENGINEERING GROUP, PLLC | COMPANY LICENSE # P-2766

305 CHURCH AT NORTH HILLS STREET, SUITE 1110 RALEIGH, NC 27609 | INFORMATION@STRONGROCKGROUP.COM


STRONG ROCK PROJECT	STRONG ROCK PROJECT
PSP-24-03	PSP-24-03
NOT FOR CONSTRUCTION	NOT FOR CONSTRUCTION
SCALE AS SHOWN	SCALE AS SHOWN
DESIGNED BY SRG	DESIGNED BY SRG
DRAWN BY SRG	DRAWN BY SRG
CHECKED BY SRG	CHECKED BY SRG

RESERVE @ MITCHELL MILL
TOWN OF ROLESVILLE, WAKE COUNTY, NORTH CAROLINA
CONSTRUCTION PLANS
EROSION CONTROL PLAN
PHASE 4 - STAGE 3

DRAWING SHEET


C-10.24

83 OF 230

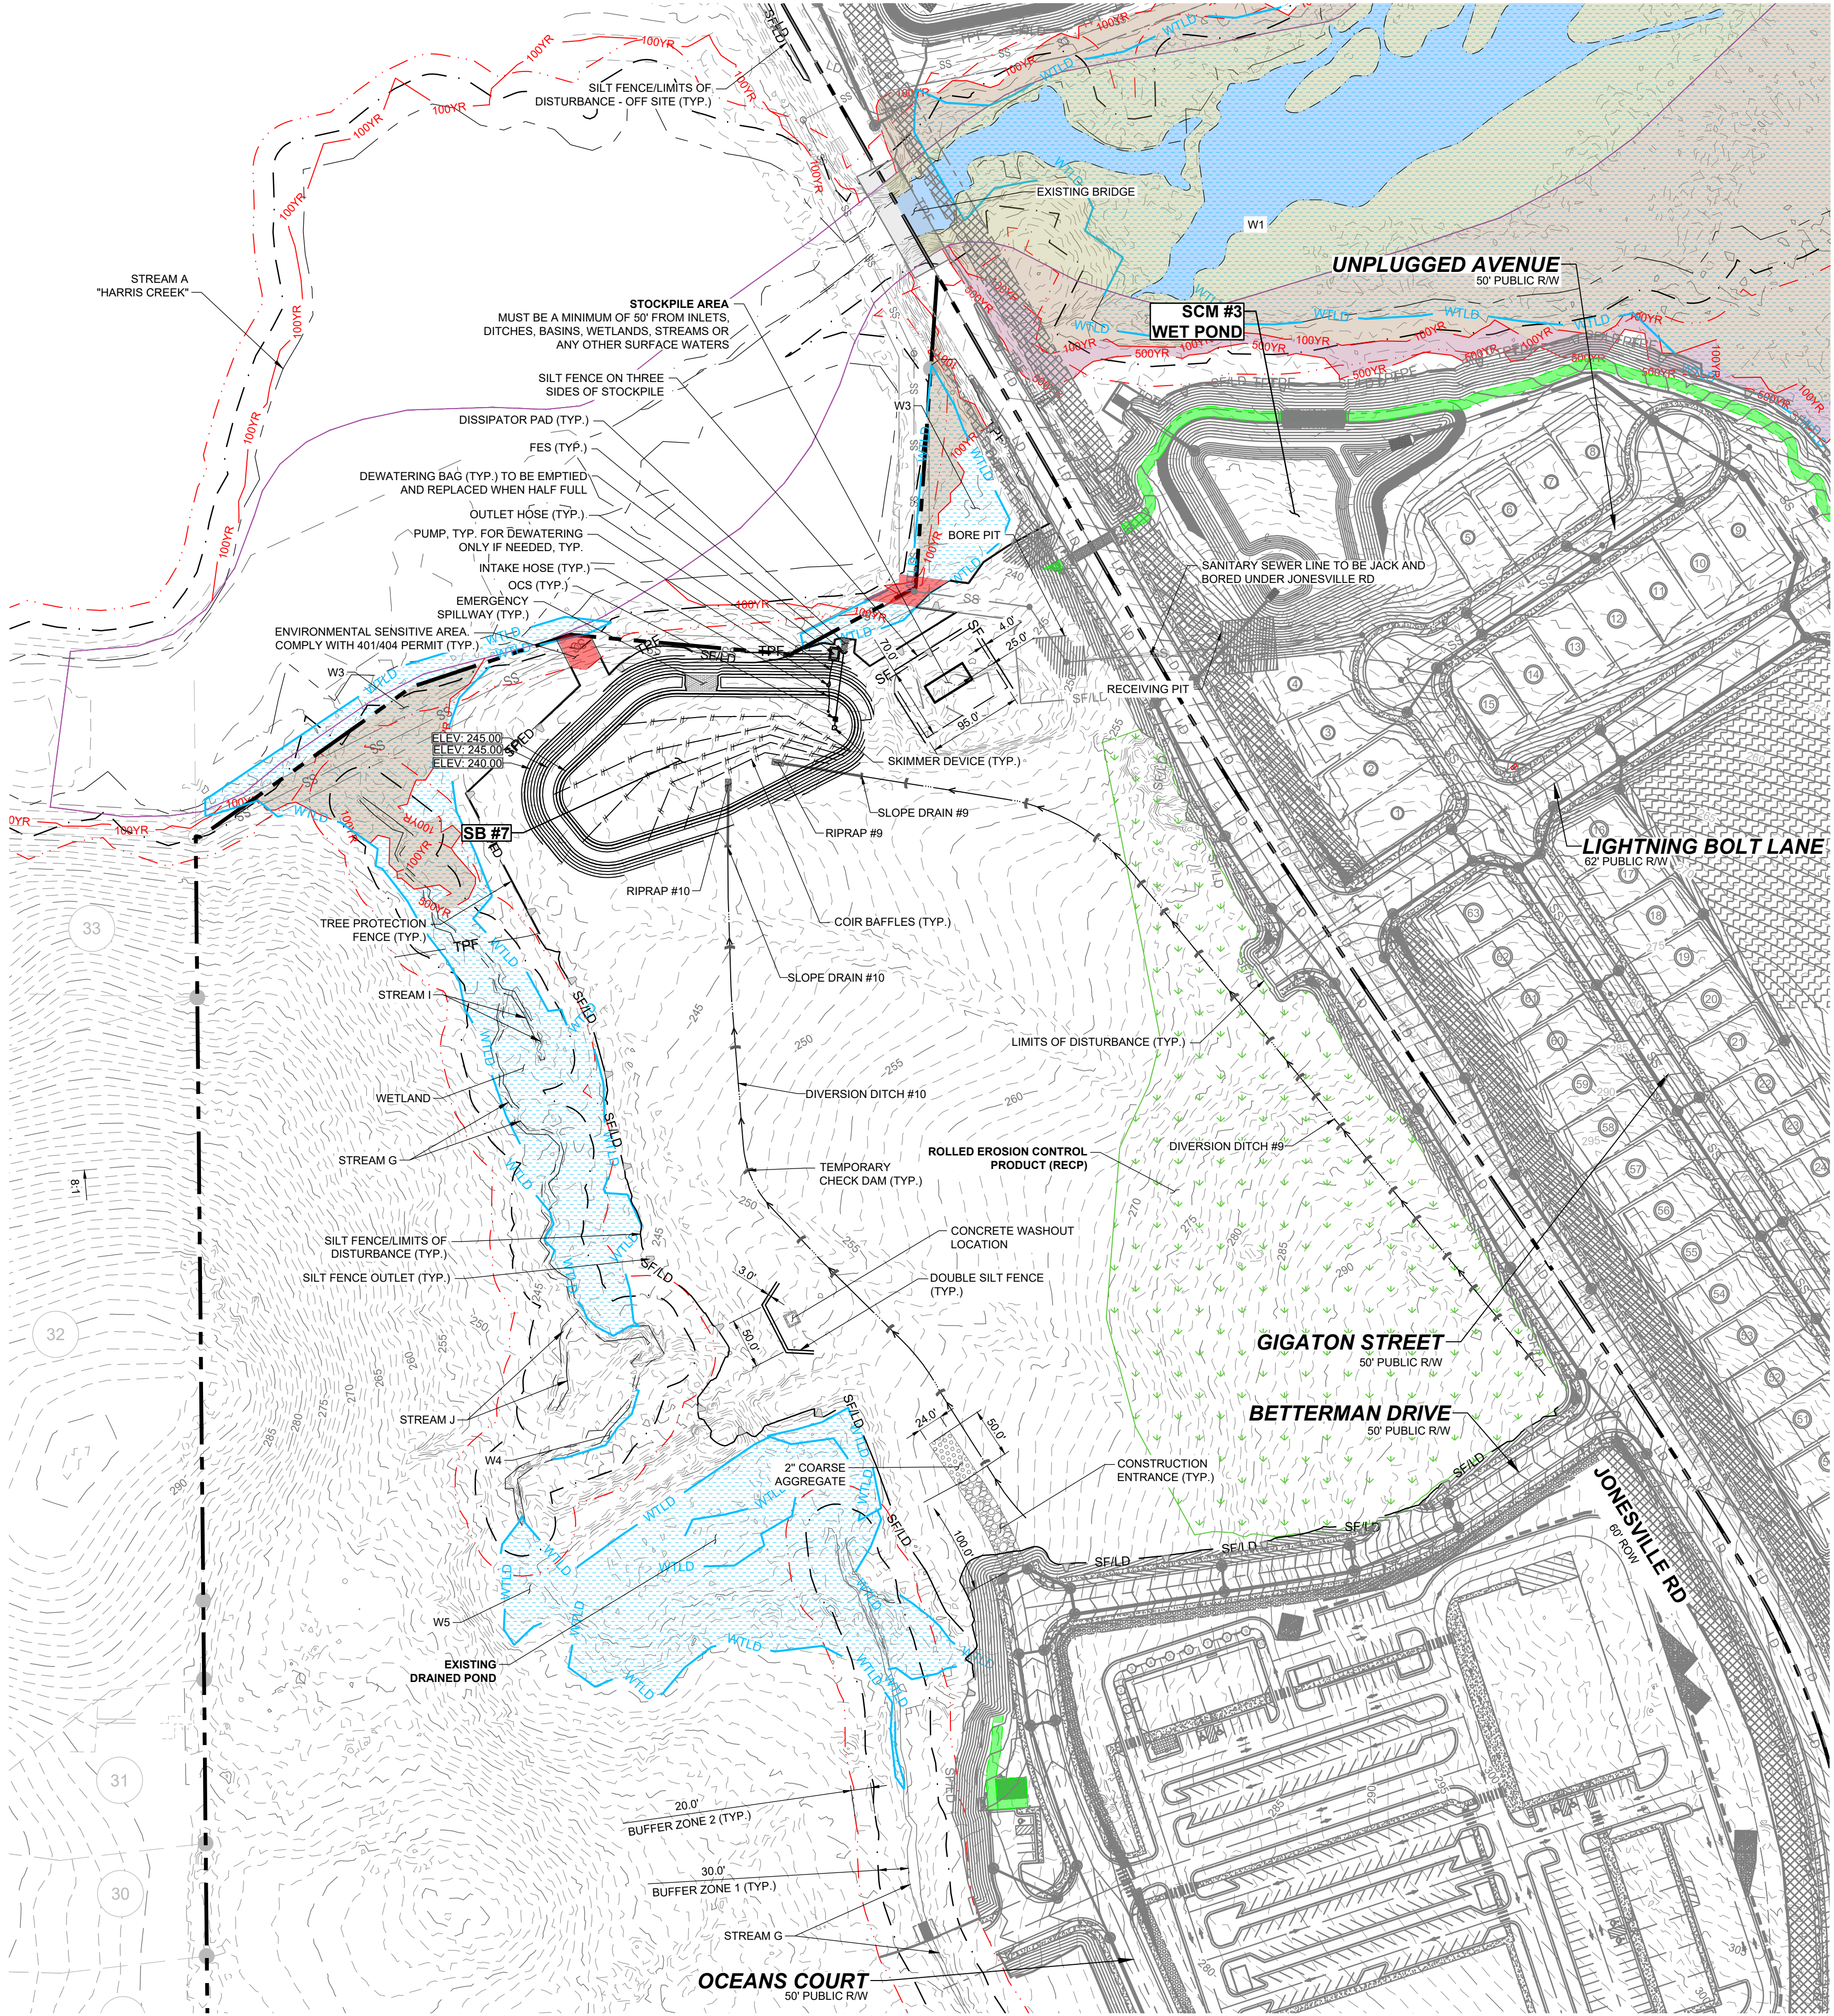

NOTE:


1. PHASE 5, ACREAGE: 14.75 AC
2. EROSION CONTROL NOTES: SEE SHEET C-10.0
3. ALL LAND-DISTURBING ACTIVITIES MUST BE PLANNED AND CONDUCTED TO LIMIT THE EXPOSED AREA TO 50 ROLLING ACRES.
4. STOCKPILE HEIGHT SHALL NOT EXCEED 35 FEET.

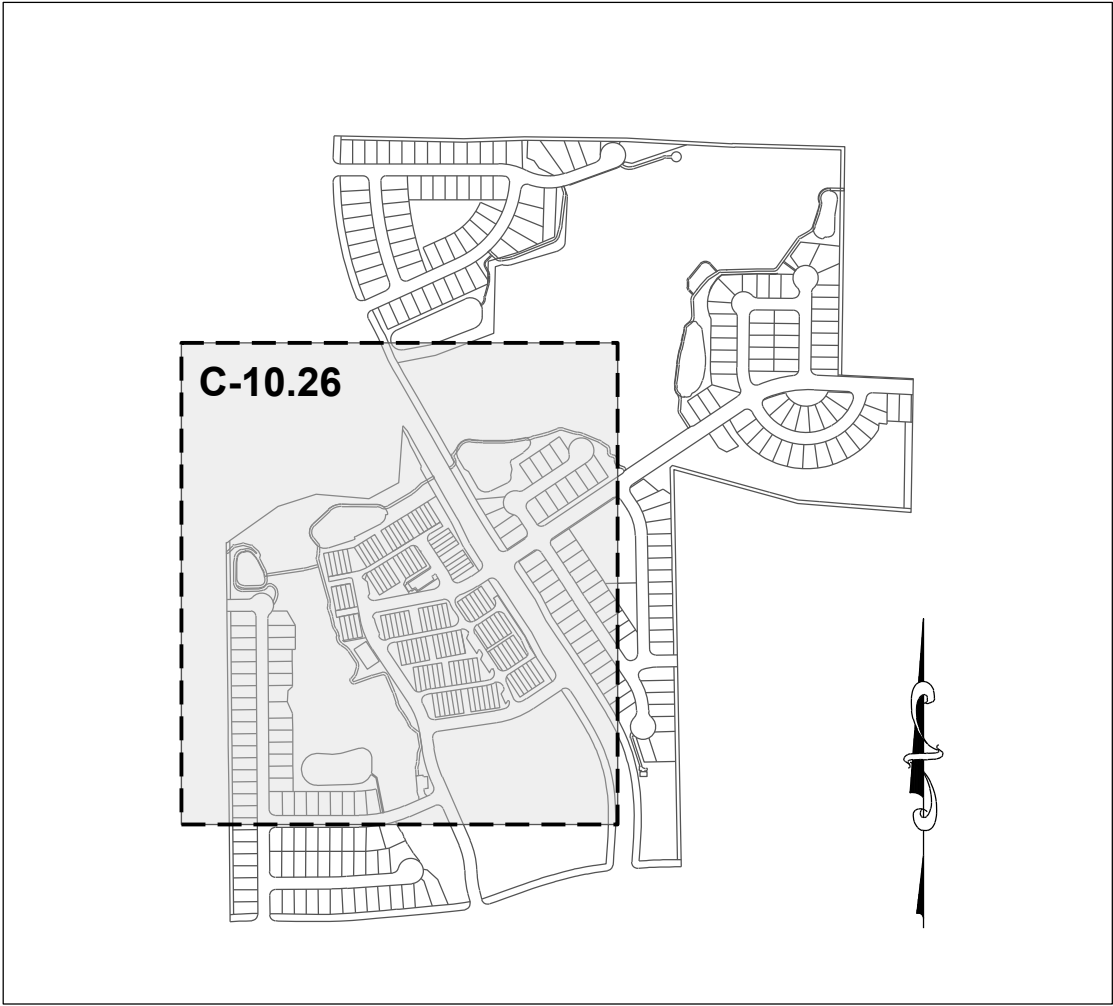

SITE KEY PLAN

LEGEND:

- EXISTING ADJOINER PROPERTY LINE
- EXISTING EDGE OF PAVEMENT
- EX. MAJOR CONTOURS
- EX. MINOR CONTOURS
- SILT FENCE/LIMITS OF DISTURBANCE
- LD
- SF
- TPF
- TEMPORARY DITCH
- BAFFLES
- TEMPORARY SLOPE DRAIN
- TEMPORARY SKIMMER
- SILT FENCE OUTLET
- CHECK DAM
- DISSIPATOR PAD
- CONSTRUCTION ENTRANCE
- EXISTING WETLAND
- ROLLED EROSION CONTROL
- ENVIRONMENTAL SENSITIVE AREA

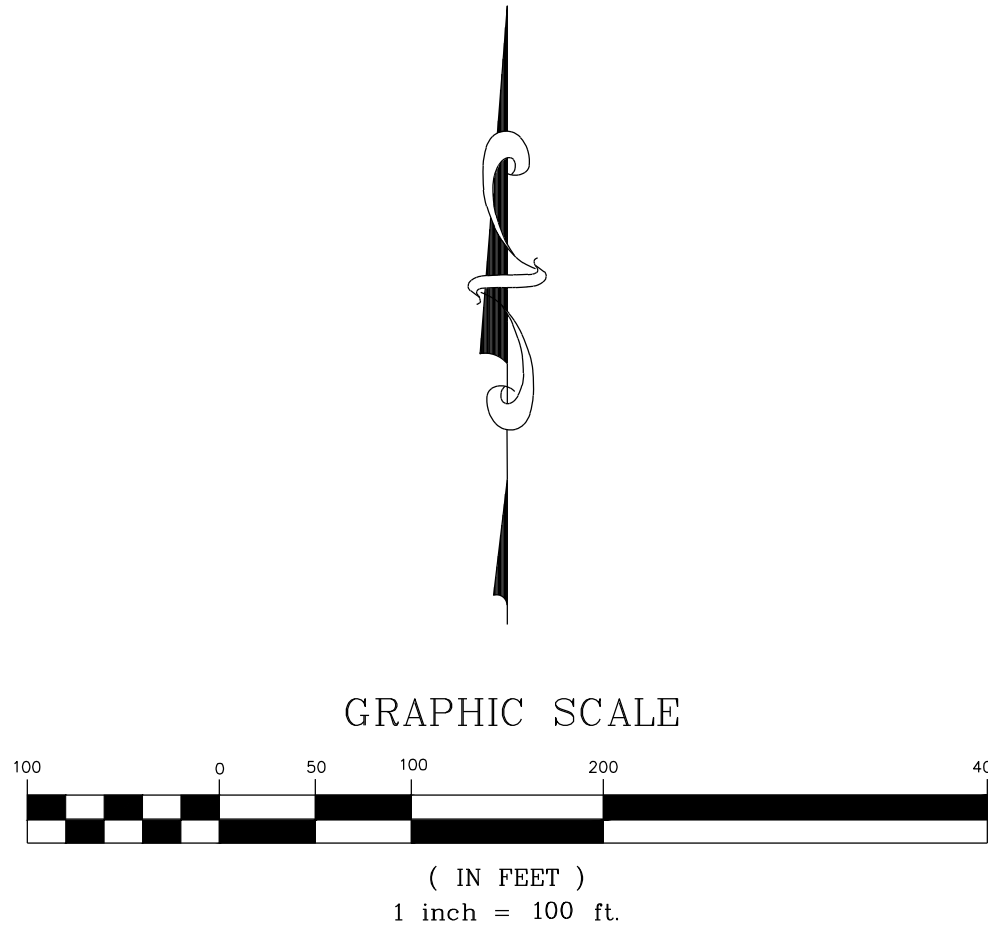

THIS PLANSET AND ANY ASSOCIATED DOCUMENTS ARE PRELIMINARY AND NOT AUTHORIZED FOR CONSTRUCTION UNTIL SIGNED, DATED, AND OFFICIALLY RELEASED FOR CONSTRUCTION BY THE ENGINEER OF RECORD.

CONSTRUCTION INFRASTRUCTURE DRAWINGS		DATE	BY
01	CID-24-04	08/04/2024	SRG
02	TOWN OF ROLESVILLE CID-24-04 V2	11/07/2024	SRG
03	TOWN OF ROLESVILLE CID-24-04 V3	02/07/2024	SRG
04	TOWN OF ROLESVILLE CID-24-04 V4	06/02/2025	SRG
05	TOWN OF ROLESVILLE CID-24-04 V5	08/02/2025	SRG
REVISIONS			
No.			

STRONGROCK

ENGINEERING GROUP

STRONG ROCK ENGINEERING GROUP, PLLC | COMPANY LICENSE # P-2166
305 CHURCH AT NORTH HILLS STREET, SUITE 1110 RALEIGH, NC 27609 | INFORMATION@STRONGROCKGROUP.COM

STRONG ROCK PROJECT	SRG
PSP-24-03	SRG
NOT FOR CONSTRUCTION	SRG
SCALE	AS SHOWN
DESIGNED BY	SRG
DRAWN BY	SRG
CHECKED BY	SRG

RESERVE @ MITCHELL MILL
TOWN OF ROLESVILLE, WAKE COUNTY, NORTH CAROLINA
CONSTRUCTION PLANS
EROSION CONTROL PLAN
PHASE 5 - STAGE 1

DRAWING
SHEET

C-10.26

85 OF 230

ADJOINER INFORMATION			
1	CHARLES E. FERRELL AND WIFE GRETIA LOUISE FERRELL PIN: 1757481951 DB 1813 PG 421 ZONING: R-30 (WC) USE: SF	20	CECIL L. GOODNIGHT AND WIFE, JUDY J. GOODNIGHT PIN: 1757650296 DB 5344 PG 819 ZONING: R-30 (WC) USE: SF
2	ABRAHAM T. BURNHAM AND KYLA L. BURNHAM PIN: 1757481832 DB 19140 PG 734 ZONING: R-30 (WC) USE: SF	21	CECIL L. GOODNIGHT AND WIFE, JUDY J. GOODNIGHT PIN: 1757641415 DB 5344 PG 819 ZONING: R-30 (WC) USE: VA
3	JOE L. GREEN PIN: 1757483799 DB 15-E PG 2691 ZONING: R-30 (WC) USE: SF	22	CHRISTOPHER GHOLSON AND WIFE, KELLY GAITHER GHOLSON PIN: 1757555361 DB 17855 PG 457 LOT 4 - BM 2018 PG 1333 ZONING: R-30 (WC) USE: SF
4	CHARLES ALFONSA JONES AND WIFE ALLIE V. JONES PIN: 1757484609 DB 2305 PG 673 ZONING: R-30 (WC) USE: SF	23	ABAHOR ELIAS AND SPOUSE, SUSAN ELIAS PIN: 1757553215 DB 17220 PG 2609 LOT 3 - BM 2018 PG 1333 ZONING: R-30 (WC) USE: SF
5	BENJAMIN FERRELL PIN: 1757485713 DB 1697 PG 465 ZONING: R-30 (WC) USE: SF	24	TODD KENDALL HONEYCUTT PIN: 1757551202 DB 13474 PG 1974 LOT 2 - BM 2018 PG 1333 ZONING: R-30 (WC) USE: SF
6	ALESIA FERRELL & ARRON WALKER PIN: 1757489733 DB 6374 PG 89 BM 1996 PG 00524 ZONING: R-30 (WC) USE: SF	25	CURTIS L. HONEYCUTT AND WIFE TODD KENDALL PIN: 1757540996 DB 19289 PG 2474 LOT 1 - BM 2018 PG 1333 ZONING: R-30 (WC) USE: SF
7	CHRIST HOLINESS CHURCH #1 PIN: 1757487783 DB 2928 PG 328 ZONING: R-30 (WC) USE: CH	26	PHETIS JONES BRADSHER PIN: 1757349473 DB 15208 PG 2320 BM 2013 PG 868 ZONING: R-30 (WC) USE: FO
8	CHRIST HOLINESS CHURCH #1 PIN: 1757489733 DB 4321 PG 788 ZONING: R-30 (WC) USE: VA	27	PHETIS JONES BRADSHER PIN: 1757349473 DB 15208 PG 2320 ZONING: R-30 (WC) USE: FO
9	CHRIST HOLINESS CHURCH #1 PIN: 1757580764 DB 8467 PG 430 ZONING: R-30 (WC) USE: VA	28	PERR Y. ELWOOD RYAN PIN: 1757585952 DB 19239 PG 2780 ZONING: R-30 (WC) USE: MO
10	ALICIA BROWN & CARL T. JONES PIN: 1757582714 DB 10128 PG 183 ZONING: R-30 (WC) USE: SF	29	TOUTLOFF, KENNETH S. TOUTLOFF, BILLIE ANNE PIN: 1757357764 DB 9236 PG 2229 LOT 3 - BM 1990 PG 956 ZONING: R-30 (WC) USE: SF
11	RS RENTAL II LLC PIN: 1757584724 DB 18703 PG 2414 BM 1981 PG 898 ZONING: R-30 (WC) USE: SF	30	BERNARD MILLER PIN: 1757357865 DB 15416 PG 1651 LOT 4 - BM 1990 PG 956 ZONING: R-30 (WC) USE: SF
12	KAREN E. BASS PIN: 1757585874 DB 12560 PG 1636 BM 1984 PG 943 ZONING: R-30 (WC) USE: SF	31	MARCIE L. HOLDEN PIN: 1757358908 DB 15599 PG 1003 LOT 5 - BM 1990 PG 956 ZONING: R-30 (WC) USE: SF
13	JAMES K. WILLIAMS PIN: 1757585874 DB 16784 PG 1013 BM 1989 PG 01474 ZONING: R-30 (WC) USE: VA	32	MEGAN KULAWIAK PIN: 1757367387 DB 16226 PG 1133 LOT 6 BM 1989 PG 00387 ZONING: R-30 (WC) USE: VA
14	GRO PEG PROPERTIES LLC PIN: 1757684897 DB 18359 PG 1707 LOT 5 - BM 1980 PG 00396 ZONING: R-30 (WC) USE: VA	33	KENNETH INVESTMENT LLC. PIN: 1757368816 DB 19248 PG 1884 ZONING: R-30 (WC) USE: VA
15	SCOTT & THERESA CARLE PIN: 1757679786 DB 14863 PG 2493 LOT 4A - BM 1980 PG 00396 ZONING: R-30 (WC) USE: VA	34	KENNETH INVESTMENT LLC PIN: 1757471559 DB 19248 PG 1884 LOT - BM 2007 PG 01224 ZONING: R-30 (WC) USE: VA
16	GRO PEG PROPERTIES PIN: 1757664956 DB 19081 PG 2786 LOT 2A - BM 1982 PG 00581 ZONING: R-30 (WC) USE: VA	35	HENRY ALSTON PIN: 1757481376 DB 19248 PG 984 BM 1982 PG 721 ZONING: R-30 (WC) USE: SF
17	MT. CALVARY HOLINESS CHURCH OF WAKE CO. INC PIN: 1757660324 DB 10124 PG 2778 LOT 1 - BM 2002 PG 991 ZONING: R-30 (WC) USE: VA	36	UNIVERSAL CHURCH OF PRAYER PIN: 1757388408 DB 19559 PG 1723 LOT - BM 2002 PG 00667 ZONING: R-30 (WC) USE: CH
18	G. ARCHIE UNDERHILL, JR. AND WIFE, TERESSA C. UNDERHILL PIN: 1757653765 DB 8443 PG 2129 BM 1999 PG 1357 ZONING: R-30 (WC) USE: SF	37	ROZELIA J. HARTSFIELD HEIRS PIN: 1757481740 DB 10-E PG 1220 ZONING: R-30 (WC) USE: VA
19	GENADIUS MAC PREDDY AND WIFE, MATTIE F. PREDDY PIN: 1757656586 DB 1882 PG 342 ZONING: R-30 (WC) USE: SF		

NOTE:

- PHASE 5, ACREAGE: 14.75 AC
- EROSION CONTROL NOTES: SEE SHEET C-10.0
- ALL LAND-DISTURBING ACTIVITIES MUST BE PLANNED AND CONDUCTED TO LIMIT THE EXPOSED AREA TO 50 ROLLING ACRES.
- STOCKPILE HEIGHT SHALL NOT EXCEED 35 FEET.



LEGEND:

- EXISTING ADJOINER PROPERTY LINE
- EXISTING EDGE OF PAVEMENT
- EX. MAJOR CONTOURS
- EX. MINOR CONTOURS
- PROP. MAJOR CONTOURS
- PROP. MINOR CONTOURS
- STANDARD CURB & GUTTER
- PROPOSED STORM DRAIN LINE
- PROPOSED LOT LINE
- SILT FENCE/LIMITS OF DISTURBANCE
- LIMITS OF DISTURBANCE
- SILT FENCE
- TREE PROTECTION LINE
- BAFFLES
- TEMPORARY SKIMMER
- SILT FENCE OUTLET
- INLET PROTECTION
- DISSIPATOR PAD
- CONSTRUCTION ENTRANCE
- EXISTING WETLAND
- ENVIRONMENTAL SENSITIVE AREA

STRONGROCK

ENGINEERING GROUP

STRONG ROCK ENGINEERING GROUP, PLLC | COMPANY LICENSE # P-2166
305 CHURCH AT NORTH HILLS STREET, SUITE 1110 RALEIGH, NC 27609 | INFORMATION@STRONGROCKGROUP.COM

STRONG ROCK PROJECT
PSP-24-03

NOT FOR CONSTRUCTION

SCALE AS SHOWN

DESIGNED BY SRG

DRAWN BY SRG

CHECKED BY SRG

RESERVE @ MITCHELL MILL
TOWN OF ROLESVILLE, WAKE COUNTY, NORTH CAROLINA

CONSTRUCTION PLANS

EROSION CONTROL PLAN OVERALL
PHASE 5 - STAGE 2

DRAWING SHEET

C-10.27

86 OF 230

01

02

1038</

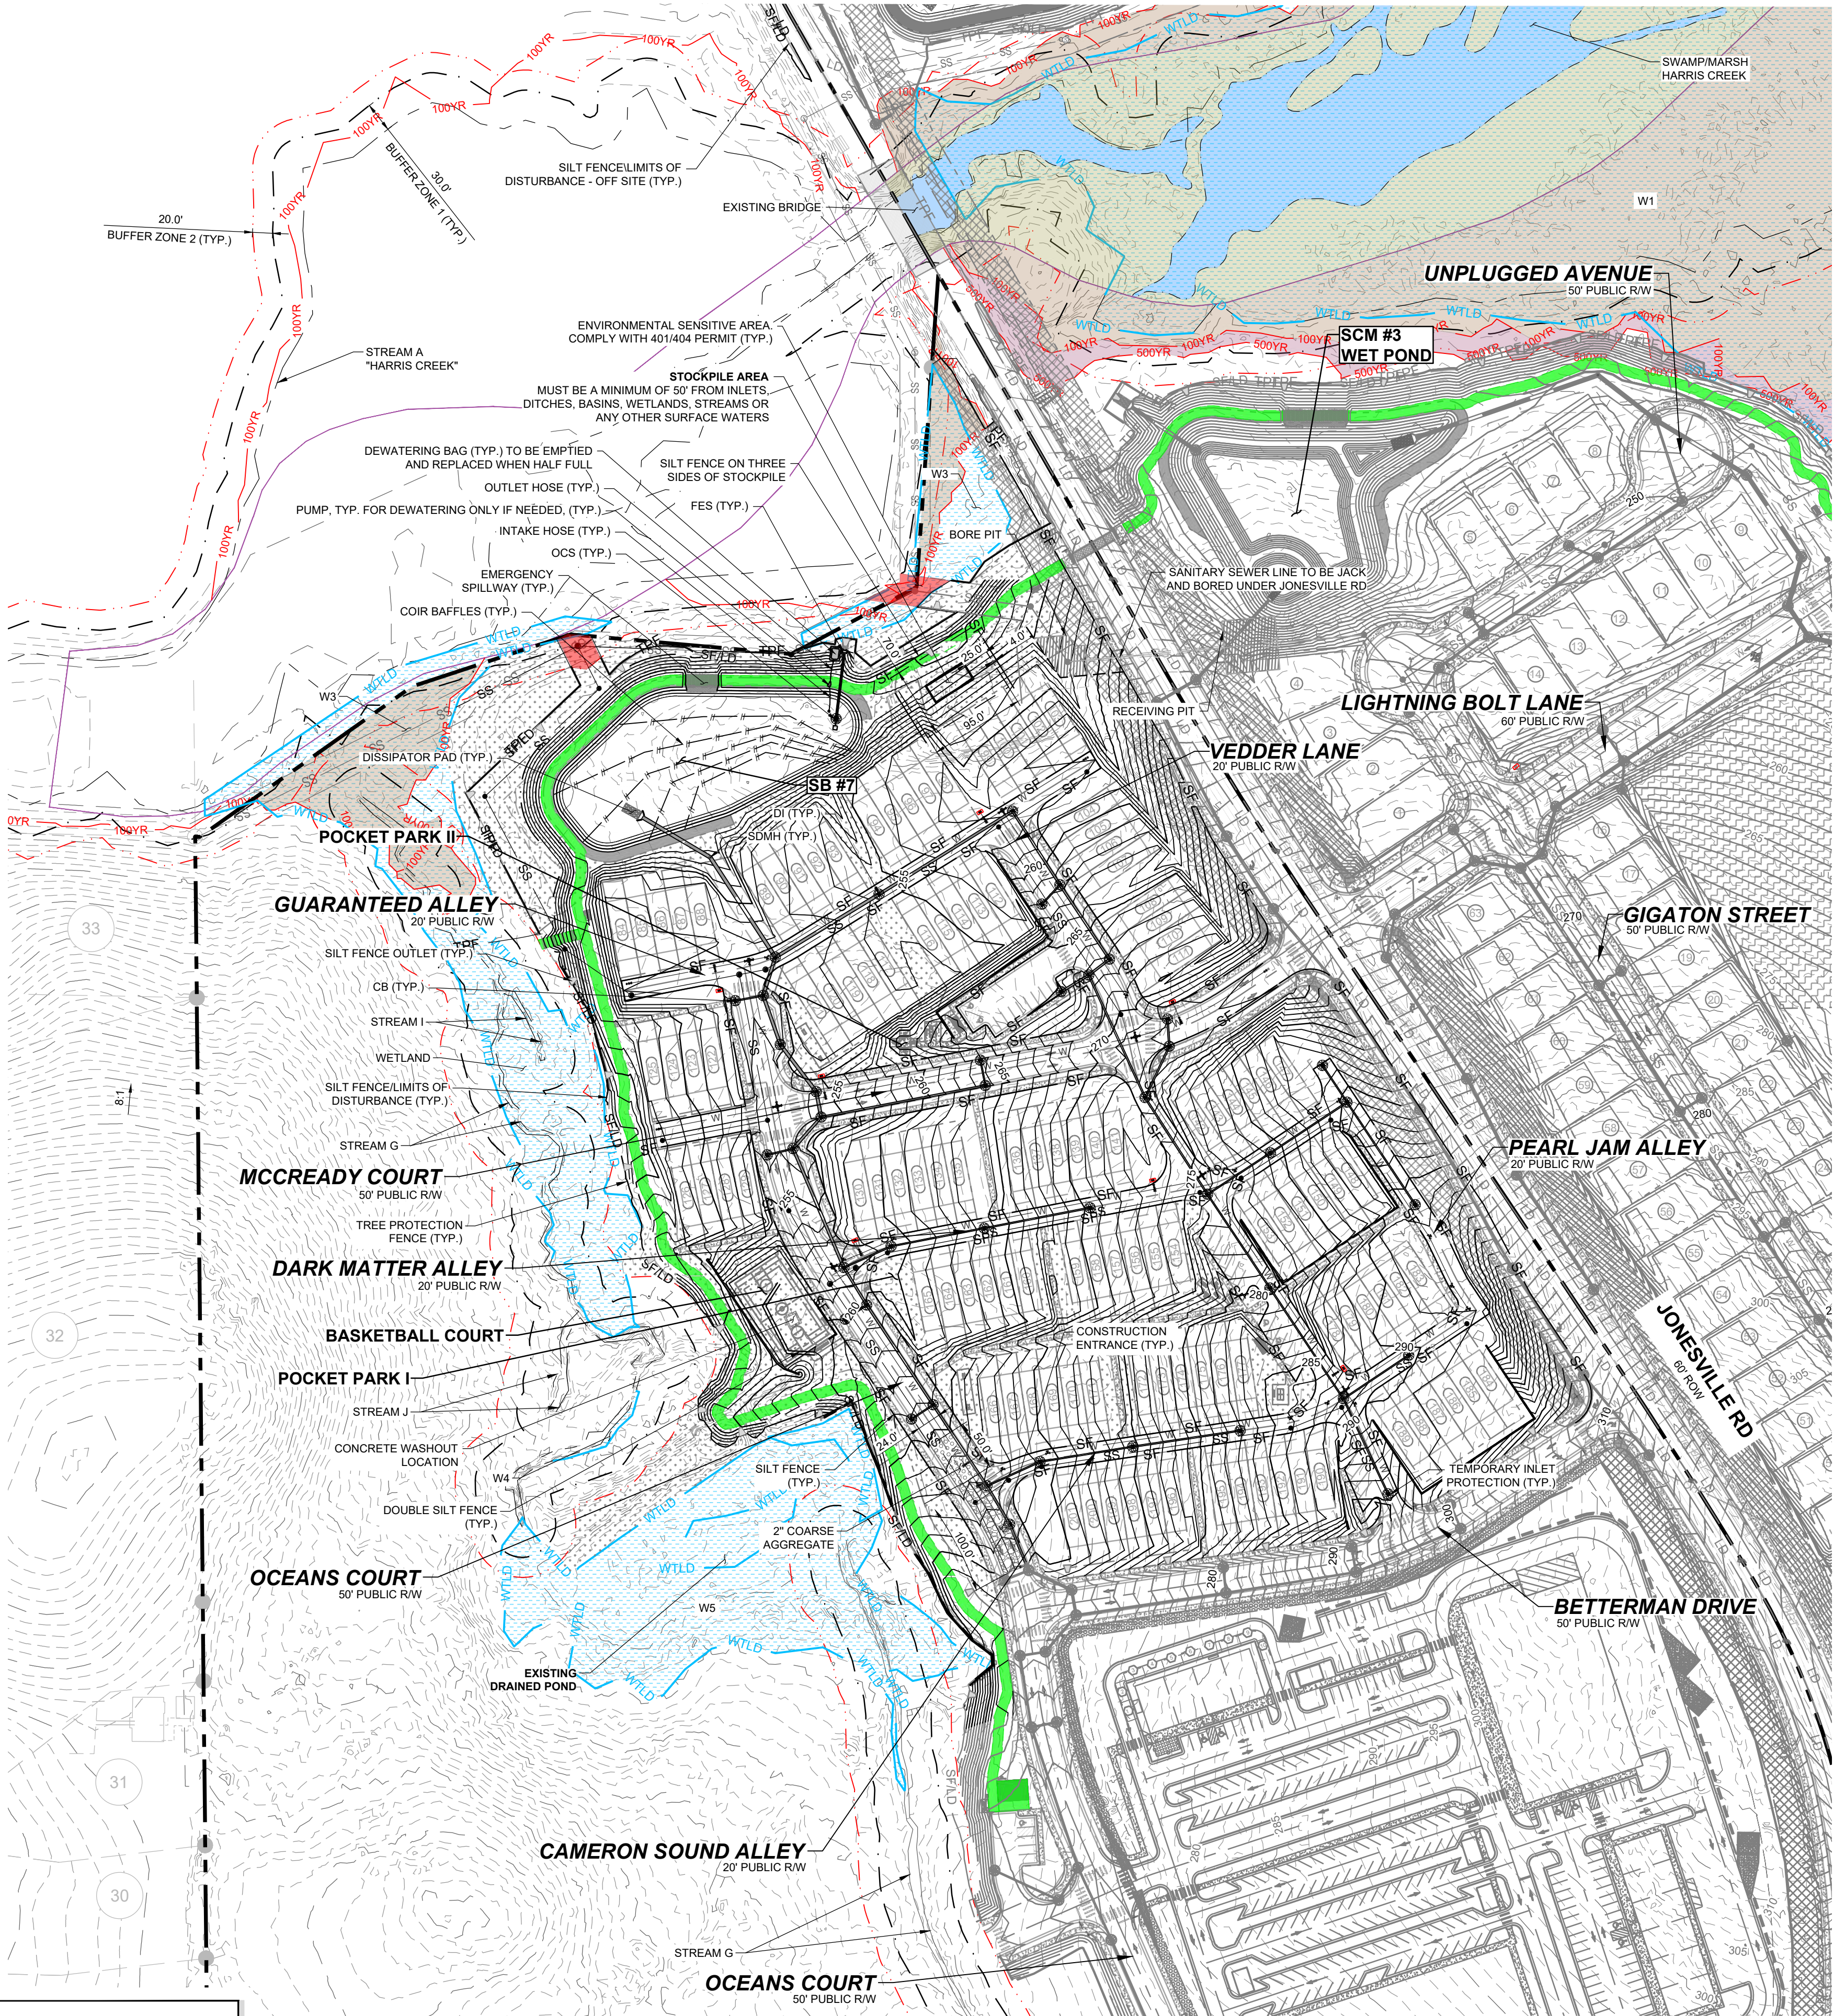


NOTE:

1. PHASE 5, ACREAGE: 14.75 AC
2. EROSION CONTROL NOTES: SEE SHEET C-10.0
3. ALL LAND-DISTURBING ACTIVITIES MUST BE PLANNED AND CONDUCTED TO LIMIT THE EXPOSED AREA TO 50 ROLLING ACRES.
4. STOCKPILE HEIGHT SHALL NOT EXCEED 35 FEET.

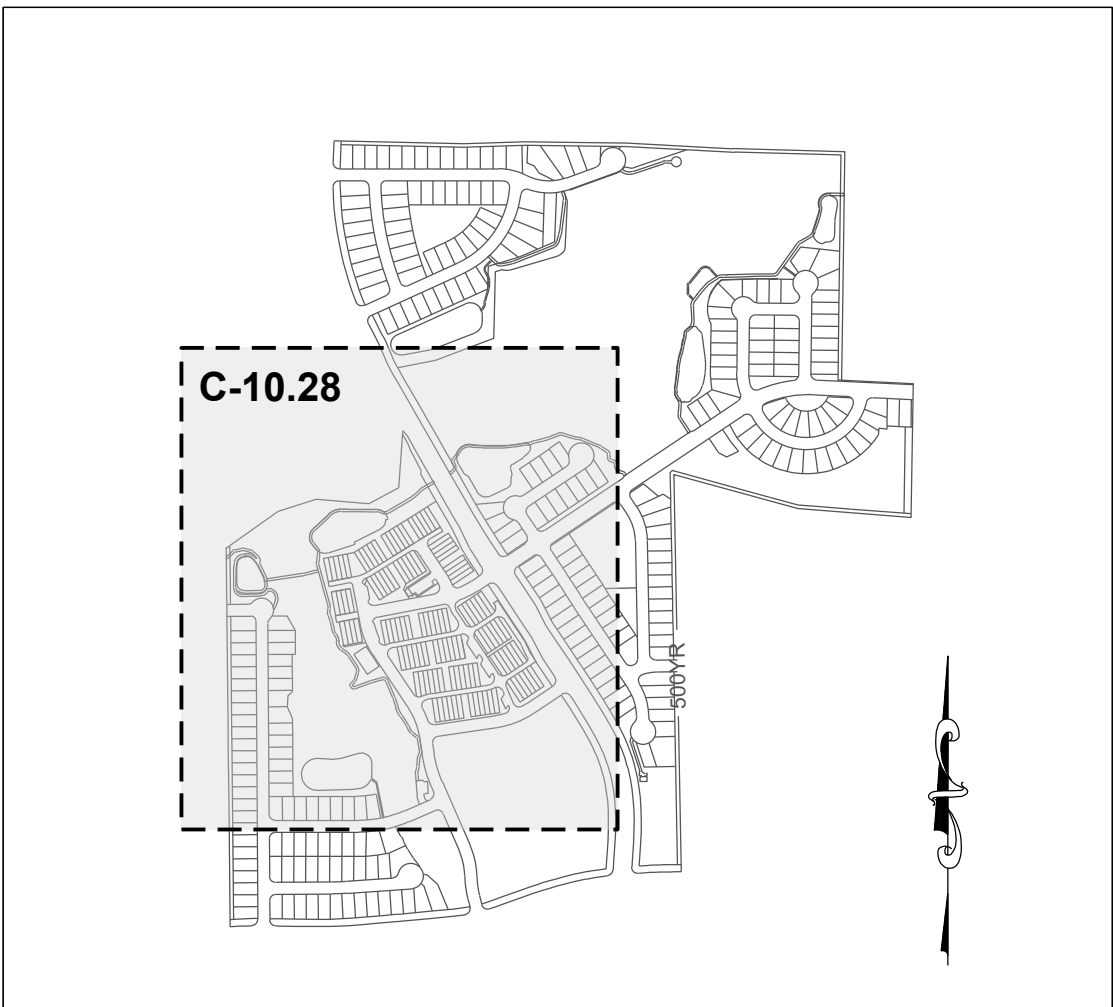

SITE KEY PLAN

LEGEND:	
	EXISTING ADJOINTER PROPERTY LINE
	EXISTING EDGE OF PAVEMENT
	EX. MAJOR CONTOURS
	EX. MINOR CONTOURS
	PROP. MAJOR CONTOURS
	PROP. MINOR CONTOURS
	STANDARD CURB & GUTTER
	PROPOSED STORM DRAIN LINE
	PROPOSED LOT LINE
	SILT FENCE/LIMITS OF DISTURBANCE
	LIMITS OF DISTURBANCE
	SILT FENCE
	TREE PROTECTION LINE
	BAFFLES
	SANITARY SEWER LINE
	SANITARY MANHOLE
	TEMPORARY SKIMMER
	SILT FENCE OUTLET
	INLET PROTECTION
	DISSIPATOR PAD
	CONSTRUCTION ENTRANCE
	EXISTING WETLAND
	ENVIRONMENTAL SENSITIVE AREA

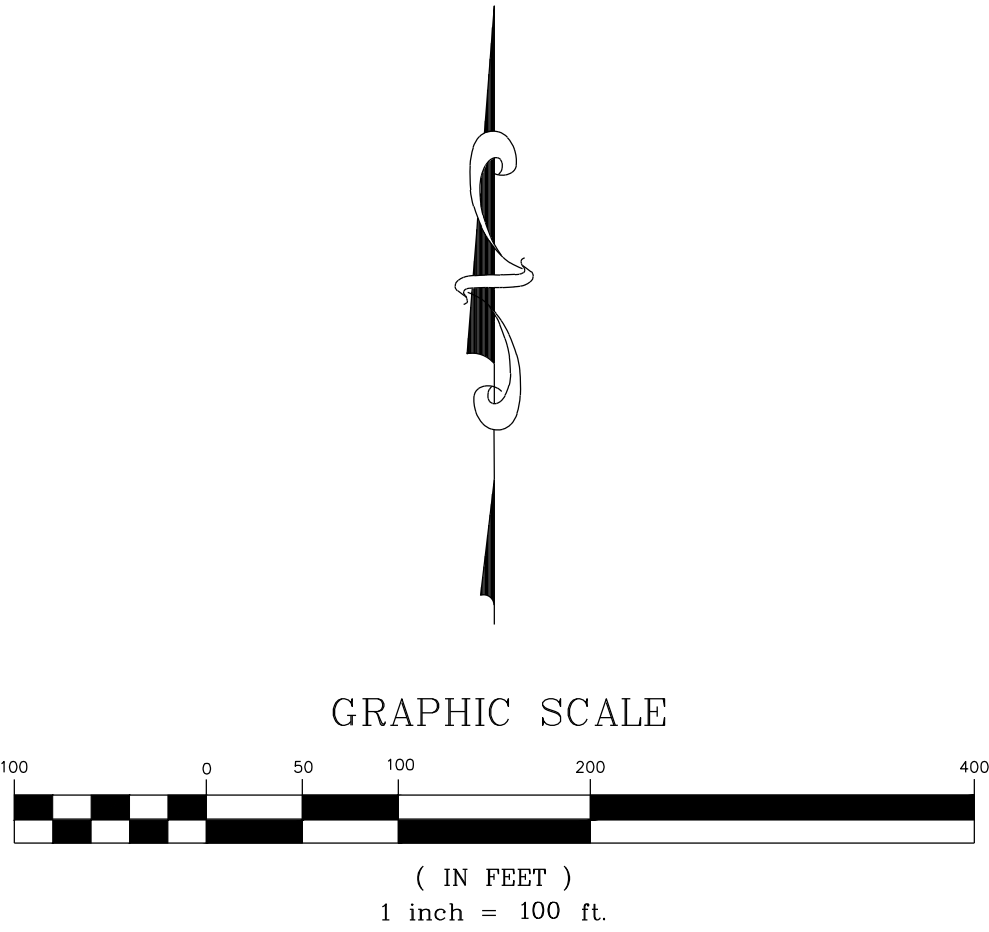

THIS PLANSET AND ANY ASSOCIATED DOCUMENTS ARE PRELIMINARY AND NOT AUTHORIZED FOR CONSTRUCTION UNTIL SIGNED, DATED, AND OFFICIALLY RELEASED FOR CONSTRUCTION BY THE ENGINEER OF RECORD.

CONSTRUCTION INFRASTRUCTURE DRAWINGS		DATE	BY
01	CID-24-04	08/04/2024	SRG
02	TOWN OF ROLESVILLE CID-24-04 V2	11/07/2024	SRG
03	TOWN OF ROLESVILLE CID-24-04 V3	02/07/2024	SRG
04	TOWN OF ROLESVILLE CID-24-04 V4	06/02/2025	SRG
05	TOWN OF ROLESVILLE CID-24-04 V5	08/02/2025	SRG
REVISIONS			
No.			

STRONGROCK

ENGINEERING GROUP


STRONG ROCK ENGINEERING GROUP, PLLC | COMPANY LICENSE # P-2766
305 CHURCH AT NORTH HILLS STREET, SUITE 1110 RALEIGH, NC 27609 | INFORMATION@STRONGROCKGROUP.COM

STRONG ROCK PROJECT	STRONG ROCK PROJECT
PSP-24-03	PSP-24-03
NOT FOR CONSTRUCTION	NOT FOR CONSTRUCTION
SCALE AS SHOWN	SCALE AS SHOWN
DESIGNED BY SRG	DESIGNED BY SRG
DRAWN BY SRG	DRAWN BY SRG
CHECKED BY SRG	CHECKED BY SRG

RESERVE @ MITCHELL MILL
TOWN OF ROLESVILLE, WAKE COUNTY, NORTH CAROLINA
CONSTRUCTION PLANS
EROSION CONTROL PLAN
PHASE 5 - STAGE 2


DRAWING SHEET

C-10.28

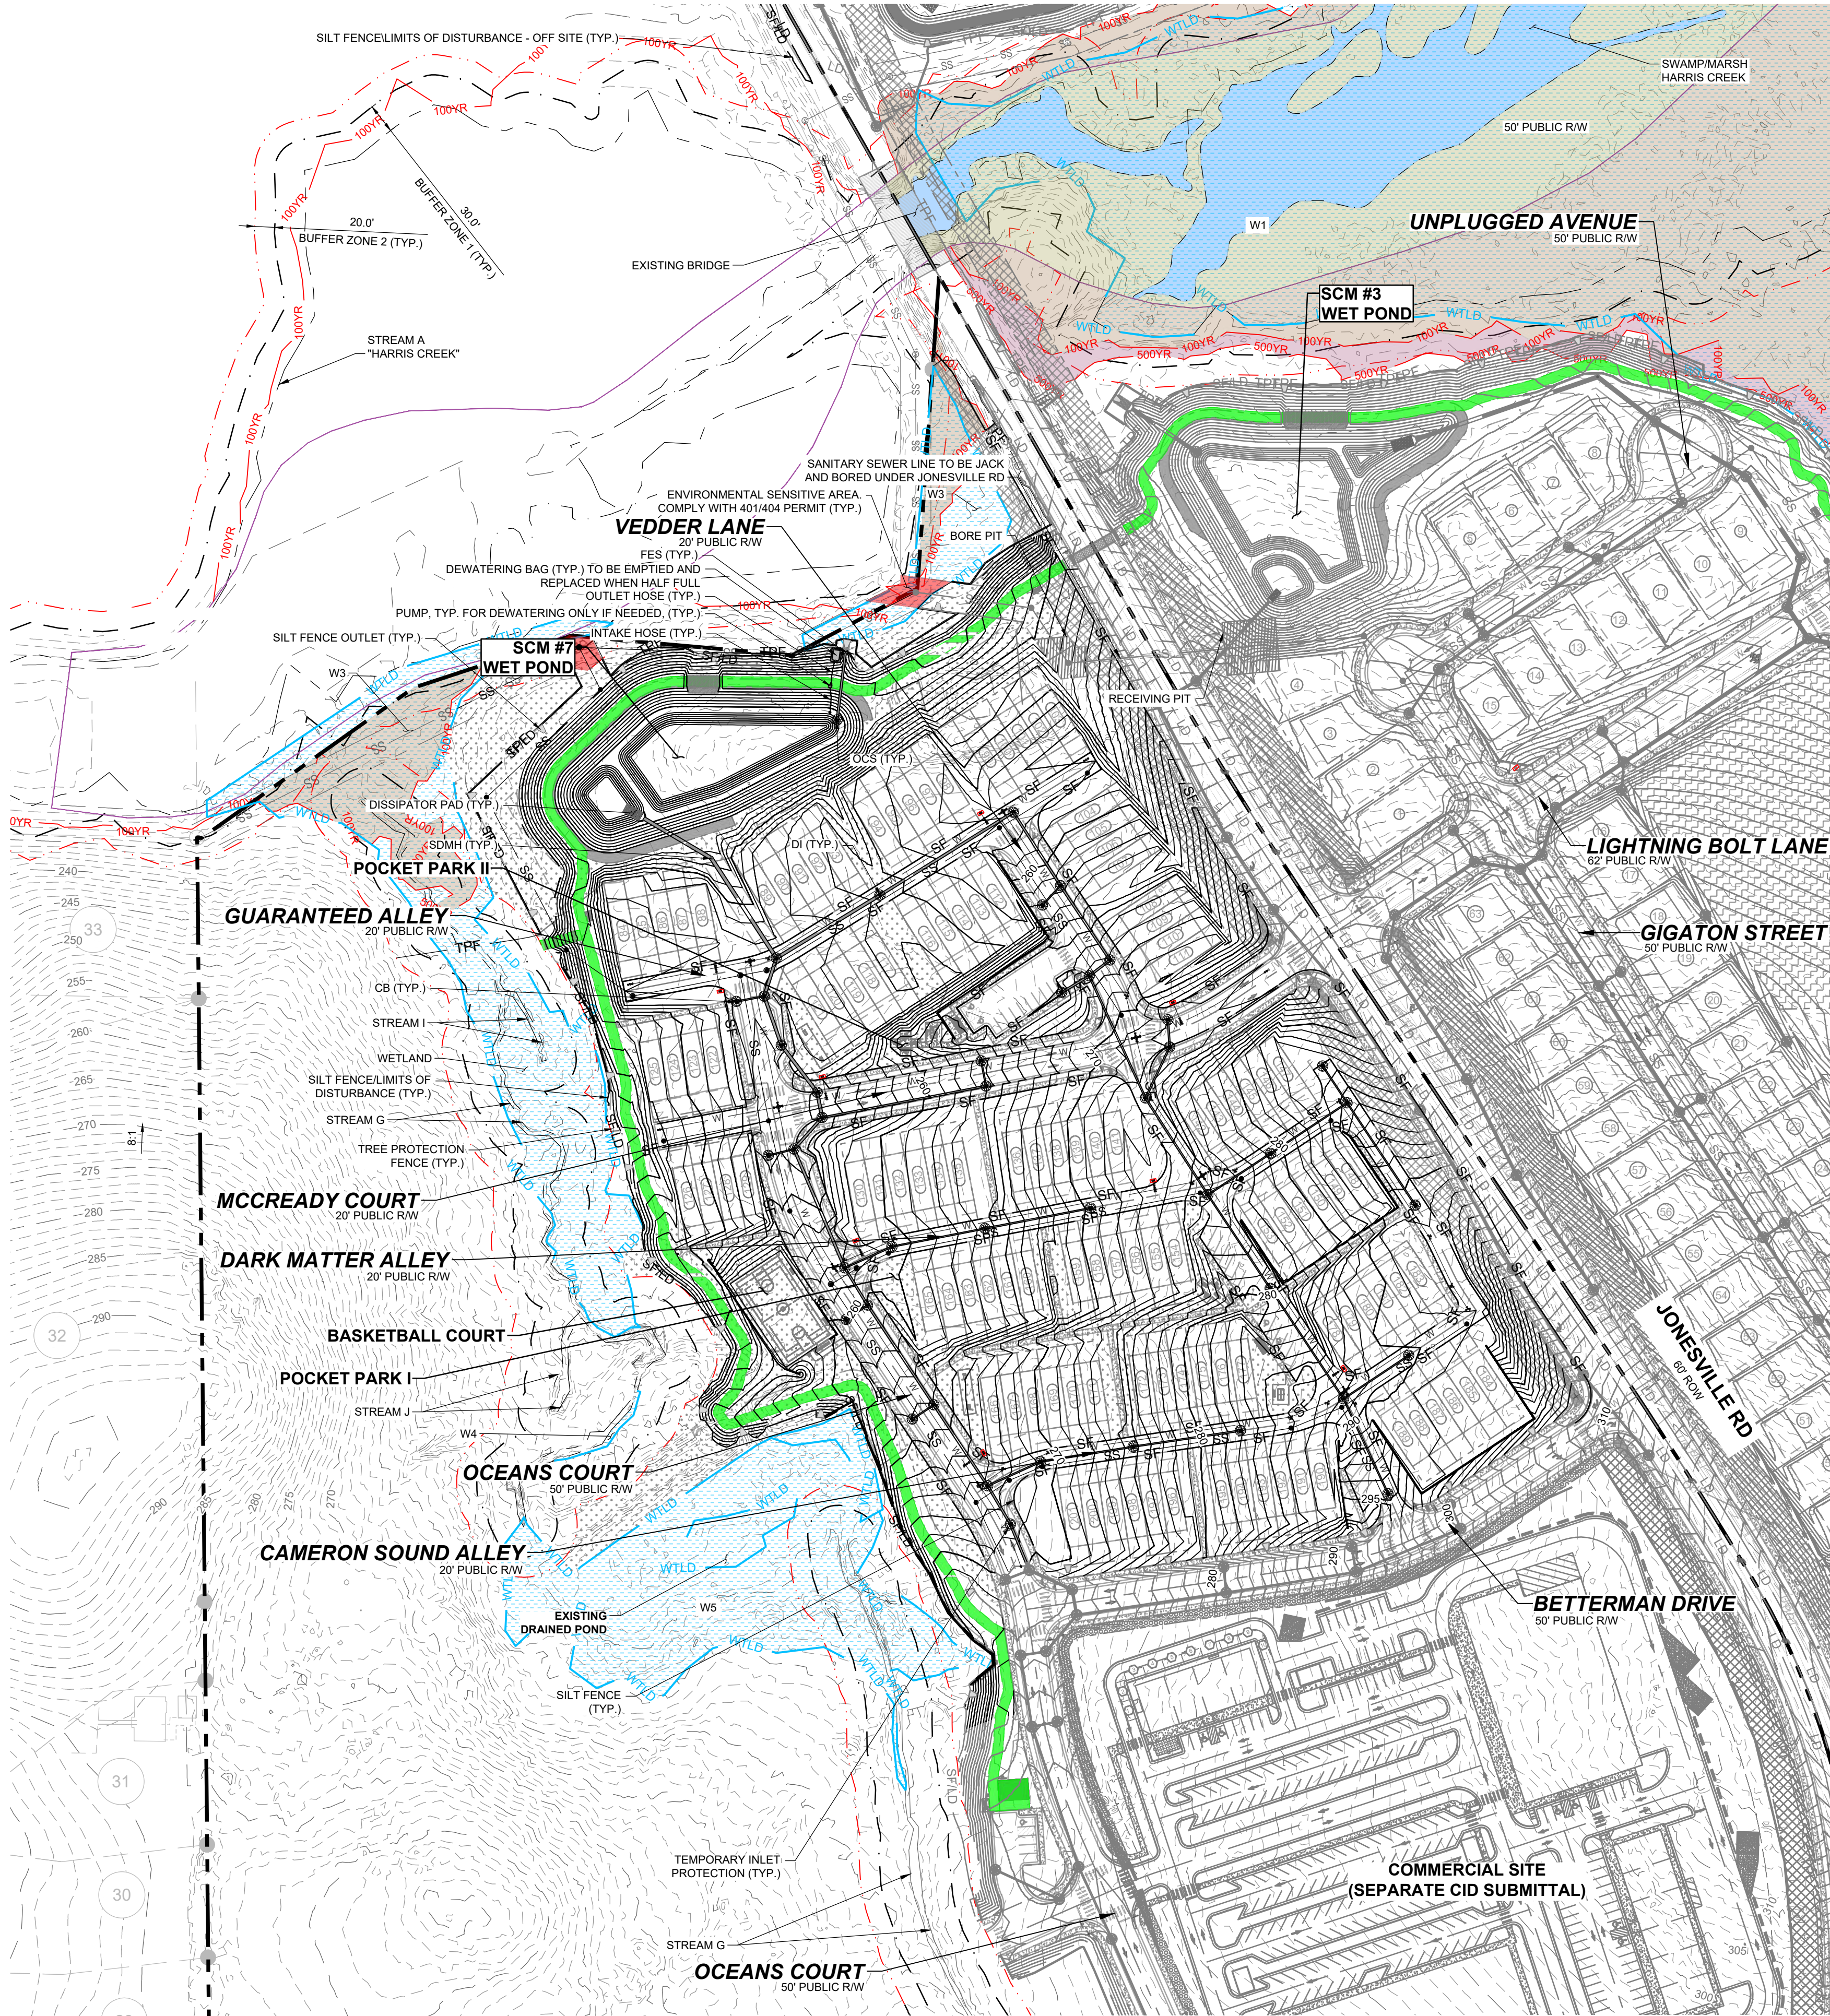

NOTE:


1. PHASE 5, ACREAGE: 14.75 AC
2. EROSION CONTROL NOTES: SEE SHEET C-10.0
3. ALL LAND-DISTURBING ACTIVITIES MUST BE PLANNED AND CONDUCTED TO LIMIT THE EXPOSED AREA TO 50 ROLLING ACRES.
4. STOCKPILE HEIGHT SHALL NOT EXCEED 35 FEET.

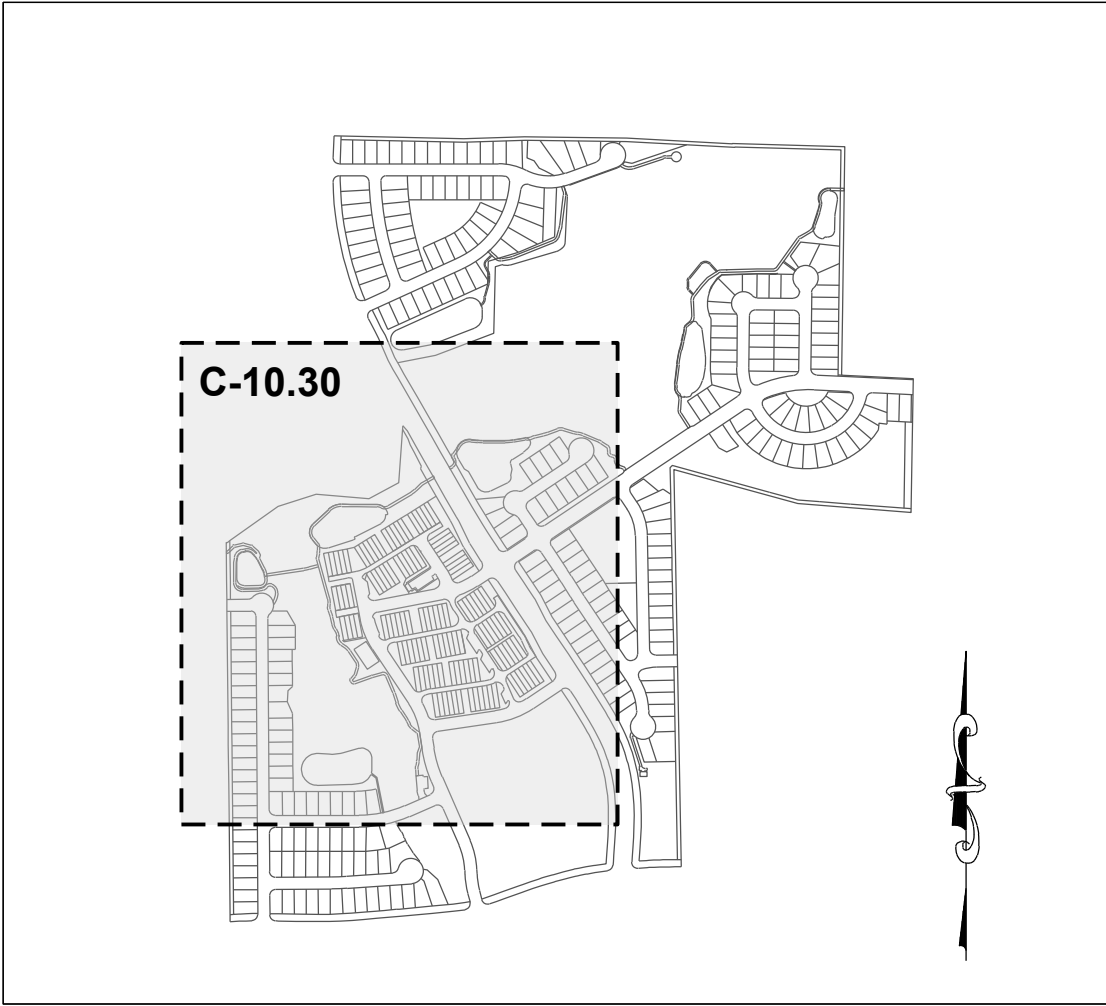

SITE KEY PLAN

LEGEND:

- | | |
|-------|----------------------------------|
| --- | EXISTING ADJOINER PROPERTY LINE |
| --- | EXISTING EDGE OF PAVEMENT |
| --- | EX. MAJOR CONTOURS |
| --- | EX. MINOR CONTOURS |
| --- | PROP. MAJOR CONTOURS |
| --- | PROP. MINOR CONTOURS |
| --- | STANDARD CURB & GUTTER |
| --- | PROPOSED STORM DRAIN LINE |
| --- | PROPOSED LOT LINE |
| SF/LD | SILT FENCE/LIMITS OF DISTURBANCE |
| LD | LIMITS OF DISTURBANCE |
| SF | SILT FENCE |
| SS | SANITARY SEWER LINE |
| ● | SANITARY MANHOLE |
| □ | INLET PROTECTION |
| □ | SILT FENCE OUTLET |
| □ | DISSIPATOR PAD |
| WTLD | EXISTING WETLAND |
| WTLD | ENVIRONMENTAL SENSITIVE AREA |

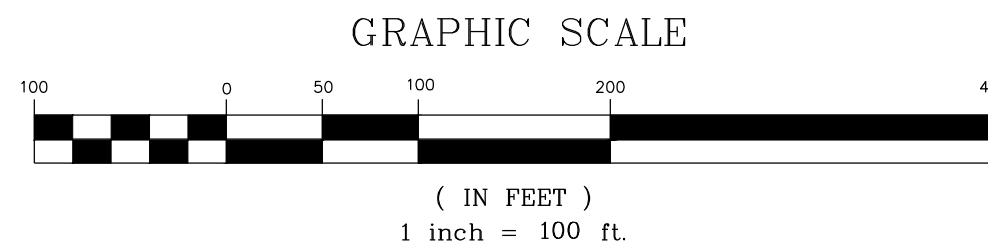

THIS PLANSET AND ANY ASSOCIATED DOCUMENTS ARE PRELIMINARY AND NOT AUTHORIZED FOR CONSTRUCTION UNTIL SIGNED, DATED, AND OFFICIALLY RELEASED FOR CONSTRUCTION BY THE ENGINEER OF RECORD.

CONSTRUCTION INFRASTRUCTURE DRAWINGS		REVISIONS		DATE	BY
01	02	03	04	05	No.
08/04/2024	11/07/2024	02/07/2025	08/02/2025		
CD-24-04	CD-24-04 V2	CD-24-04 V3	CD-24-04 V4	CD-24-04 V5	
SRG	SRG	SRG	SRG	SRG	

STRONGROCK

ENGINEERING GROUP

STRONG ROCK ENGINEERING GROUP, PLLC | COMPANY LICENSE # P-2766
305 CHURCH AT NORTH HILLS STREET, SUITE 1110 RALEIGH, NC 27609 | INFORMATION@STRONGROCKGROUP.COM

STRONG ROCK PROJECT	NOT FOR CONSTRUCTION	SCALE	SRG	SRG	SRG
PSP-24-03	AS SHOWN	DESIGNED BY	DRAWN BY	CHECKED BY	

RESERVE @ MITCHELL MILL
TOWN OF ROLESVILLE, WAKE COUNTY, NORTH CAROLINA
CONSTRUCTION PLANS
EROSION CONTROL PLAN
PHASE 5 - STAGE 3



DRAWING SHEET

C-10.30

89 OF 230

NOTE:

1. PHASE 6, ACREAGE: 18.19 AC
2. EROSION CONTROL NOTES: SEE SHEET C-10.0
3. ALL LAND-DISTURBING ACTIVITIES MUST BE PLANNED AND CONDUCTED TO LIMIT THE EXPOSED AREA TO 50 ROLLING ACRES.
4. STOCKPILE HEIGHT SHALL NOT EXCEED 35 FEET.

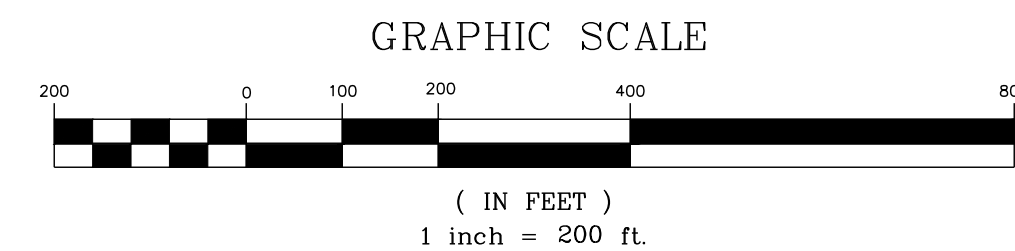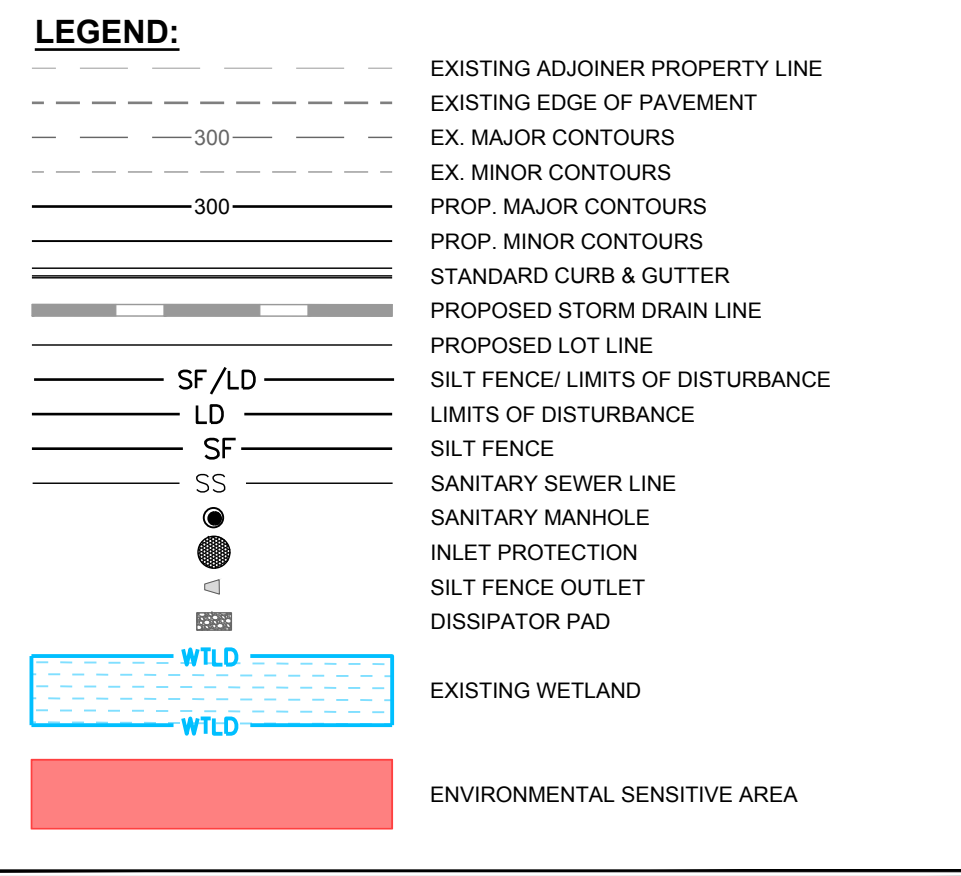

STRONGROCK
ENGINEERING GROUP

STRONG ROCK ENGINEERING GROUP, PLLC | COMPANY LICENSE # P-2186
305 CHURCH AT NORTH HILLS STREET, SUITE 1110 RALEIGH, NC 27609 | INFORMATION@STRONGROCKGROUP.COM

RESERVE @ MITCHELL MILL
TOWN OF ROLESVILLE, WAKE COUNTY, NORTH CAROLINA

CONSTRUCTION PLANS

EROSION CONTROL PLAN OVERALL
PHASE 6 - STAGE 2

92 OF 230

LEGEND:	EXISTING ADJOINER PROPERTY LINE
_____	EXISTING EDGE OF PAVEMENT
_____ 300 _____	EX. MAJOR CONTOURS
_____ 300 _____	EX. MINOR CONTOURS
=====	PROP. MAJOR CONTOURS
=====	PROP. MINOR CONTOURS
=====	STANDARD CURB & GUTTER
=====	PROPOSED STORM DRAIN LINE
=====	PROPOSED LOT LINE
SF /LD _____	SILT FENCE/ LIMITS OF DISTURBANCE
LD _____	LIMITS OF DISTURBANCE
SF _____	SILT FENCE
SS _____	SANITARY SEWER LINE
●	SANITARY MANHOLE
●	INLET PROTECTION
◁	SILT FENCE OUTLET
SS	DISSIPATOR PAD
WTLD	EXISTING WETLAND
WTLD	
	ENVIRONMENTAL SENSITIVE AREA

GRAPHIC SCALE

(IN FEET)
1 inch = 100 ft.

01	CONSTRUCTION INFRASTRUCTURE DRAWINGS CID-24-04	06/04/2024	SREG
02	TOWN OF ROLESVILLE CID-24-04 V2	11/01/2024	SREG
03	TOWN OF ROLESVILLE CID-24-04 V3	02/01/2024	SREG
04	TOWN OF ROLESVILLE CID-24-04 V4	06/02/2024	SREG
05	TOWN OF ROLESVILLE CID-24-04 V5	08/02/2025	SREG
No.	REVISIONS	DATE	BY

STRONG
**ROCK**
E N G I N E E R I N G G R O U P
STRONG ROCK ENGINEERING GROUP, PLLC | COMPANY LICENSE # P-2166
305 CHURCH AT NORTH HILLS STREET, SUITE 1110 RALEIGH, NC 27603 | INFORMATION@STRONGROCKGROUP.COM

STRONG ROCK PROJECT PSP-23-03	NOT FOR CONSTRUCTION	SCALE	AS SHOWN	DESIGNED BY	SRG	DRAWN BY	SRG	CHECKED BY	SRG
----------------------------------	-------------------------	-------	----------	-------------	-----	----------	-----	------------	-----

RESERVE @ MITCHELL MILL
TOWN OF ROLESVILLE, WAKE COUNTY, NORTH CAROLINA

CONSTRUCTION PLANS

EROSION CONTROL PLAN
PHASE 6 - STAGE 2


C-10.34

93 OF 230

1. PHASE 6, ACREAGE: 18.19 AC
2. EROSION CONTROL NOTES: SEE SHEET C-10.0
3. ALL LAND-DISTURBING ACTIVITIES MUST BE PLANNED AND CONDUCTED TO LIMIT THE EXPOSED AREA TO 50 ROLLING ACRES.
4. STOCKPILE HEIGHT SHALL NOT EXCEED 35 FEET.




- NOTE:**
1. PHASE 6, ACREAGE: 18.19 AC
 2. EROSION CONTROL NOTES: SEE SHEET C-10.0
 3. ALL LAND-DISTURBING ACTIVITIES MUST BE PLANNED AND CONDUCTED TO LIMIT THE EXPOSED AREA TO 50 ROLLING ACRES.
 4. STOCKPILE HEIGHT SHALL NOT EXCEED 35 FEET.

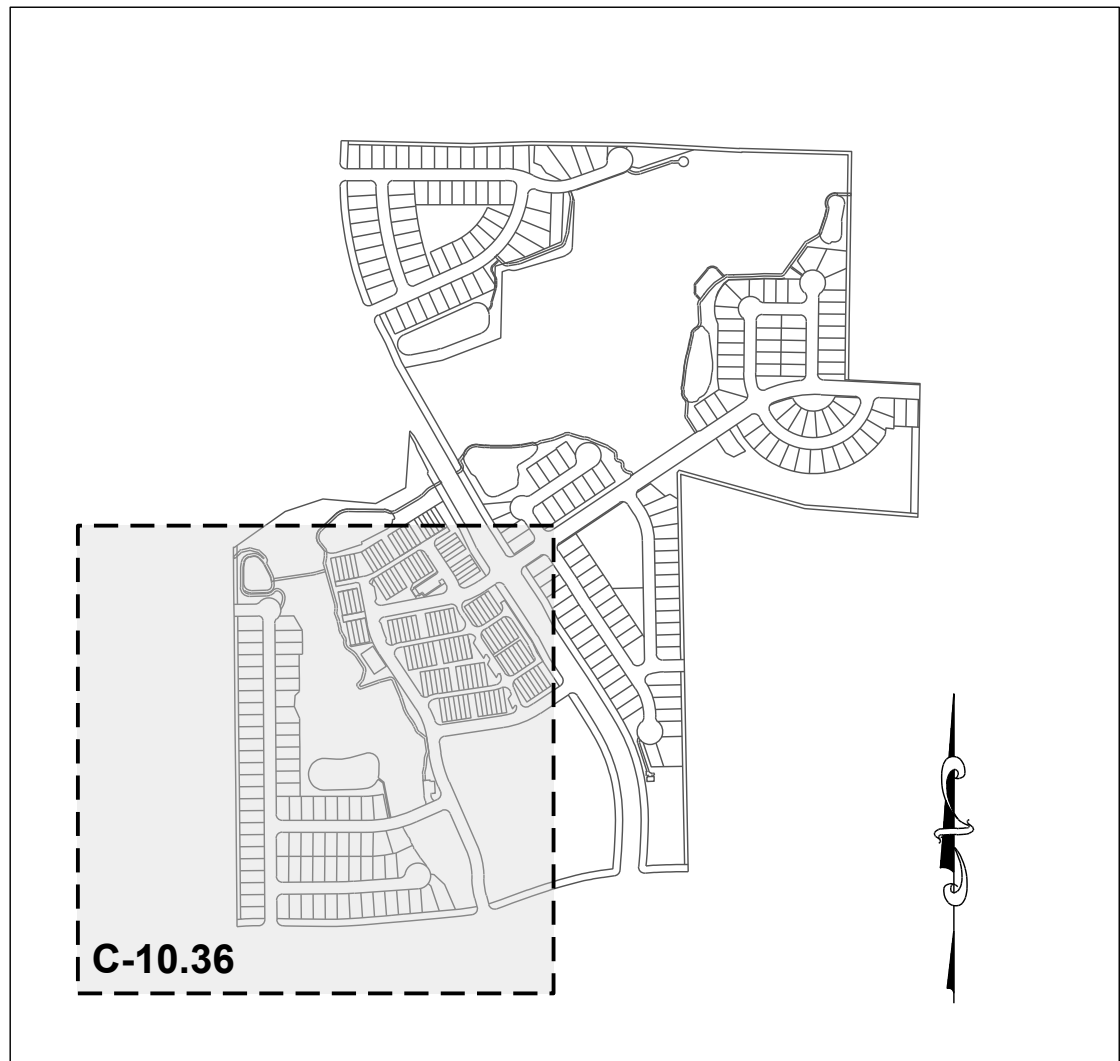

SITE KEY PLAN

LEGEND:	
	EXISTING ADJOINER PROPERTY LINE
	EXISTING EDGE OF PAVEMENT
	EX. MAJOR CONTOURS
	EX. MINOR CONTOURS
	PROP. MAJOR CONTOURS
	PROP. MINOR CONTOURS
	STANDARD CURB & GUTTER
	PROPOSED STORM DRAIN LINE
	PROPOSED LOT LINE
	SILT FENCE/LIMITS OF DISTURBANCE
	LIMITS OF DISTURBANCE
	SILT FENCE
	SANITARY SEWER LINE
	SANITARY MANHOLE
	INLET PROTECTION
	SILT FENCE OUTLET
	DISSIPATOR PAD
	EXISTING WETLAND
	ENVIRONMENTAL SENSITIVE AREA

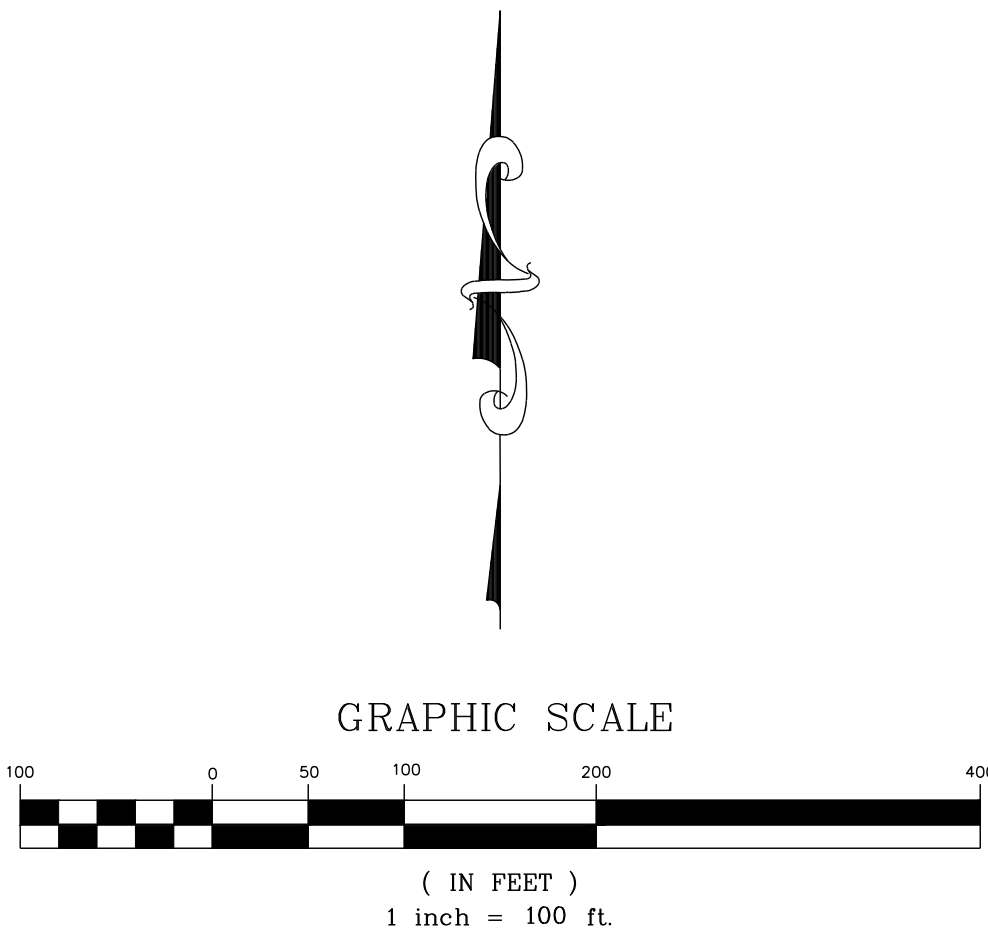


THIS PLANSET AND ANY ASSOCIATED DOCUMENTS ARE PRELIMINARY AND NOT AUTHORIZED FOR CONSTRUCTION UNTIL SIGNED, DATED, AND OFFICIALLY RELEASED FOR CONSTRUCTION BY THE ENGINEER OF RECORD.

STRONG ROCK		ENGINEERING GROUP		STRONG ROCK ENGINEERING GROUP, PLLC COMPANY LICENSE # P-2166 305 CHURCH AT NORTH HILLS STREET, SUITE 1110 RALEIGH, NC 27609 INFORMATION@STRONGROCKGROUP.COM	
STRONG ROCK PROJECT PSP-24-03	NOT FOR CONSTRUCTION	SCALE AS SHOWN	DESIGNED BY SRG	DRAWN BY SRG	CHECKED BY SRG
RESERVE @ MITCHELL MILL TOWN OF ROLESVILLE, WAKE COUNTY, NORTH CAROLINA CONSTRUCTION PLANS EROSION CONTROL PLAN PHASE 6 - STAGE 3					
DRAWING SHEET					
C-10.36					
95 OF 230					

SEAL:		CONSTRUCTION INFRASTRUCTURE DRAWINGS CID-24-04		NO.		REVISIONS		DATE		BY	
01		08/04/2024	SRG								
02		11/07/2024	SRG								
03		02/07/2024	SRG								
04		08/02/2025	SRG								
05		09/02/2025	SRG								




PROPOSED PENDULUM STREET - PLAN
HORIZONTAL: 1" = 50'

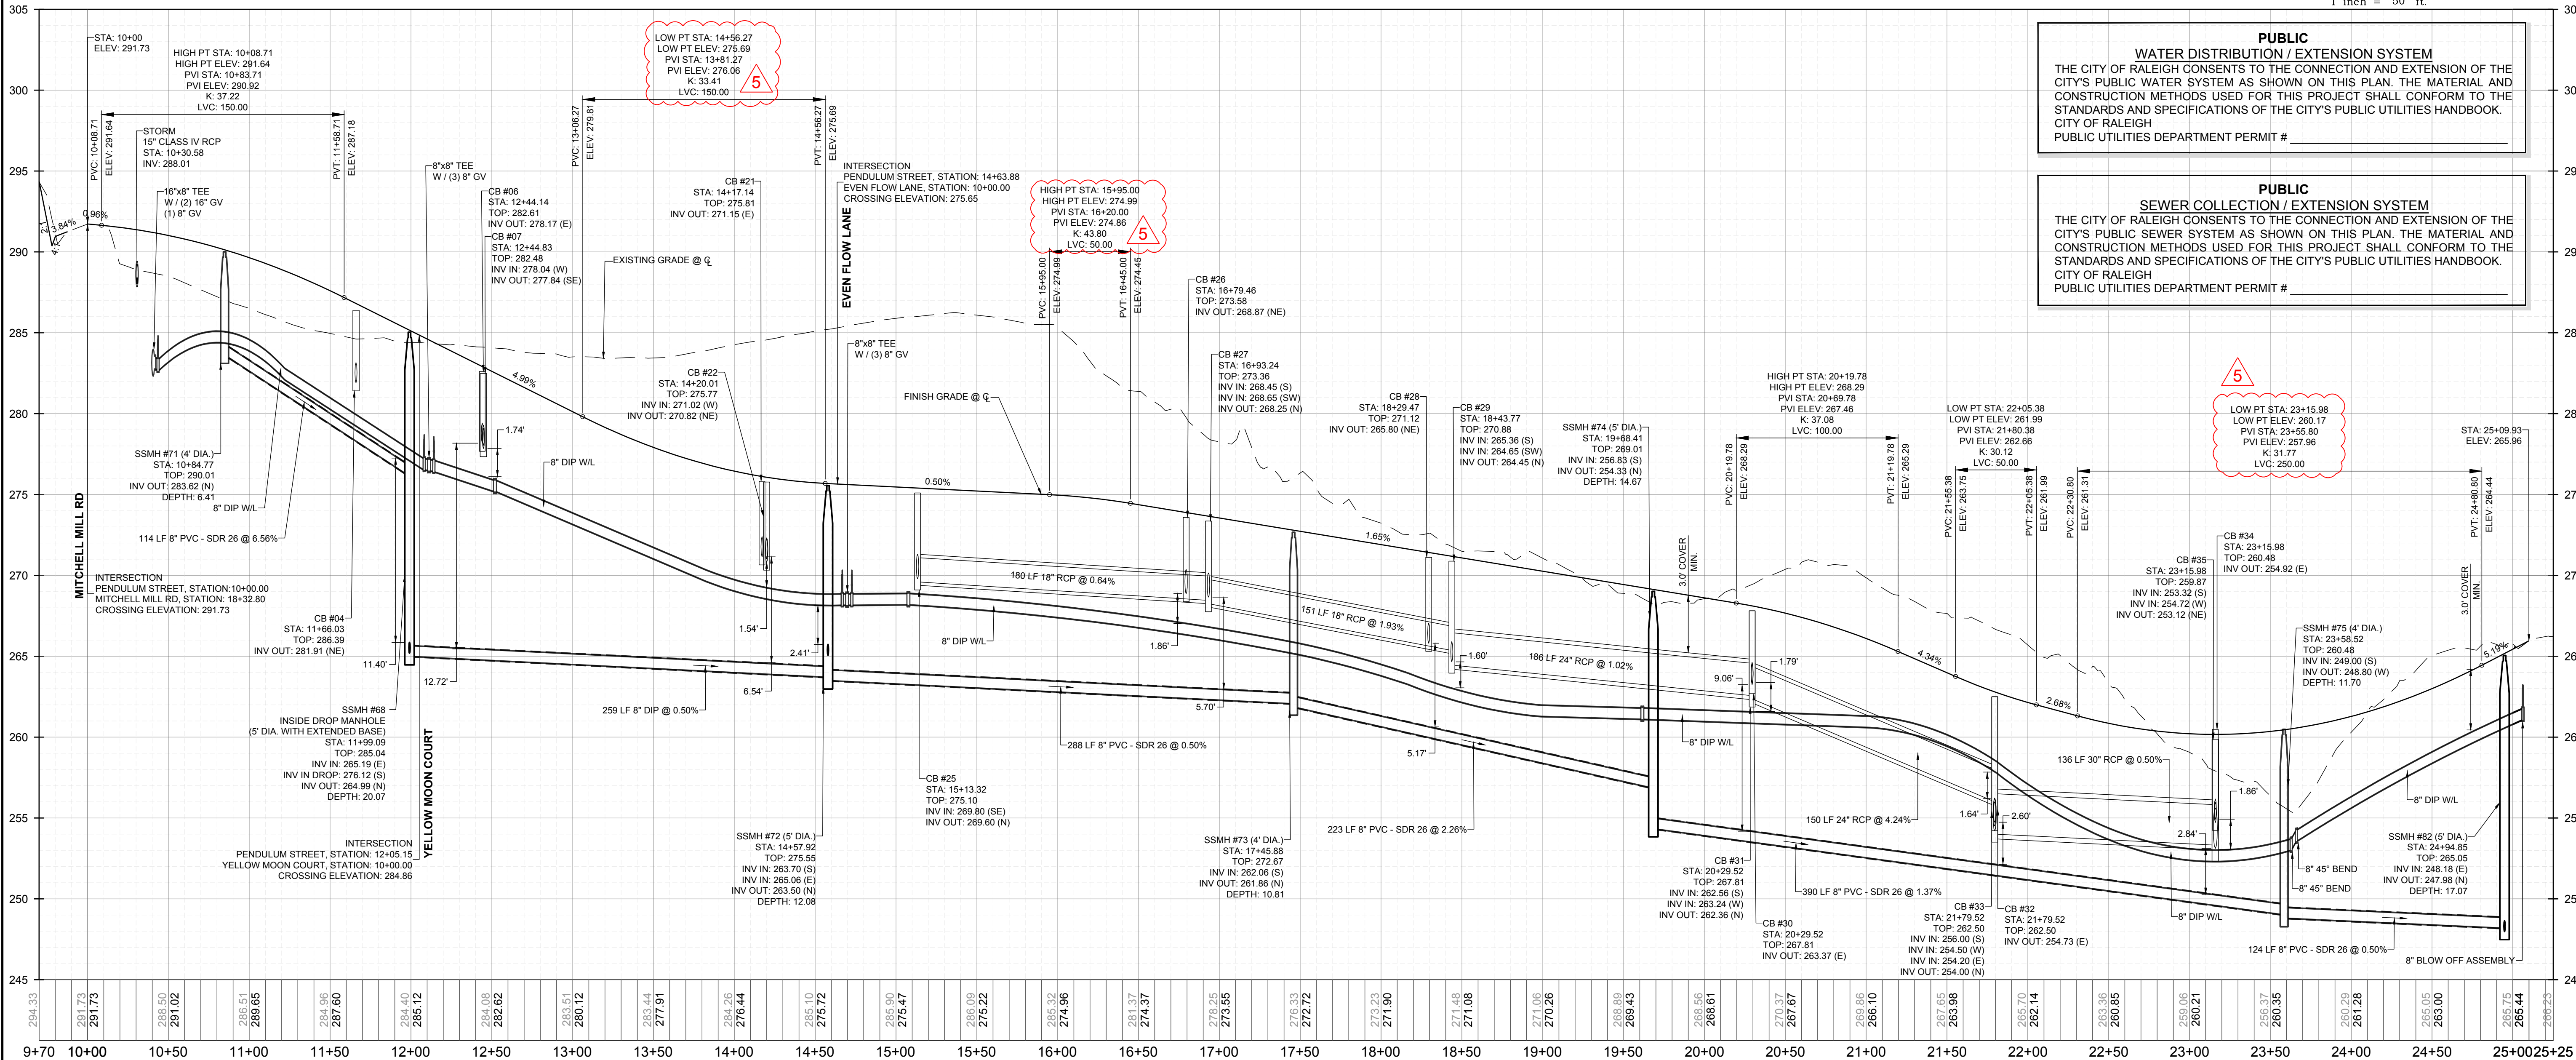


PROPOSED PENDULUM STREET - PROFILE
VERTICAL: 1" = 5'
HORIZONTAL: 1" = 50'

THIS PLANSET AND ANY ASSOCIATED DOCUMENTS ARE PRELIMINARY AND NOT AUTHORIZED FOR CONSTRUCTION UNTIL SIGNED, DATED, AND OFFICIALLY RELEASED FOR CONSTRUCTION BY THE ENGINEER OF RECORD.


CONSTRUCTION INFRASTRUCTURE DRAWINGS CID-34-04		01	02	03	04	05	NO.		REVISIONS		DATE		BY										
SEAL:												STRONG ROCK		ENGINEERING GROUP									
RESERVE @ MITCHELL MILL TOWN OF ROLESVILLE, WAKE COUNTY, NORTH CAROLINA CONSTRUCTION PLANS PROPOSED PENDULUM STREET - PLAN & PROFILE														DRAWING SHEET C-11.0		96 OF 230							
STRONG ROCK PROJECT PSP-23-03														NOT FOR CONSTRUCTION		SCALE AS SHOWN		DESIGNED BY SRG		DRAWN BY SRG		CHECKED BY SRG	
PUBLIC WATER DISTRIBUTION / EXTENSION SYSTEM THE CITY OF RALEIGH CONSENTS TO THE CONNECTION AND EXTENSION OF THE CITY'S PUBLIC WATER SYSTEM AS SHOWN ON THIS PLAN. THE MATERIAL AND CONSTRUCTION METHODS USED FOR THIS PROJECT SHALL CONFORM TO THE STANDARDS AND SPECIFICATIONS OF THE CITY'S PUBLIC UTILITIES HANDBOOK. CITY OF RALEIGH PUBLIC UTILITIES DEPARTMENT PERMIT #														PUBLIC SEWER COLLECTION / EXTENSION SYSTEM THE CITY OF RALEIGH CONSENTS TO THE CONNECTION AND EXTENSION OF THE CITY'S PUBLIC SEWER SYSTEM AS SHOWN ON THIS PLAN. THE MATERIAL AND CONSTRUCTION METHODS USED FOR THIS PROJECT SHALL CONFORM TO THE STANDARDS AND SPECIFICATIONS OF THE CITY'S PUBLIC UTILITIES HANDBOOK. CITY OF RALEIGH PUBLIC UTILITIES DEPARTMENT PERMIT #		STRONG ROCK ENGINEERING GROUP, PLLC COMPANY LICENSE # P-2166 305 CHURCH AT NORTH HILLS STREET, SUITE 1110 RALEIGH, NC 27609 INFORMATION@STRONGROCKGROUP.COM							

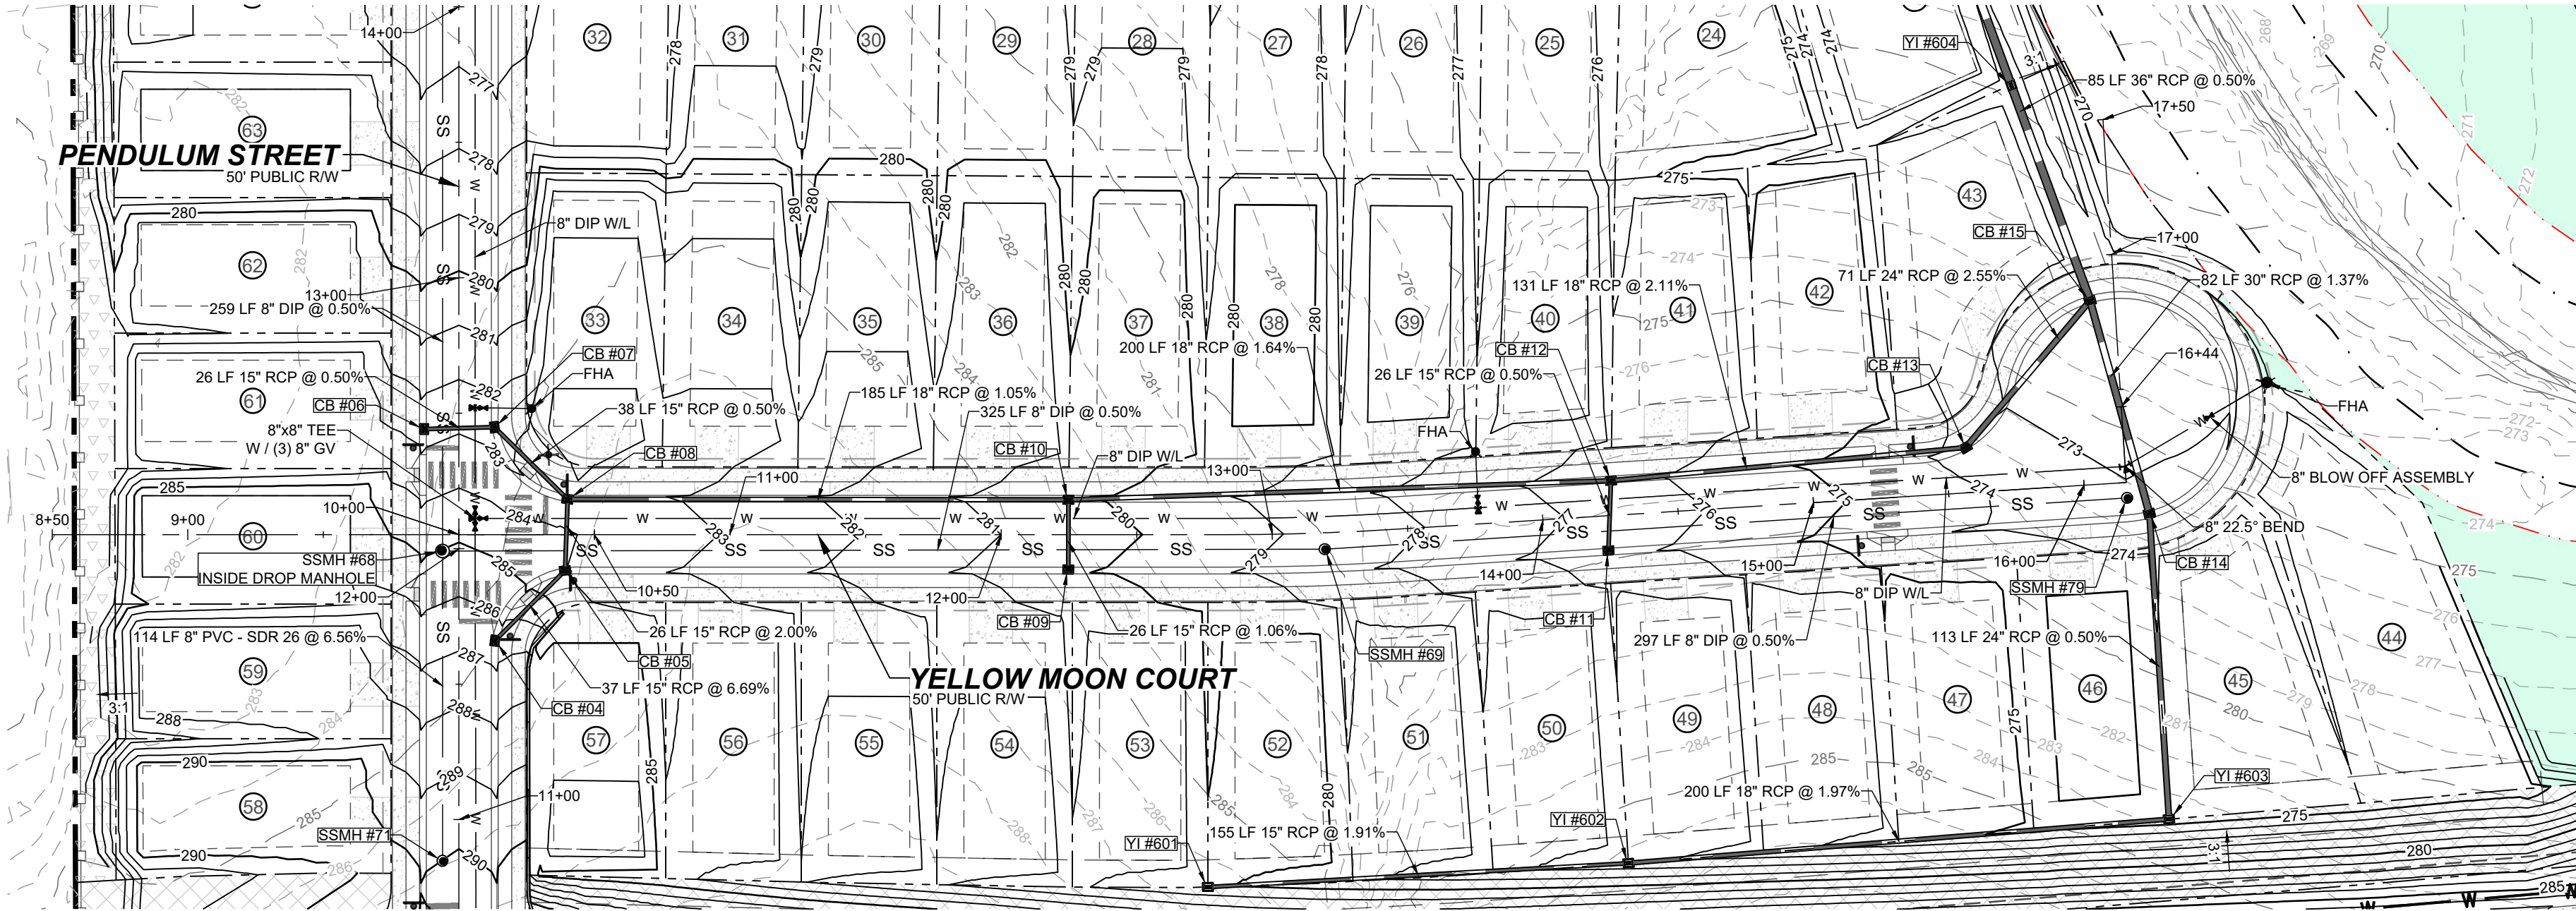

PROPOSED YELLOW MOON COURT - PLAN
HORIZONTAL: 1" = 50'

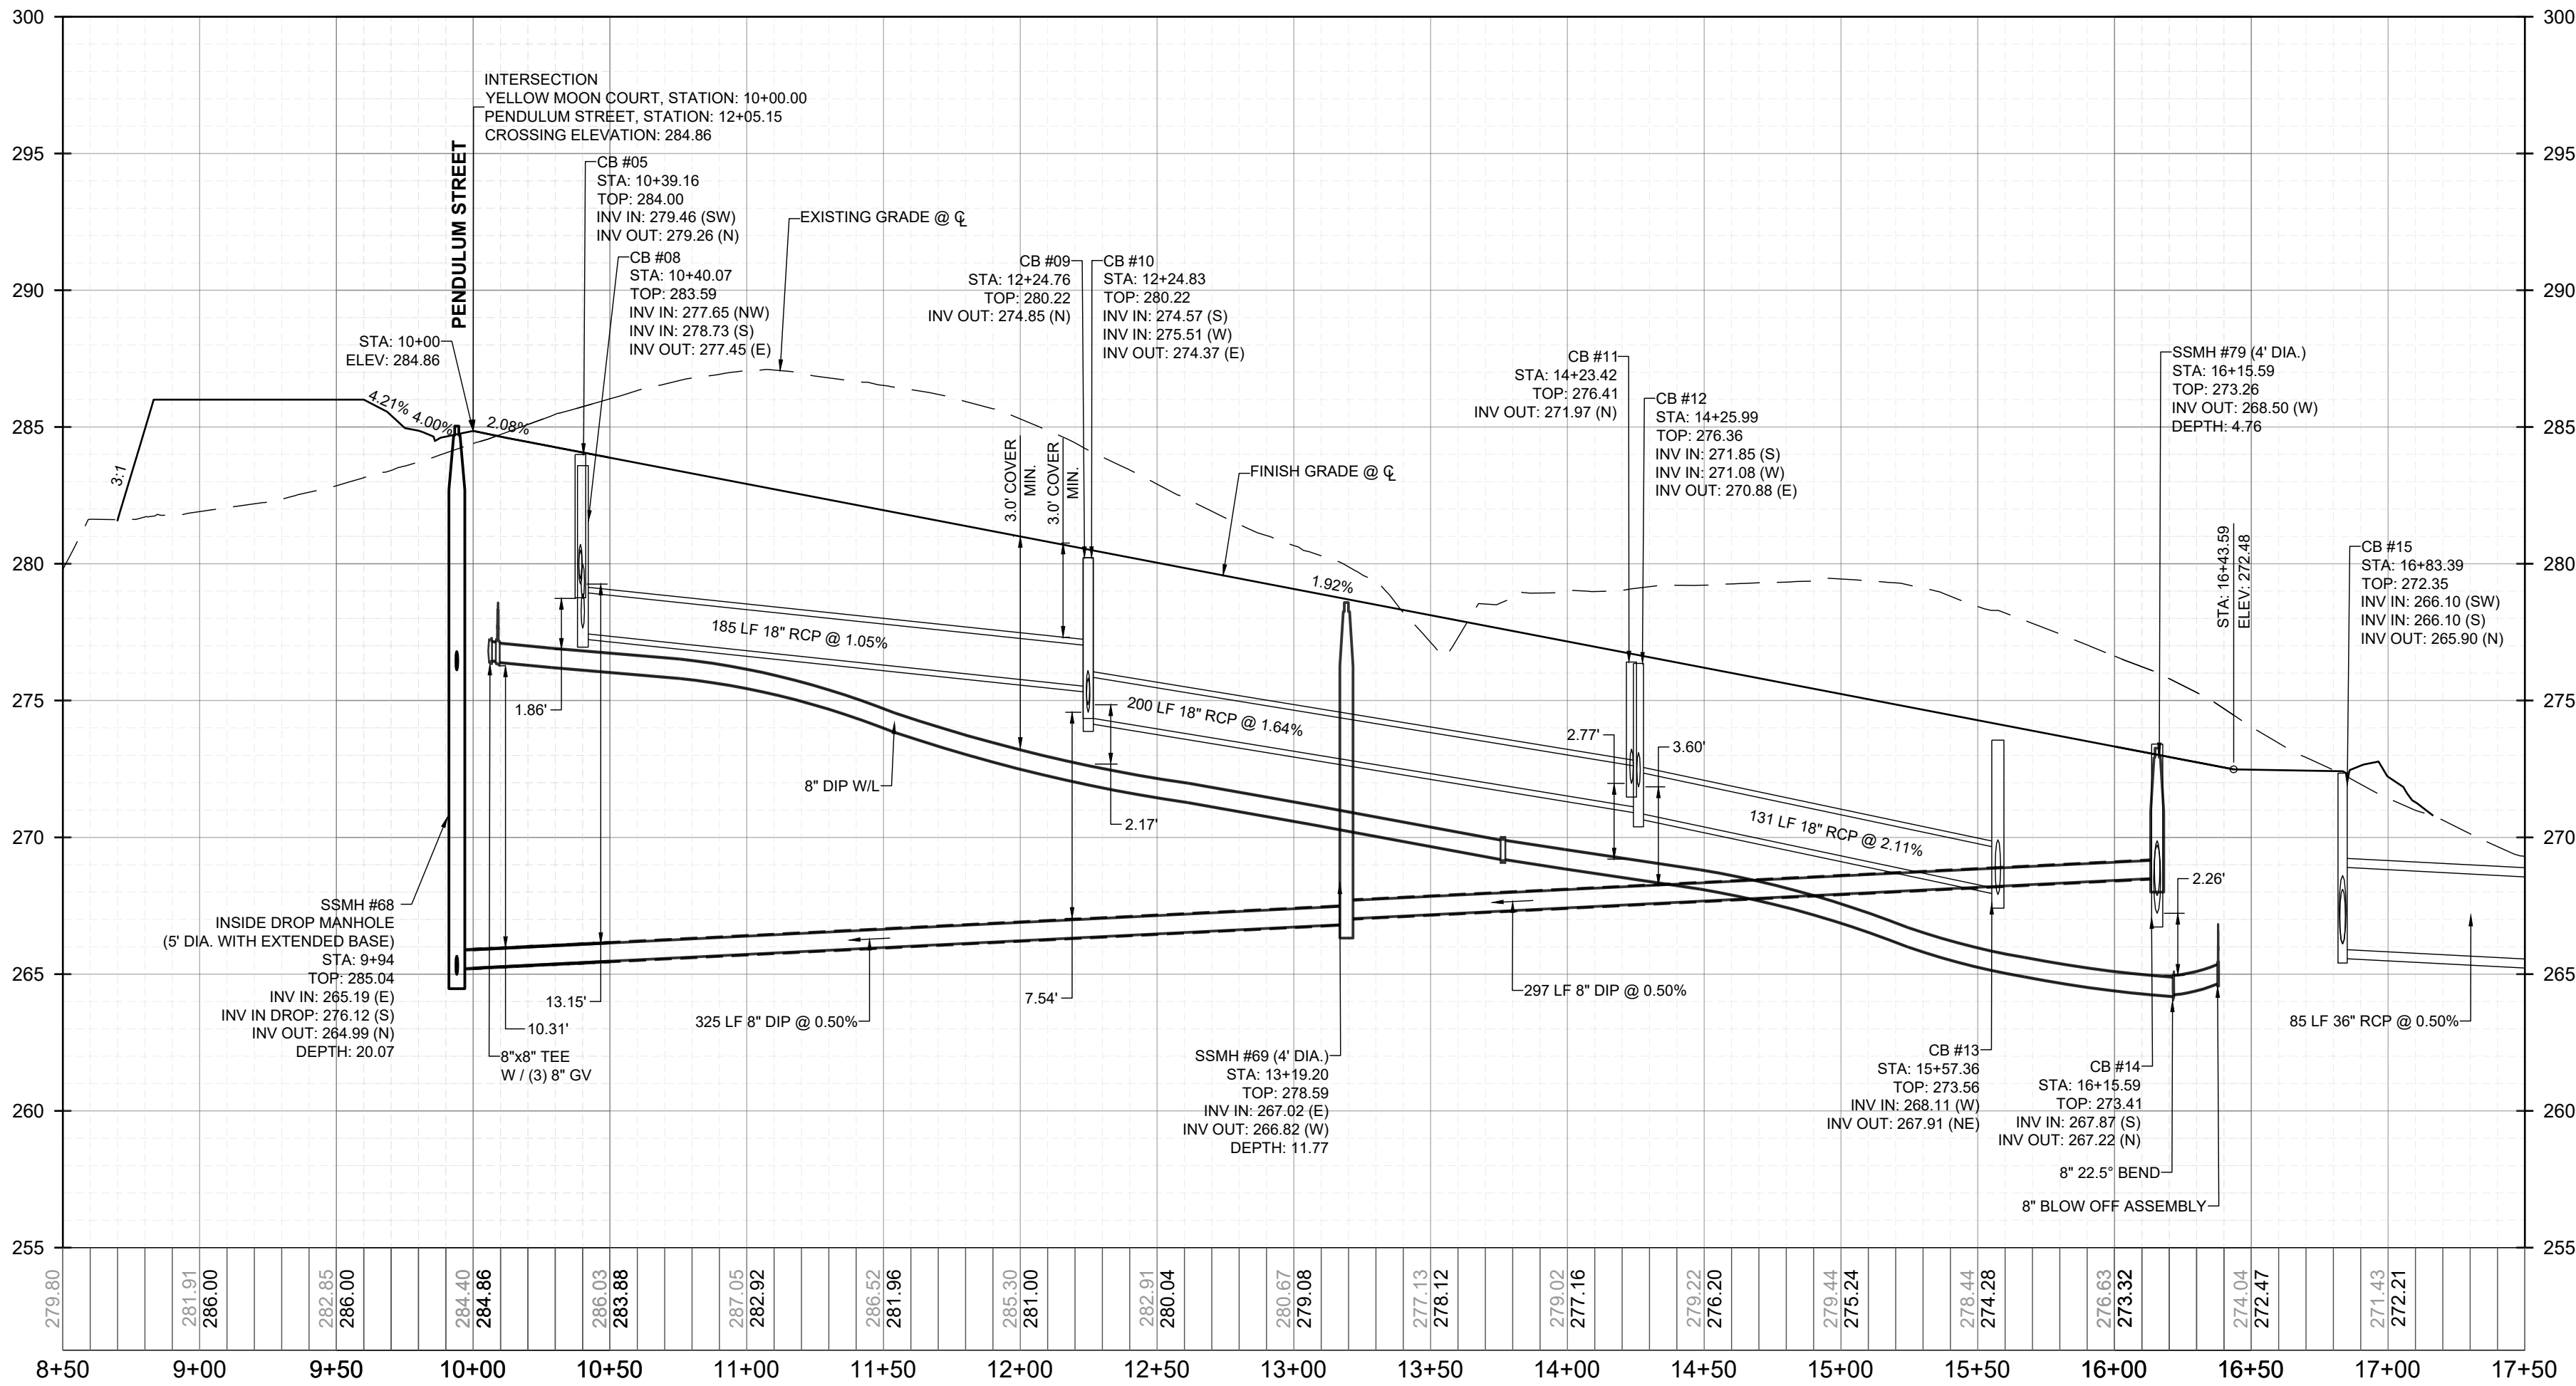

PROPOSED YELLOW MOON COURT - PROFILE
VERTICAL: 1" = 5'
HORIZONTAL: 1" = 50'

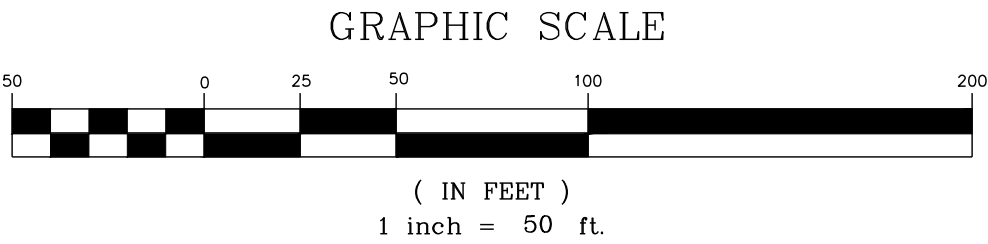

PUBLIC
WATER DISTRIBUTION / EXTENSION SYSTEM
THE CITY OF RALEIGH CONSENTS TO THE CONNECTION AND EXTENSION OF THE CITY'S PUBLIC WATER SYSTEM AS SHOWN ON THIS PLAN. THE MATERIAL AND CONSTRUCTION METHODS USED FOR THIS PROJECT SHALL CONFORM TO THE STANDARDS AND SPECIFICATIONS OF THE CITY'S PUBLIC UTILITIES HANDBOOK. CITY OF RALEIGH
PUBLIC UTILITIES DEPARTMENT PERMIT # _____

PUBLIC
SEWER COLLECTION / EXTENSION SYSTEM
THE CITY OF RALEIGH CONSENTS TO THE CONNECTION AND EXTENSION OF THE CITY'S PUBLIC SEWER SYSTEM AS SHOWN ON THIS PLAN. THE MATERIAL AND CONSTRUCTION METHODS USED FOR THIS PROJECT SHALL CONFORM TO THE STANDARDS AND SPECIFICATIONS OF THE CITY'S PUBLIC UTILITIES HANDBOOK. CITY OF RALEIGH
PUBLIC UTILITIES DEPARTMENT PERMIT # _____

CONSTRUCTION INFRASTRUCTURE DRAWINGS					REVISIONS		DATE	BY
01	02	03	04	05	No.			
01	02	03	04	05				
CD-24-04								
TOWN OF ROLESVILLE CD-24-04 V2								
TOWN OF ROLESVILLE CD-24-04 V3								
TOWN OF ROLESVILLE CD-24-04 V4								
TOWN OF ROLESVILLE CD-24-04 V5								
TOWN OF ROLESVILLE CD-24-04 V6								

SEAL:

STRONGROCK


ENGINEERING GROUP

STRONG ROCK ENGINEERING GROUP, PLLC | COMPANY LICENSE # P-2166
305 CHURCH AT NORTH HILLS STREET, SUITE 1110 RALEIGH, NC 27609 | INFORMATION@STRONGROCKGROUP.COM



STRONG ROCK PROJECT	NOT FOR CONSTRUCTION	SCALE	AS SHOWN	SRG	SRG	SRG
PSP-24-03						
DESIGNED BY	CHECKED BY	DRAWN BY	CHECKED BY			

RESERVE @ MITCHELL MILL
TOWN OF ROLESVILLE, WAKE COUNTY, NORTH CAROLINA
CONSTRUCTION PLANS
PROPOSED YELLOW MOON COURT -
PLAN & PROFILE

DRAWING SHEET
C-11.1

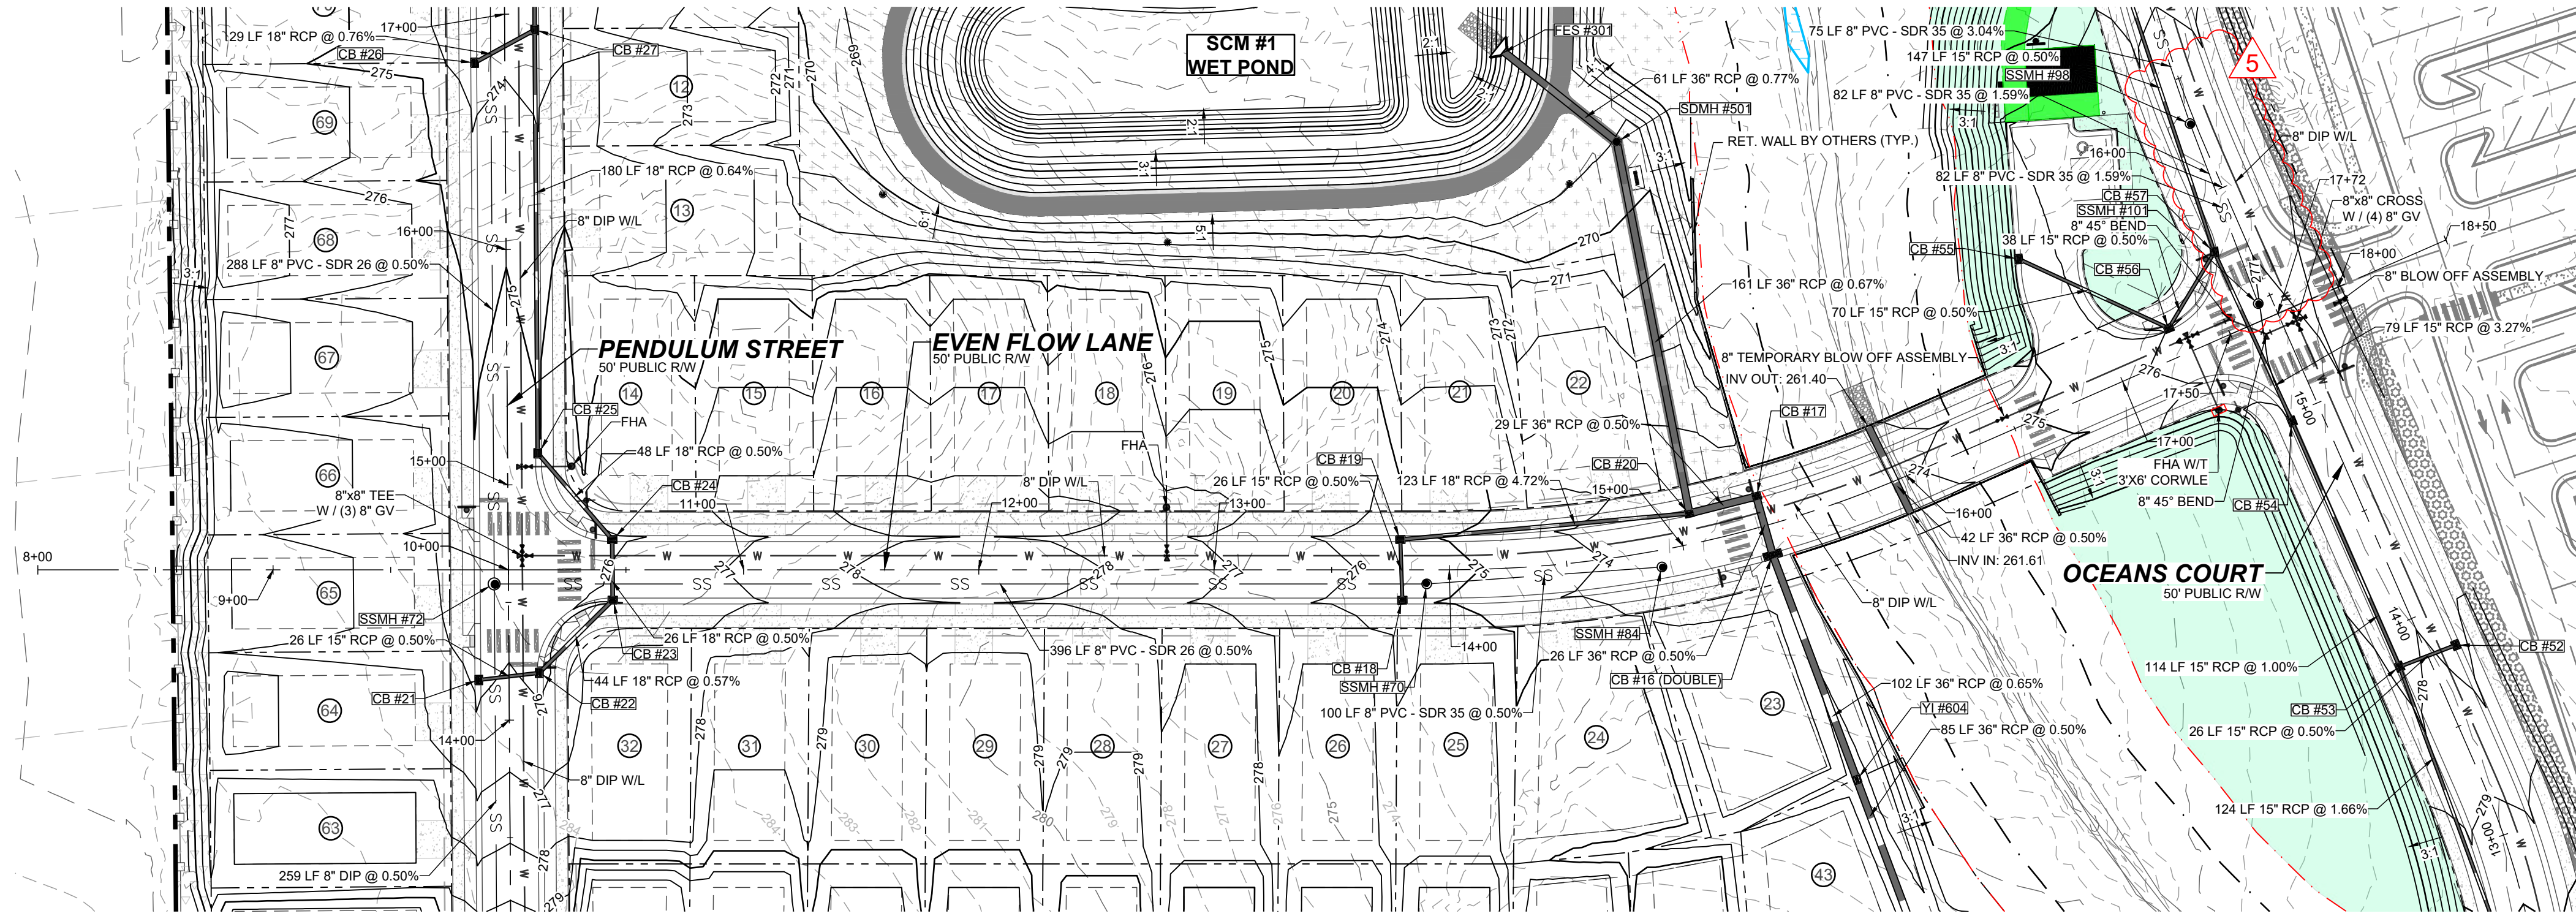

PROPOSED EVEN FLOW LANE - PLAN
HORIZONTAL: 1" = 50'

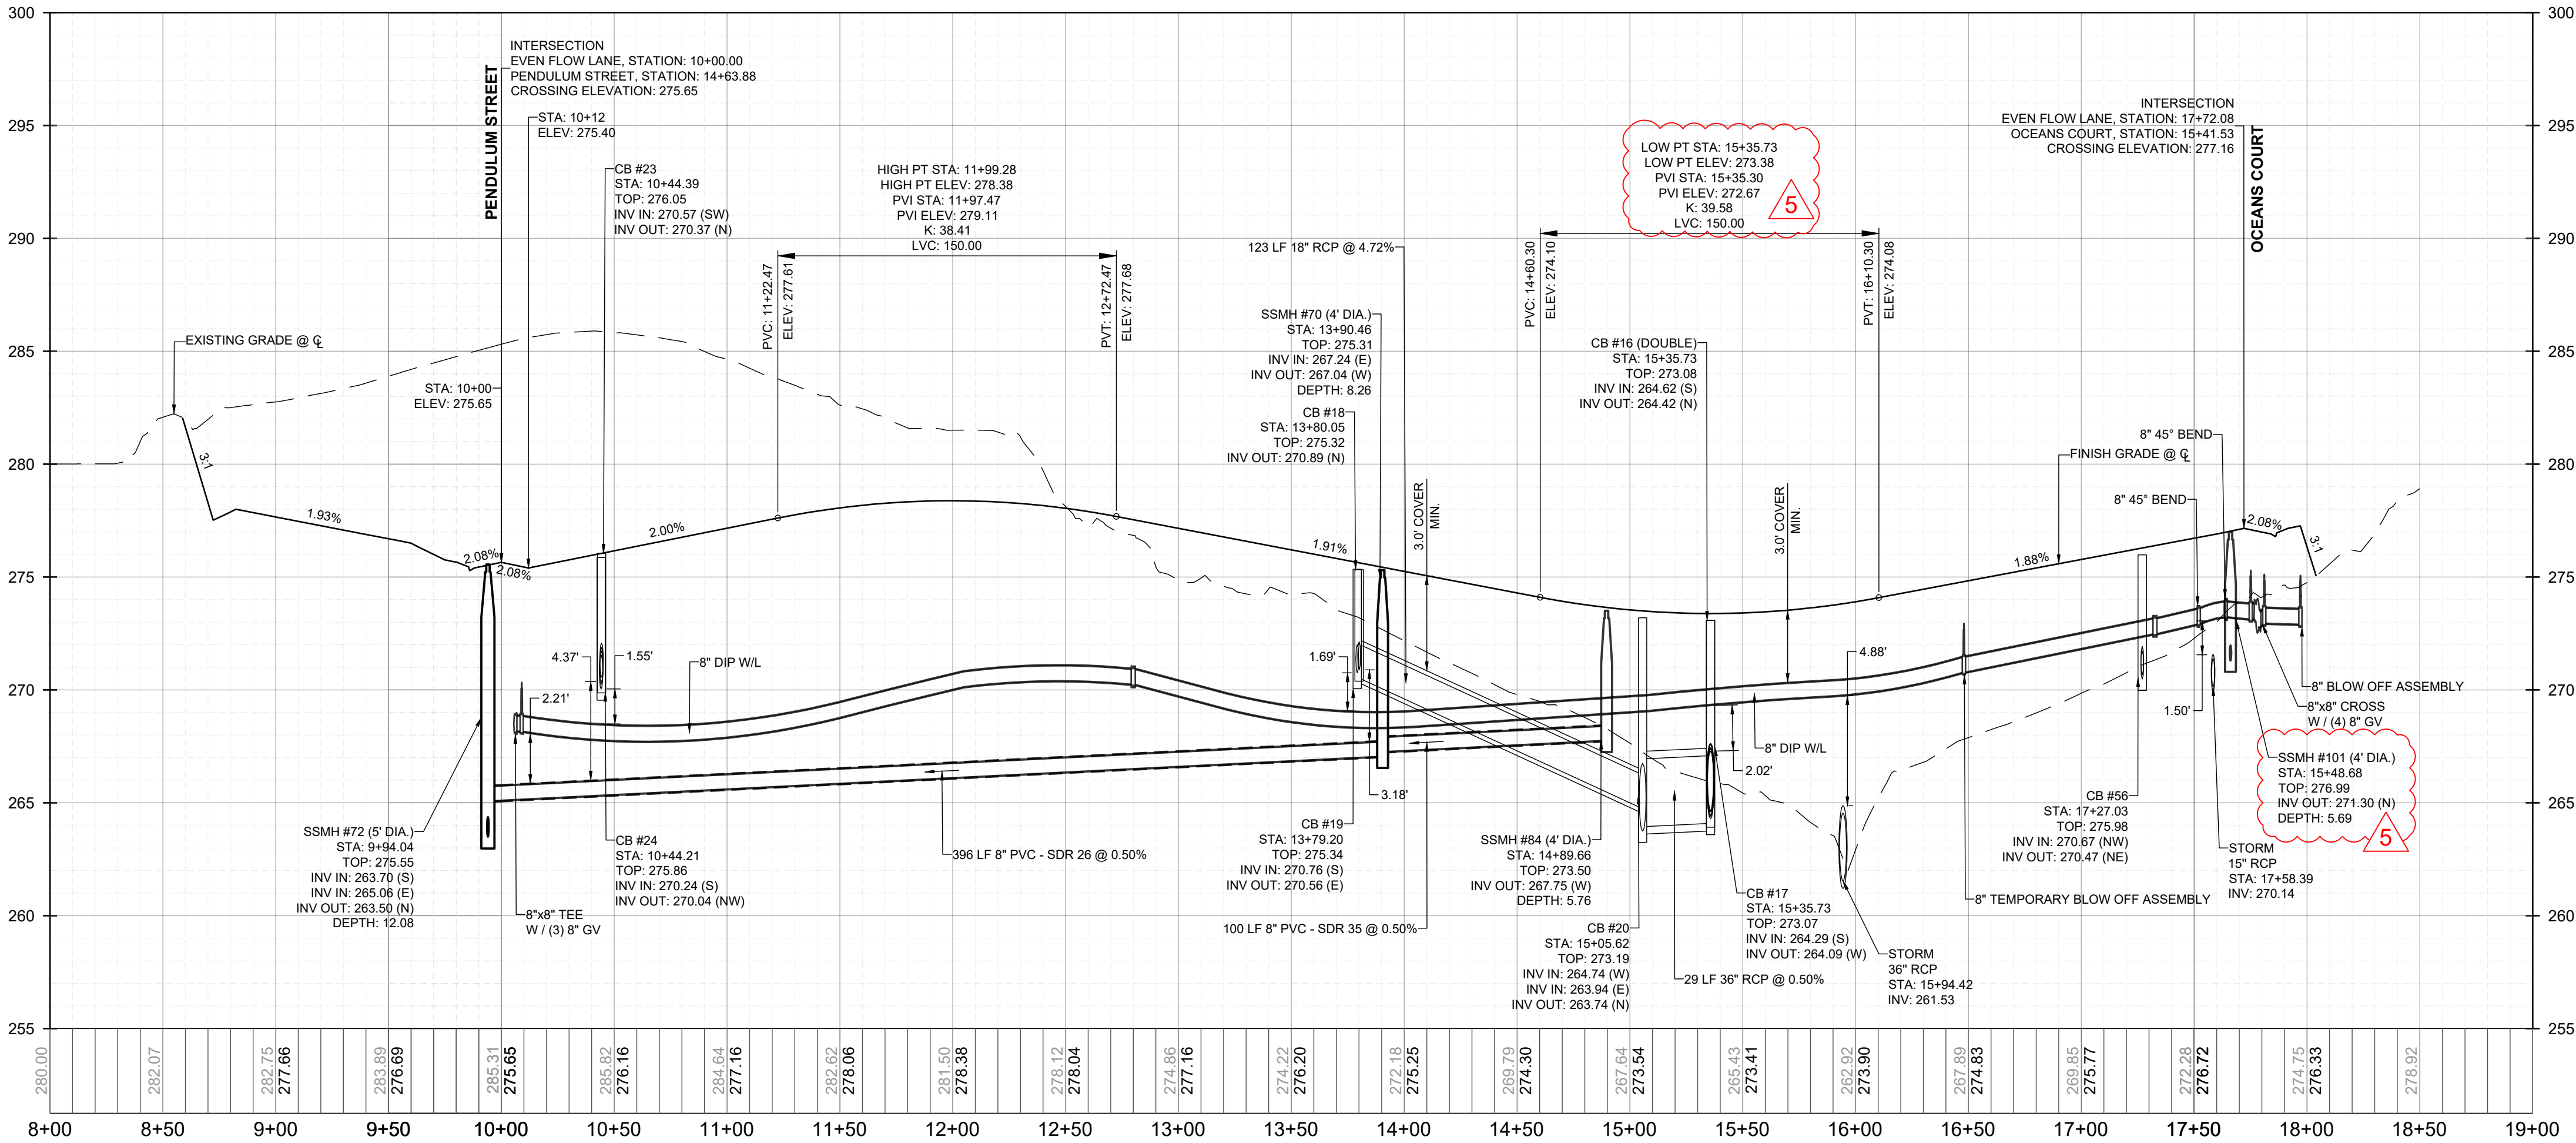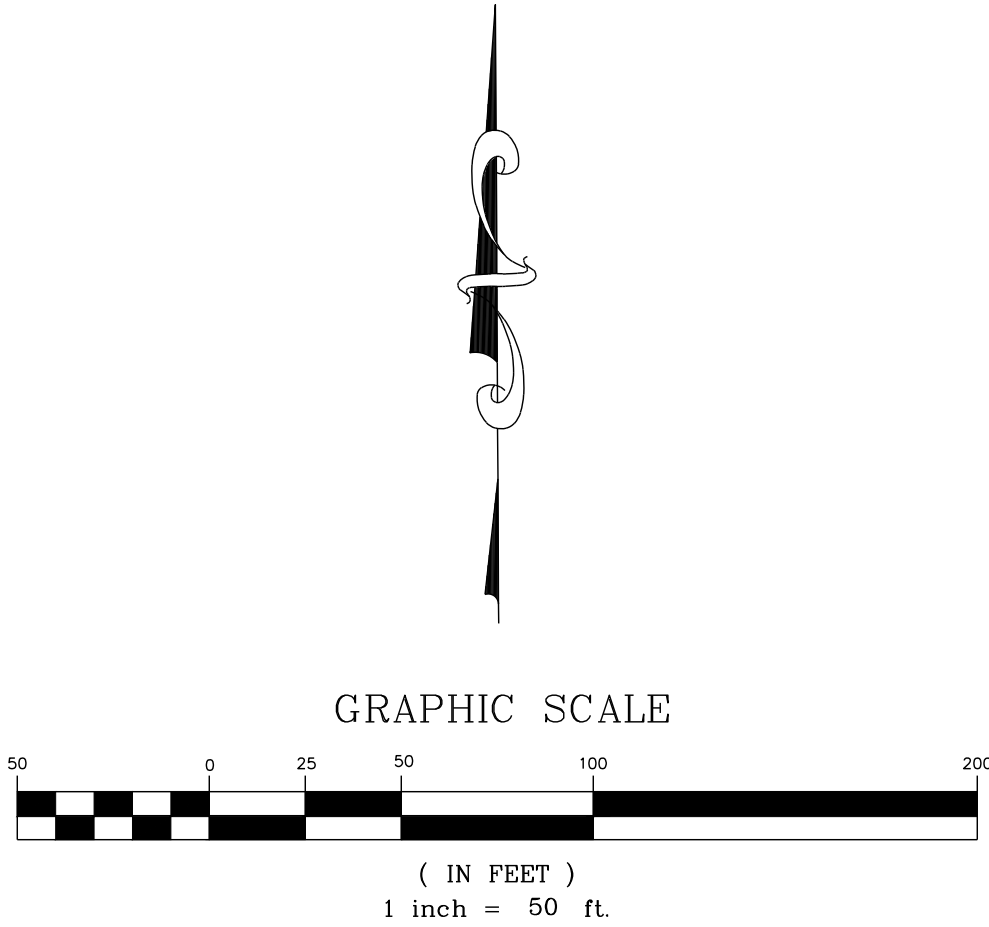

PROPOSED EVEN FLOW LANE - PROFILE
VERTICAL: 1" = 5'
HORIZONTAL: 1" = 50'

PUBLIC
WATER DISTRIBUTION / EXTENSION SYSTEM
THE CITY OF RALEIGH CONSENTS TO THE CONNECTION AND EXTENSION OF THE CITY'S PUBLIC WATER SYSTEM AS SHOWN ON THIS PLAN. THE MATERIAL AND CONSTRUCTION METHODS USED FOR THIS PROJECT SHALL CONFORM TO THE STANDARDS AND SPECIFICATIONS OF THE CITY'S PUBLIC UTILITIES HANDBOOK.
CITY OF RALEIGH
PUBLIC UTILITIES DEPARTMENT PERMIT # _____

PUBLIC
SEWER COLLECTION / EXTENSION SYSTEM
THE CITY OF RALEIGH CONSENTS TO THE CONNECTION AND EXTENSION OF THE CITY'S PUBLIC SEWER SYSTEM AS SHOWN ON THIS PLAN. THE MATERIAL AND CONSTRUCTION METHODS USED FOR THIS PROJECT SHALL CONFORM TO THE STANDARDS AND SPECIFICATIONS OF THE CITY'S PUBLIC UTILITIES HANDBOOK.
CITY OF RALEIGH
PUBLIC UTILITIES DEPARTMENT PERMIT # _____

STRONGROCK

ENGINEERING GROUP

STRONG ROCK ENGINEERING GROUP, PLLC | COMPANY LICENSE # P-2166
305 CHURCH AT NORTH HILLS STREET, SUITE 1110 RALEIGH, NC 27609 | INFORMATION@STRONGROCKGROUP.COM

SEAL:

CONSTRUCTION INFRASTRUCTURE DRAWINGS
CID-24-04

01
02
03
04
05

08/04/2024
11/07/2024
02/07/2024
08/02/2025
09/02/2025

SRG
SRG
SRG
SRG
SRG

DATE


BY

RESERVE @ MITCHELL MILL
TOWN OF ROLESVILLE, WAKE COUNTY, NORTH CAROLINA
CONSTRUCTION PLANS
PROPOSED EVEN FLOW LANE -
PLAN & PROFILE



DRAWING SHEET
C-11.2

98 OF 230

THIS PLANSET AND ANY ASSOCIATED DOCUMENTS ARE PRELIMINARY AND NOT AUTHORIZED FOR CONSTRUCTION UNTIL SIGNED, DATED, AND OFFICIALLY RELEASED FOR CONSTRUCTION BY THE ENGINEER OF RECORD.

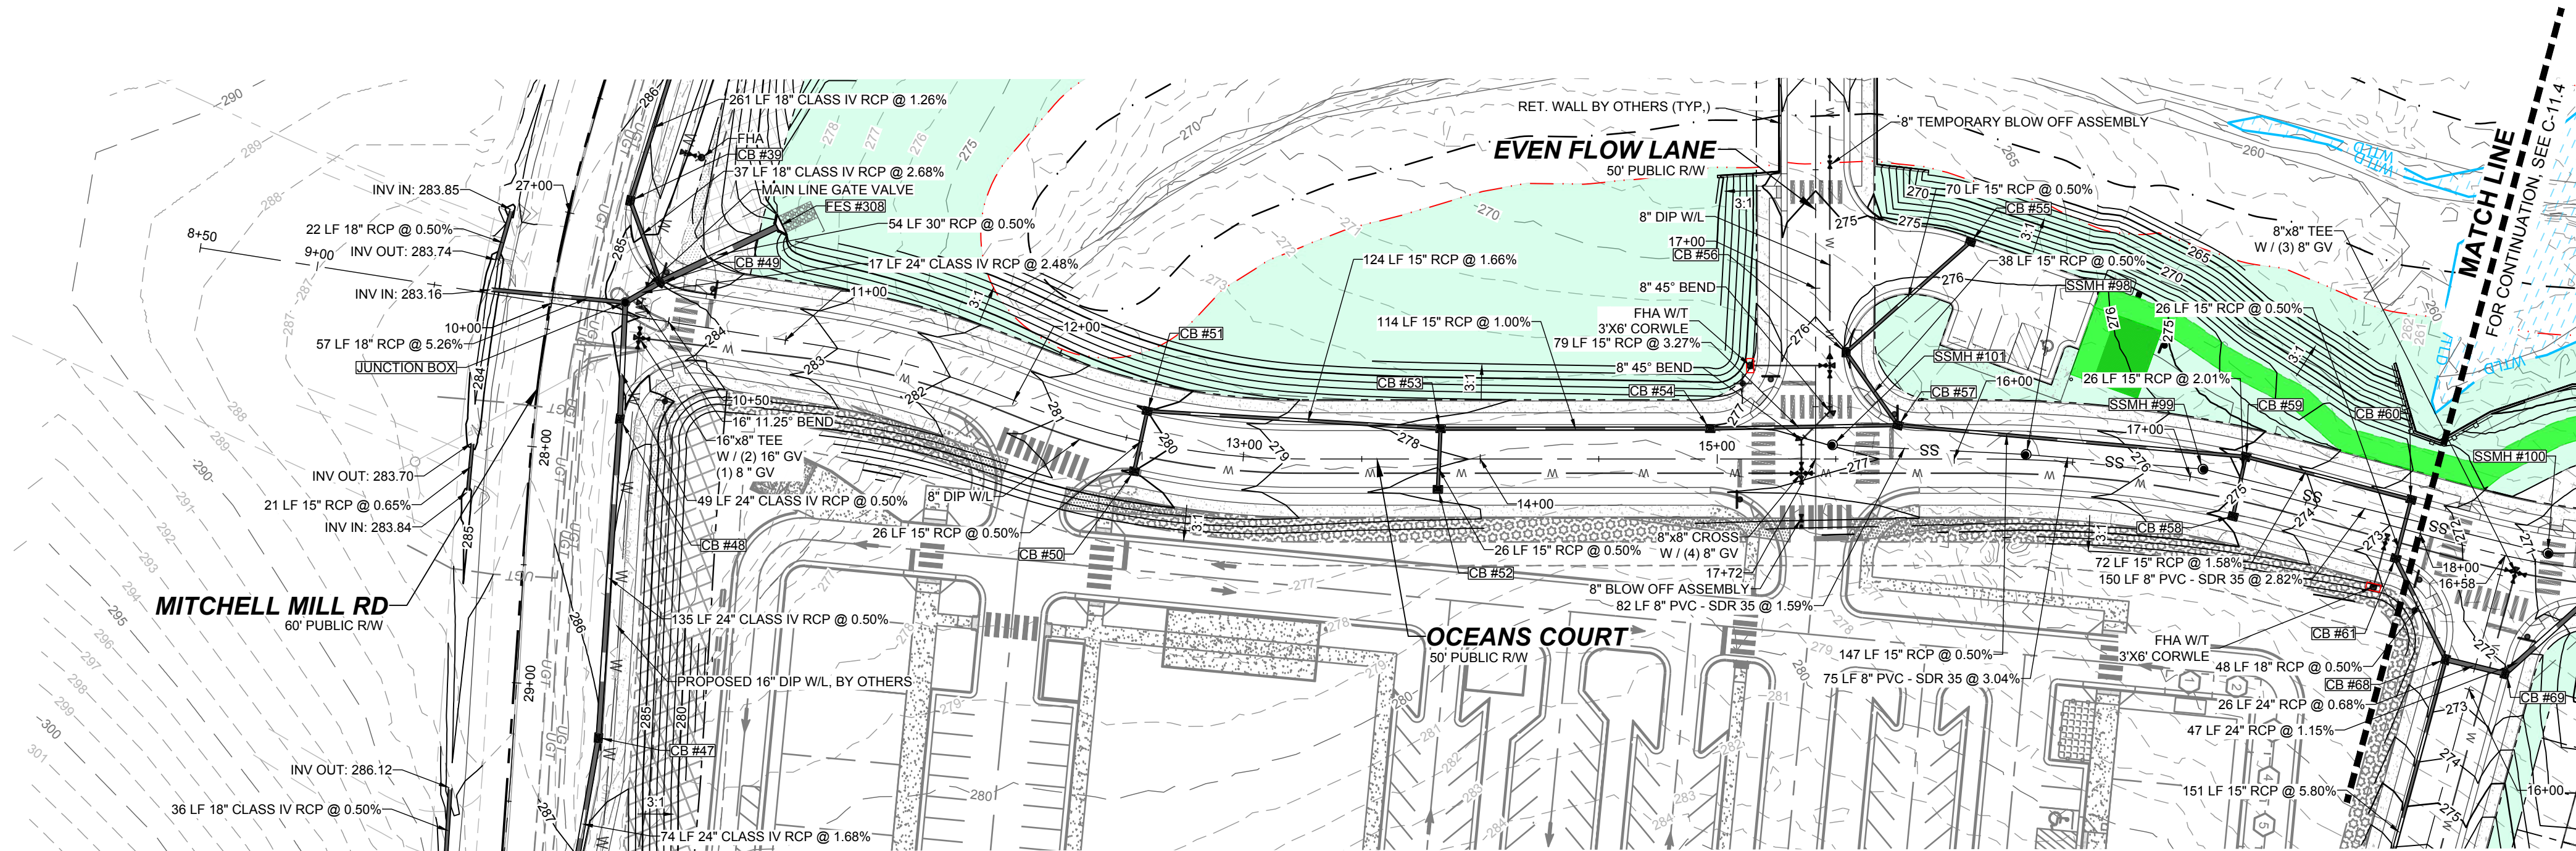

PROPOSED OCEANS COURT - PLAN
HORIZONTAL: 1" = 50'

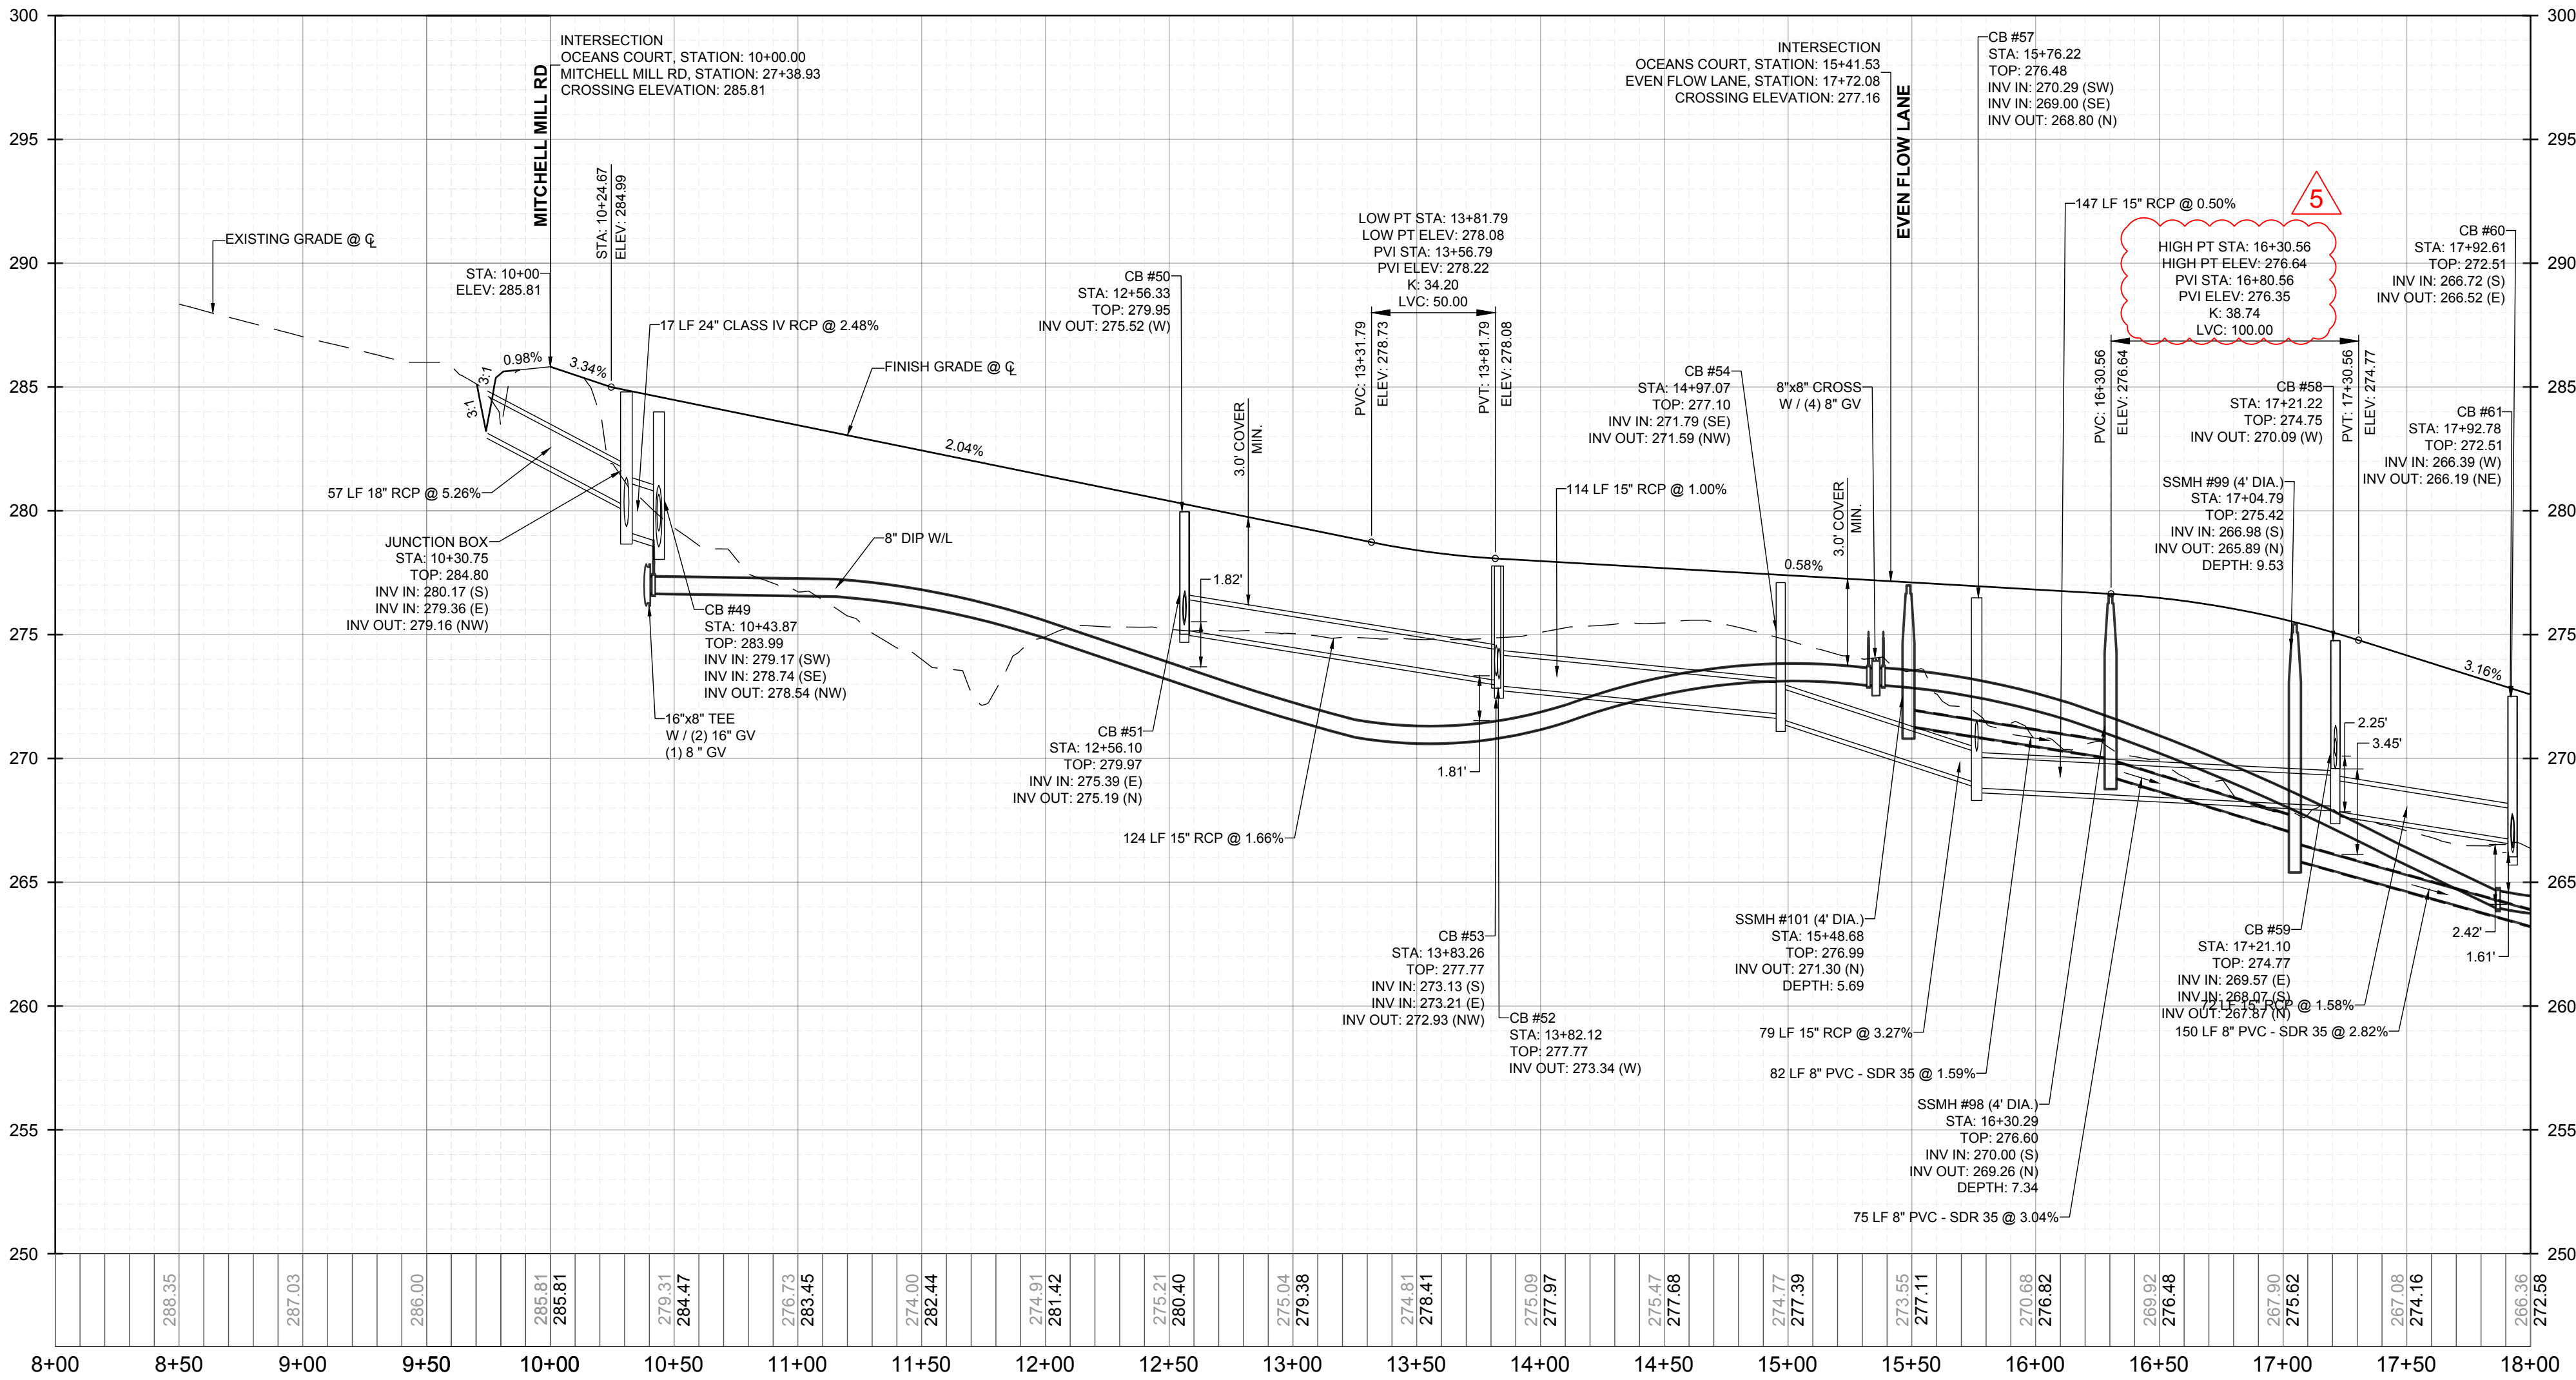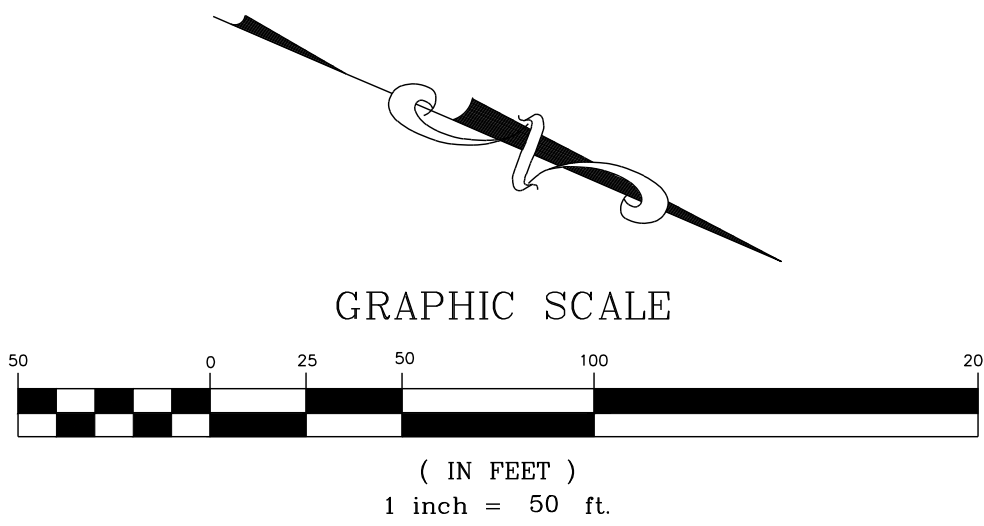

PROPOSED OCEANS COURT - PROFILE
VERTICAL: 1" = 5'
HORIZONTAL: 1" = 50'

PUBLIC
WATER DISTRIBUTION / EXTENSION SYSTEM
THE CITY OF RALEIGH CONSENTS TO THE CONNECTION AND EXTENSION OF THE CITY'S PUBLIC WATER SYSTEM AS SHOWN ON THIS PLAN. THE MATERIAL AND CONSTRUCTION METHODS USED FOR THIS PROJECT SHALL CONFORM TO THE STANDARDS AND SPECIFICATIONS OF THE CITY'S PUBLIC UTILITIES HANDBOOK. CITY OF RALEIGH
PUBLIC UTILITIES DEPARTMENT PERMIT # _____

PUBLIC
SEWER COLLECTION / EXTENSION SYSTEM
THE CITY OF RALEIGH CONSENTS TO THE CONNECTION AND EXTENSION OF THE CITY'S PUBLIC SEWER SYSTEM AS SHOWN ON THIS PLAN. THE MATERIAL AND CONSTRUCTION METHODS USED FOR THIS PROJECT SHALL CONFORM TO THE STANDARDS AND SPECIFICATIONS OF THE CITY'S PUBLIC UTILITIES HANDBOOK. CITY OF RALEIGH
PUBLIC UTILITIES DEPARTMENT PERMIT # _____

THIS PLANSET AND ANY ASSOCIATED DOCUMENTS ARE PRELIMINARY AND NOT AUTHORIZED FOR CONSTRUCTION UNTIL SIGNED, DATED, AND OFFICIALLY RELEASED FOR CONSTRUCTION BY THE ENGINEER OF RECORD.

RESERVE @ MITCHELL MILL
TOWN OF ROLESVILLE, WAKE COUNTY, NORTH CAROLINA
CONSTRUCTION PLANS
PROPOSED OCEANS COURT -
PLAN & PROFILE


DRAWING
SHEET
C-11.3

99 OF 230



STRONGROCK
ENGINEERING GROUP
STRONG ROCK ENGINEERING GROUP, PLLC | COMPANY LICENSE # P-2166
305 CHURCH AT NORTH HILLS STREET, SUITE 1110 RALEIGH, NC 27609 | INFORMATION@STRONGROCKGROUP.COM

SEAL:
01
02
03
04
05
No.
DATE
REVISIONS
BY

CONSTRUCTION INFRASTRUCTURE DRAWINGS
CID-24-04
CID-24-04 V2
CID-24-04 V3
CID-24-04 V4
CID-24-04 V5
08/04/2024
11/07/2024
02/07/2024
08/02/2025
09/02/2025
SRG
SRG
SRG
SRG
SRG

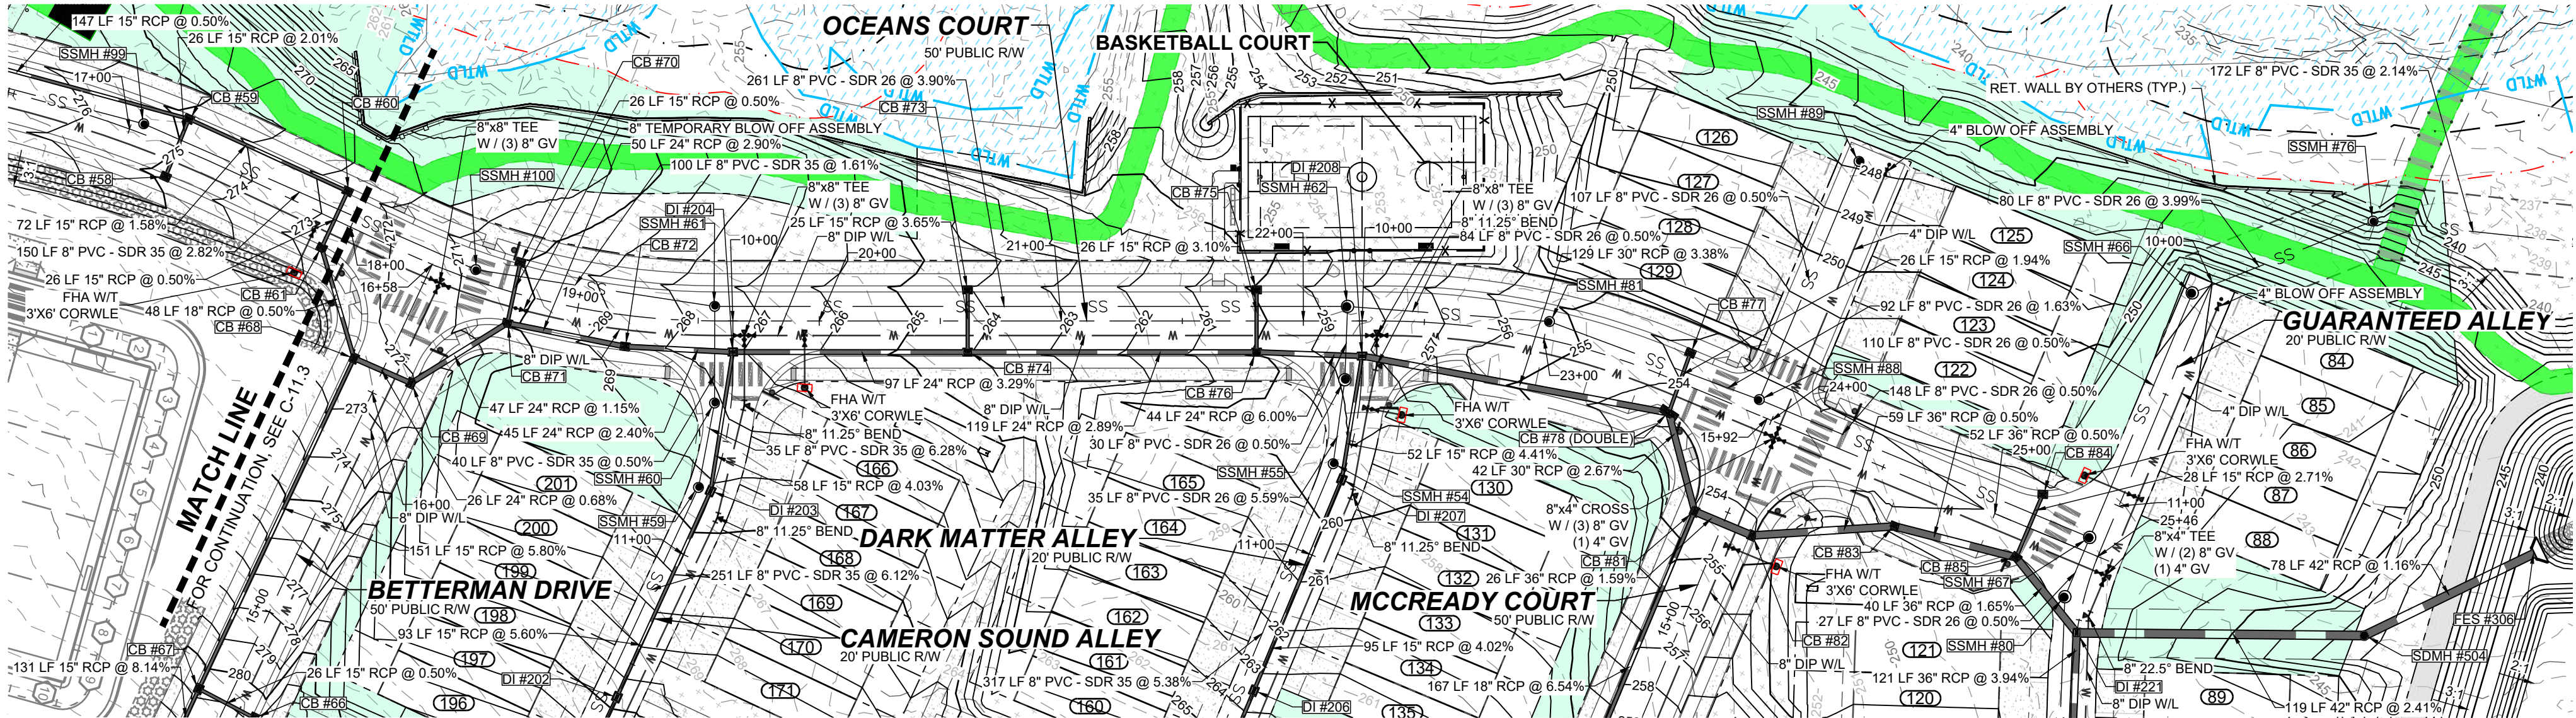

PROPOSED OCEANS COURT - PLAN
HORIZONTAL: 1" = 50'

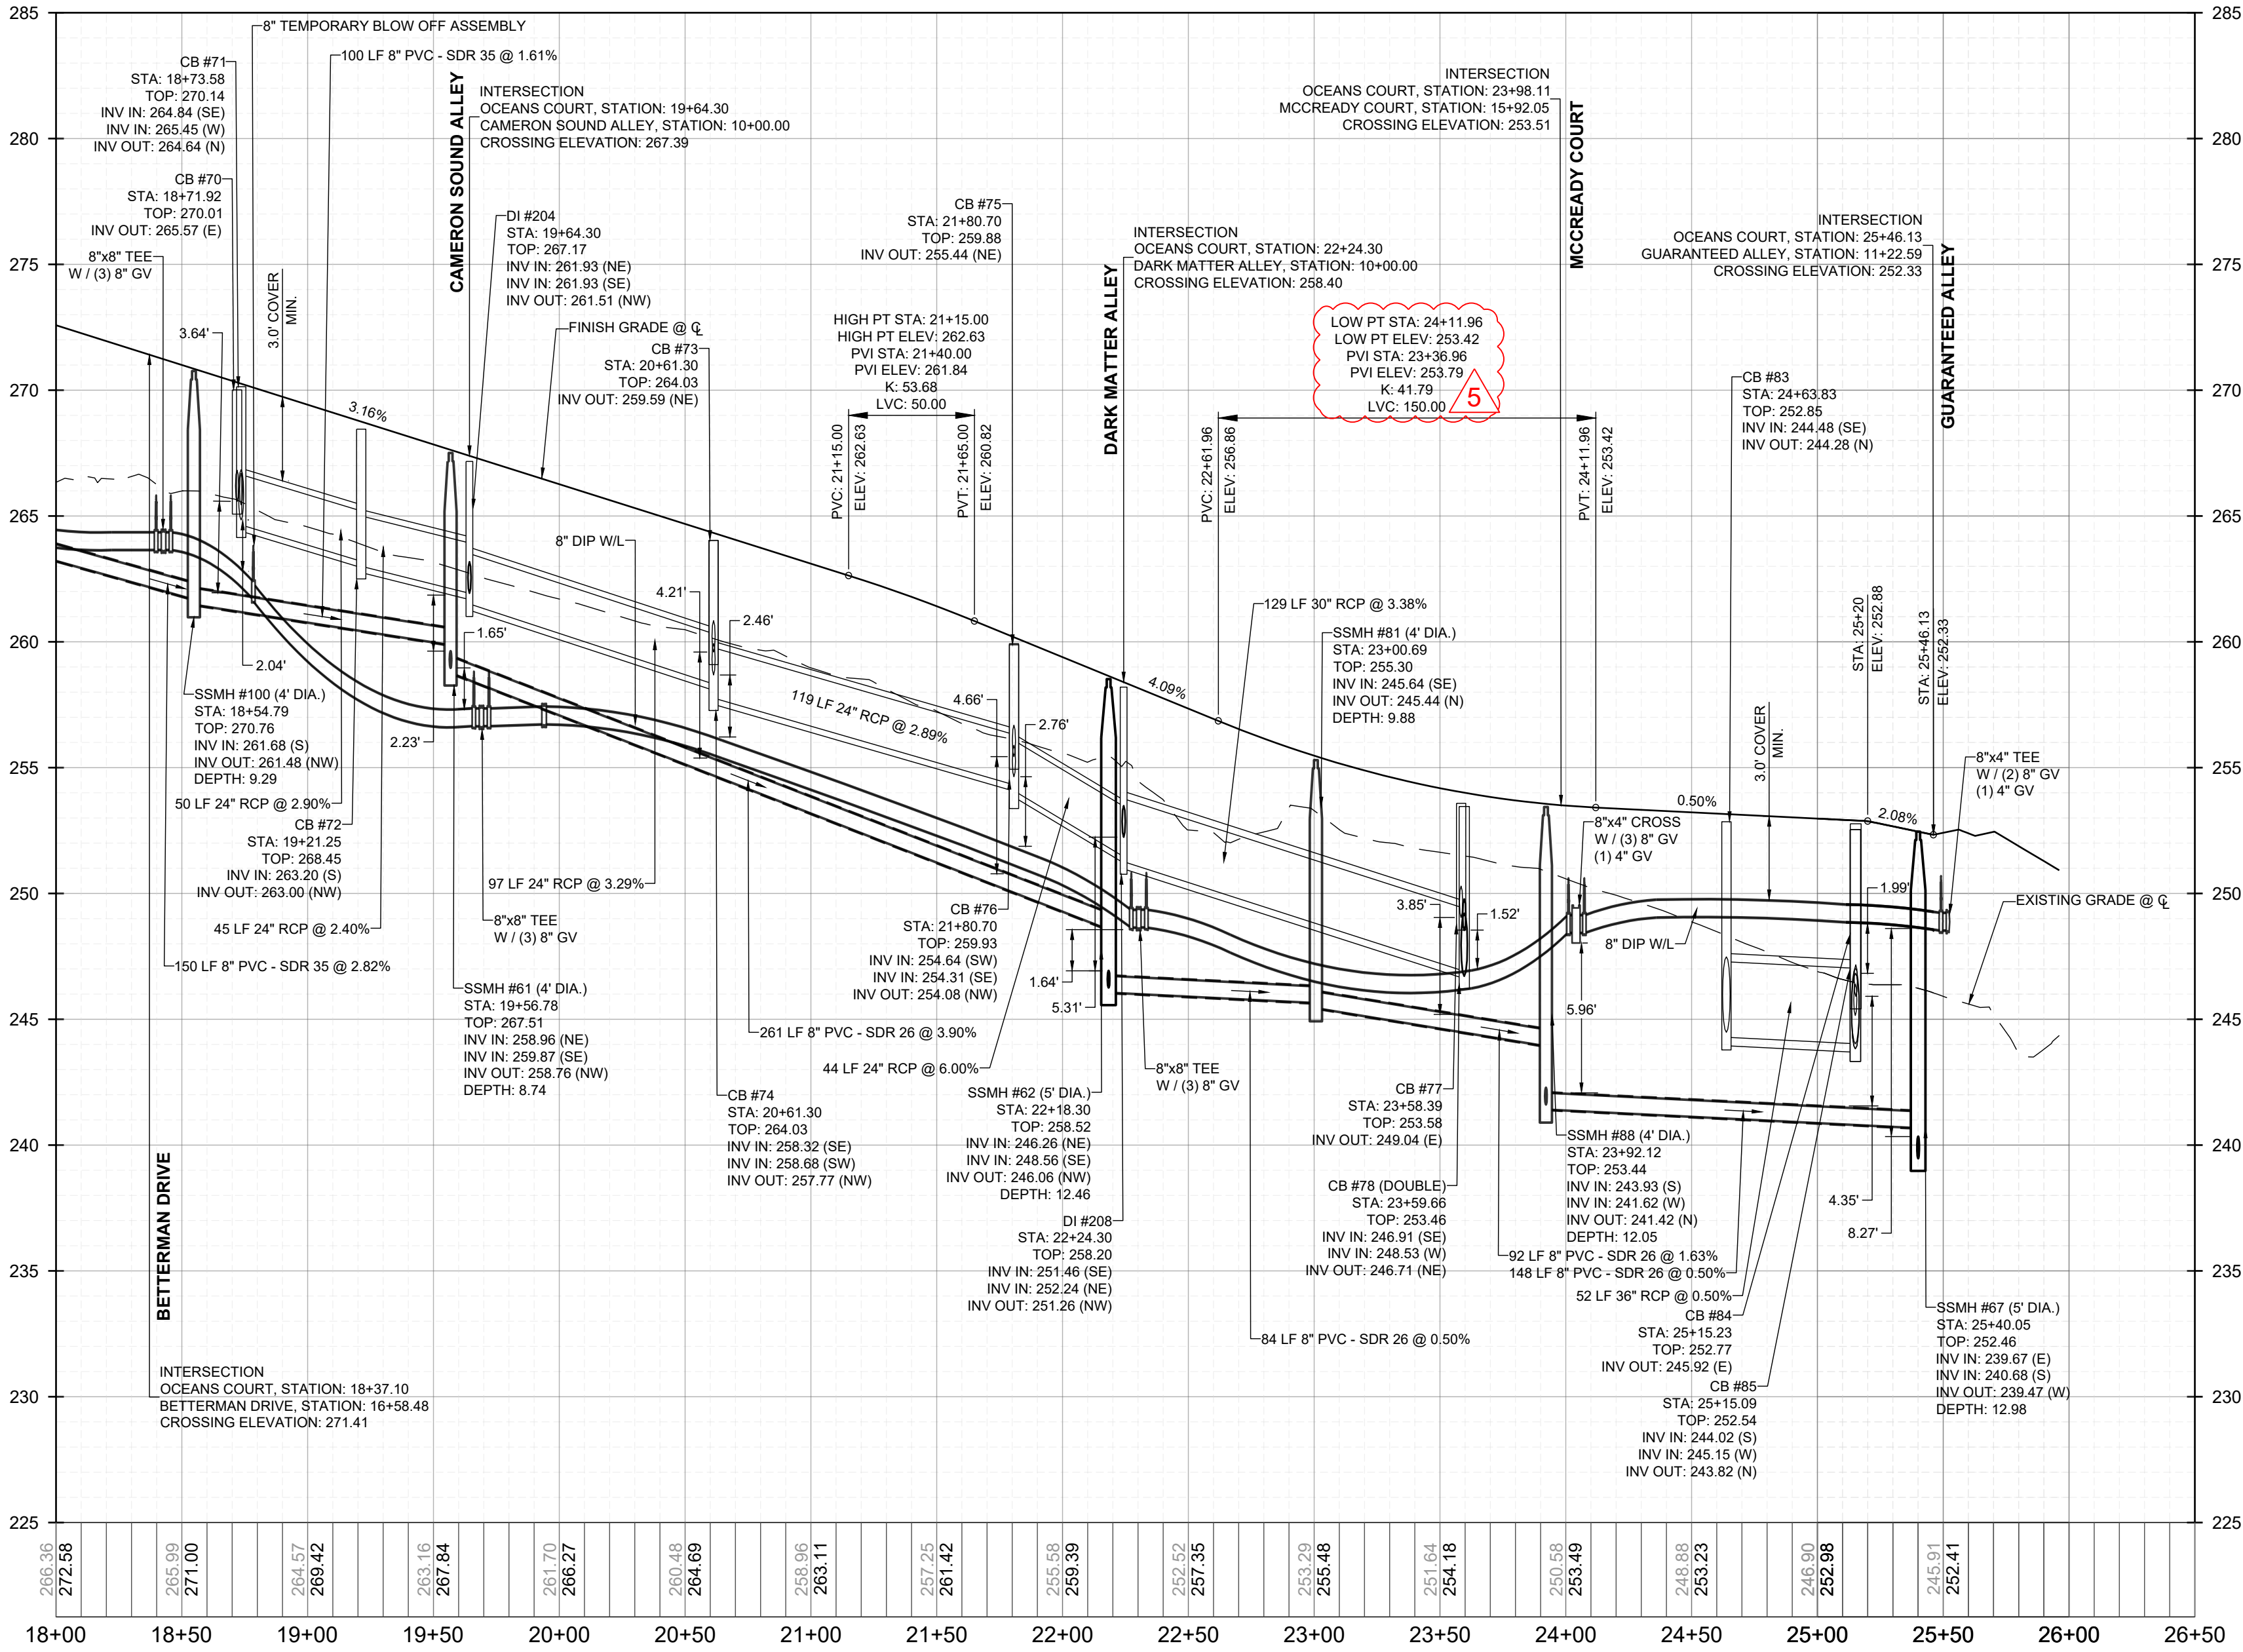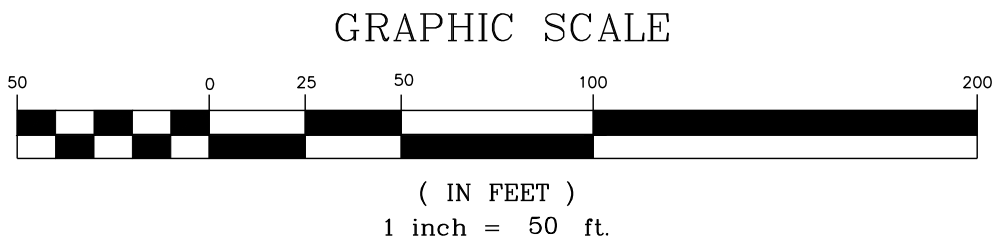

PROPOSED OCEANS COURT - PROFILE
VERTICAL: 1" = 5'
HORIZONTAL: 1" = 50'

PUBLIC
WATER DISTRIBUTION / EXTENSION SYSTEM
THE CITY OF RALEIGH CONSENTS TO THE CONNECTION AND EXTENSION OF THE CITY'S PUBLIC WATER SYSTEM AS SHOWN ON THIS PLAN. THE MATERIAL AND CONSTRUCTION METHODS USED FOR THIS PROJECT SHALL CONFORM TO THE STANDARDS AND SPECIFICATIONS OF THE CITY'S PUBLIC UTILITIES HANDBOOK. CITY OF RALEIGH
PUBLIC UTILITIES DEPARTMENT PERMIT # _____

PUBLIC
SEWER COLLECTION / EXTENSION SYSTEM
THE CITY OF RALEIGH CONSENTS TO THE CONNECTION AND EXTENSION OF THE CITY'S PUBLIC SEWER SYSTEM AS SHOWN ON THIS PLAN. THE MATERIAL AND CONSTRUCTION METHODS USED FOR THIS PROJECT SHALL CONFORM TO THE STANDARDS AND SPECIFICATIONS OF THE CITY'S PUBLIC UTILITIES HANDBOOK. CITY OF RALEIGH
PUBLIC UTILITIES DEPARTMENT PERMIT # _____


CONSTRUCTION INFRASTRUCTURE DRAWINGS		REVISIONS		BY
NO.	DESCRIPTION	NO.	DESCRIPTION	DATE
01	TOWN OF ROLESVILLE CID-24-04 V1			
02	TOWN OF ROLESVILLE CID-24-04 V2			
03	TOWN OF ROLESVILLE CID-24-04 V3			
04	TOWN OF ROLESVILLE CID-24-04 V4			
05	TOWN OF ROLESVILLE CID-24-04 V5			

STRONGROCK
ENGINEERING GROUP
STRONG ROCK ENGINEERING GROUP, PLLC | COMPANY LICENSE # P-2166
305 CHURCH AT NORTH HILLS STREET, SUITE 1110 RALEIGH, NC 27609 | INFORMATION@STRONGROCKGROUP.COM



STRONG ROCK PROJECT PSP-24-03	NOT FOR CONSTRUCTION	SCALE AS SHOWN	SRG	SRG	SRG
DESIGNED BY	DRAWN BY	CHECKED BY			

RESERVE @ MITCHELL MILL
TOWN OF ROLESVILLE, WAKE COUNTY, NORTH CAROLINA
CONSTRUCTION PLANS
PROPOSED OCEANS COURT -
PLAN & PROFILE

DRAWING
SHEET
C-11.4

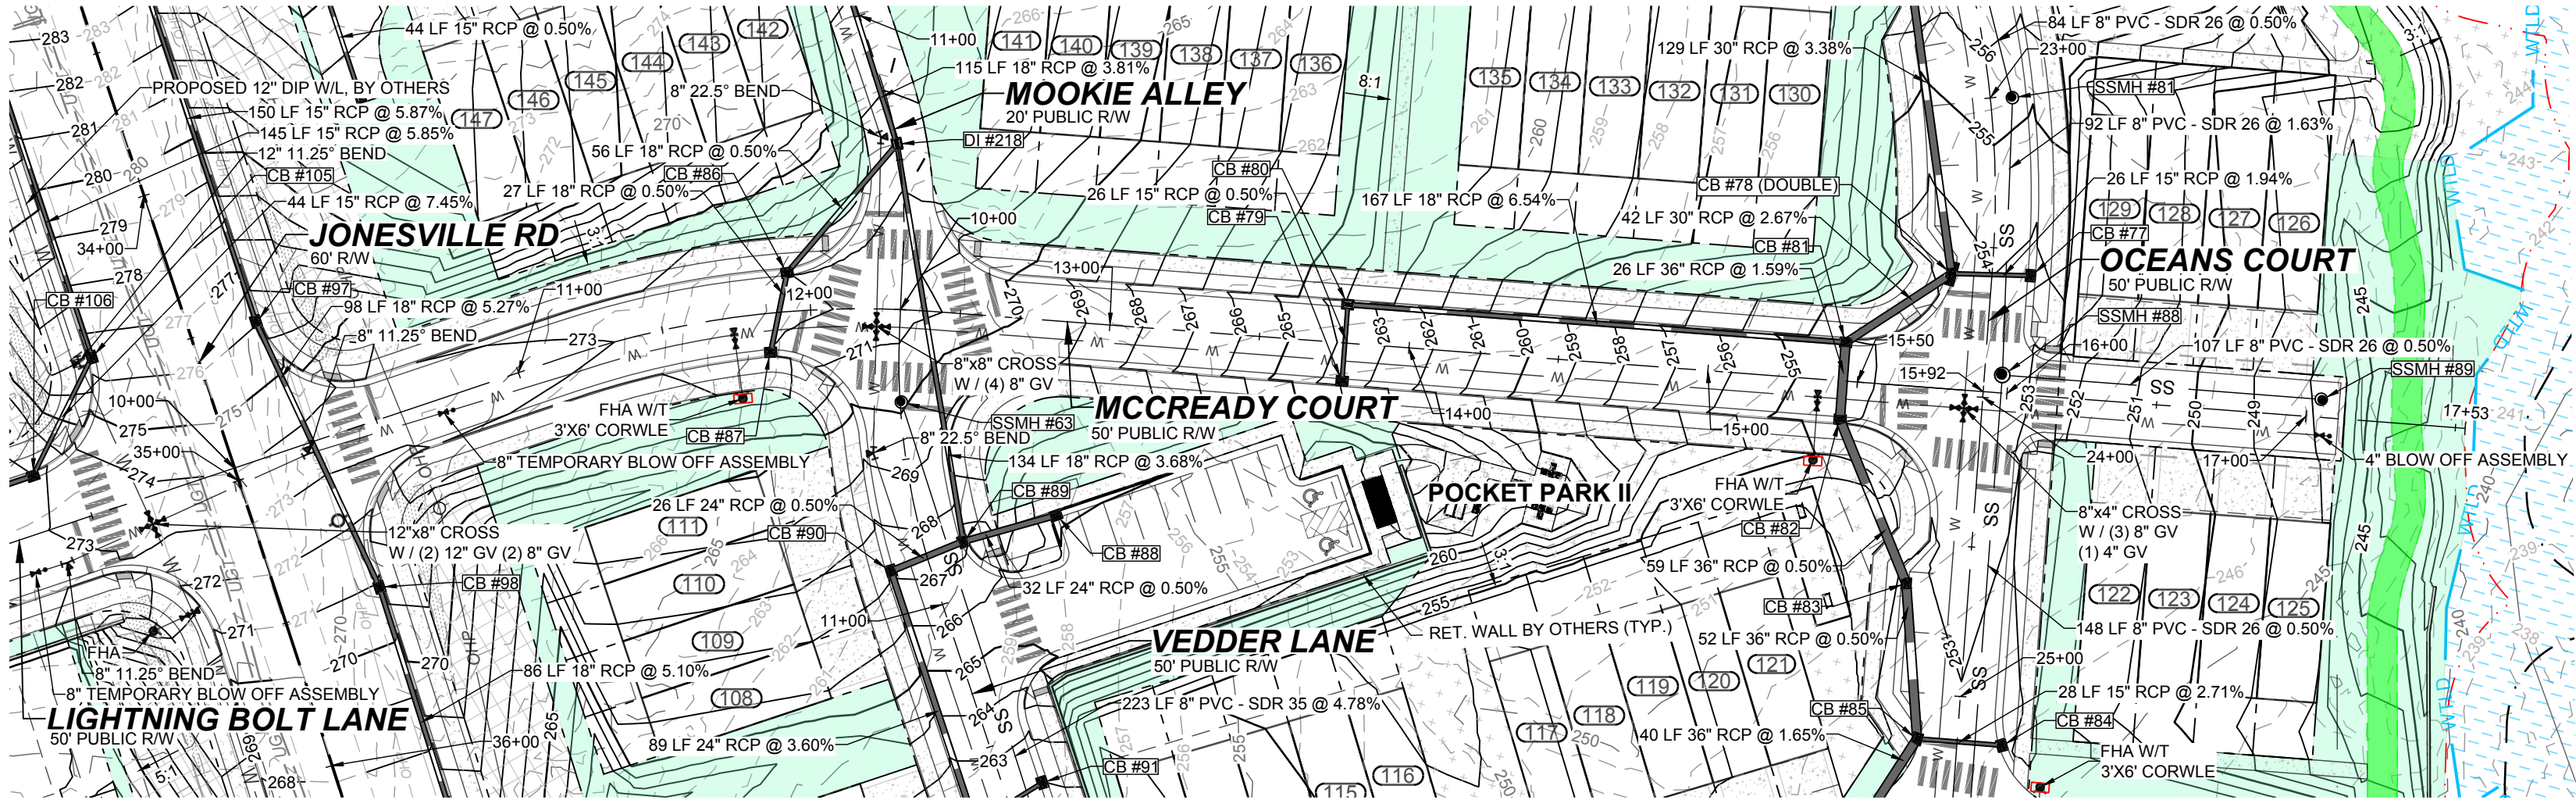

PROPOSED MCCREADY COURT - PLAN
HORIZONTAL: 1" = 50'

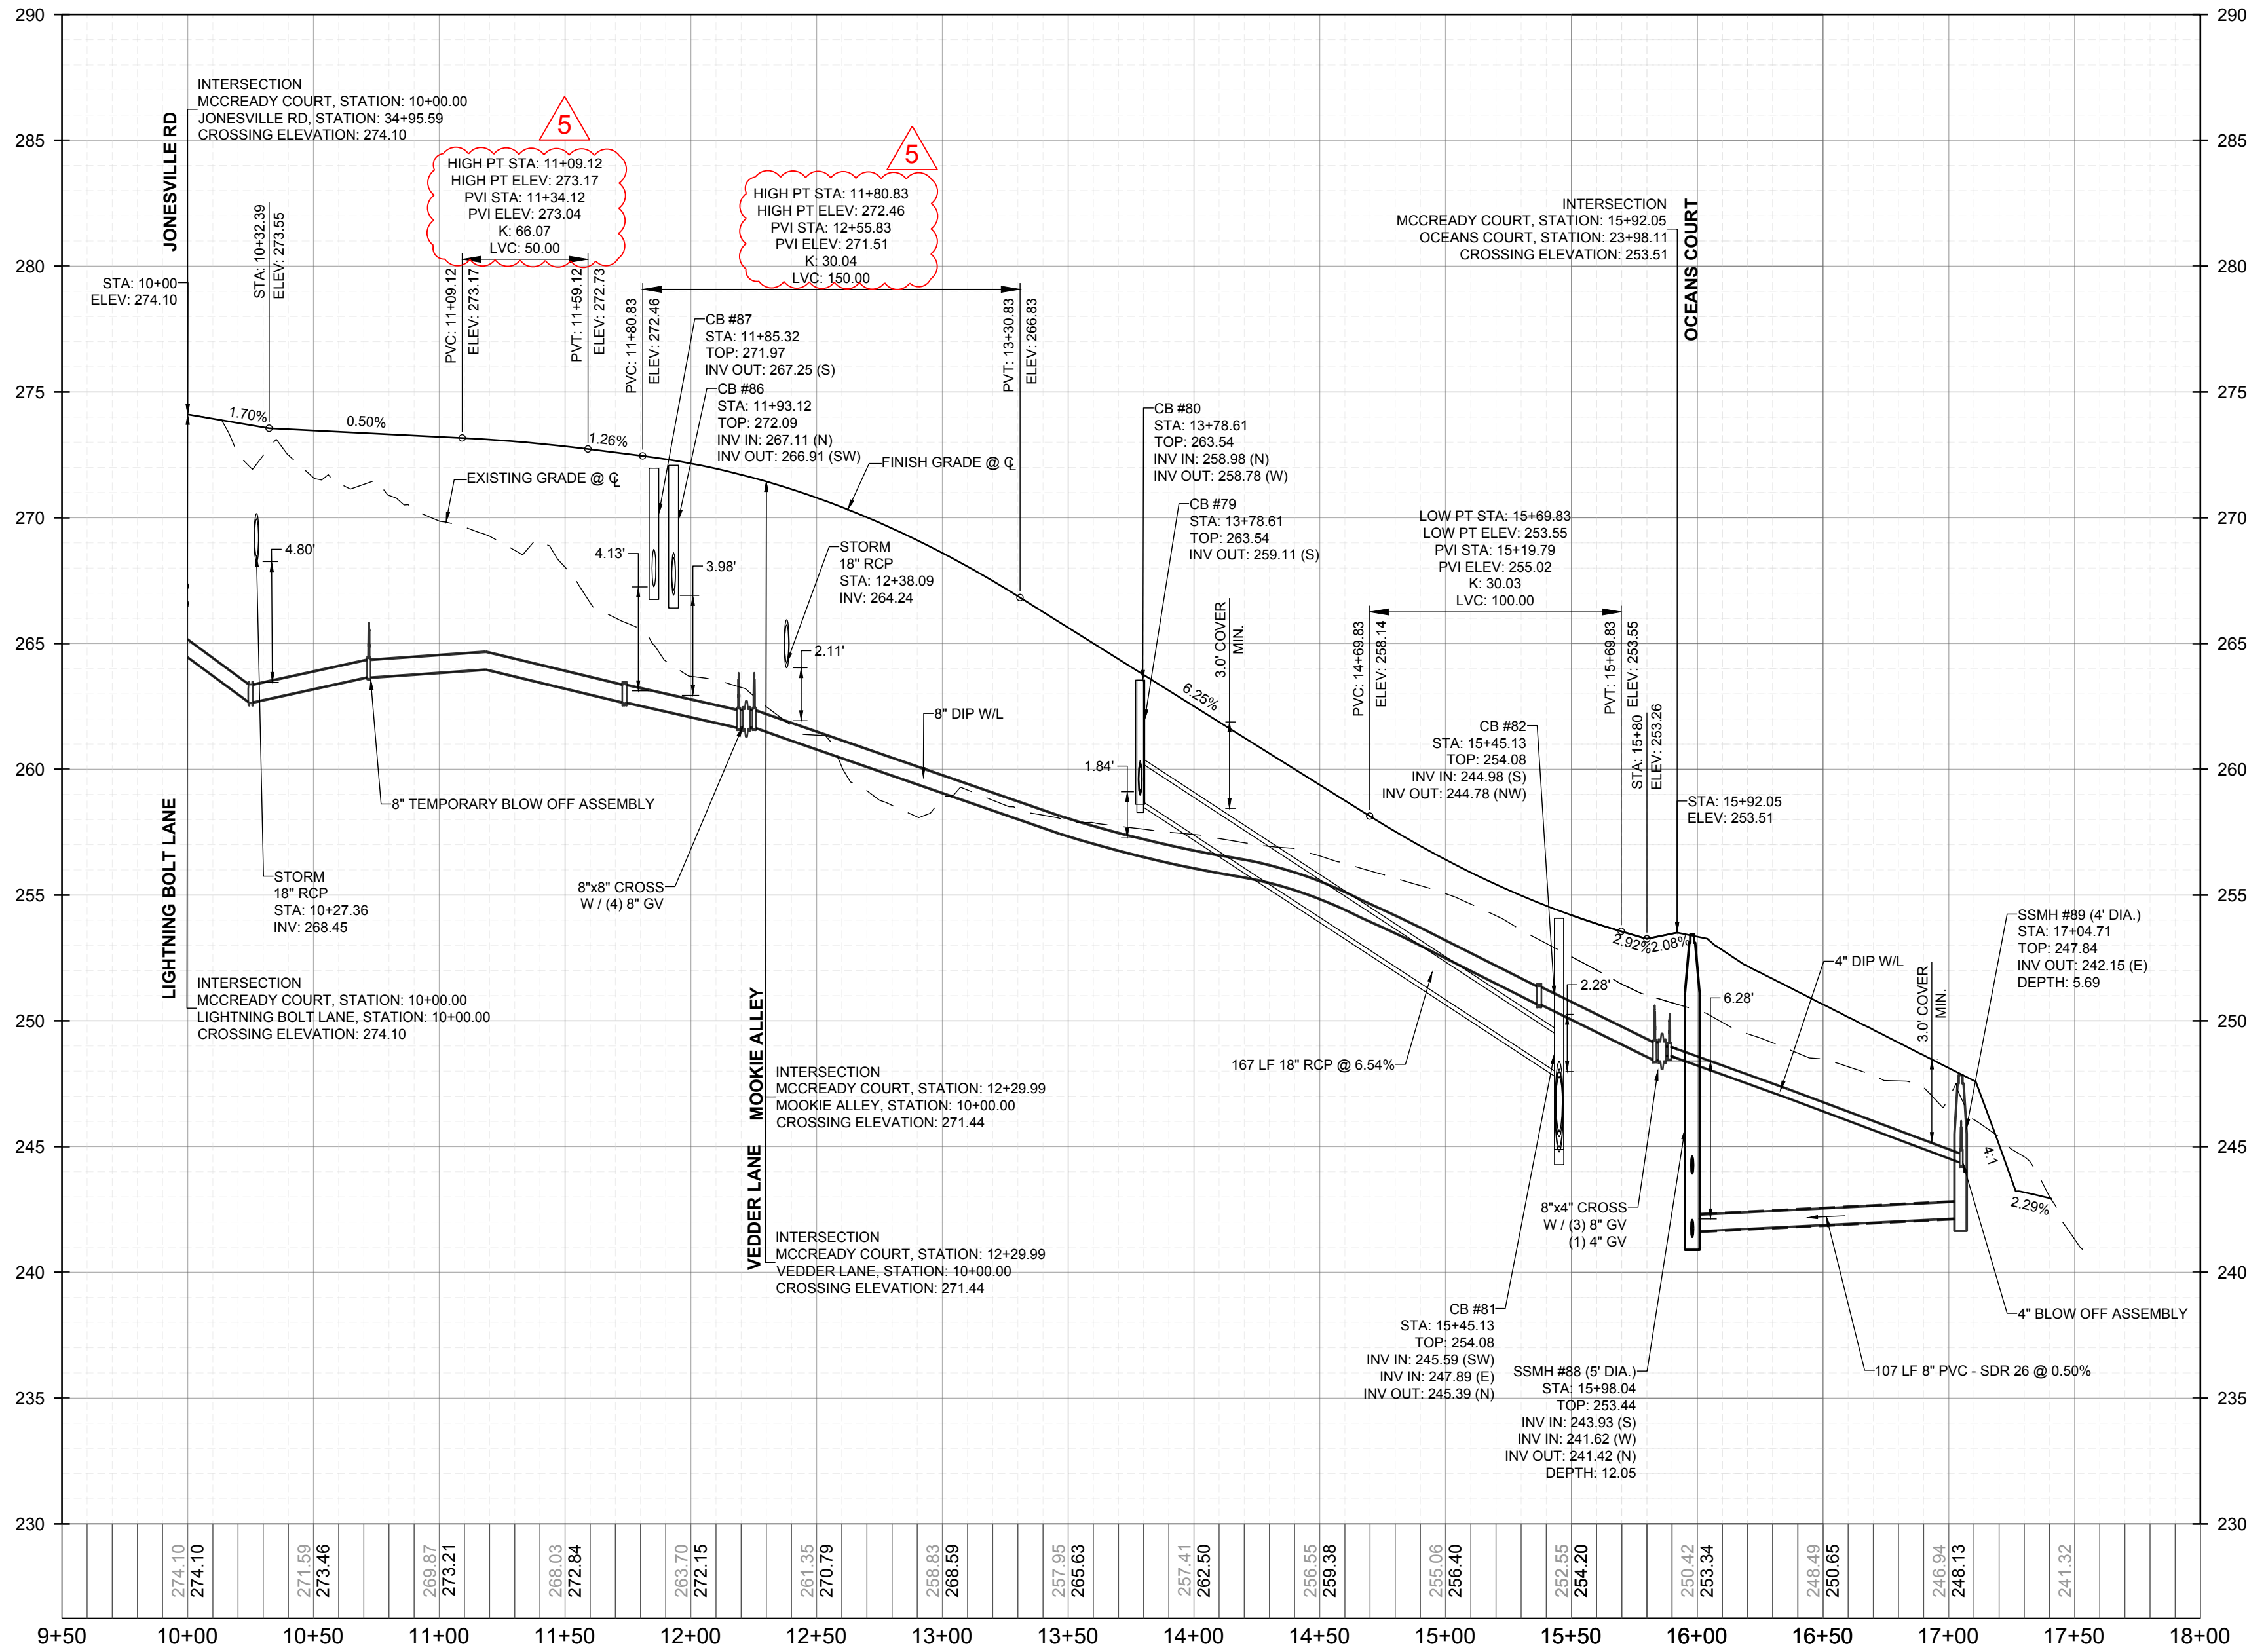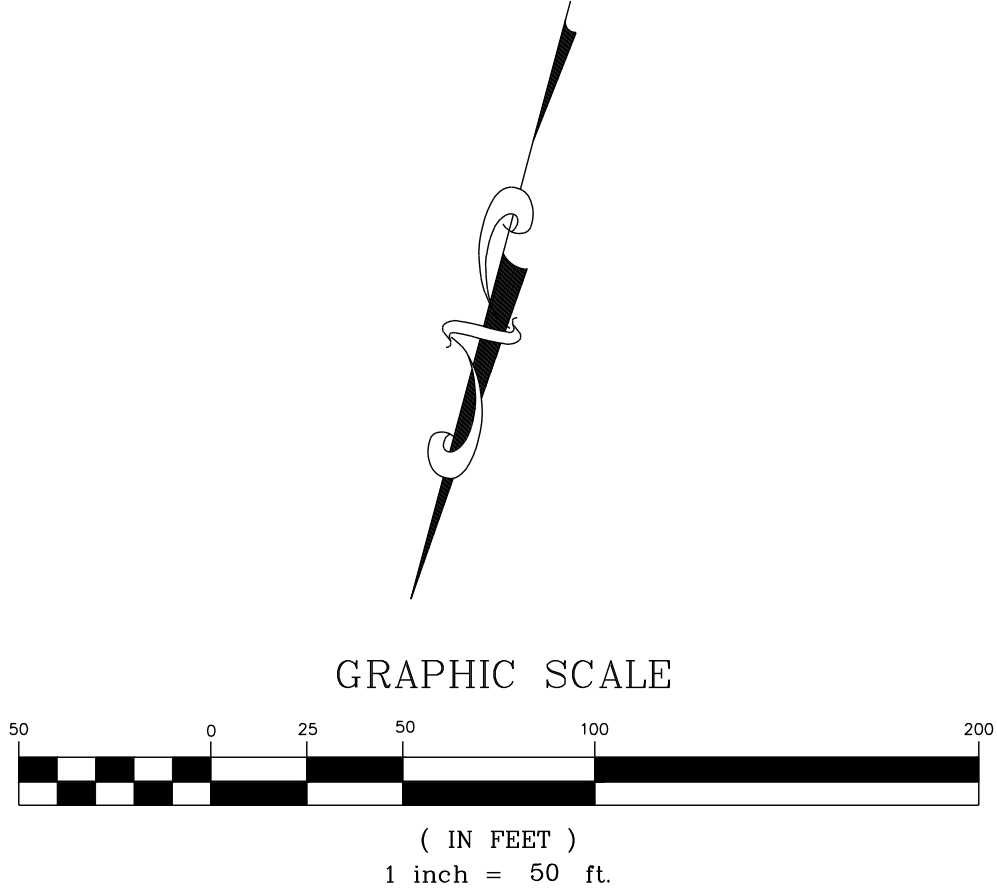

PROPOSED MCCREADY COURT - PROFILE
VERTICAL: 1" = 5'
HORIZONTAL: 1" = 50'

PUBLIC
WATER DISTRIBUTION / EXTENSION SYSTEM
THE CITY OF RALEIGH CONSENTS TO THE CONNECTION AND EXTENSION OF THE CITY'S PUBLIC WATER SYSTEM AS SHOWN ON THIS PLAN. THE MATERIAL AND CONSTRUCTION METHODS USED FOR THIS PROJECT SHALL CONFORM TO THE STANDARDS AND SPECIFICATIONS OF THE CITY'S PUBLIC UTILITIES HANDBOOK. CITY OF RALEIGH
PUBLIC UTILITIES DEPARTMENT PERMIT # _____

PUBLIC
SEWER COLLECTION / EXTENSION SYSTEM
THE CITY OF RALEIGH CONSENTS TO THE CONNECTION AND EXTENSION OF THE CITY'S PUBLIC SEWER SYSTEM AS SHOWN ON THIS PLAN. THE MATERIAL AND CONSTRUCTION METHODS USED FOR THIS PROJECT SHALL CONFORM TO THE STANDARDS AND SPECIFICATIONS OF THE CITY'S PUBLIC UTILITIES HANDBOOK. CITY OF RALEIGH
PUBLIC UTILITIES DEPARTMENT PERMIT # _____

CONSTRUCTION INFRASTRUCTURE DRAWINGS		REVISIONS		BY
01	CID-34-04	No.	DATE	
02	TOWN OF ROLESVILLE CID-34-04 V2			
03	TOWN OF ROLESVILLE CID-34-04 V3			
04	TOWN OF ROLESVILLE CID-34-04 V4			
05	TOWN OF ROLESVILLE CID-34-04 V5			

STRONGROCK

ENGINEERING GROUP



STRONG ROCK ENGINEERING GROUP, PLLC | COMPANY LICENSE # P-2166
305 CHURCH AT NORTH HILLS STREET, SUITE 1110 RALEIGH, NC 27609 | INFORMATION@STRONGROCKGROUP.COM

STRONG ROCK PROJECT	NOT FOR CONSTRUCTION	SCALE	SRG	SRG	SRG
PSP-23-03		AS SHOWN	DESIGNED BY	DRAWN BY	CHECKED BY

RESERVE @ MITCHELL MILL
TOWN OF ROLESVILLE, WAKE COUNTY, NORTH CAROLINA
CONSTRUCTION PLANS
PROPOSED MCCREADY COURT -
PLAN & PROFILE

DRAWING
SHEET

C-11.5

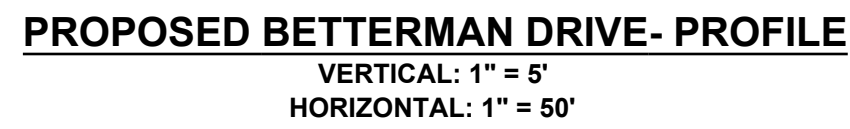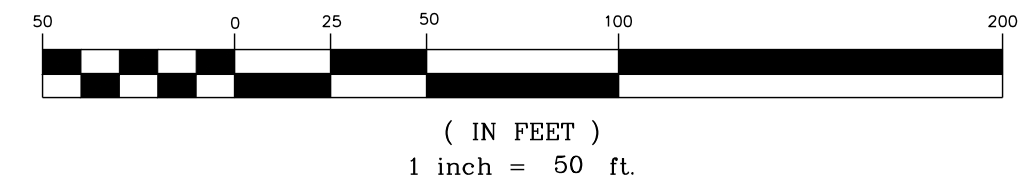

STRONG ROCK PROJECT		STRONG ROCK PROJECT			STRONGROCK E N G I N E E R I N G G R O U P	STRONG ROCK ENGINEERING GROUP, PLLC COMPANY LICENSE # P-2166
FSP-23-03		NOT FOR CONSTRUCTION				305 CHURCH AT NORTH HILLS STREET, SUITE 1110 RALEIGH, NC 27609 INFORMATION@STRONGROCKGROUP.COM
SCALE		AS SHOWN				
DESIGNED BY		SRG				
DRAWN BY		SRG				
CHECKED BY		SRG				

RESERVE @ MITCHELL MILL
TOWN OF ROLESVILLE, WAKE COUNTY, NORTH CAROLINA

CONSTRUCTION PLANS

**PROPOSED VEDDER LANE &
BETTERMAN DRIVE - PLAN & PROFILE**

DRAWING SHEET

C-11.6

102 OF 230

CONSTRUCTION INFRASTRUCTURE DRAWINGS		SEAL:		REVISIONS		BY	
01	08/04/2024	SR	CD-34-04	01			
02	11/01/2024	SR	TOWN OF ROLESVILLE CD-34-04 V2	02			
03	02/07/2024	SR	TOWN OF ROLESVILLE CD-34-04 V3	03			
04	06/02/2024	SR	TOWN OF ROLESVILLE CD-34-04 V4	04			
05	08/02/2025	SR	TOWN OF ROLESVILLE CD-34-04 V5	05			
				No.		DATE	

STRONGROCK

ENGINEERING GROUP

STRONG ROCK ENGINEERING GROUP, PLLC | COMPANY LICENSE # P-2166
305 CHURCH AT NORTH HILLS STREET, SUITE 1110 RALEIGH, NC 27609 | INFORMATION@STRONGROCKGROUP.COM


STRONG ROCK PROJECT	NOT FOR CONSTRUCTION	SCALE	AS SHOWN	SRG	SRG	SRG
PSP-24-03				DESIGNED BY	DRAWN BY	CHECKED BY

RESERVE @ MITCHELL MILL
TOWN OF ROLESVILLE, WAKE COUNTY, NORTH CAROLINA
CONSTRUCTION PLANS
PROPOSED LIGHTNING BOLT LANE -
PLAN & PROFILE


DRAWING
SHEET

C-11.7

THIS PLANSET AND ANY ASSOCIATED DOCUMENTS ARE PRELIMINARY AND NOT AUTHORIZED FOR CONSTRUCTION UNTIL SIGNED, DATED, AND OFFICIALLY RELEASED FOR CONSTRUCTION BY THE ENGINEER OF RECORD.

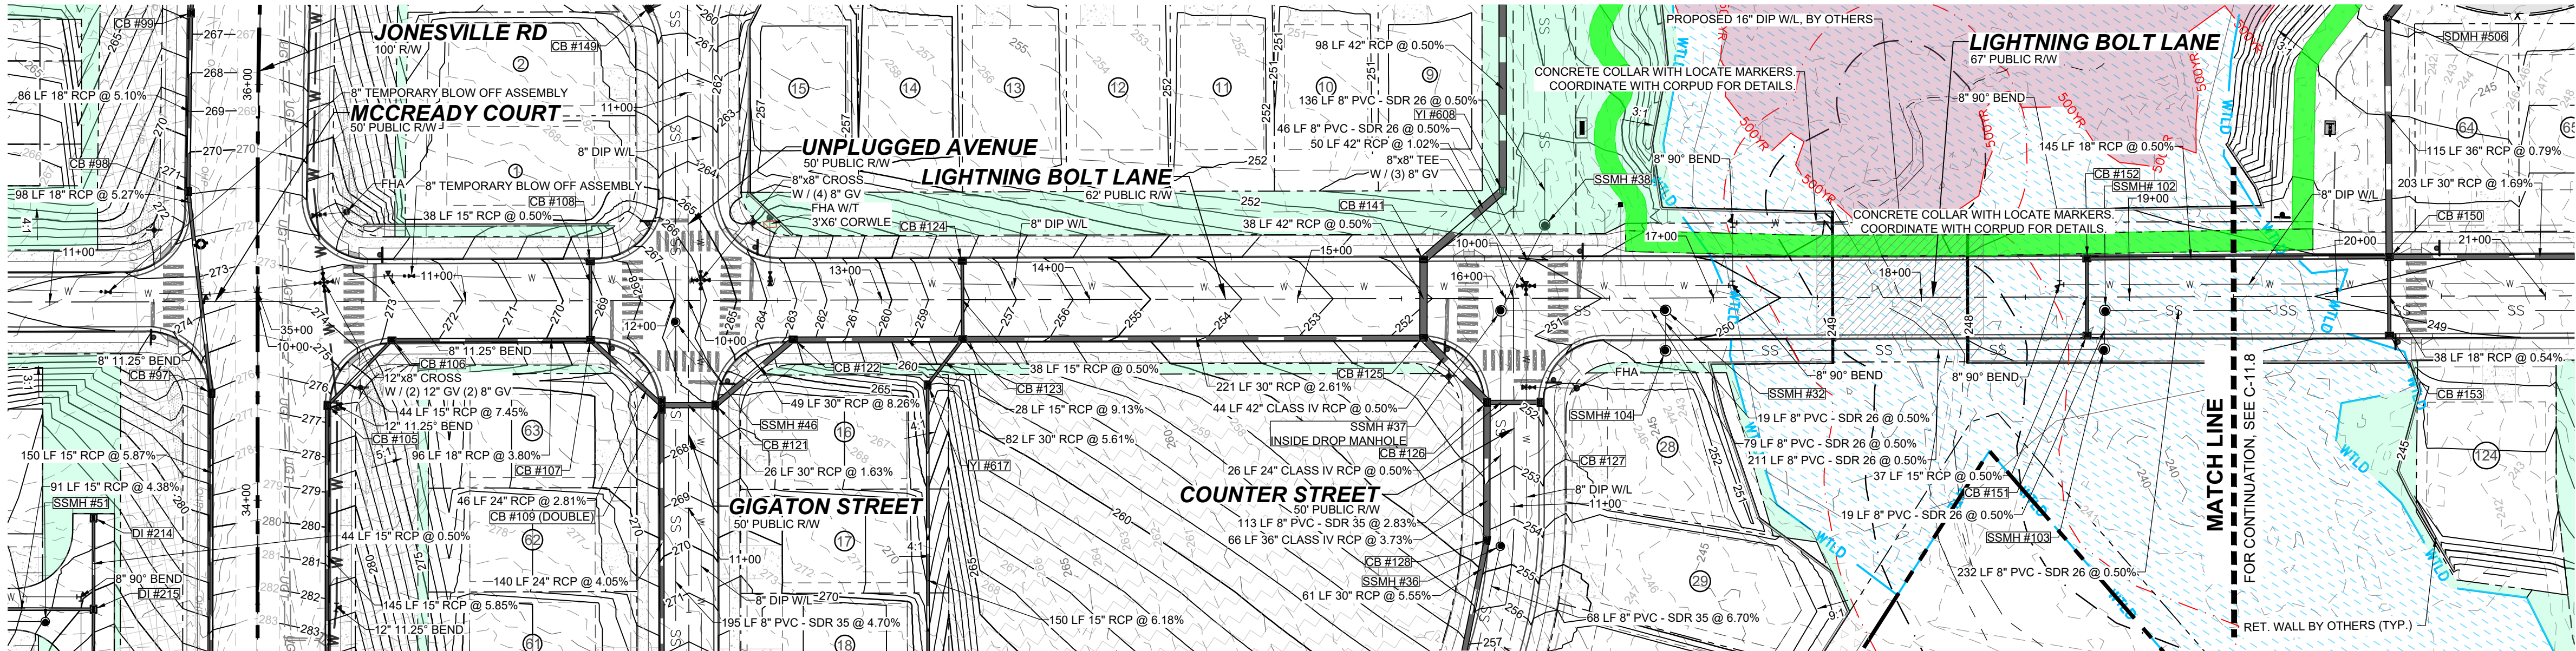


PROPOSED LIGHTNING BOLT LANE - PLAN
HORIZONTAL: 1" = 50'

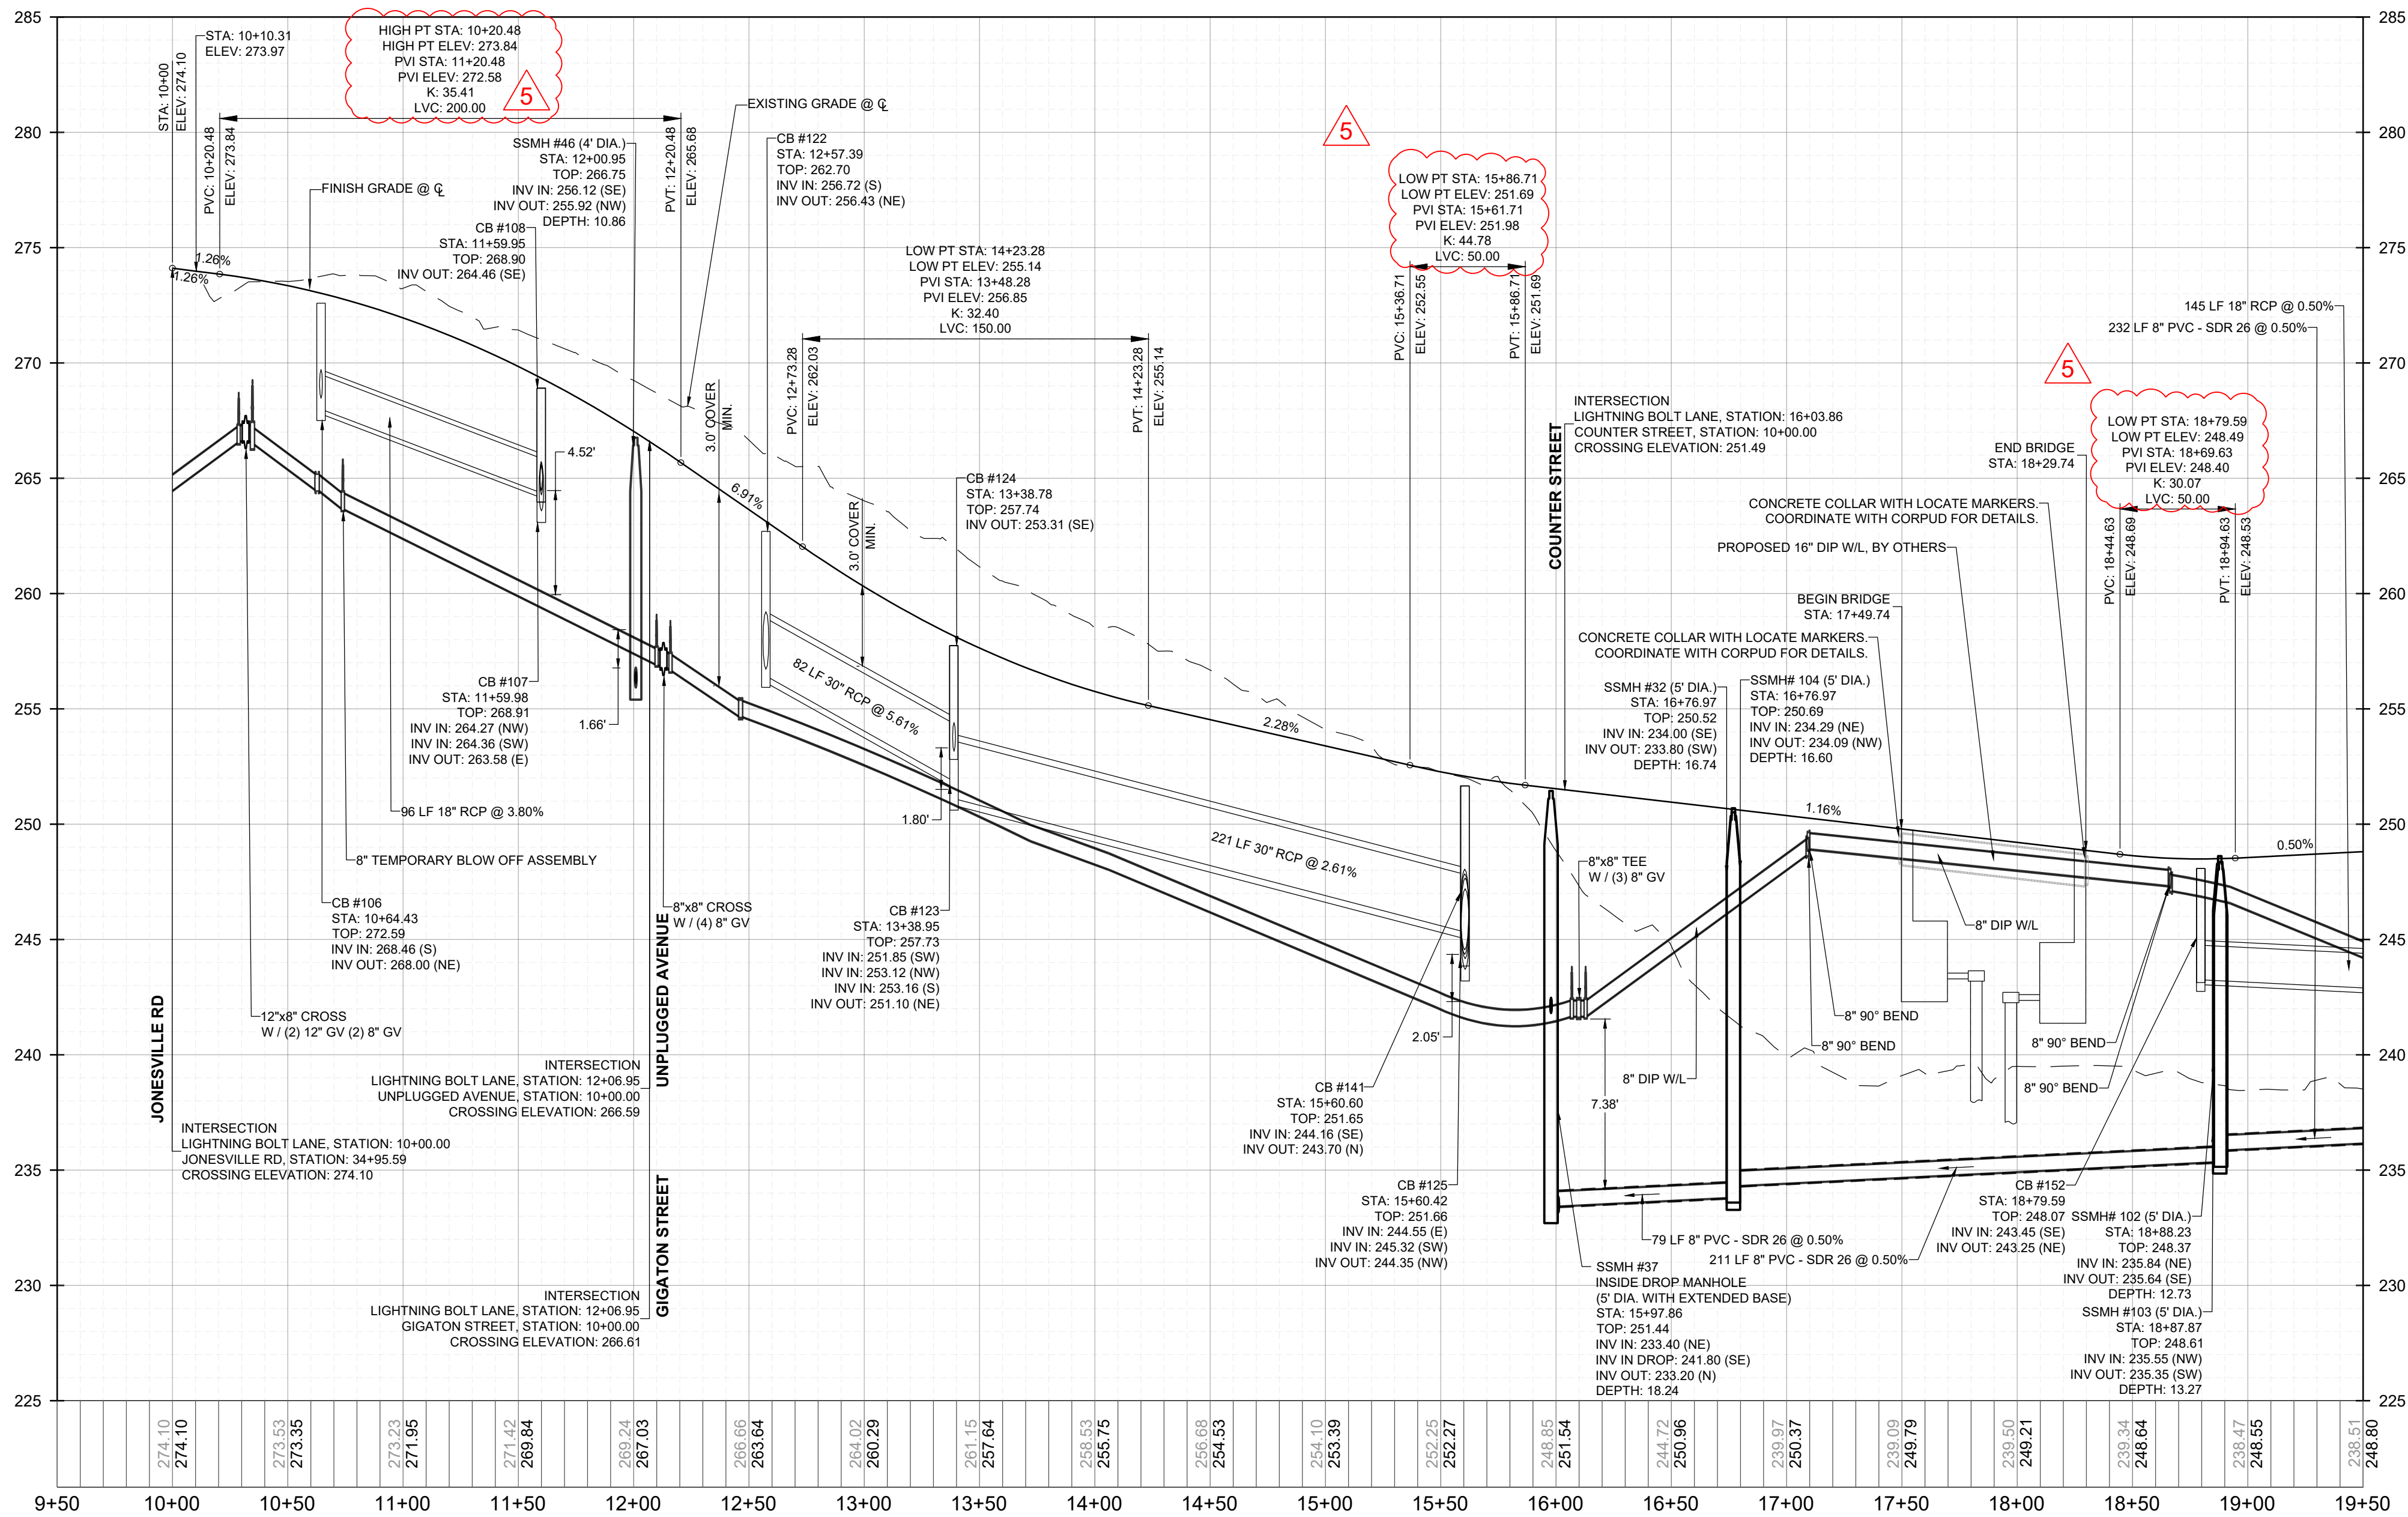

PROPOSED LIGHTNING BOLT LANE - PROFILE
VERTICAL: 1" = 5'
HORIZONTAL: 1" = 50'


PUBLIC
WATER DISTRIBUTION / EXTENSION SYSTEM
THE CITY OF RALEIGH CONSENTS TO THE CONNECTION AND EXTENSION OF THE CITY'S PUBLIC WATER SYSTEM AS SHOWN ON THIS PLAN. THE MATERIAL AND CONSTRUCTION METHODS USED FOR THIS PROJECT SHALL CONFORM TO THE STANDARDS AND SPECIFICATIONS OF THE CITY'S PUBLIC UTILITIES HANDBOOK. CITY OF RALEIGH
PUBLIC UTILITIES DEPARTMENT PERMIT # _____

PUBLIC
SEWER COLLECTION / EXTENSION SYSTEM
THE CITY OF RALEIGH CONSENTS TO THE CONNECTION AND EXTENSION OF THE CITY'S PUBLIC SEWER SYSTEM AS SHOWN ON THIS PLAN. THE MATERIAL AND CONSTRUCTION METHODS USED FOR THIS PROJECT SHALL CONFORM TO THE STANDARDS AND SPECIFICATIONS OF THE CITY'S PUBLIC UTILITIES HANDBOOK. CITY OF RALEIGH
PUBLIC UTILITIES DEPARTMENT PERMIT # _____

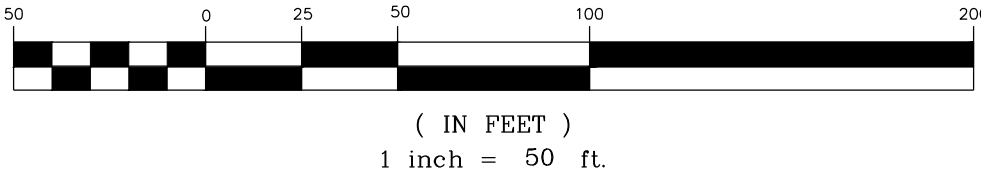

GRAPHIC SCALE

(IN FEET)
1 inch = 50 ft

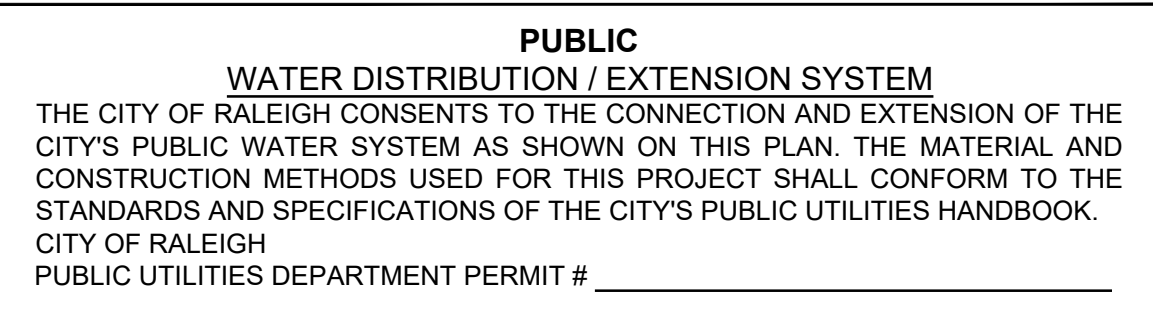

PUBLIC
SEWER COLLECTION / EXTENSION SYSTEM

THE CITY OF RALEIGH CONSENTS TO THE CONNECTION AND EXTENSION OF THE CITY'S PUBLIC SEWER SYSTEM AS SHOWN ON THIS PLAN. THE MATERIAL AND CONSTRUCTION METHODS USED FOR THIS PROJECT SHALL CONFORM TO THE STANDARDS AND SPECIFICATIONS OF THE CITY'S PUBLIC UTILITIES HANDBOOK. CITY OF RALEIGH

PUBLIC UTILITIES DEPARTMENT PERMIT # _____

STRONGROCK
ENGINEERING GROUP
STRONG ROCK ENGINEERING GROUP, PLLC | COMPANY LICENSE # P-2166

STRONG ROCK ENGINEERING GROUP, PLLC | COMPANY LICENSE # P-2166

STRONG ROCK PROJECT PSP-23-03	NOT FOR CONSTRUCTION	SCALE	AS SHOWN
		DESIGNED BY	SRG
		DRAWN BY	SRG
		CHECKED BY	SRG


RESERVE @ MITCHELL MILL
TOWN OF ROLLESVILLE, WAKE COUNTY, NORTH CAROLINA
CONSTRUCTION PLANS
PROPOSED LIGHTING BOLT LANE
PLAN & PROFILE

DRAWING
SHEET


C-11.8

104 OF 230


THIS PLANSET AND ANY ASSOCIATED DOCUMENTS ARE PRELIMINARY AND NOT AUTHORIZED FOR CONSTRUCTION UNTIL SIGNED, DATED, AND OFFICIALLY RELEASED FOR CONSTRUCTION BY THE ENGINEER OF RECORD.

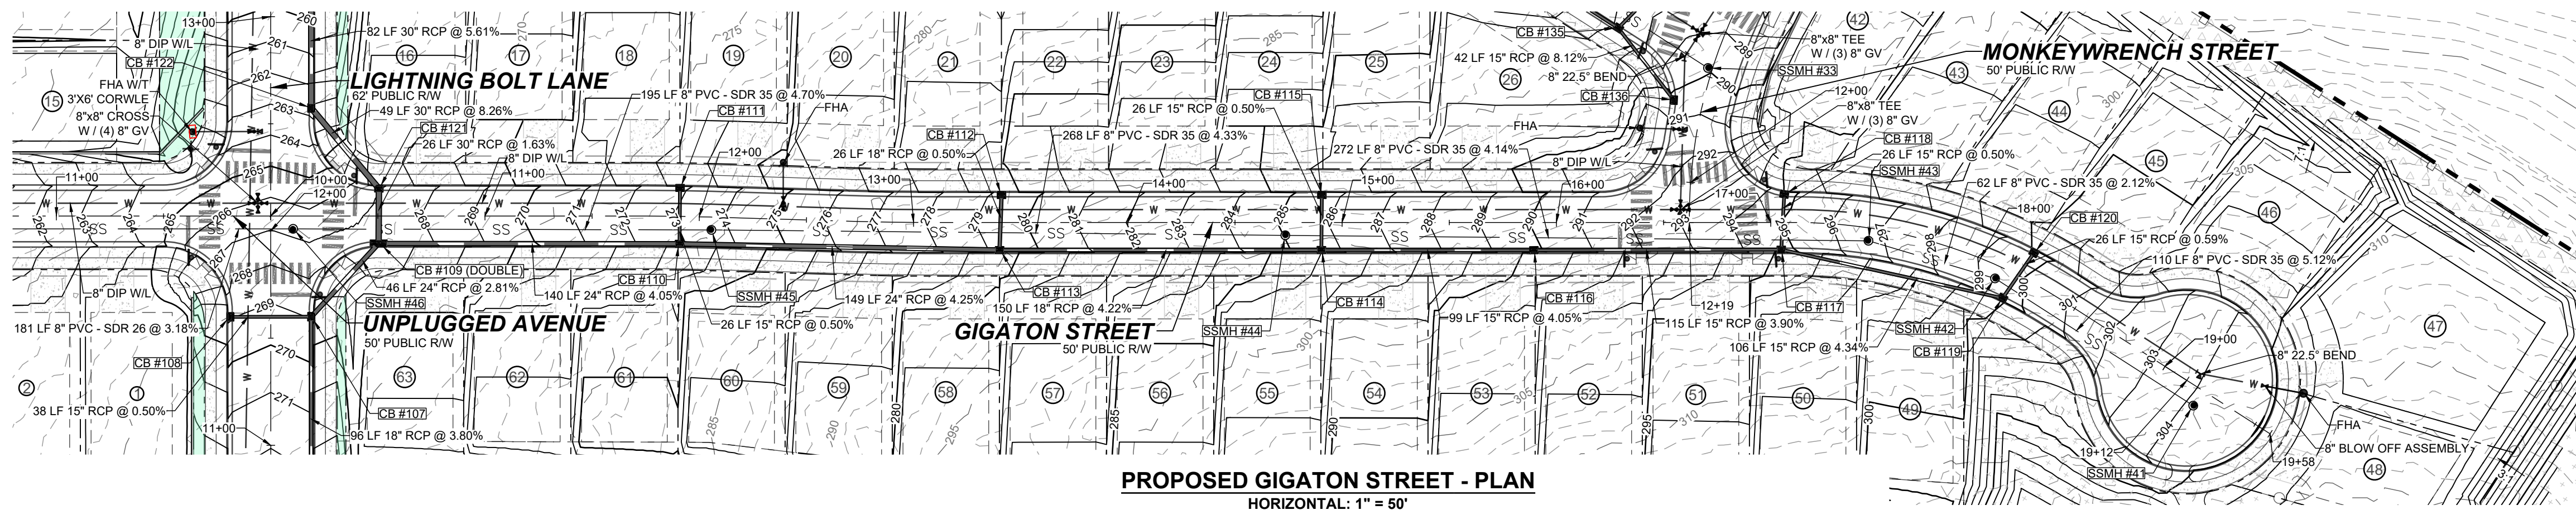

PROPOSED GIGATON STREET - PLAN
HORIZONTAL: 1" = 50'

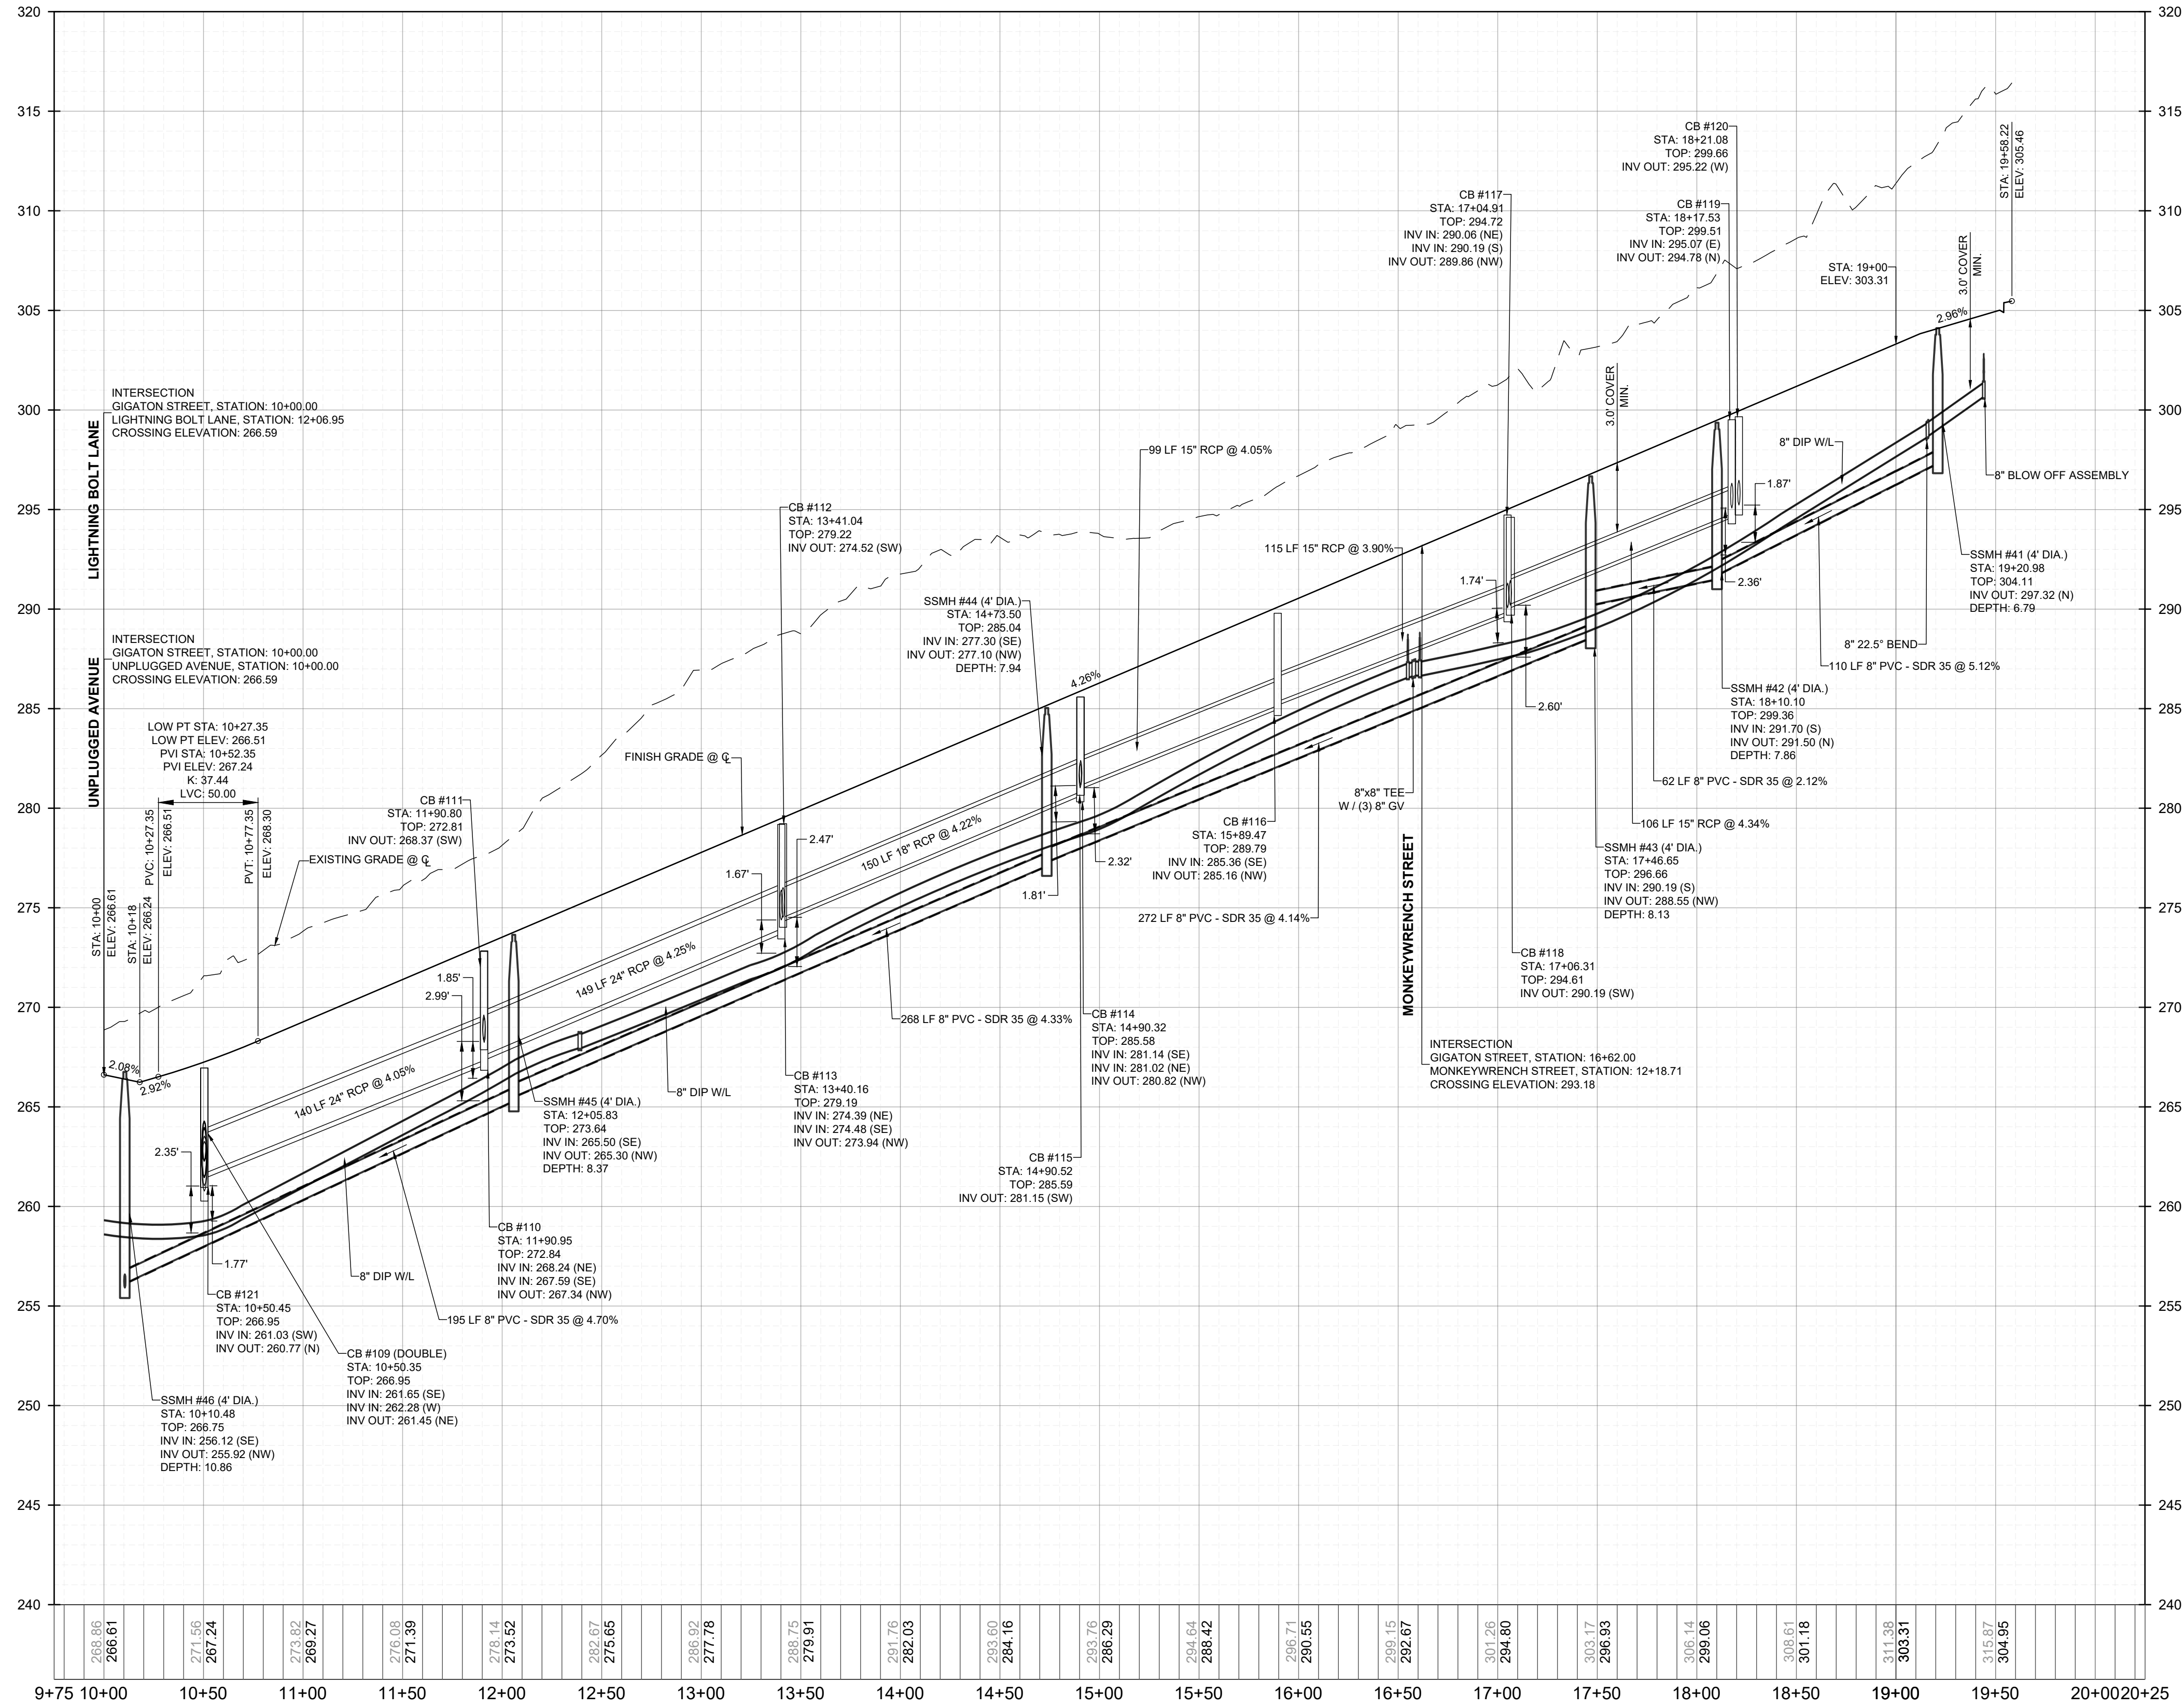

PROPOSED GIGATON STREET - PROFILE
VERTICAL: 1" = 5'
HORIZONTAL: 1" = 50'

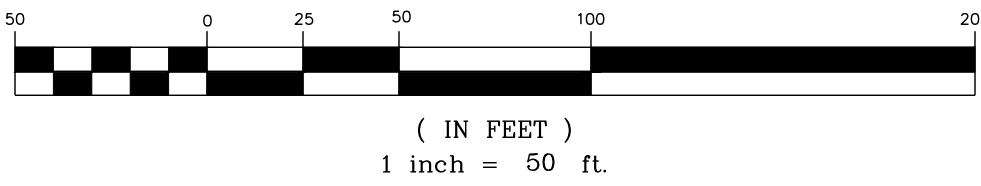

PUBLIC
WATER DISTRIBUTION / EXTENSION SYSTEM
THE CITY OF RALEIGH CONSENTS TO THE CONNECTION AND EXTENSION OF THE CITY'S PUBLIC WATER SYSTEM AS SHOWN ON THIS PLAN. THE MATERIAL AND CONSTRUCTION METHODS USED FOR THIS PROJECT SHALL CONFORM TO THE STANDARDS AND SPECIFICATIONS OF THE CITY'S PUBLIC UTILITIES HANDBOOK.
CITY OF RALEIGH
PUBLIC UTILITIES DEPARTMENT PERMIT # _____

PUBLIC
SEWER COLLECTION / EXTENSION SYSTEM
THE CITY OF RALEIGH CONSENTS TO THE CONNECTION AND EXTENSION OF THE CITY'S PUBLIC SEWER SYSTEM AS SHOWN ON THIS PLAN. THE MATERIAL AND CONSTRUCTION METHODS USED FOR THIS PROJECT SHALL CONFORM TO THE STANDARDS AND SPECIFICATIONS OF THE CITY'S PUBLIC UTILITIES HANDBOOK.
CITY OF RALEIGH
PUBLIC UTILITIES DEPARTMENT PERMIT # _____

CONSTRUCTION INFRASTRUCTURE DRAWINGS	DATE	BY
01	08/04/2024	
02	11/01/2024	
03	02/01/2024	
04	09/02/2025	
05	09/02/2025	
No.		
	REVISIONS	

STRONGROCK


ENGINEERING GROUP

STRONG ROCK ENGINEERING GROUP, PLLC | COMPANY LICENSE # P-2166
305 CHURCH AT NORTH HILLS STREET, SUITE 1110 RALEIGH, NC 27609 | INFORMATION@STRONGROCKGROUP.COM


STRONG ROCK PROJECT	NOT FOR CONSTRUCTION	SCALE	DESIGNED BY	DRAWN BY	CHECKED BY
PSP-24-03	AS SHOWN	SRG			

RESERVE @ MITCHELL MILL
TOWN OF ROLESVILLE, WAKE COUNTY, NORTH CAROLINA
CONSTRUCTION PLANS
PROPOSED GIGATON STREET -
PLAN & PROFILE


DRAWING SHEET
C-11.9

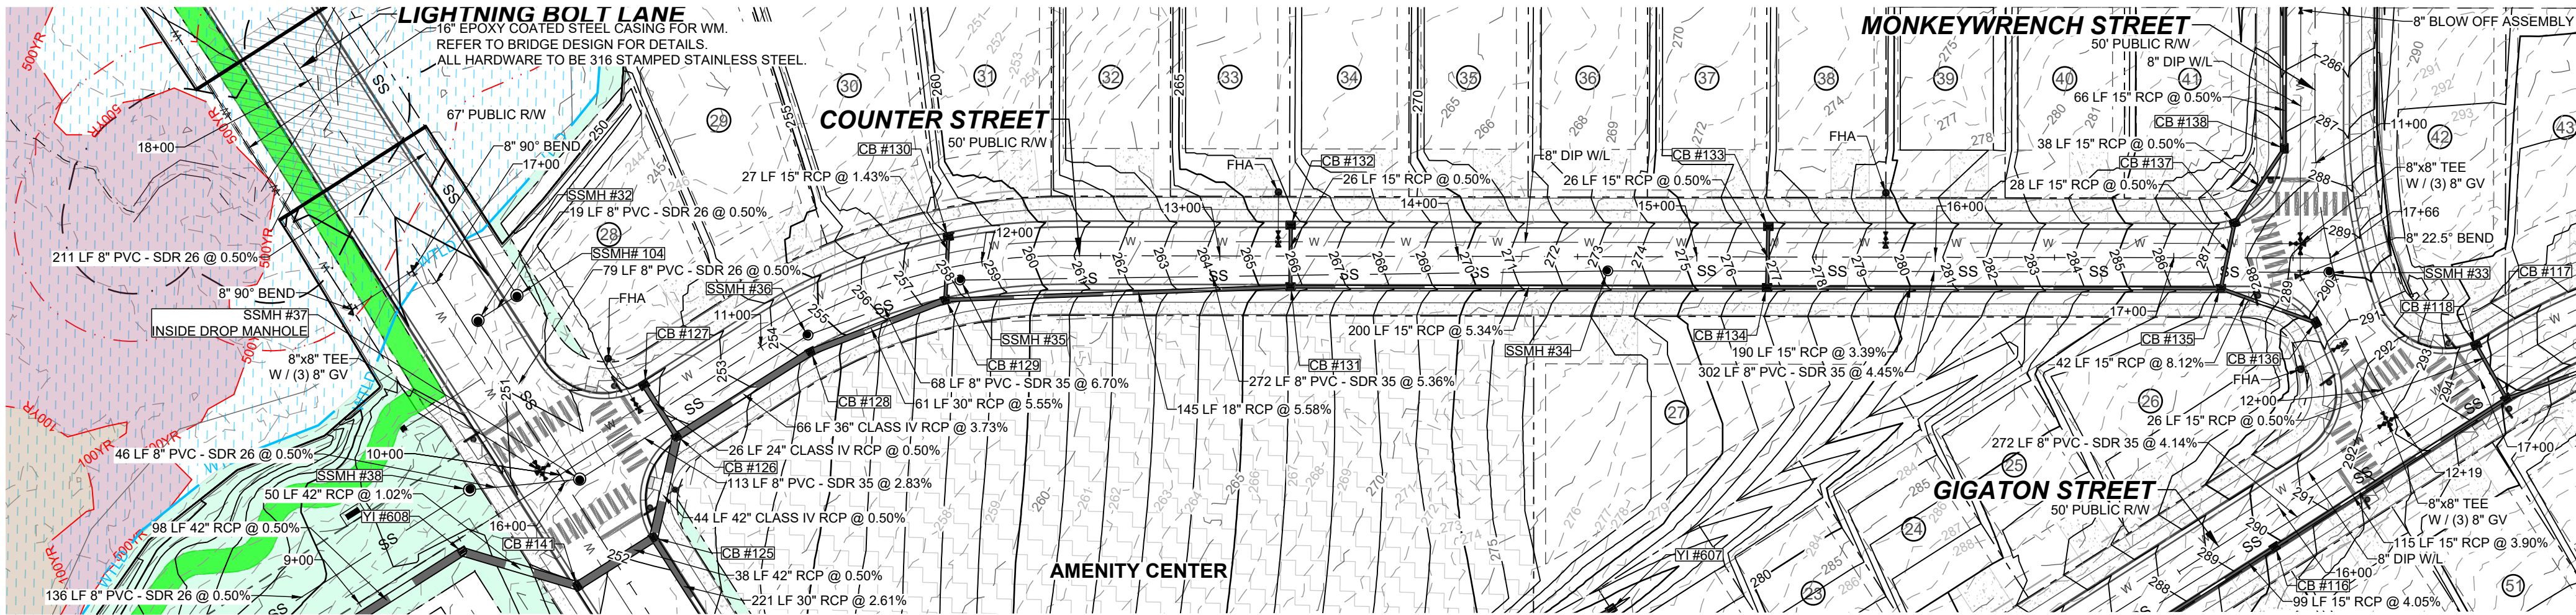

PROPOSED COUNTER STREET - PLAN
HORIZONTAL: 1" = 50'

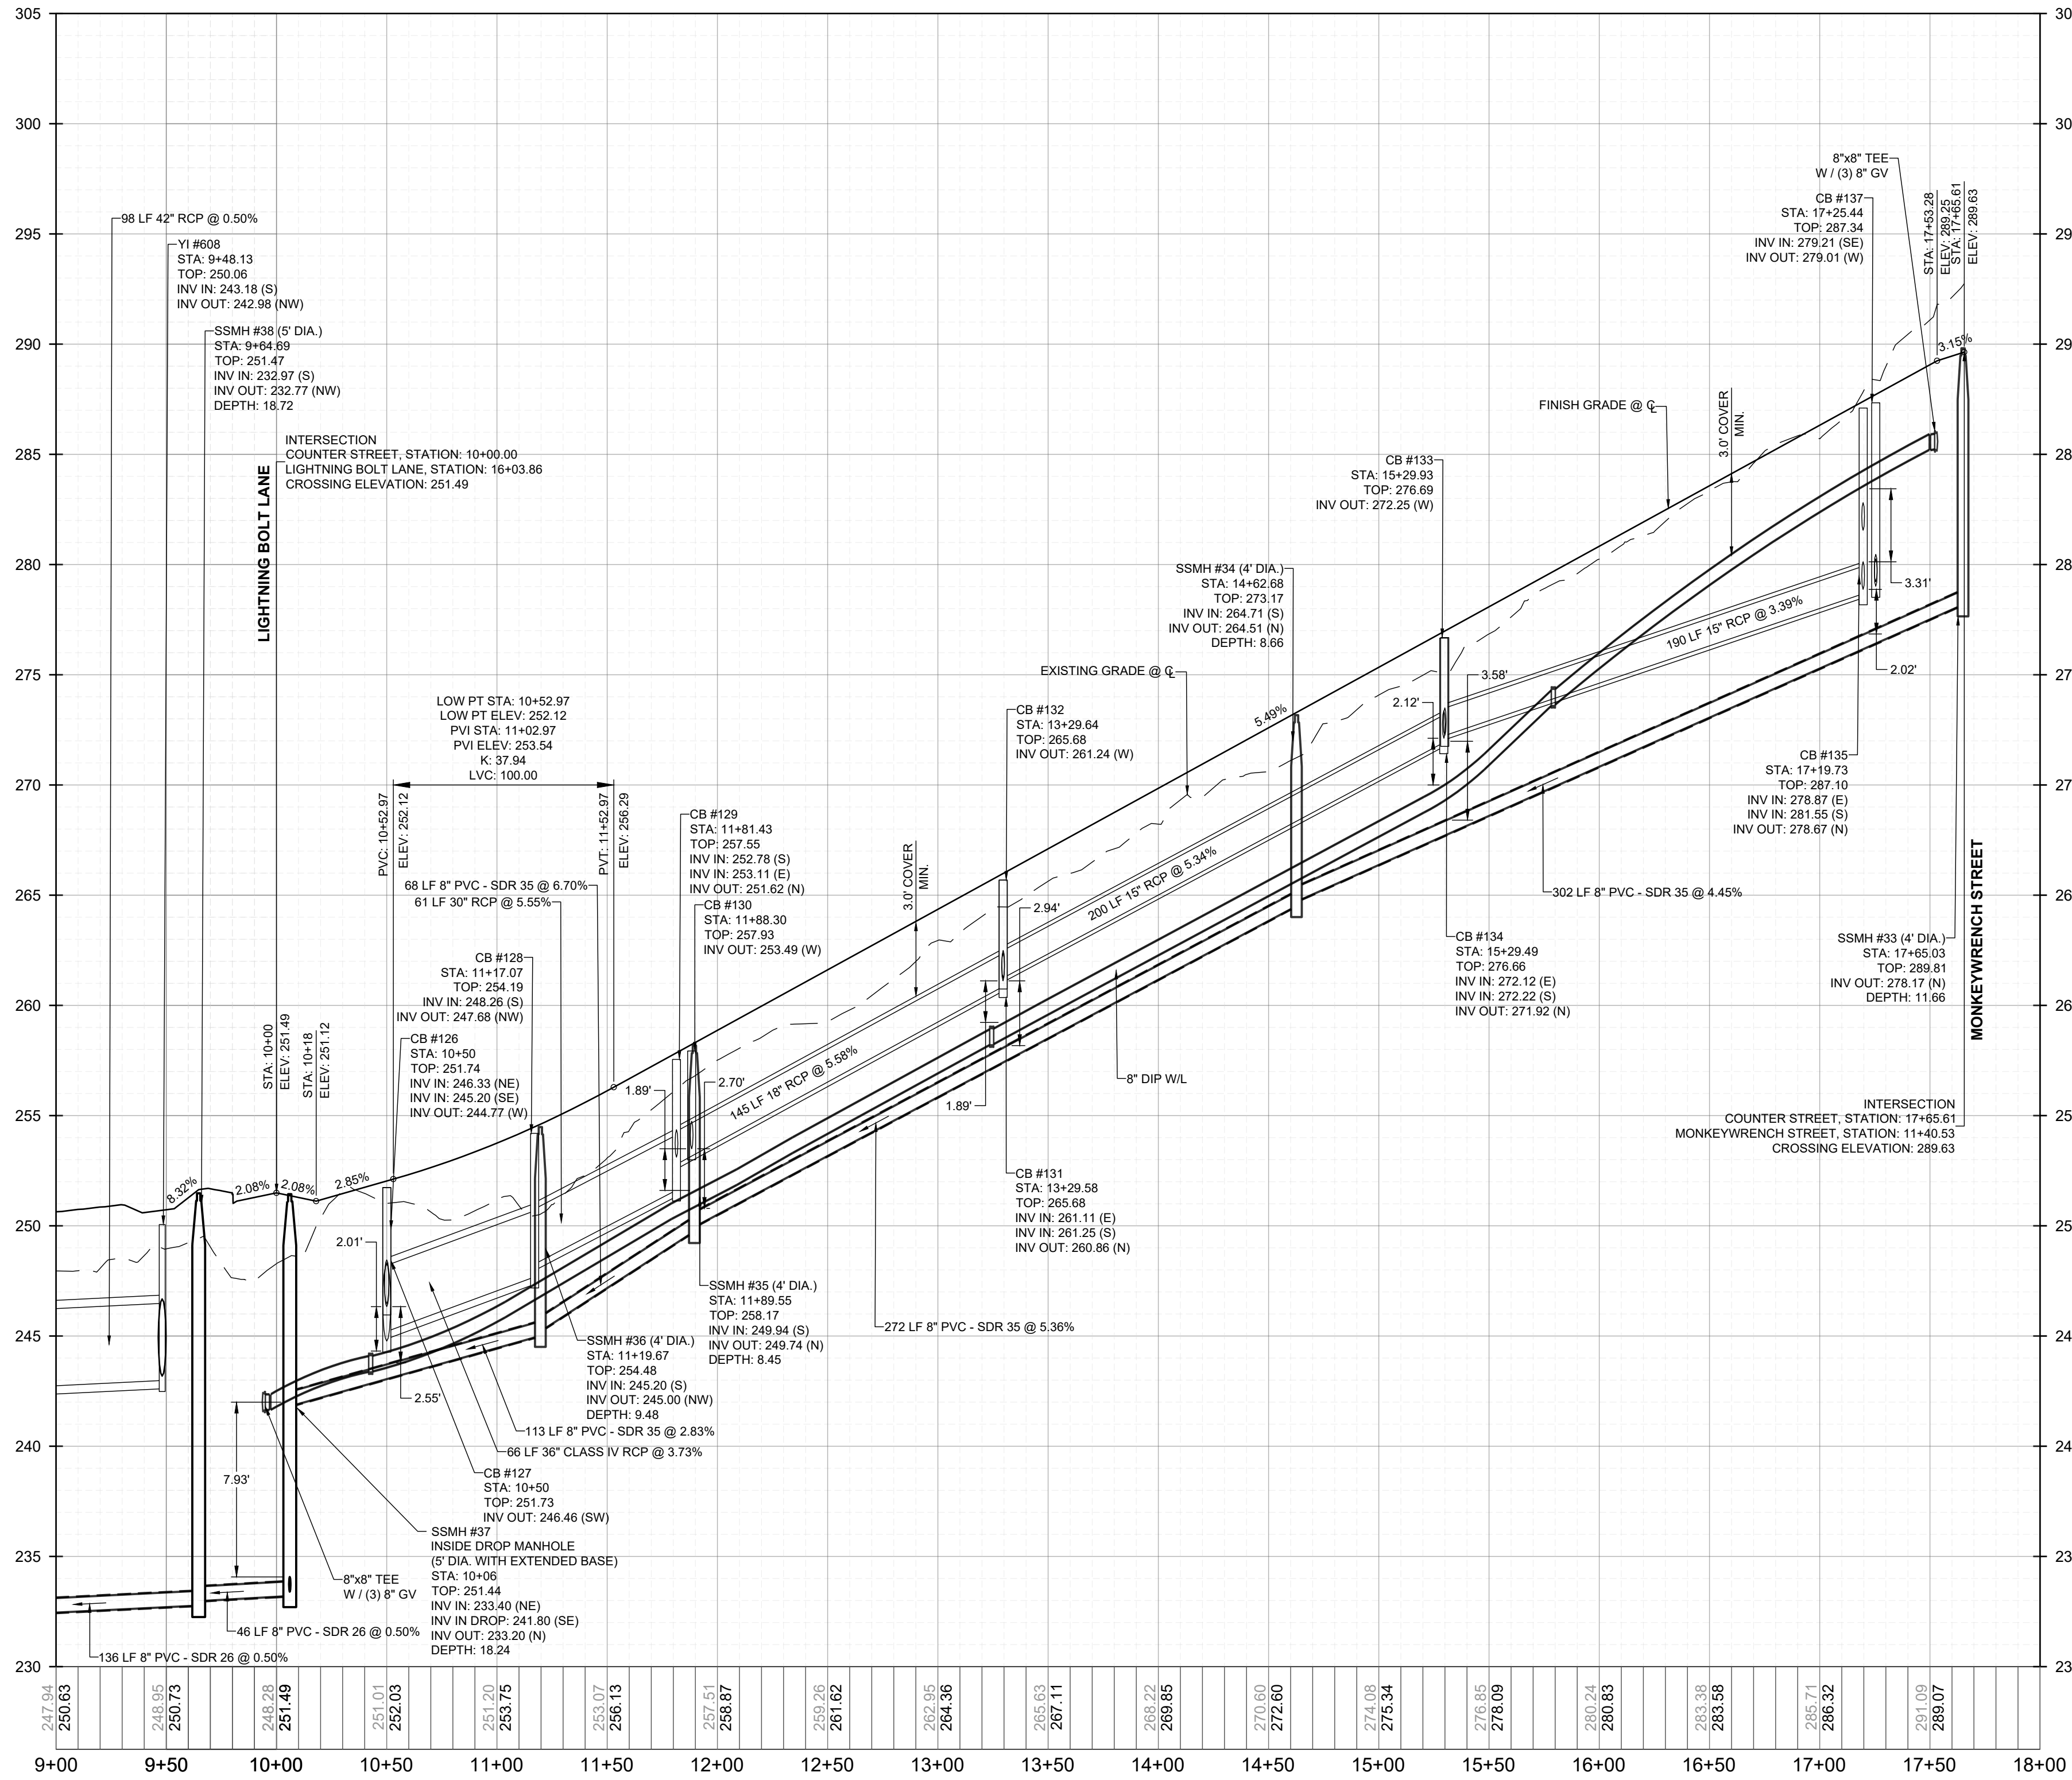

PROPOSED COUNTER STREET - PROFILE
VERTICAL: 1" = 5'
HORIZONTAL: 1" = 50'

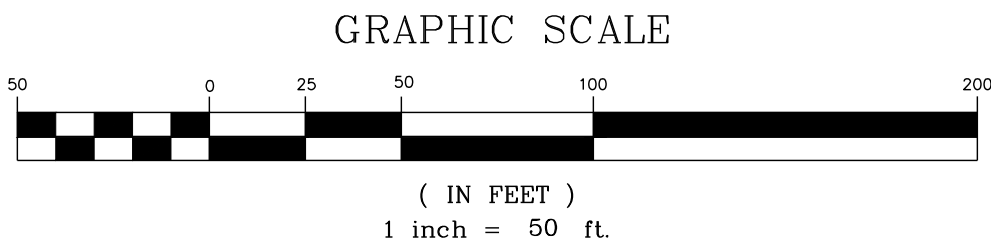

PUBLIC
WATER DISTRIBUTION / EXTENSION SYSTEM
THE CITY OF RALEIGH CONSENTS TO THE CONNECTION AND EXTENSION OF THE CITY'S PUBLIC WATER SYSTEM AS SHOWN ON THIS PLAN. THE MATERIAL AND CONSTRUCTION METHODS USED FOR THIS PROJECT SHALL CONFORM TO THE STANDARDS AND SPECIFICATIONS OF THE CITY'S PUBLIC UTILITIES HANDBOOK. CITY OF RALEIGH
PUBLIC UTILITIES DEPARTMENT PERMIT # _____

PUBLIC
SEWER COLLECTION / EXTENSION SYSTEM
THE CITY OF RALEIGH CONSENTS TO THE CONNECTION AND EXTENSION OF THE CITY'S PUBLIC SEWER SYSTEM AS SHOWN ON THIS PLAN. THE MATERIAL AND CONSTRUCTION METHODS USED FOR THIS PROJECT SHALL CONFORM TO THE STANDARDS AND SPECIFICATIONS OF THE CITY'S PUBLIC UTILITIES HANDBOOK. CITY OF RALEIGH
PUBLIC UTILITIES DEPARTMENT PERMIT # _____




CONSTRUCTION INFRASTRUCTURE DRAWINGS	DATE	BY
CID-24-04	08/04/2024	
TOWN OF ROLESVILLE CID-24-04 V2	11/01/2024	
TOWN OF ROLESVILLE CID-24-04 V3	02/01/2024	
TOWN OF ROLESVILLE CID-24-04 V4	08/02/2025	
TOWN OF ROLESVILLE CID-24-04 V5	09/02/2025	
No.	REVISIONS	DATE

STRONGROCK
ENGINEERING GROUP
STRONG ROCK ENGINEERING GROUP, PLLC | COMPANY LICENSE # P-2166
305 CHURCH AT NORTH HILLS STREET, SUITE 1110 RALEIGH, NC 27609 | INFORMATION@STRONGROCKGROUP.COM

STRONG ROCK PROJECT	NOT FOR CONSTRUCTION	SCALE	AS SHOWN	SRG	DESIGNED BY	SRG	DRAWN BY	SRG	CHECKED BY	SRG
---------------------	----------------------	-------	----------	-----	-------------	-----	----------	-----	------------	-----

RESERVE @ MITCHELL MILL
TOWN OF ROLESVILLE, WAKE COUNTY, NORTH CAROLINA
CONSTRUCTION PLANS
PROPOSED COUNTER STREET -
PLAN & PROFILE

DRAWING
SHEET
C-11.10

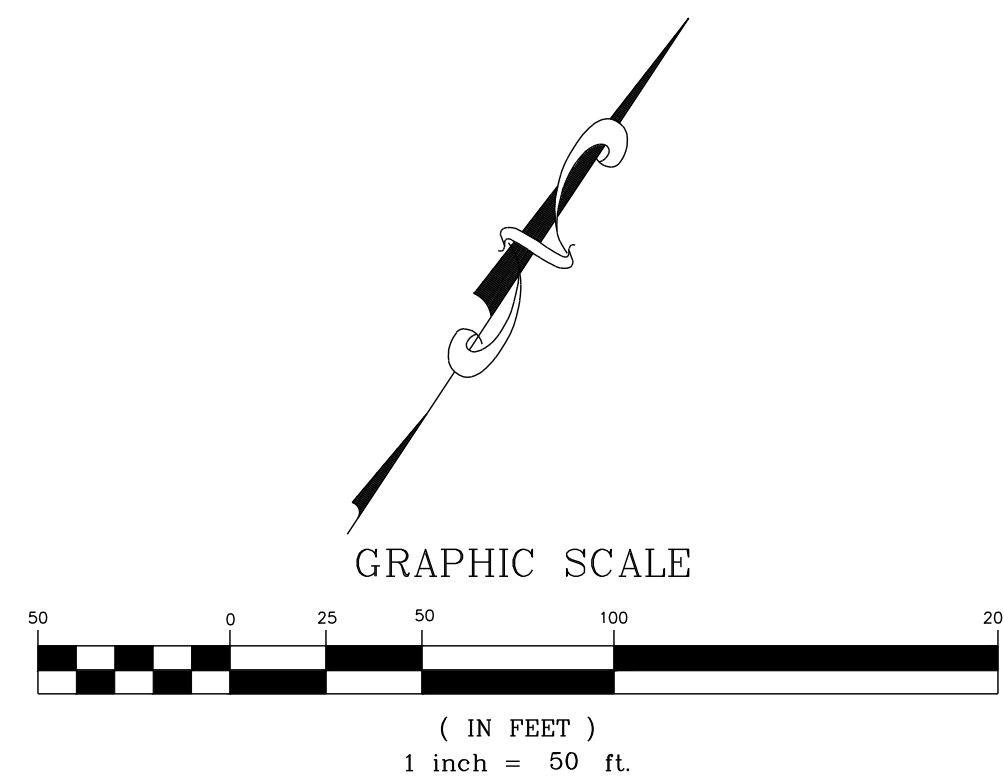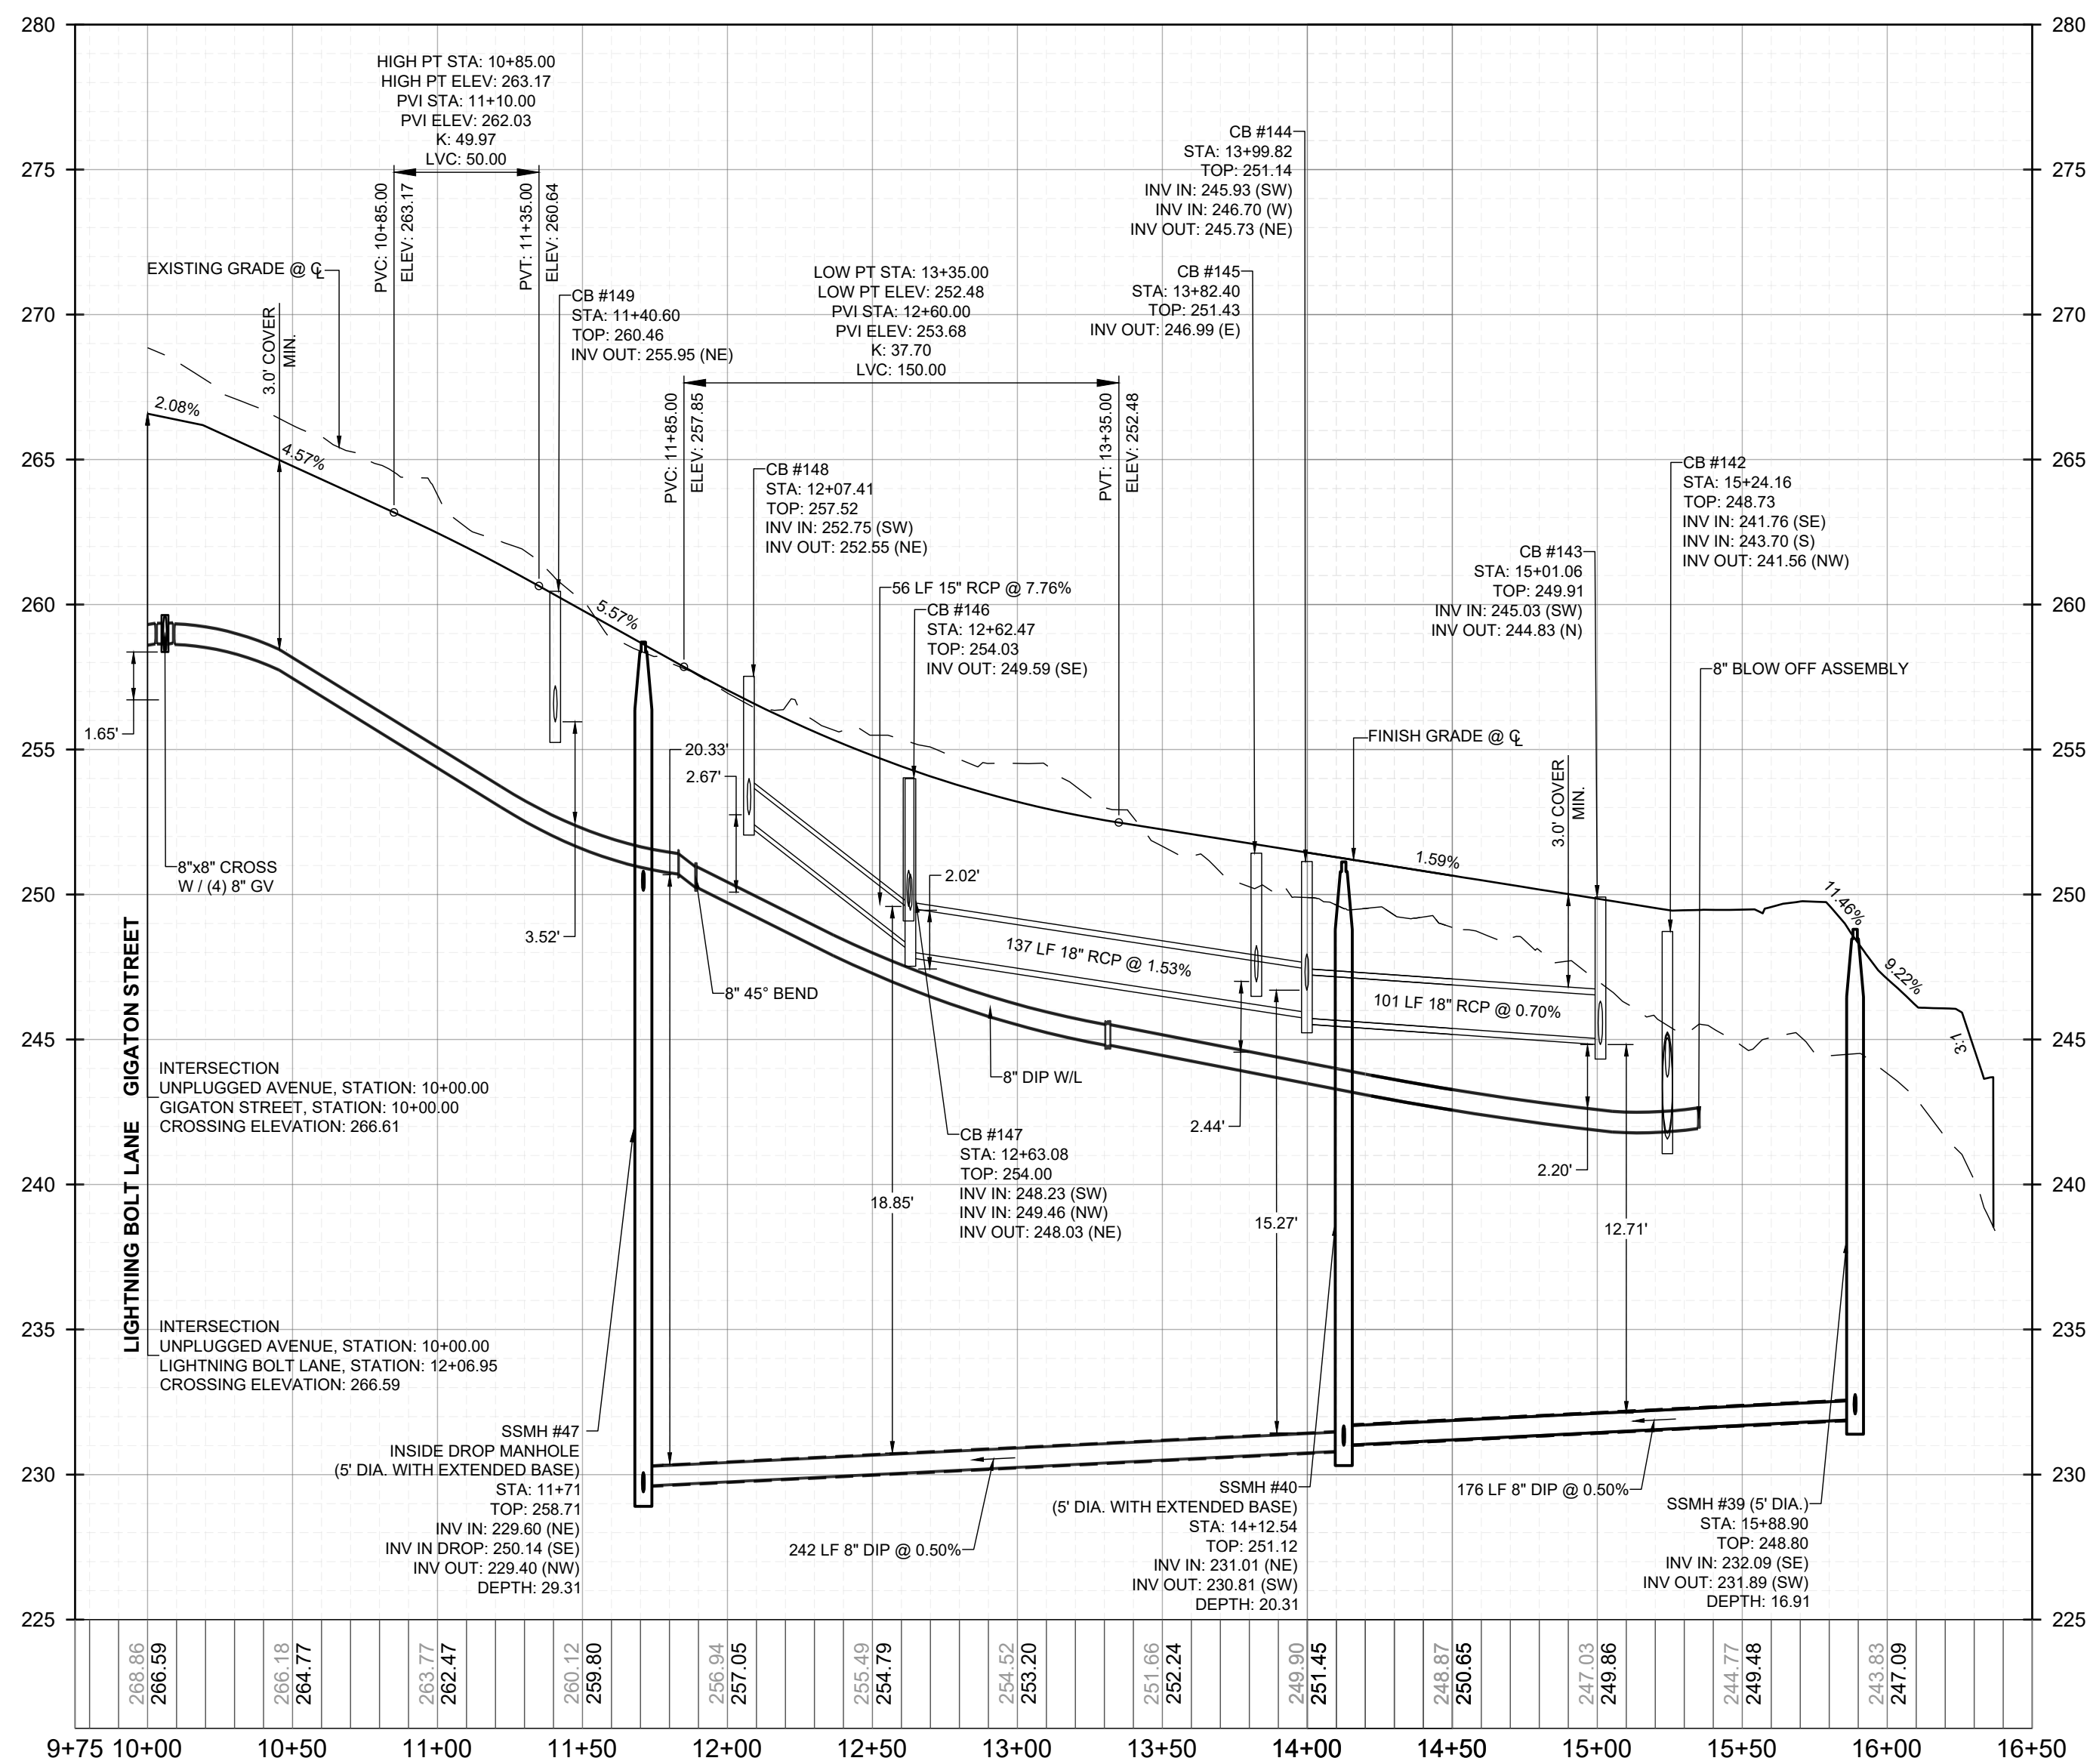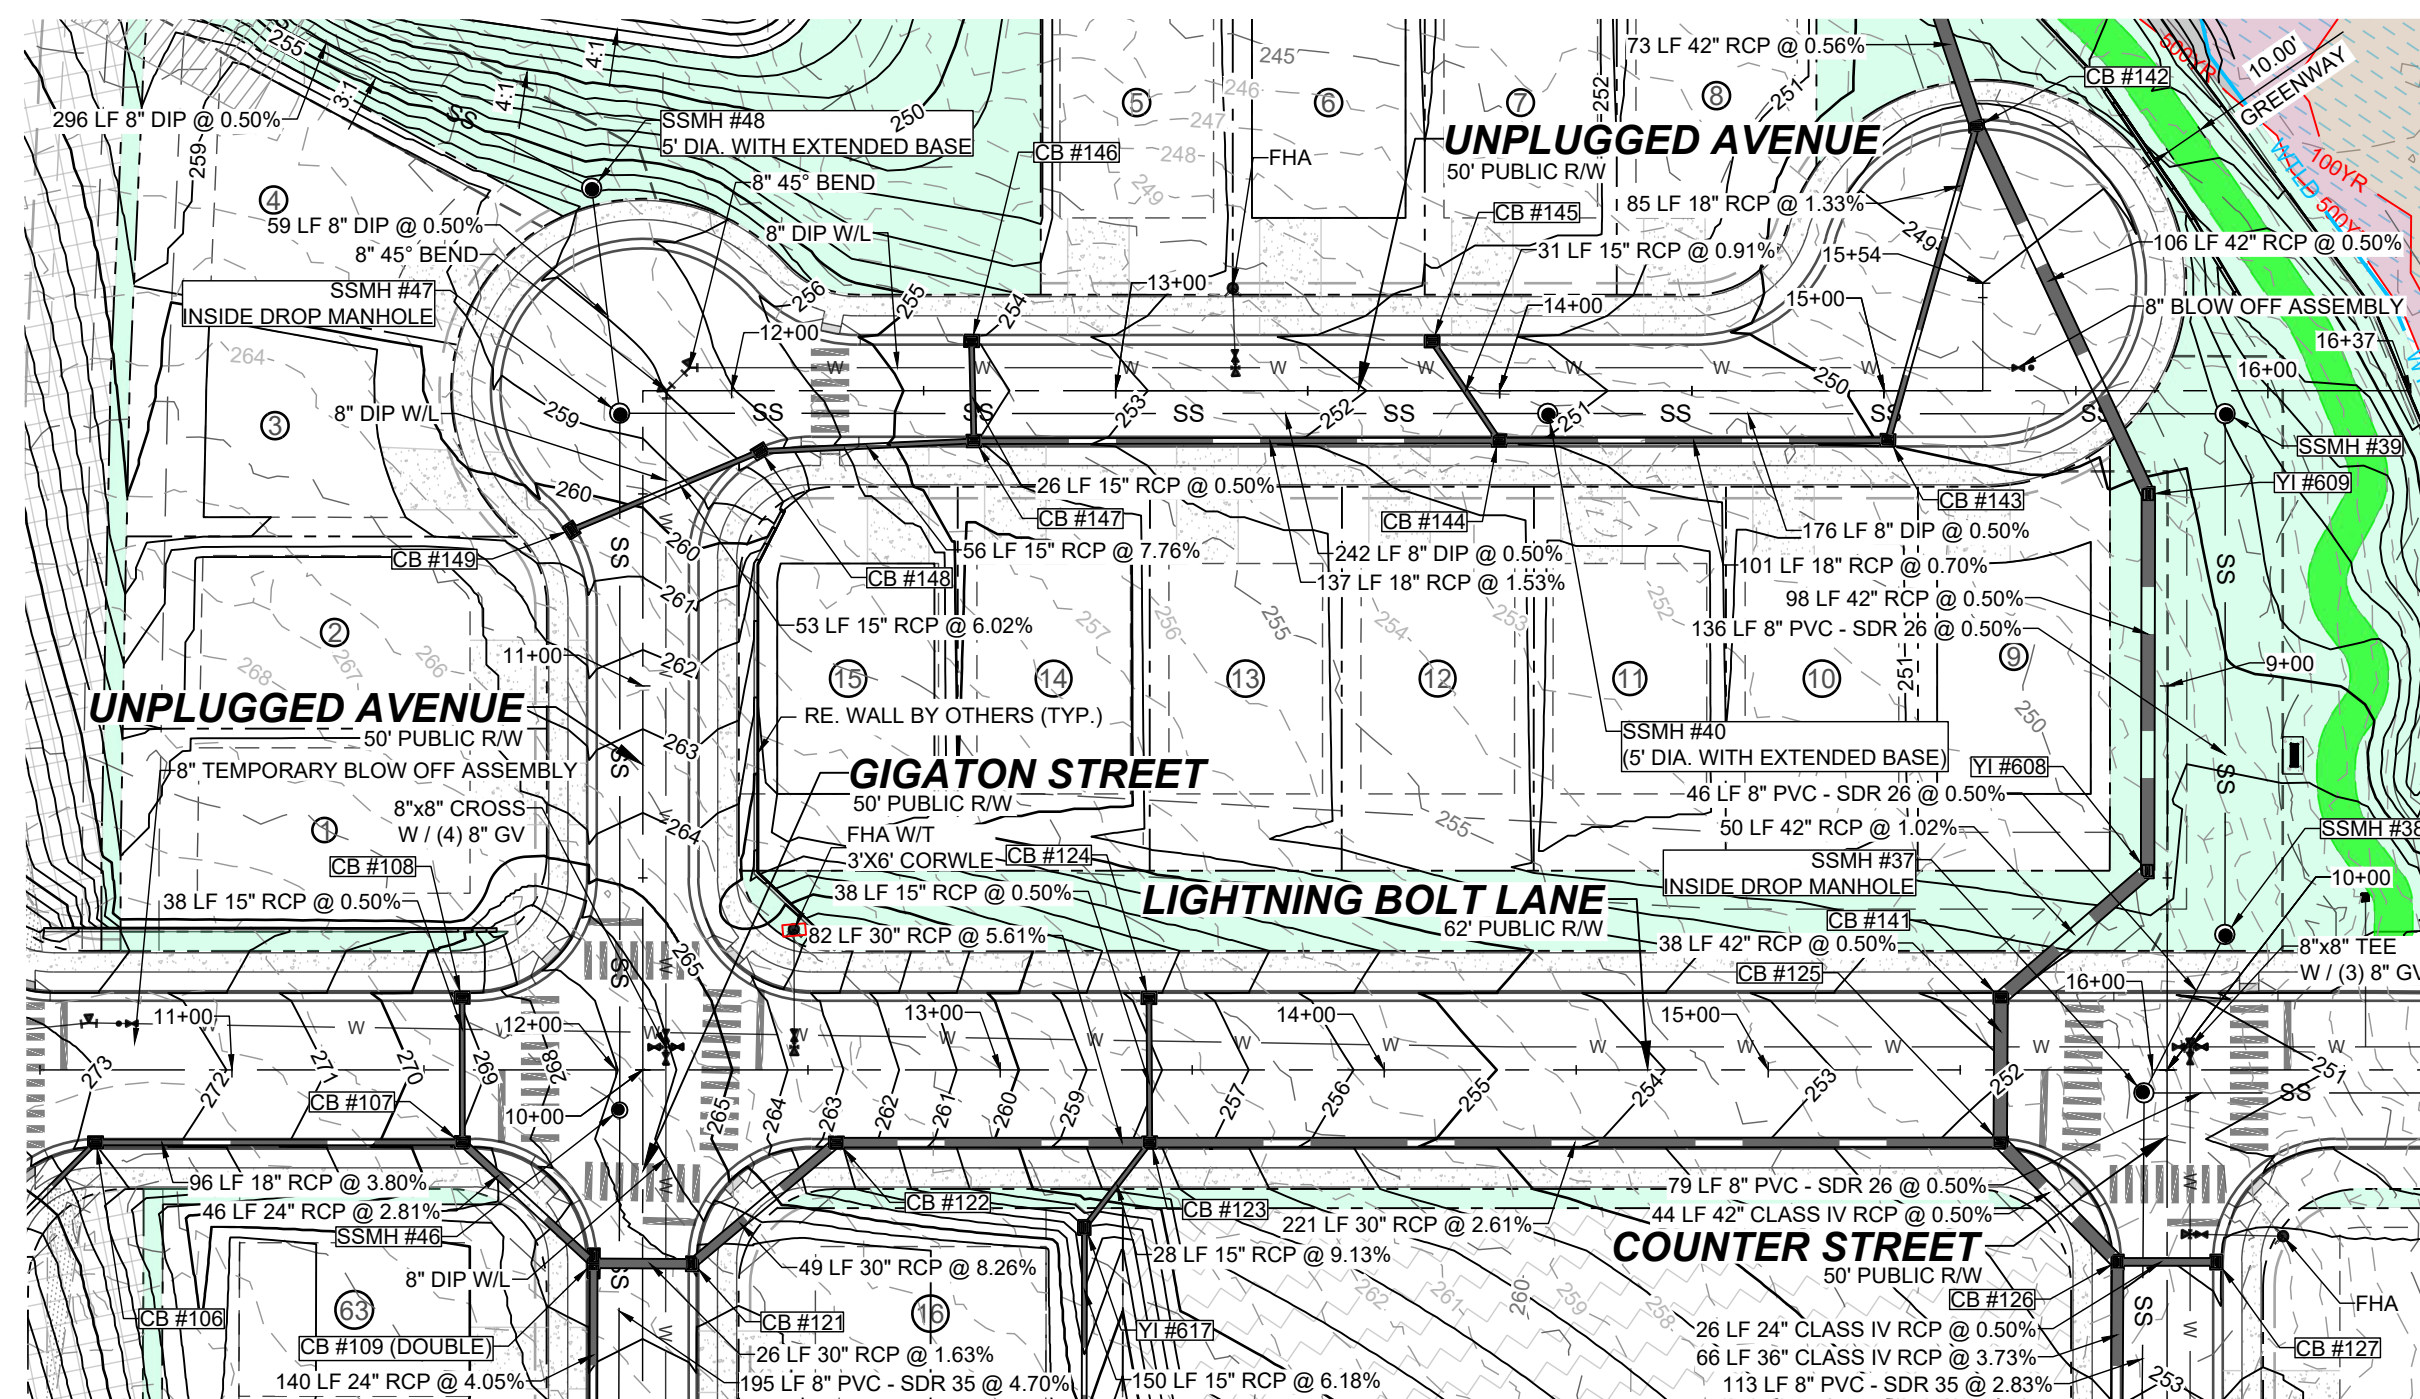

PUBLIC
WATER DISTRIBUTION / EXTENSION SYSTEM

THE CITY OF RALEIGH CONSENTS TO THE CONNECTION AND EXTENSION OF THE CITY'S PUBLIC WATER SYSTEM AS SHOWN ON THIS PLAN. THE MATERIAL AND CONSTRUCTION METHODS USED FOR THIS PROJECT SHALL CONFORM TO THE STANDARDS AND SPECIFICATIONS OF THE CITY'S PUBLIC UTILITIES HANDBOOK, CITY OF RALEIGH

PUBLIC UTILITIES DEPARTMENT PERMIT # _____

PUBLIC
SEWER COLLECTION / EXTENSION SYSTEM

THE CITY OF RALEIGH CONSENTS TO THE CONNECTION AND EXTENSION OF THE CITY'S PUBLIC SEWER SYSTEM AS SHOWN ON THIS PLAN. THE MATERIAL AND CONSTRUCTION METHODS USED FOR THIS PROJECT SHALL CONFORM TO THE STANDARDS AND SPECIFICATIONS OF THE CITY'S PUBLIC UTILITIES HANDBOOK. CITY OF RALEIGH

PUBLIC UTILITIES DEPARTMENT PERMIT # _____

No.	REVISIONS	DATE	BY
01	CONSTRUCTION INFRASTRUCTURE DRAWINGS CID-24-04	06/04/2024	SREG
02	TOWN OF ROLESVILLE CID-24-04 V2	11/01/2024	SREG
03	TOWN OF ROLESVILLE CID-24-04 V3	02/01/2024	SREG
04	TOWN OF ROLESVILLE CID-24-04 V4	08/02/2025	SREG
05	TOWN OF ROLESVILLE CID-24-04 V5	09/02/2025	SREG

SEAL:

STRONGROCK
ENGINEERING GROUP
STRONG ROCK ENGINEERING GROUP, PLLC | COMPANY LICENSE # P-2166

STRONG ROCK PROJECT PSP-23-03	NOT FOR CONSTRUCTION	SCALE AS SHOWN	DESIGNED BY SRG	DRAWN BY SRG	CHECKED BY SRG
----------------------------------	-------------------------	----------------	-----------------	--------------	----------------

RESERVE @ MITCHELL MILL
TOWN OF ROLESVILLE, WAKE COUNTY, NORTH CAROLINA


CONSTRUCTION PLANS
PROPOSED UNPLUGGED
AVENUE - PLAN & PROFILE

DRAWING SHEET


C-11.11

107 OF 230

THIS PLANSET AND ANY ASSOCIATED DOCUMENTS ARE PRELIMINARY AND NOT AUTHORIZED FOR CONSTRUCTION
UNTIL SIGNED, DATED, AND OFFICIALLY RELEASED FOR CONSTRUCTION BY THE ENGINEER OF RECORD.

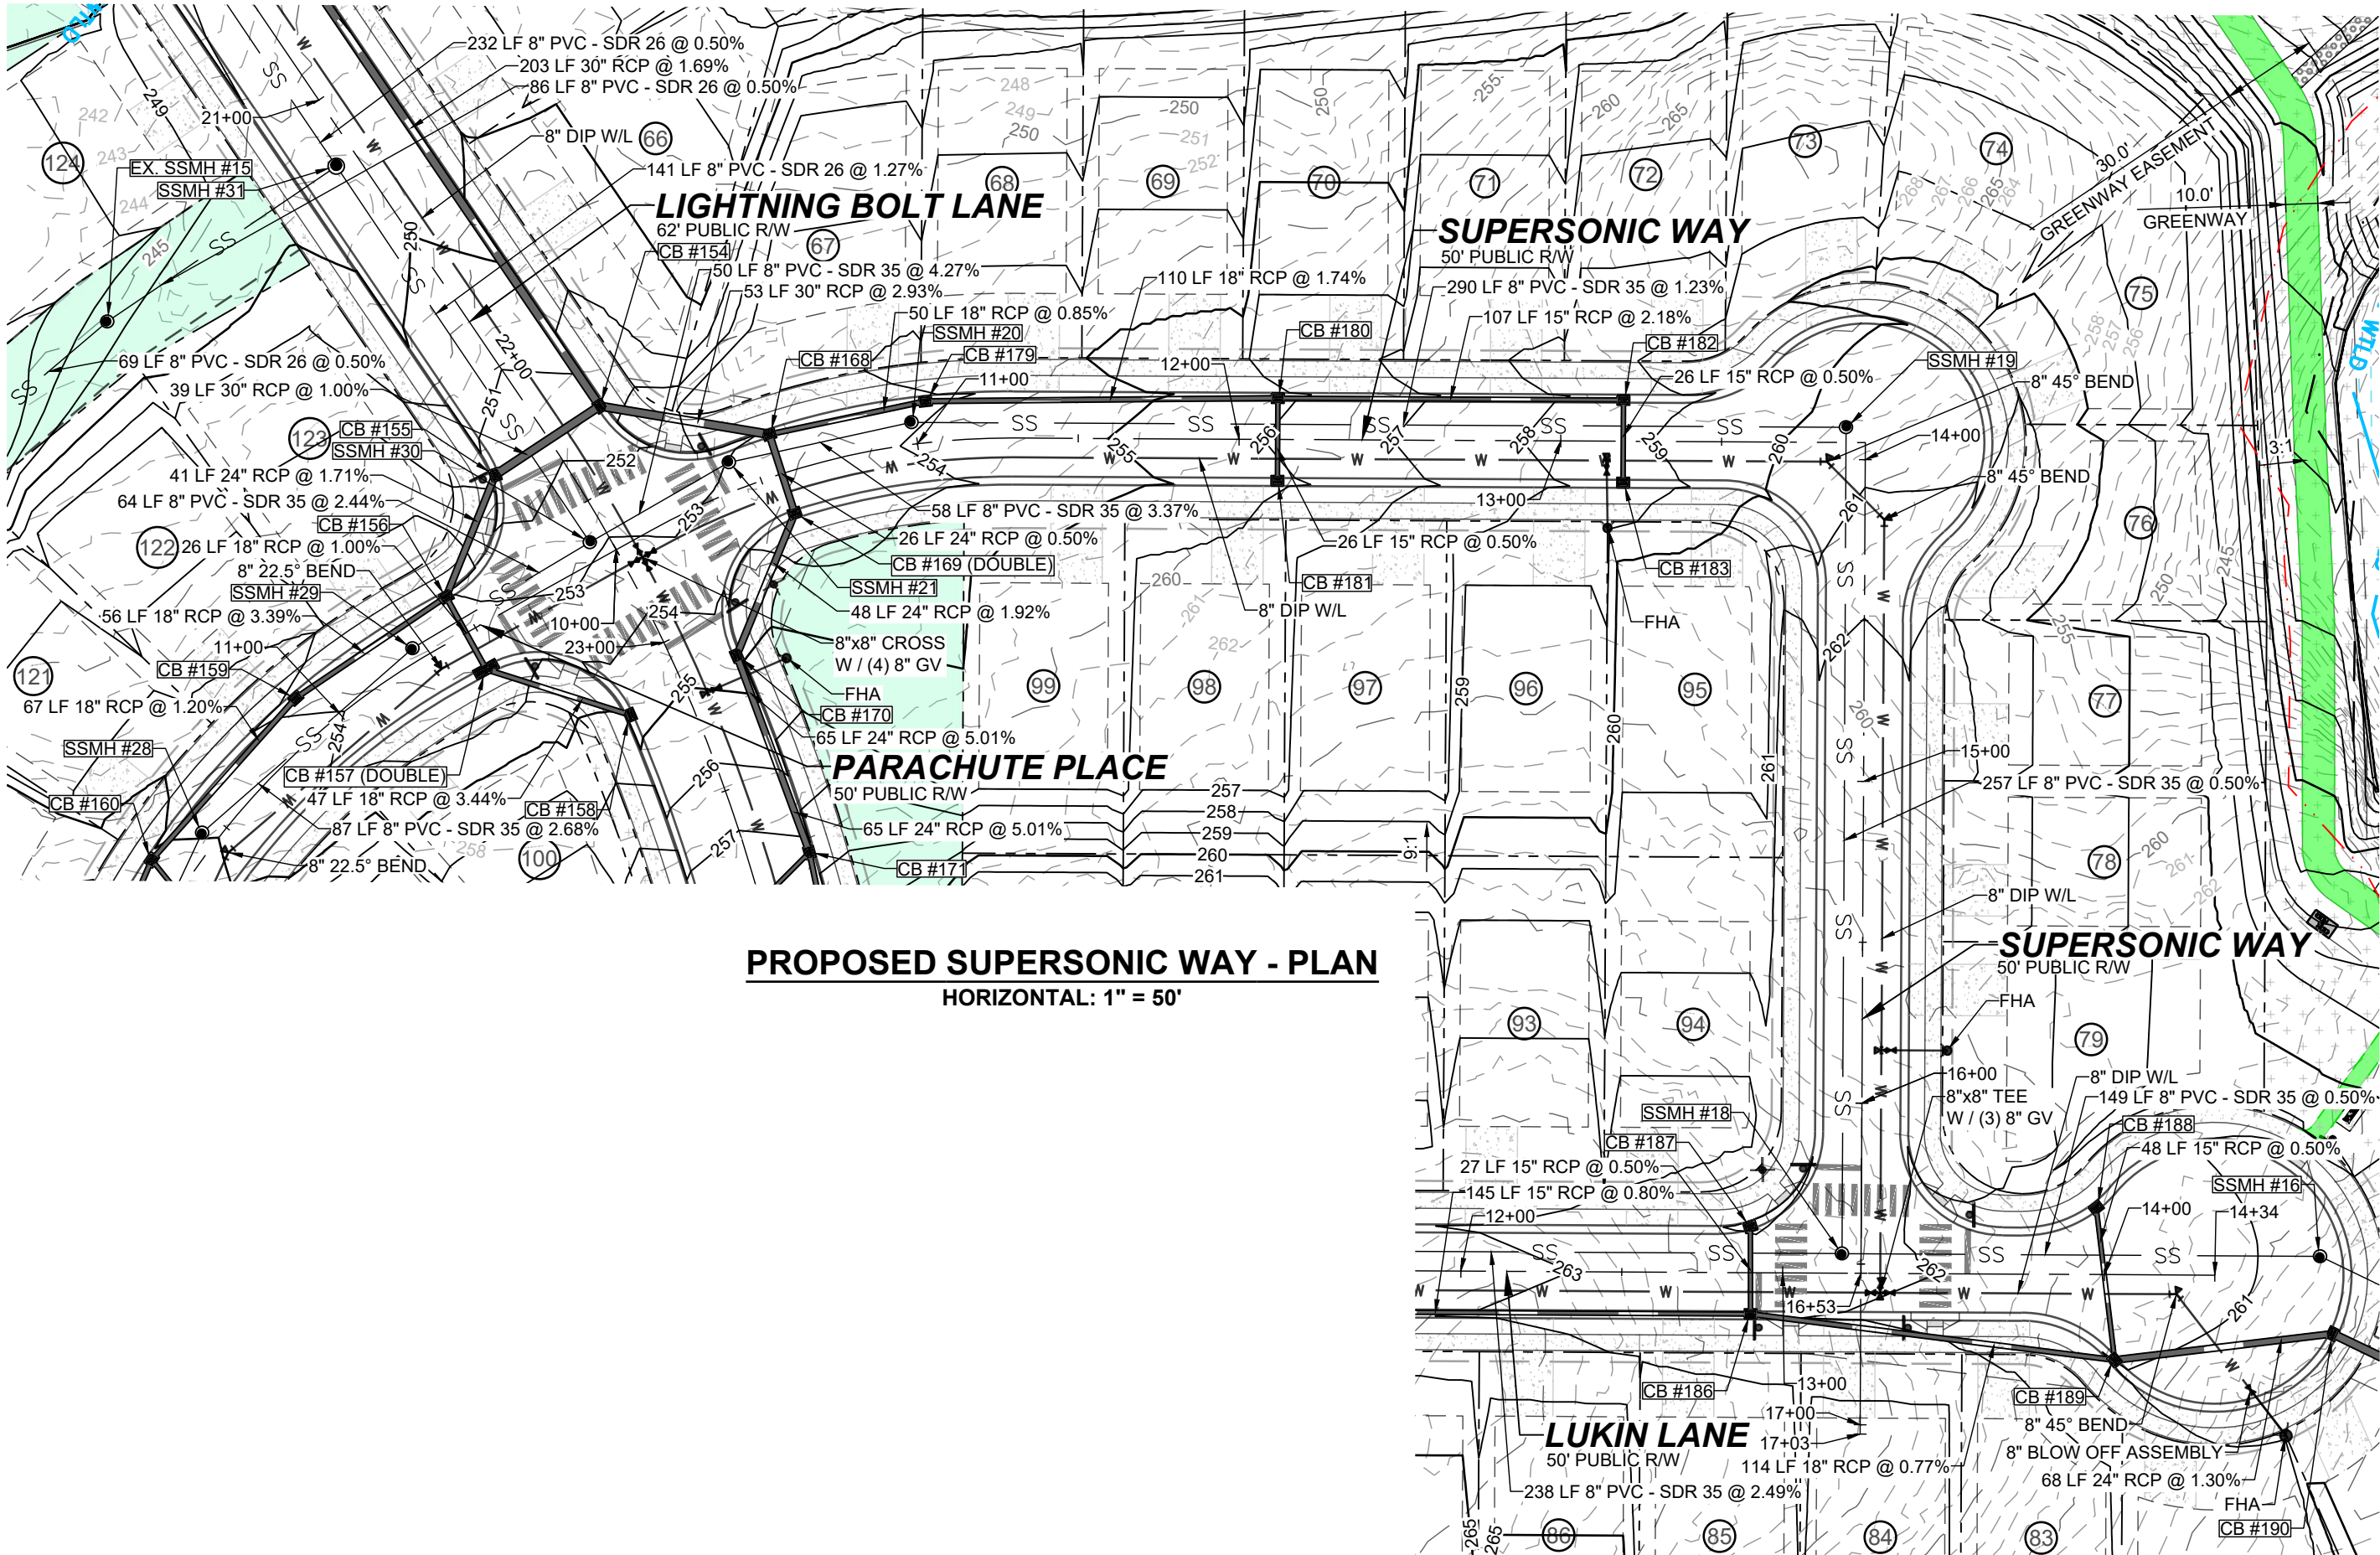


PROPOSED SUPERSONIC WAY - PLAN
HORIZONTAL: 1" = 50'

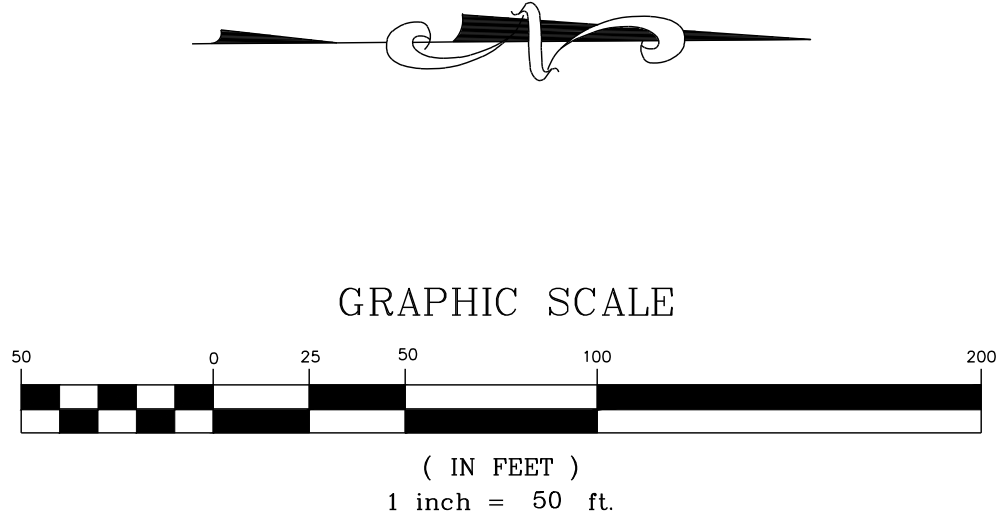

PUBLIC
WATER DISTRIBUTION / EXTENSION SYSTEM
THE CITY OF RALEIGH CONSENTS TO THE CONNECTION AND EXTENSION OF THE CITY'S PUBLIC WATER SYSTEM AS SHOWN ON THIS PLAN. THE MATERIAL AND CONSTRUCTION METHODS USED FOR THIS PROJECT SHALL CONFORM TO THE STANDARDS AND SPECIFICATIONS OF THE CITY'S PUBLIC UTILITIES HANDBOOK. CITY OF RALEIGH
PUBLIC UTILITIES DEPARTMENT PERMIT # _____

PUBLIC
SEWER COLLECTION / EXTENSION SYSTEM
THE CITY OF RALEIGH CONSENTS TO THE CONNECTION AND EXTENSION OF THE CITY'S PUBLIC SEWER SYSTEM AS SHOWN ON THIS PLAN. THE MATERIAL AND CONSTRUCTION METHODS USED FOR THIS PROJECT SHALL CONFORM TO THE STANDARDS AND SPECIFICATIONS OF THE CITY'S PUBLIC UTILITIES HANDBOOK. CITY OF RALEIGH
PUBLIC UTILITIES DEPARTMENT PERMIT # _____

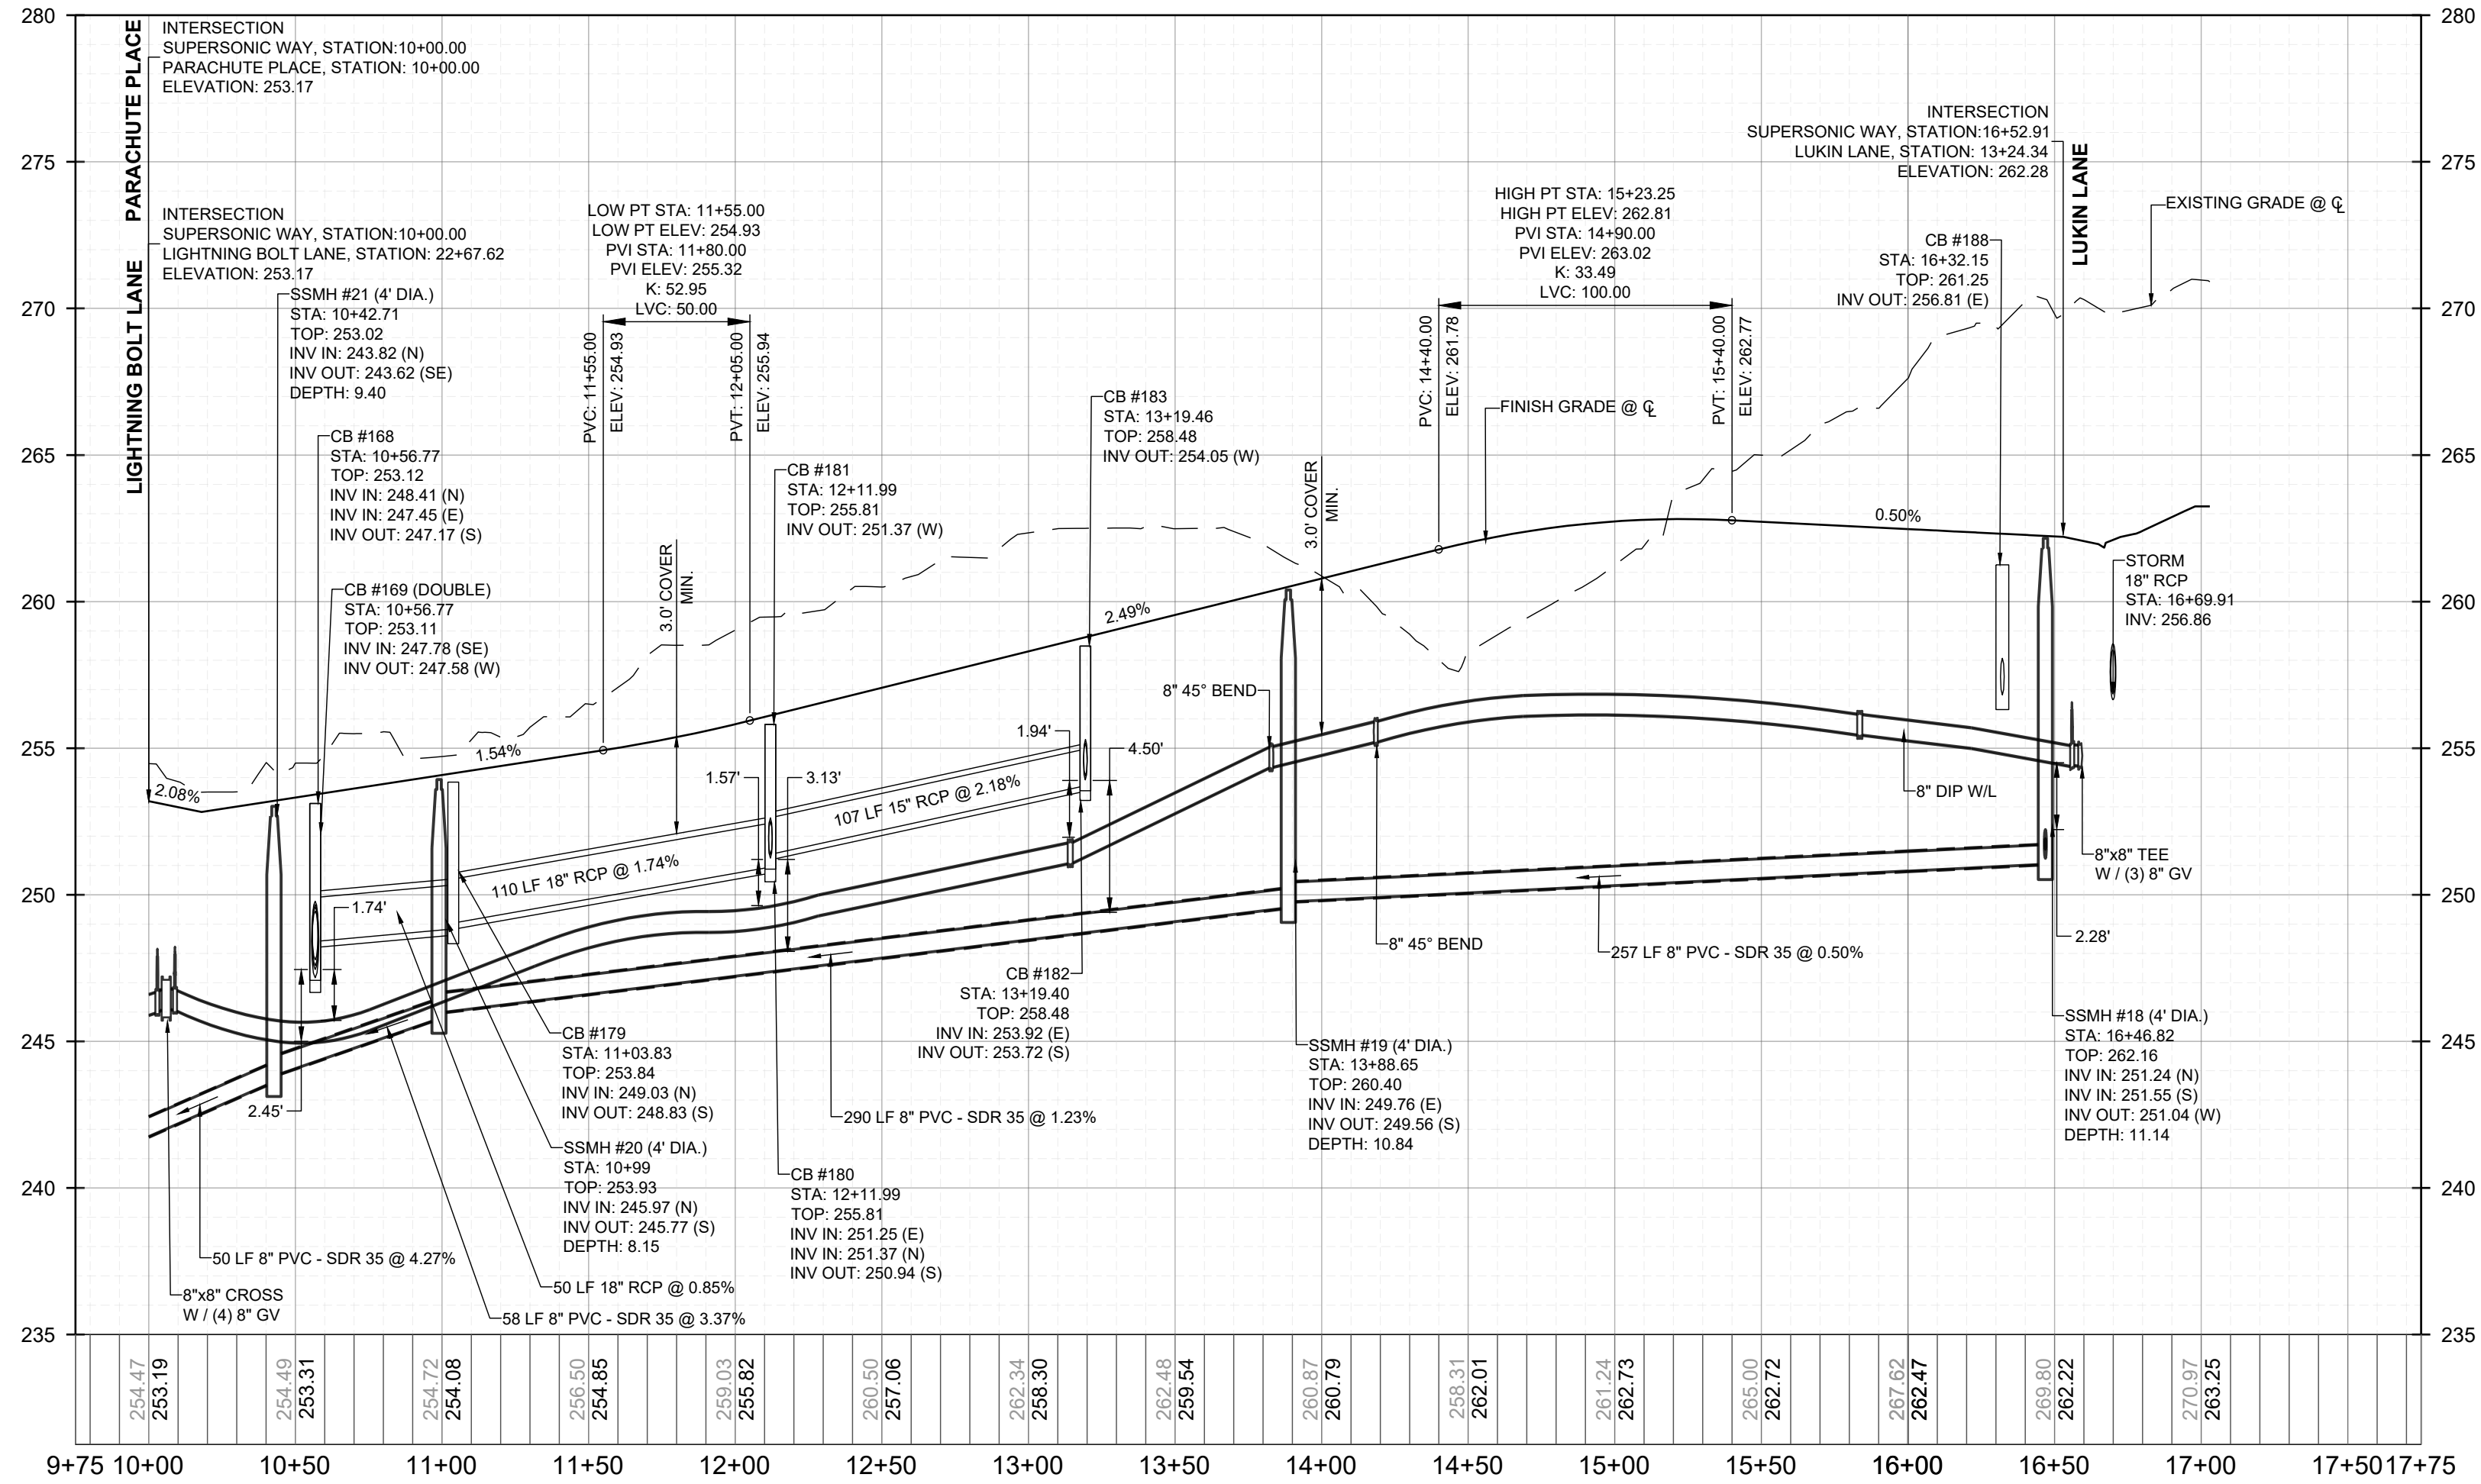

PROPOSED SUPERSONIC WAY - PROFILE
VERTICAL: 1" = 5'
HORIZONTAL: 1" = 50'

SEAL:

STRONGROCK

ENGINEERING GROUP

STRONG ROCK ENGINEERING GROUP, PLLC | COMPANY LICENSE # P-2166
305 CHURCH AT NORTH HILLS STREET, SUITE 1110 RALEIGH, NC 27609 | INFORMATION@STRONGROCKGROUP.COM

CONSTRUCTION INFRASTRUCTURE DRAWINGS
CID-24-04

01

02

03

04

05

NO.


DATE

BY



RESERVE @ MITCHELL MILL
TOWN OF ROLESVILLE, WAKE COUNTY, NORTH CAROLINA
CONSTRUCTION PLANS
PROPOSED SUPERSONIC WAY -
PLAN & PROFILE

DRAWING
SHEET
C-11.12

108 OF 230

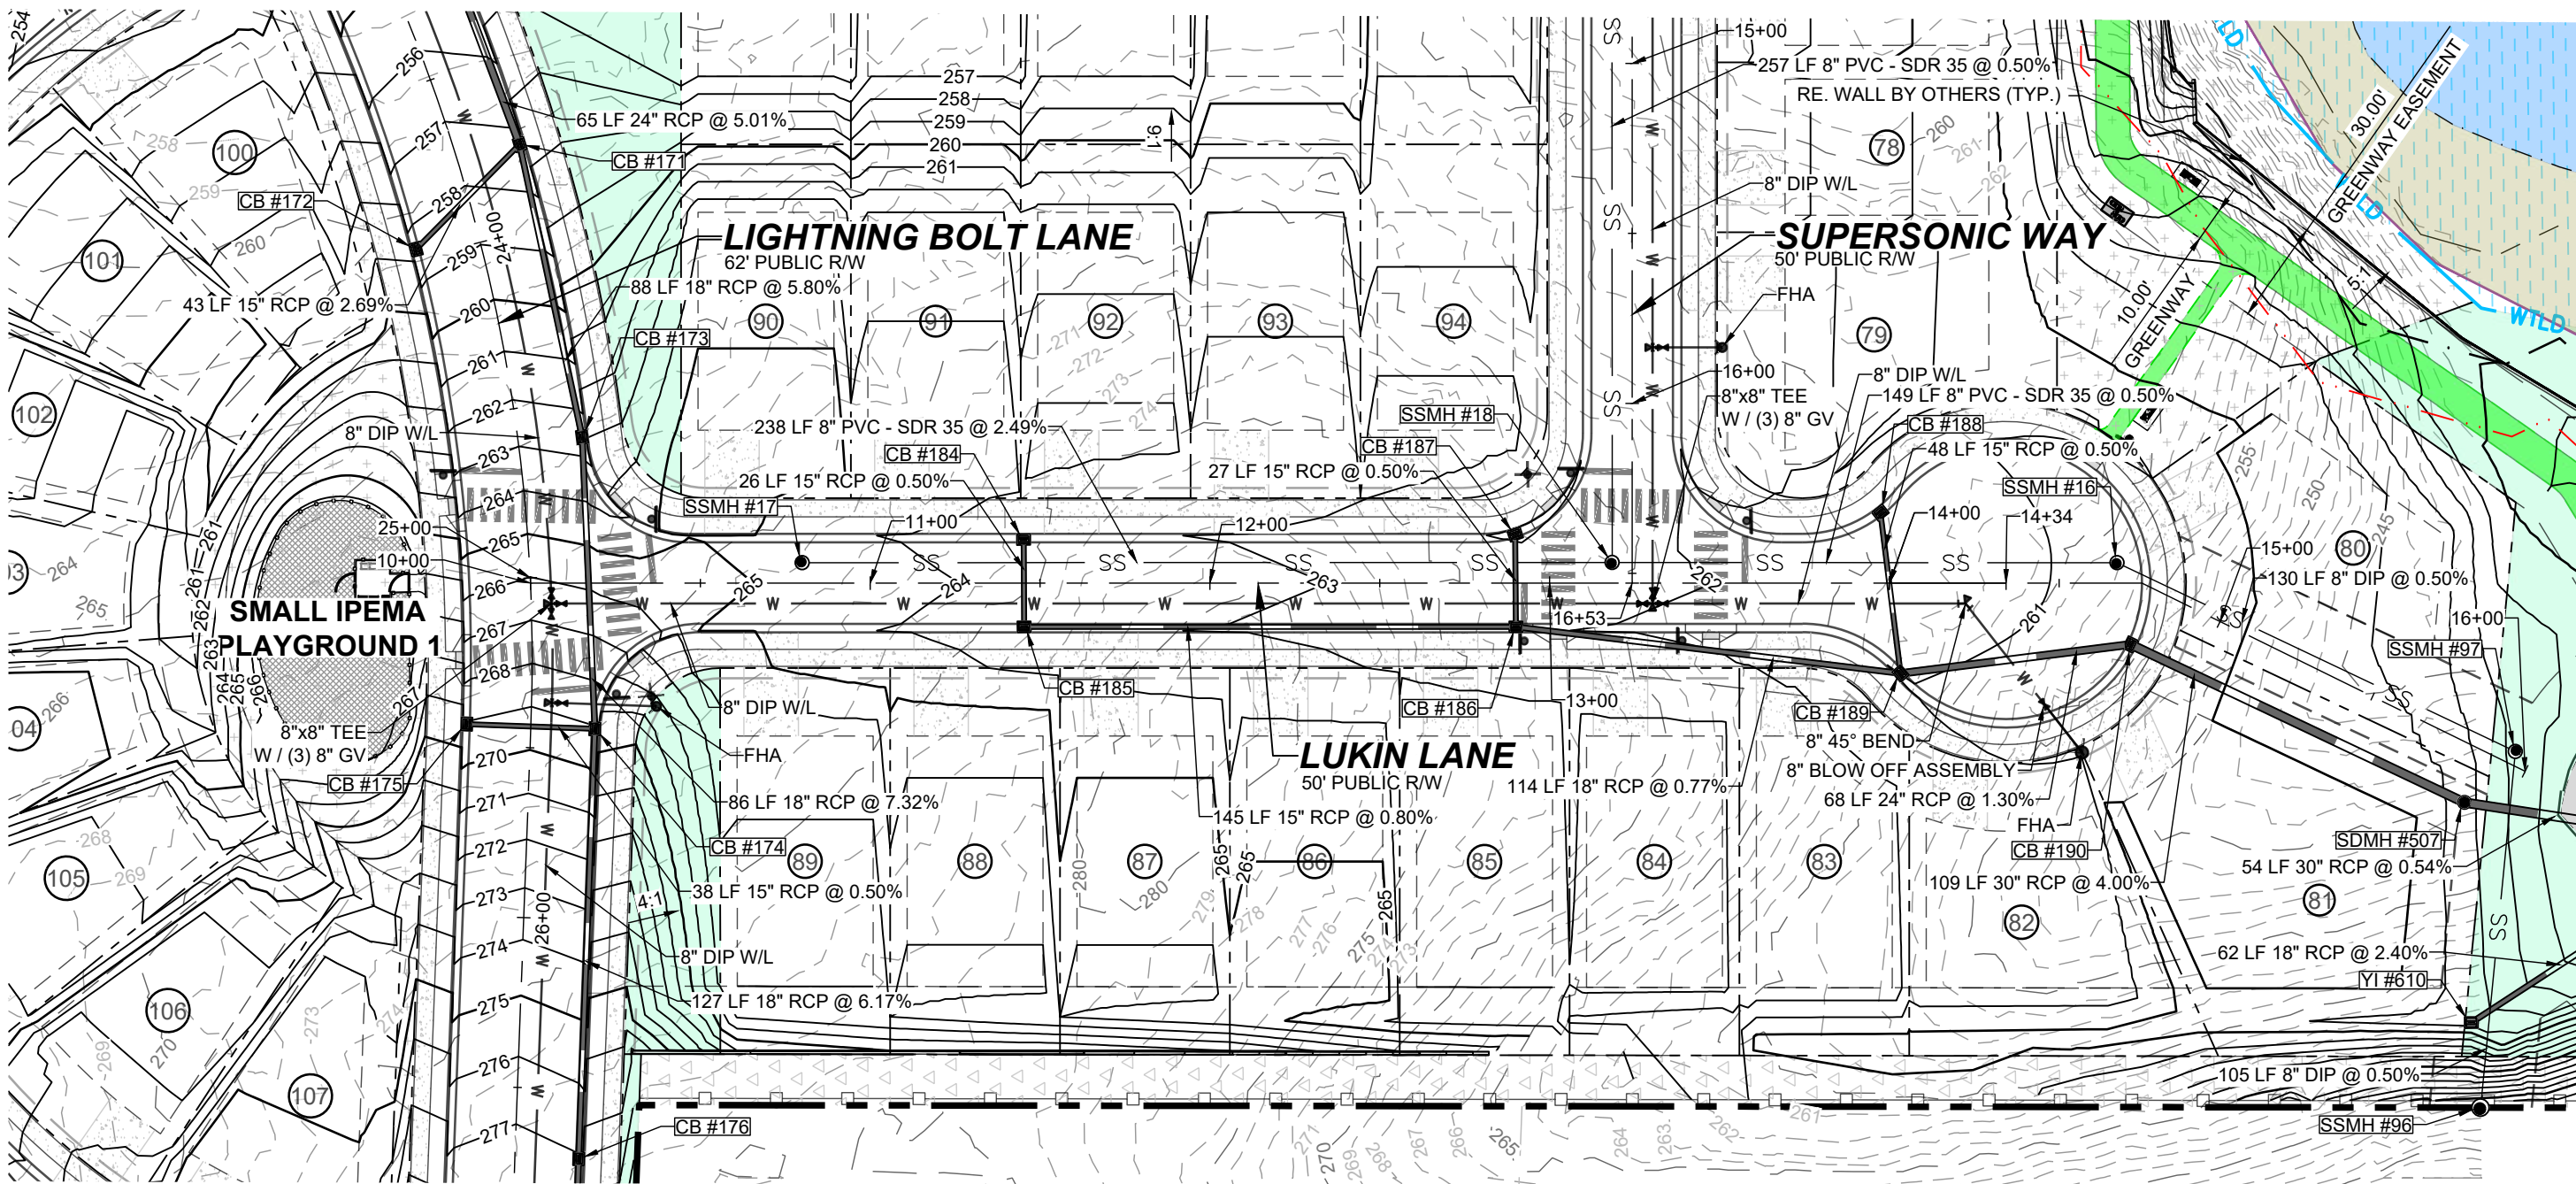

PROPOSED LUKIN LANE - PLAN
HORIZONTAL: 1" = 50'

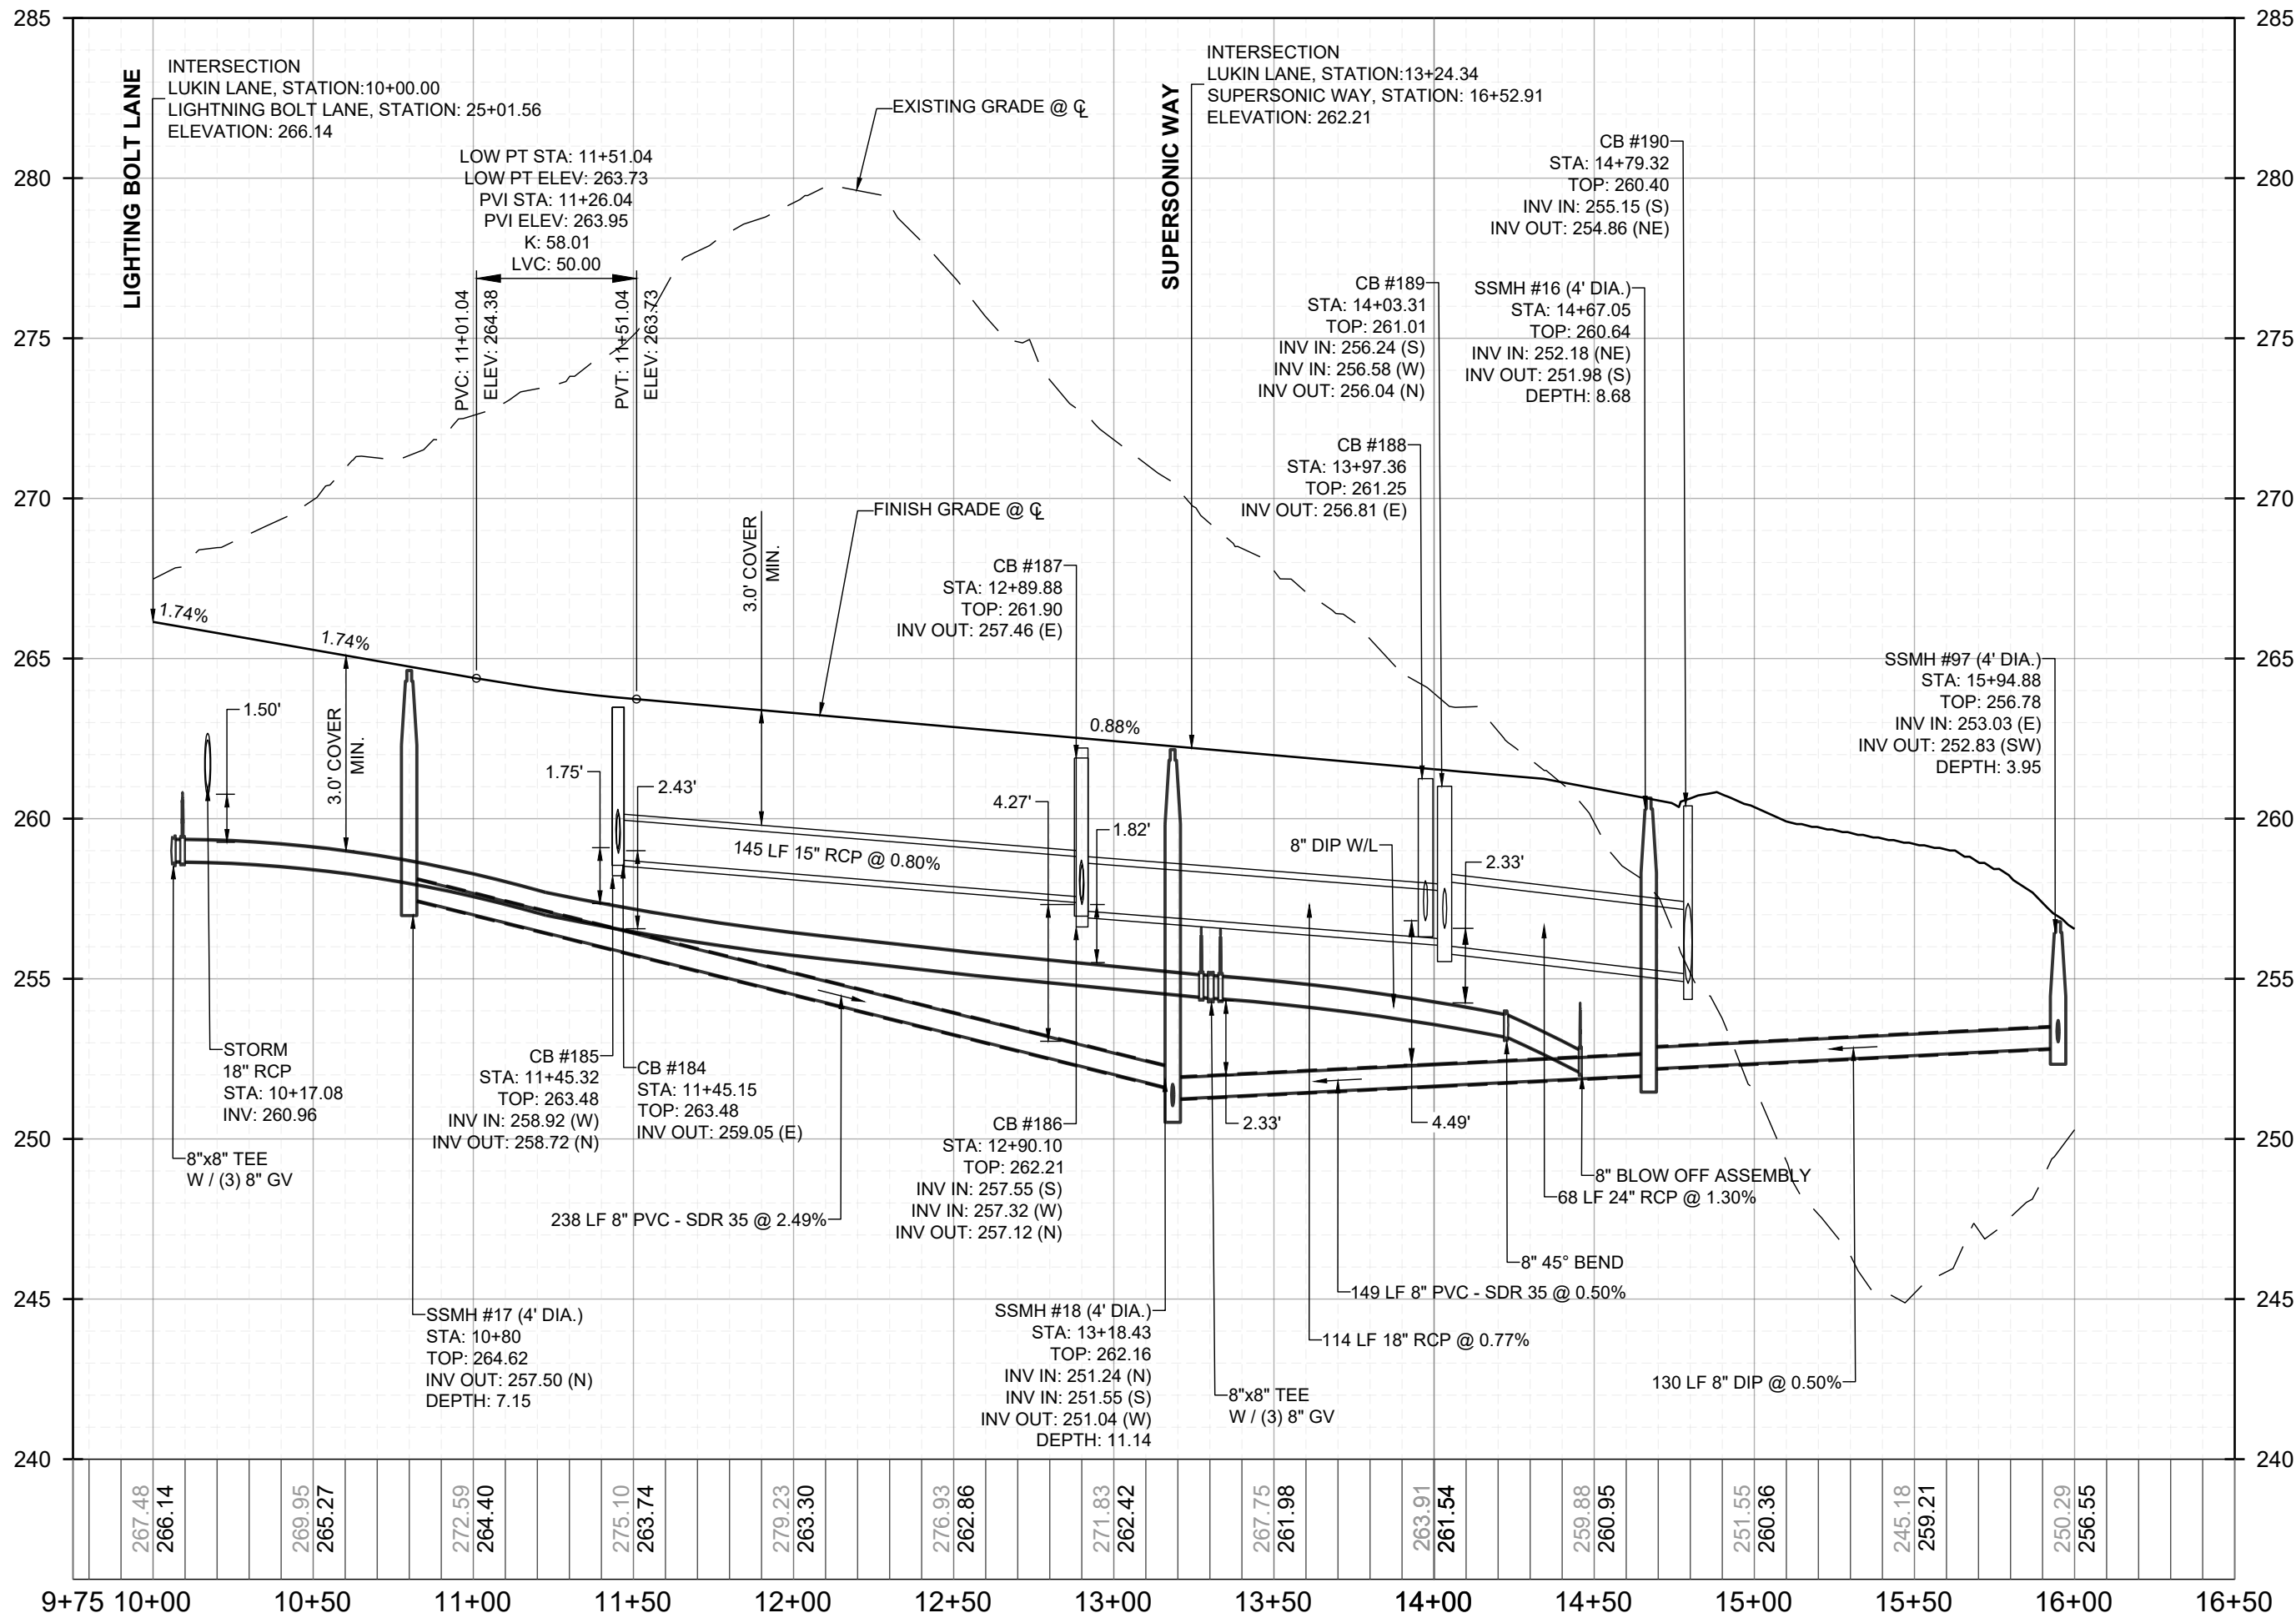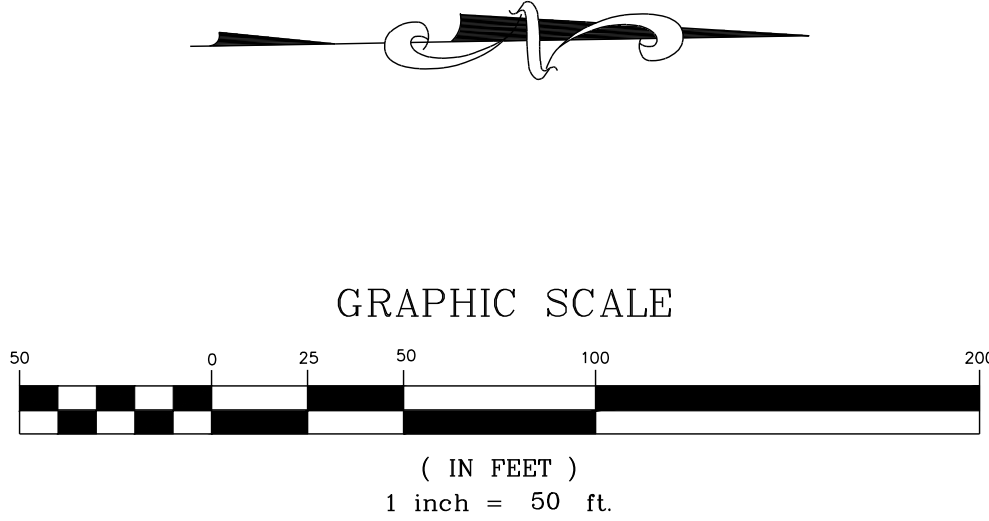

PROPOSED LUKIN LANE - PROFILE
VERTICAL: 1" = 5'
HORIZONTAL: 1" = 50'

PUBLIC
WATER DISTRIBUTION / EXTENSION SYSTEM
THE CITY OF RALEIGH CONSENTS TO THE CONNECTION AND EXTENSION OF THE CITY'S PUBLIC WATER SYSTEM AS SHOWN ON THIS PLAN. THE MATERIAL AND CONSTRUCTION METHODS USED FOR THIS PROJECT SHALL CONFORM TO THE STANDARDS AND SPECIFICATIONS OF THE CITY'S PUBLIC UTILITIES HANDBOOK. CITY OF RALEIGH
PUBLIC UTILITIES DEPARTMENT PERMIT # _____

PUBLIC
SEWER COLLECTION / EXTENSION SYSTEM
THE CITY OF RALEIGH CONSENTS TO THE CONNECTION AND EXTENSION OF THE CITY'S PUBLIC SEWER SYSTEM AS SHOWN ON THIS PLAN. THE MATERIAL AND CONSTRUCTION METHODS USED FOR THIS PROJECT SHALL CONFORM TO THE STANDARDS AND SPECIFICATIONS OF THE CITY'S PUBLIC UTILITIES HANDBOOK. CITY OF RALEIGH
PUBLIC UTILITIES DEPARTMENT PERMIT # _____

RESERVE @ MITCHELL MILL
TOWN OF ROLESVILLE, WAKE COUNTY, NORTH CAROLINA
CONSTRUCTION PLANS
PROPOSED LUKIN LANE -
PLAN & PROFILE

DRAWING
SHEET
C-11.13

109 OF 230

STRONG ROCK PROJECT
PSP-24-03

NOT FOR
CONSTRUCTION

SCALE
AS SHOWN

DESIGNED BY
SRG

DRAWN BY
SRG

CHECKED BY
SRG

STRONG ROCK
ENGINEERING GROUP

STRONG ROCK ENGINEERING GROUP, PLLC | COMPANY LICENSE # P-2166
305 CHURCH AT NORTH HILLS STREET, SUITE 1110 RALEIGH, NC 27609 | INFORMATION@STRONGROCKGROUP.COM

CONSTRUCTION INFRASTRUCTURE DRAWINGS
CID-24-04

01

02

<

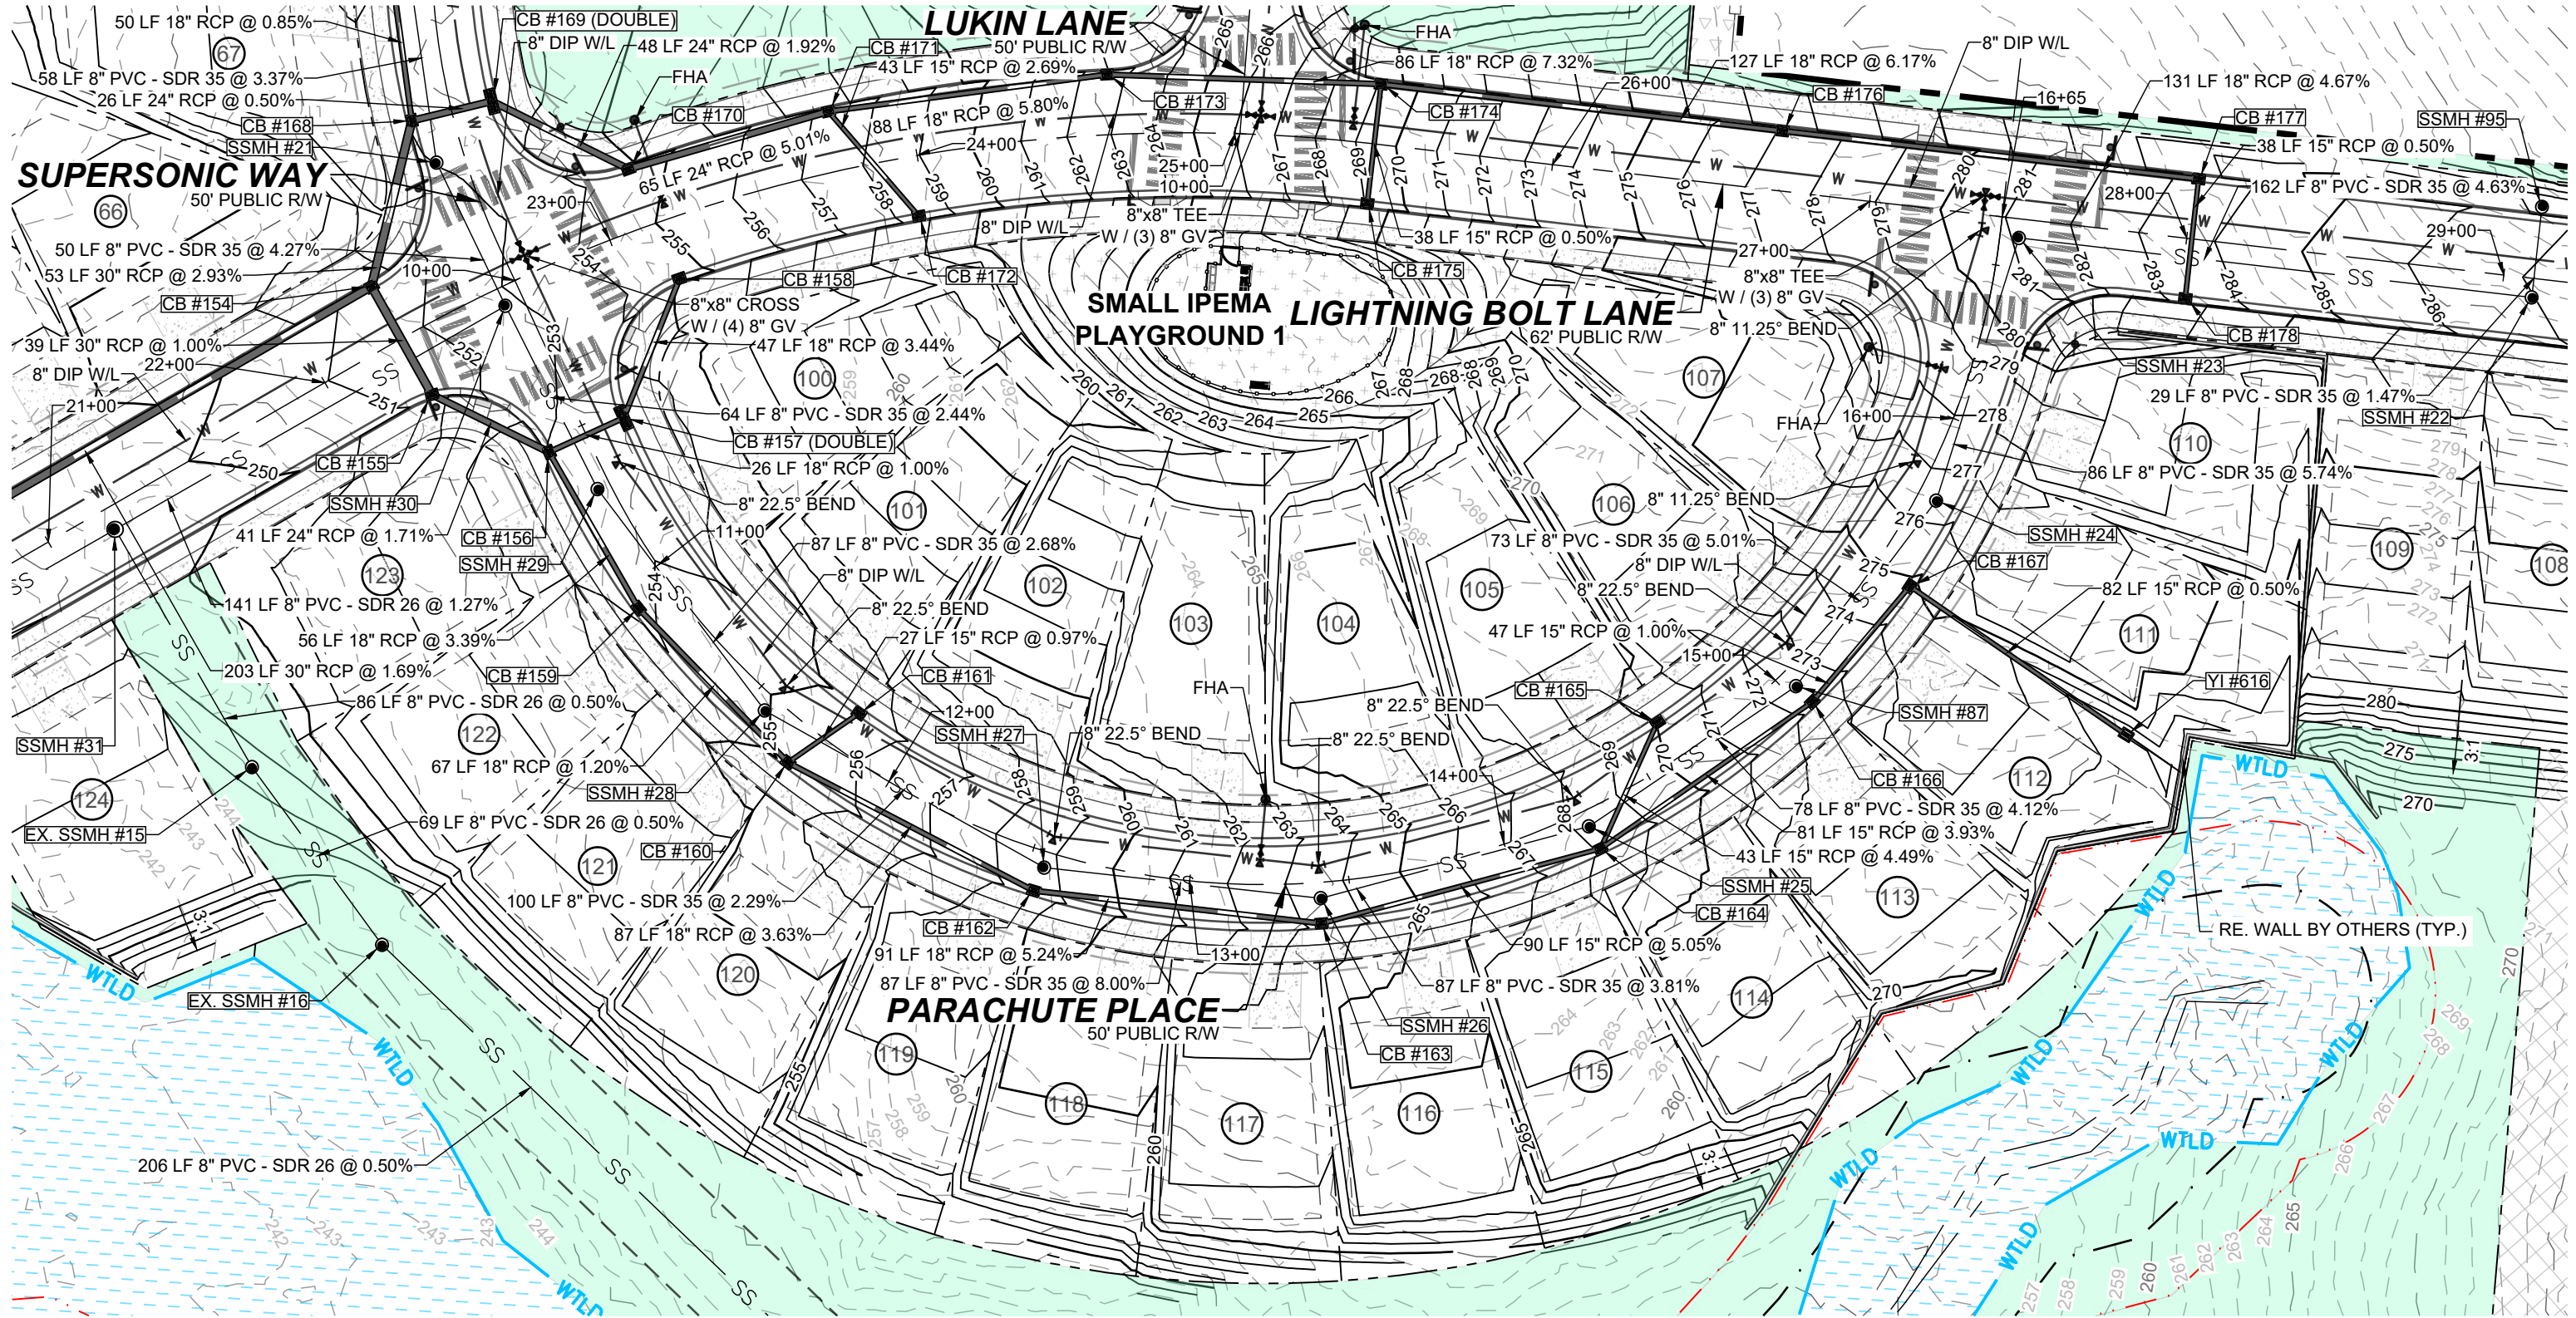

PROPOSED PARACHUTE PLACE - PLAN
HORIZONTAL: 1" = 50'

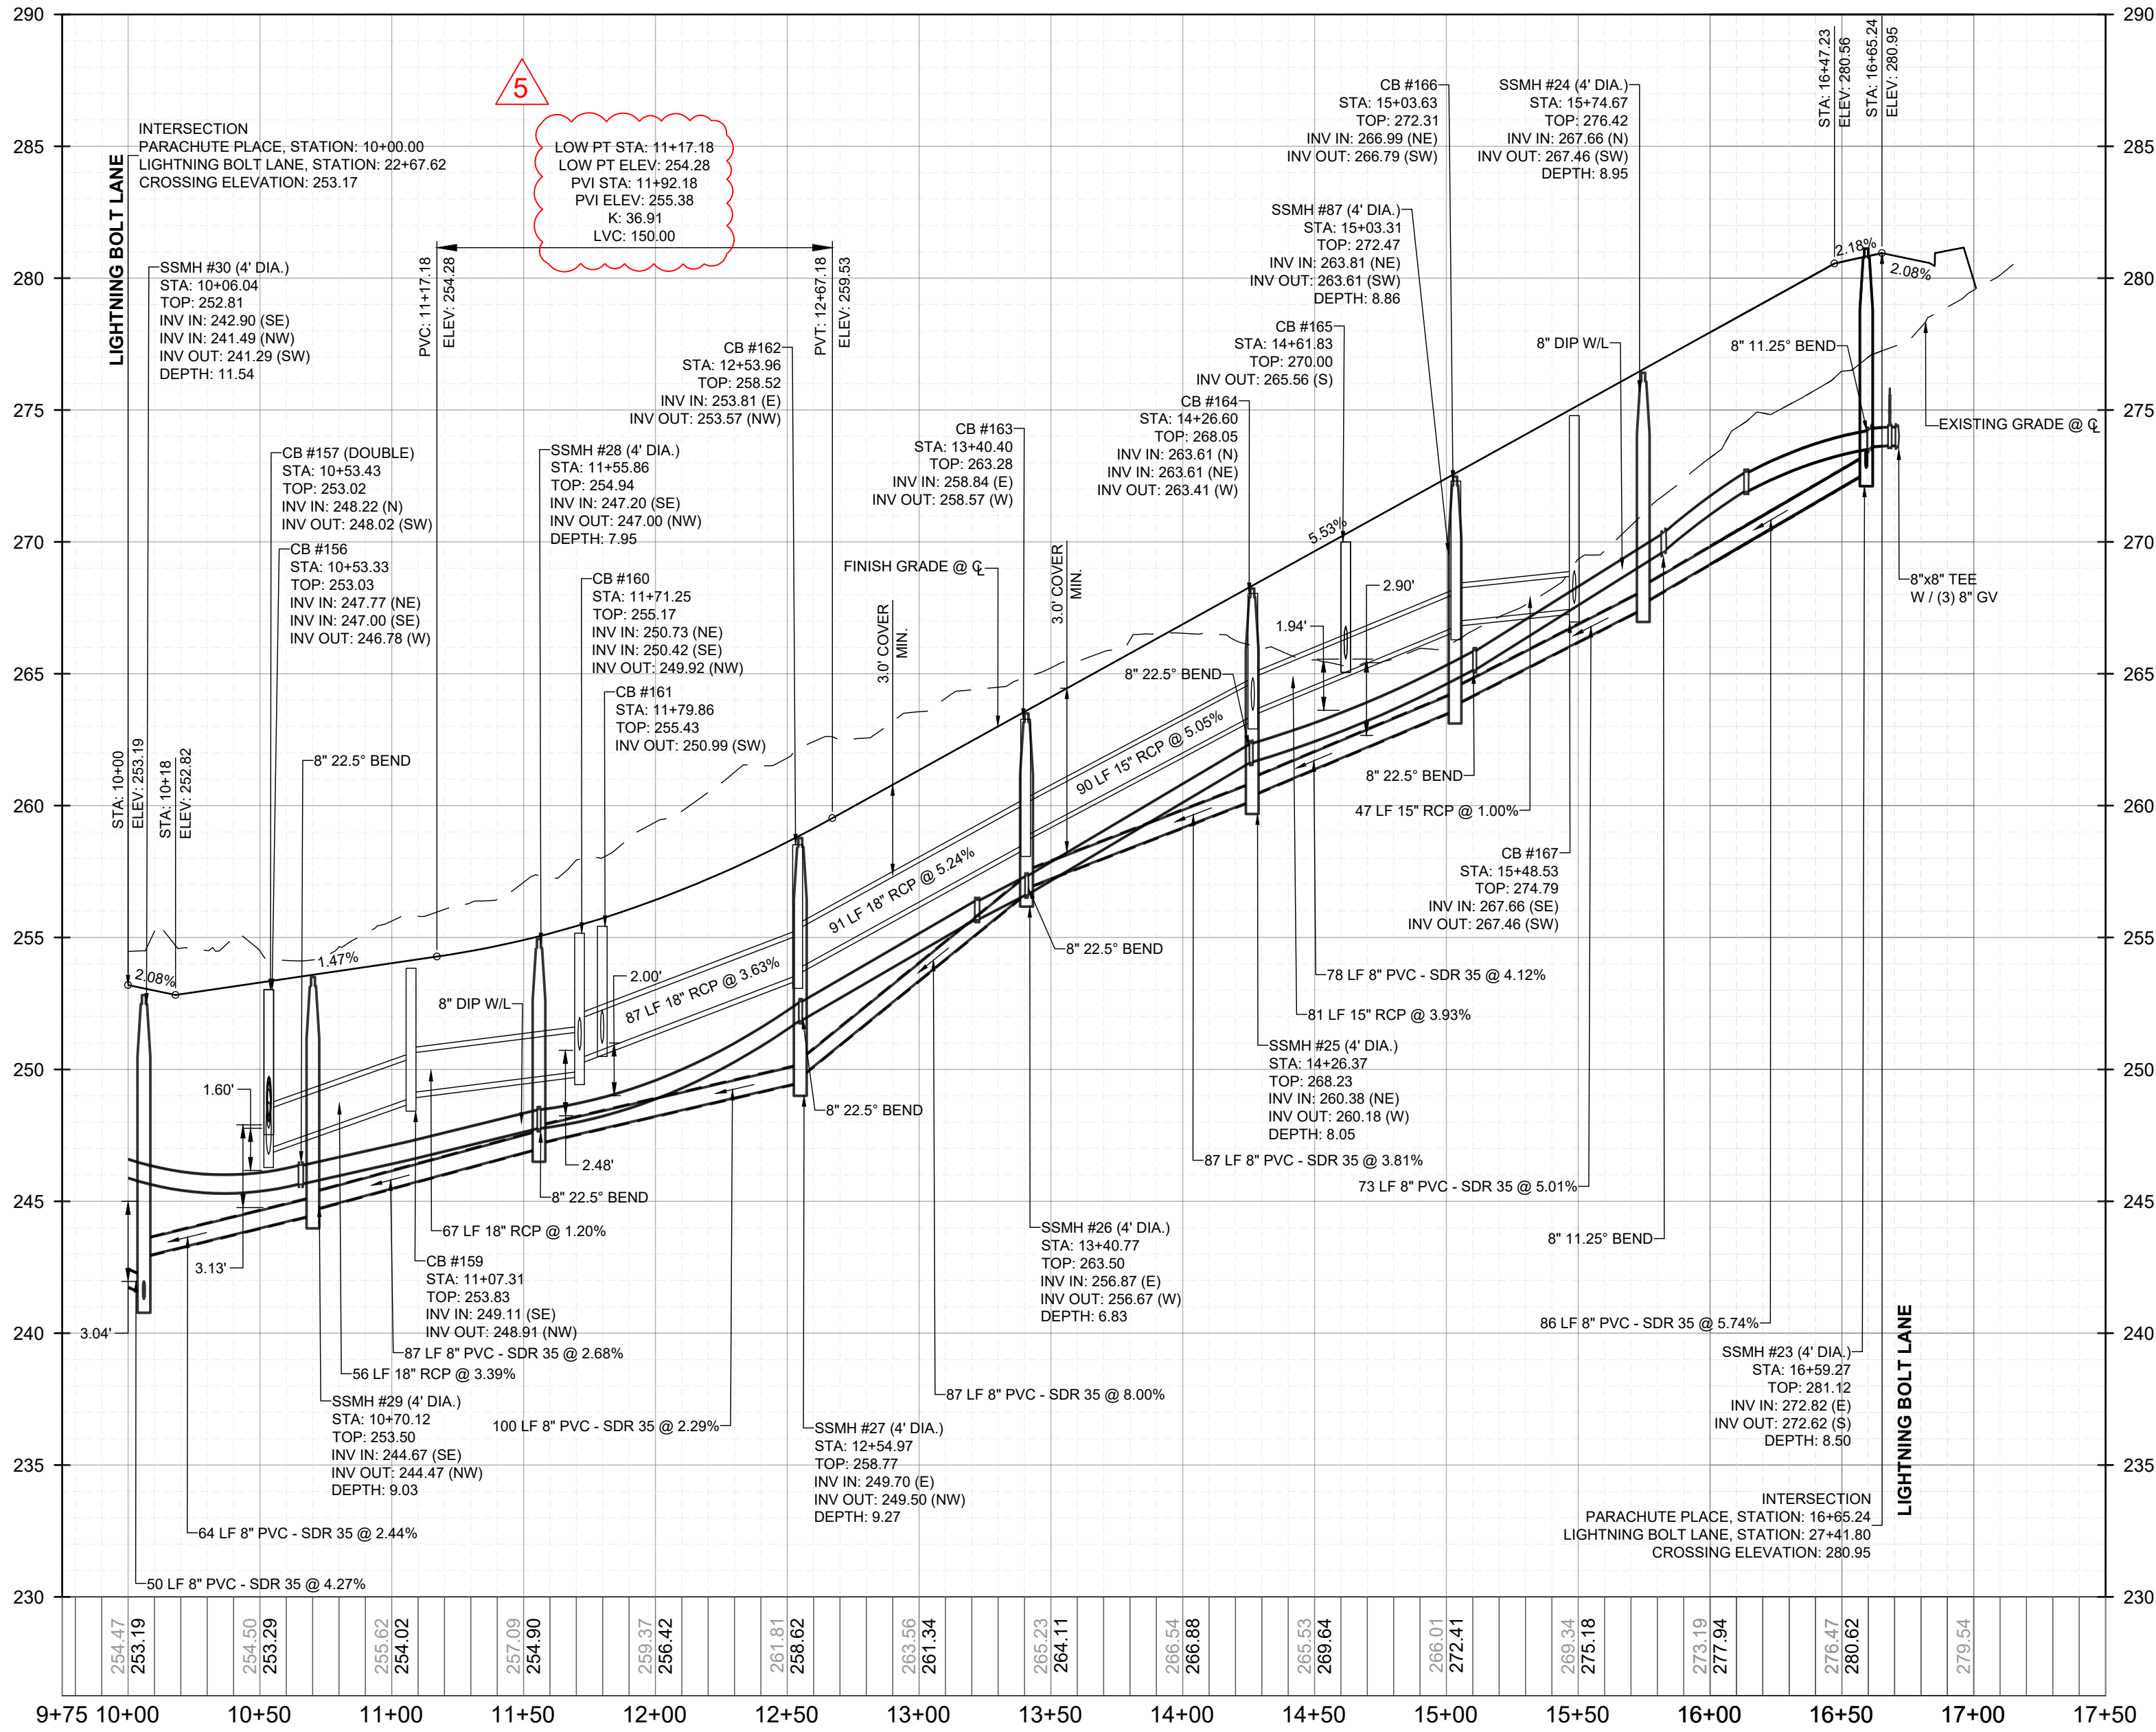

PROPOSED PARACHUTE PLACE - PROFILE
VERTICAL: 1" = 5'
HORIZONTAL: 1" = 50'

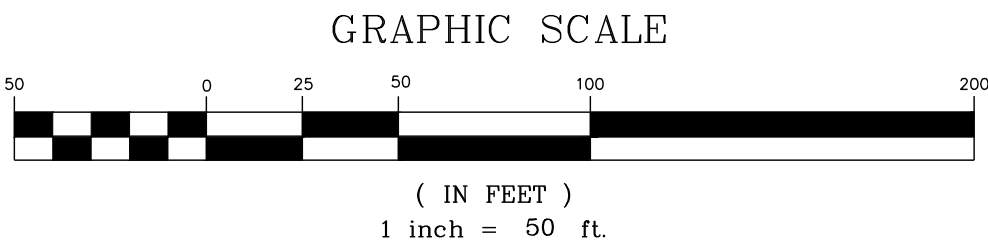

PUBLIC
WATER DISTRIBUTION / EXTENSION SYSTEM
THE CITY OF RALEIGH CONSENTS TO THE CONNECTION AND EXTENSION OF THE CITY'S PUBLIC WATER SYSTEM AS SHOWN ON THIS PLAN. THE MATERIAL AND CONSTRUCTION METHODS USED FOR THIS PROJECT SHALL CONFORM TO THE STANDARDS AND SPECIFICATIONS OF THE CITY'S PUBLIC UTILITIES HANDBOOK. CITY OF RALEIGH
PUBLIC UTILITIES DEPARTMENT PERMIT # _____

PUBLIC
SEWER COLLECTION / EXTENSION SYSTEM
THE CITY OF RALEIGH CONSENTS TO THE CONNECTION AND EXTENSION OF THE CITY'S PUBLIC SEWER SYSTEM AS SHOWN ON THIS PLAN. THE MATERIAL AND CONSTRUCTION METHODS USED FOR THIS PROJECT SHALL CONFORM TO THE STANDARDS AND SPECIFICATIONS OF THE CITY'S PUBLIC UTILITIES HANDBOOK. CITY OF RALEIGH
PUBLIC UTILITIES DEPARTMENT PERMIT # _____

SEAL:

STRONGROCK

ENGINEERING GROUP

STRONG ROCK ENGINEERING GROUP, PLLC | COMPANY LICENSE # P-2166
305 CHURCH AT NORTH HILLS STREET, SUITE 1110 RALEIGH, NC 27609 | INFORMATION@STRONGROCKGROUP.COM

CONSTRUCTION INFRASTRUCTURE DRAWINGS

01

02

03

04

05

CID-24-04

TOWN OF ROLESVILLE CID-24-04 V2

TOWN OF ROLESVILLE CID-24-04 V3

TOWN OF ROLESVILLE CID-24-04 V4

TOWN OF ROLESVILLE CID-24-04 V5

08/04/2024

11/07/2024

02/07/2024

08/02/2025

09/02/2025

SRG

SRG

SRG

SRG

SRG

DATE

REVISIONS

BY

RESERVE @ MITCHELL MILL

TOWN OF ROLESVILLE, WAKE COUNTY, NORTH CAROLINA

CONSTRUCTION PLANS


PROPOSED PARACHUTE PLACE

- PLAN & PROFILE

DRAWING SHEET

C-11.14

110 OF 230

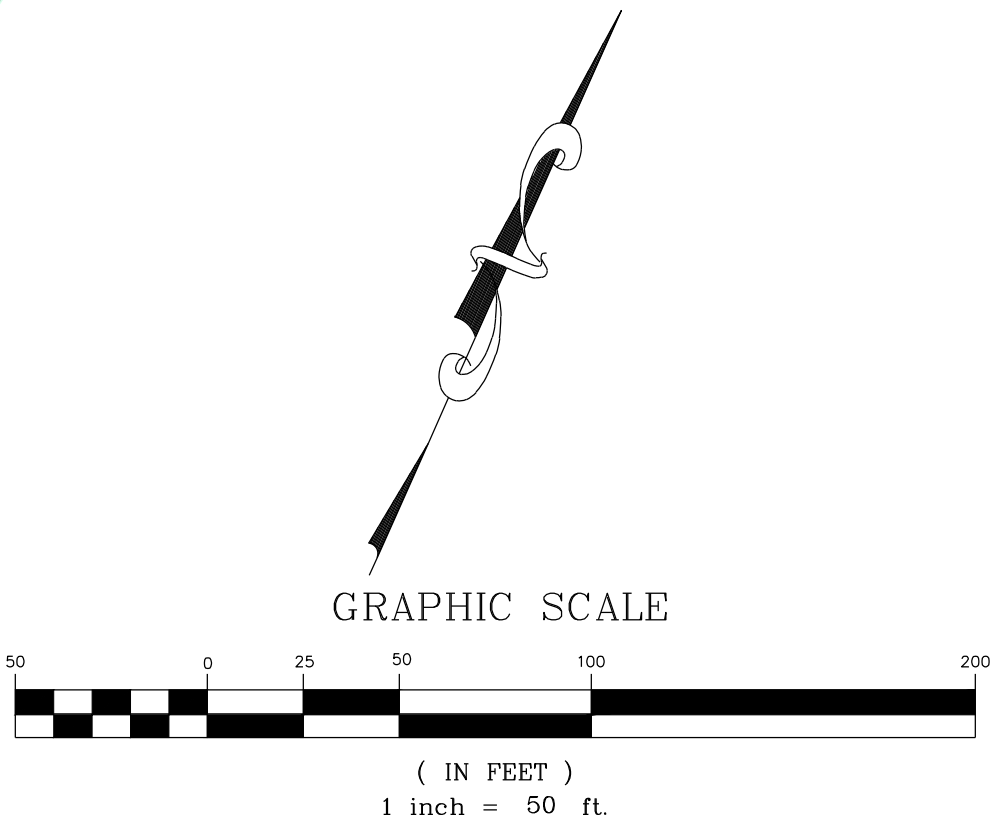

PUBLIC

WATER DISTRIBUTION / EXTENSION SYSTEM

THE CITY OF RALEIGH CONSENTS TO THE CONNECTION AND EXTENSION OF THE CITY'S PUBLIC WATER SYSTEM AS SHOWN ON THIS PLAN. THE MATERIAL AND CONSTRUCTION METHODS USED FOR THIS PROJECT SHALL CONFORM TO THE STANDARDS AND SPECIFICATIONS OF THE CITY'S PUBLIC UTILITIES HANDBOOK.


CITY OF RALEIGH
PUBLIC UTILITIES DEPARTMENT PERMIT # _____


PUBLIC

SEWER COLLECTION / EXTENSION SYSTEM


THE CITY OF RALEIGH CONSENTS TO THE CONNECTION AND EXTENSION OF THE CITY'S PUBLIC SEWER SYSTEM AS SHOWN ON THIS PLAN. THE MATERIAL AND CONSTRUCTION METHODS USED FOR THIS PROJECT SHALL CONFORM TO THE STANDARDS AND SPECIFICATIONS OF THE CITY'S PUBLIC UTILITIES HANDBOOK.


CITY OF RALEIGH
PUBLIC UTILITIES DEPARTMENT PERMIT # _____

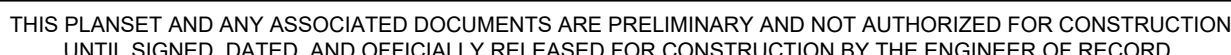


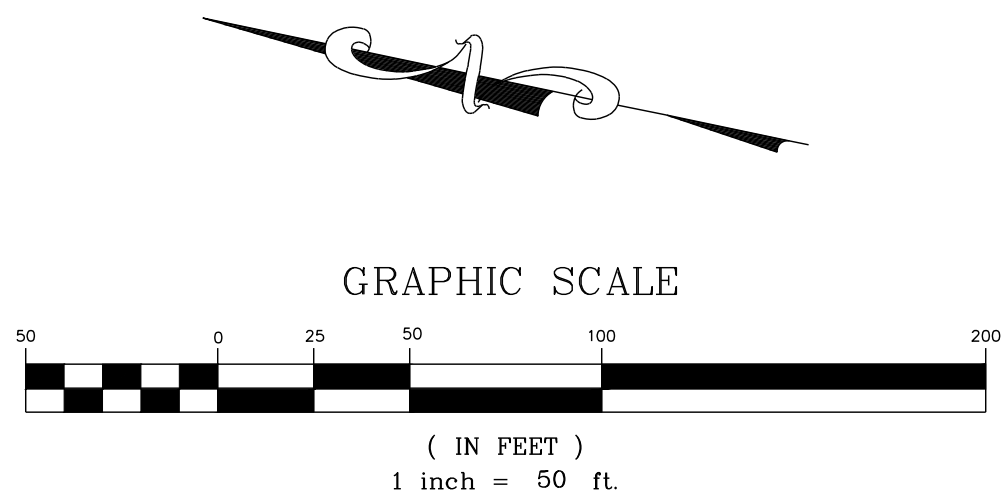


PUBLIC <u>WATER DISTRIBUTION / EXTENSION SYSTEM</u> THE CITY OF RALEIGH CONSENTS TO THE CONNECTION AND EXTENSION OF THE CITY'S PUBLIC WATER SYSTEM AS SHOWN ON THIS PLAN. THE MATERIAL AND CONSTRUCTION METHODS USED FOR THIS PROJECT SHALL CONFORM TO THE STANDARDS AND SPECIFICATIONS OF THE CITY'S PUBLIC UTILITIES HANDBOOK. CITY OF RALEIGH PUBLIC UTILITIES DEPARTMENT PERMIT # _____
--

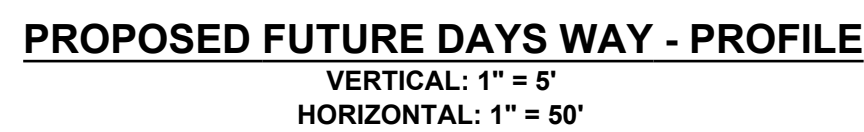

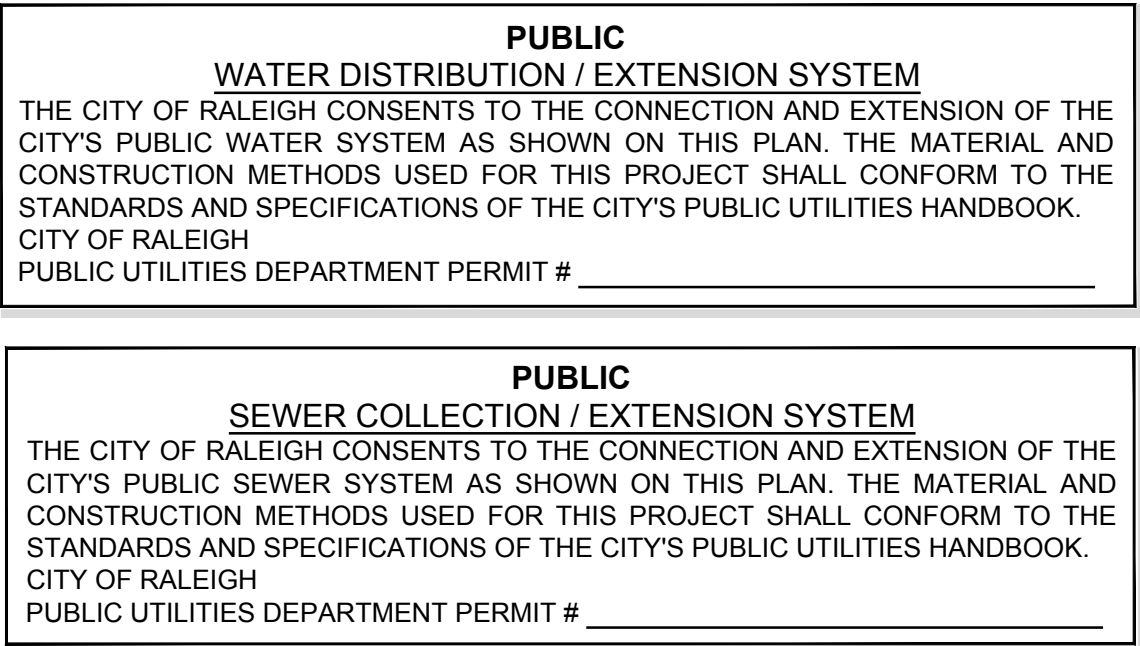


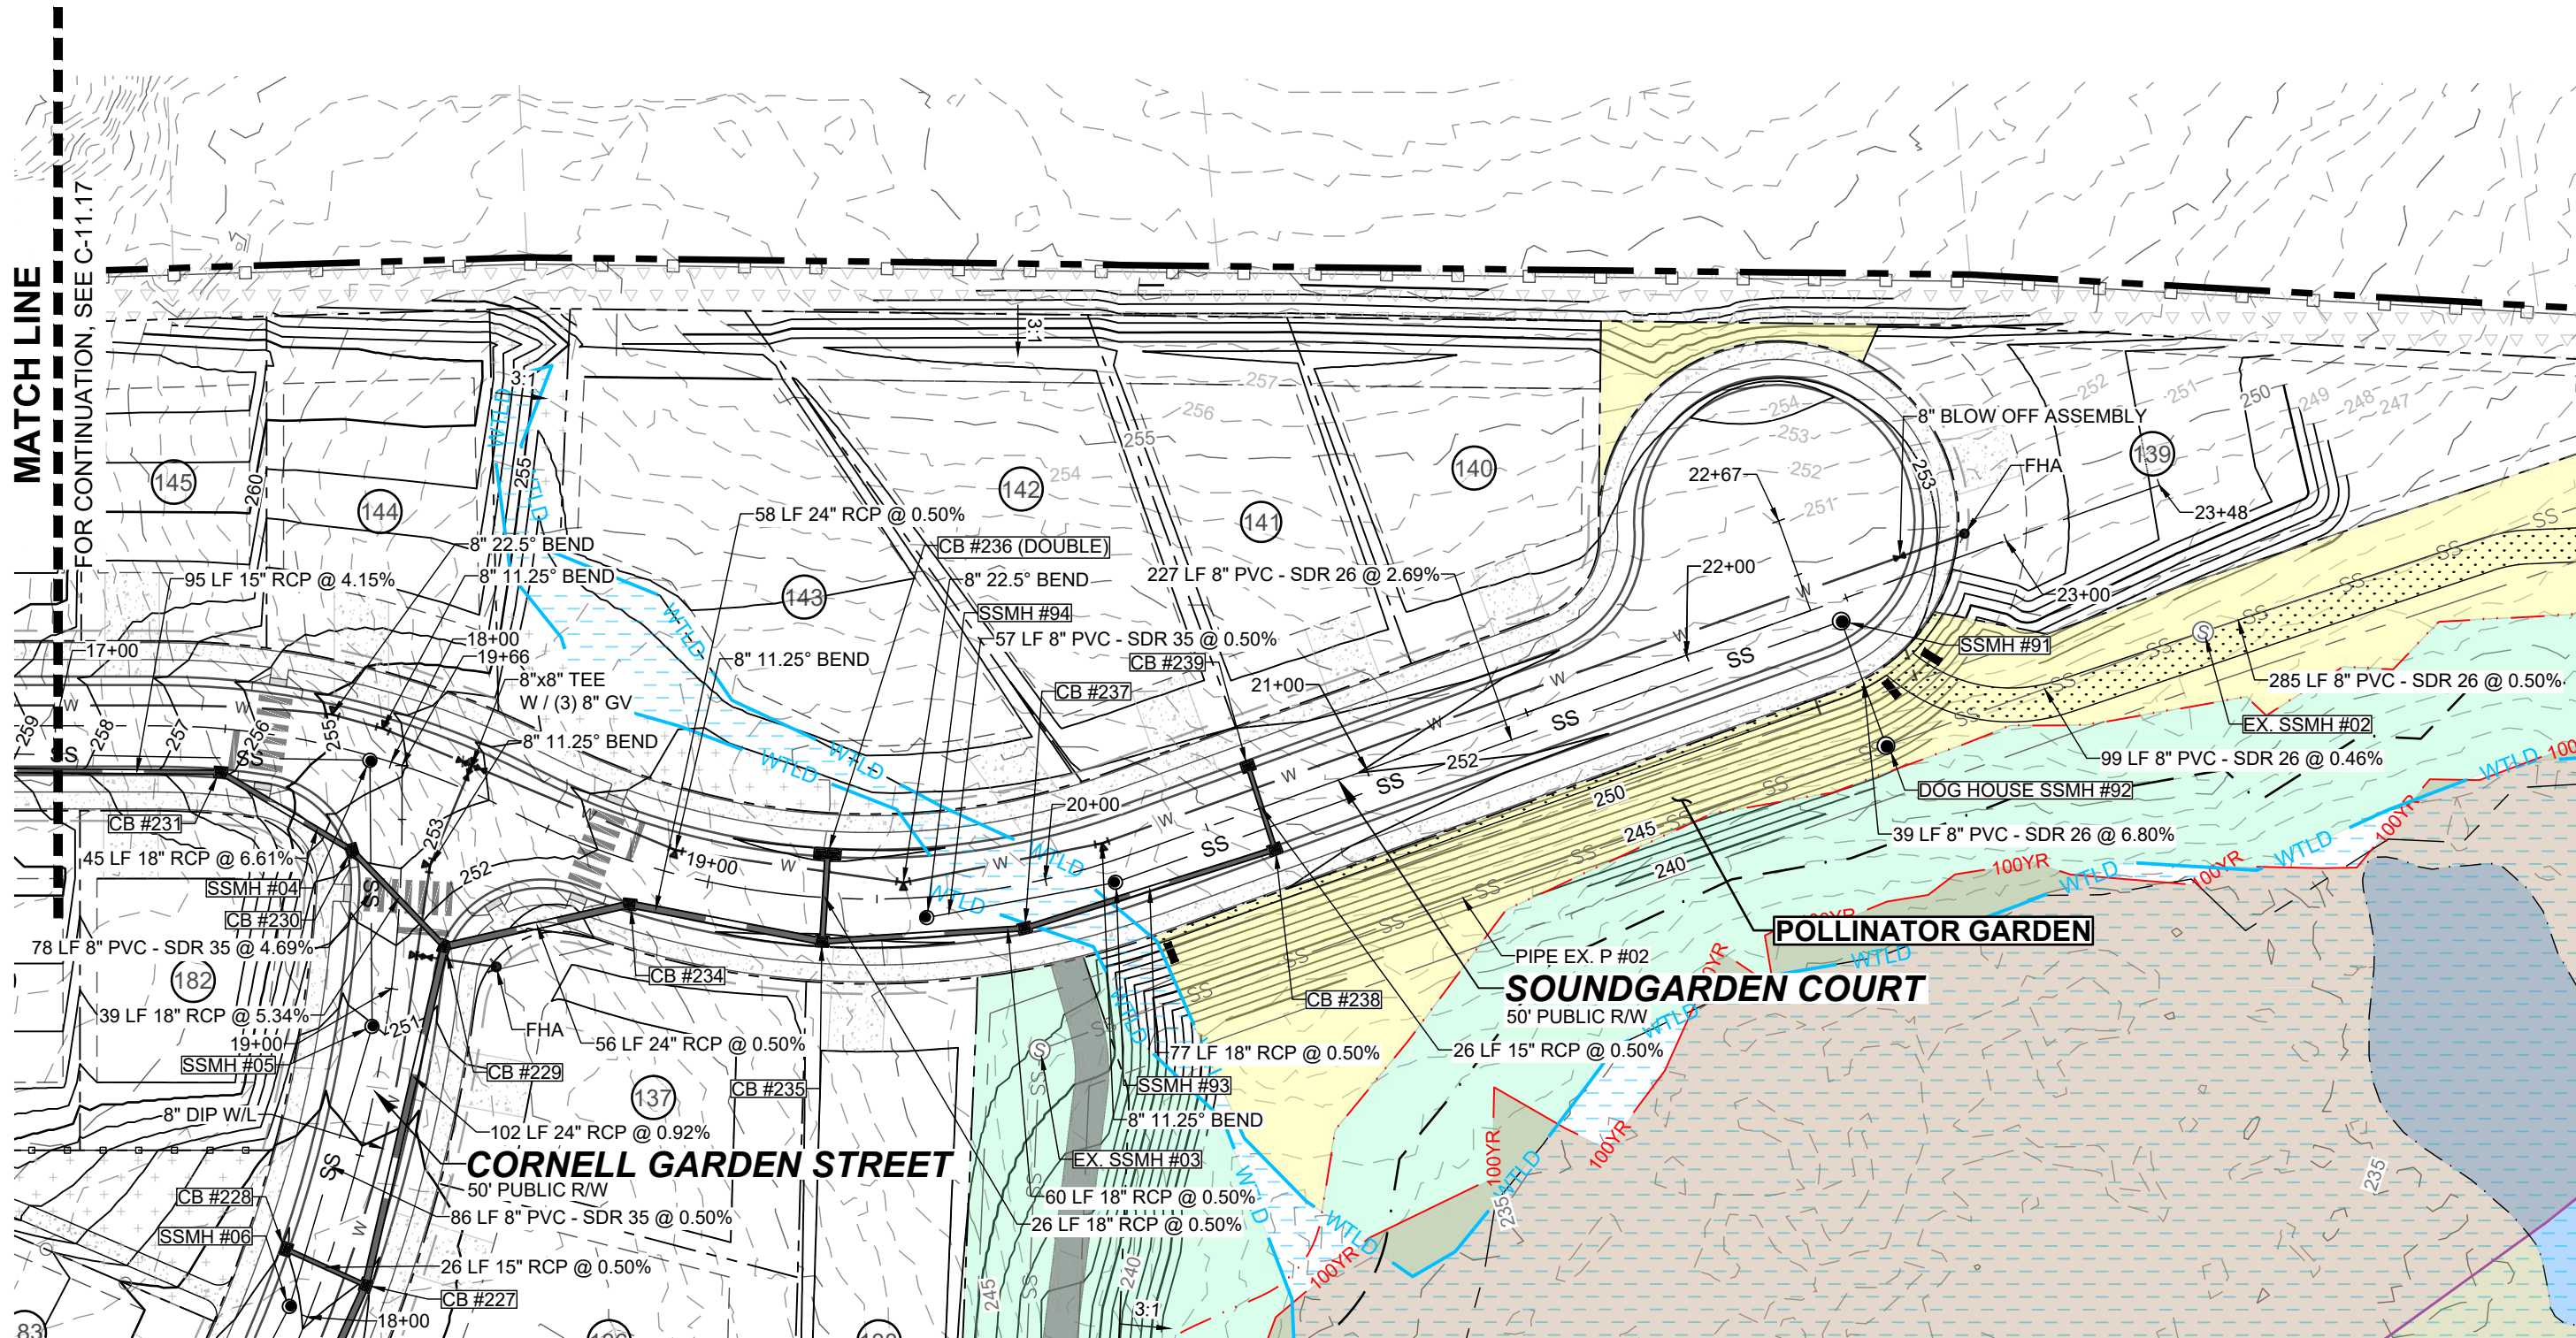

PROPOSED SOUNDGARDEN COURT - PLAN
HORIZONTAL: 1" = 50'

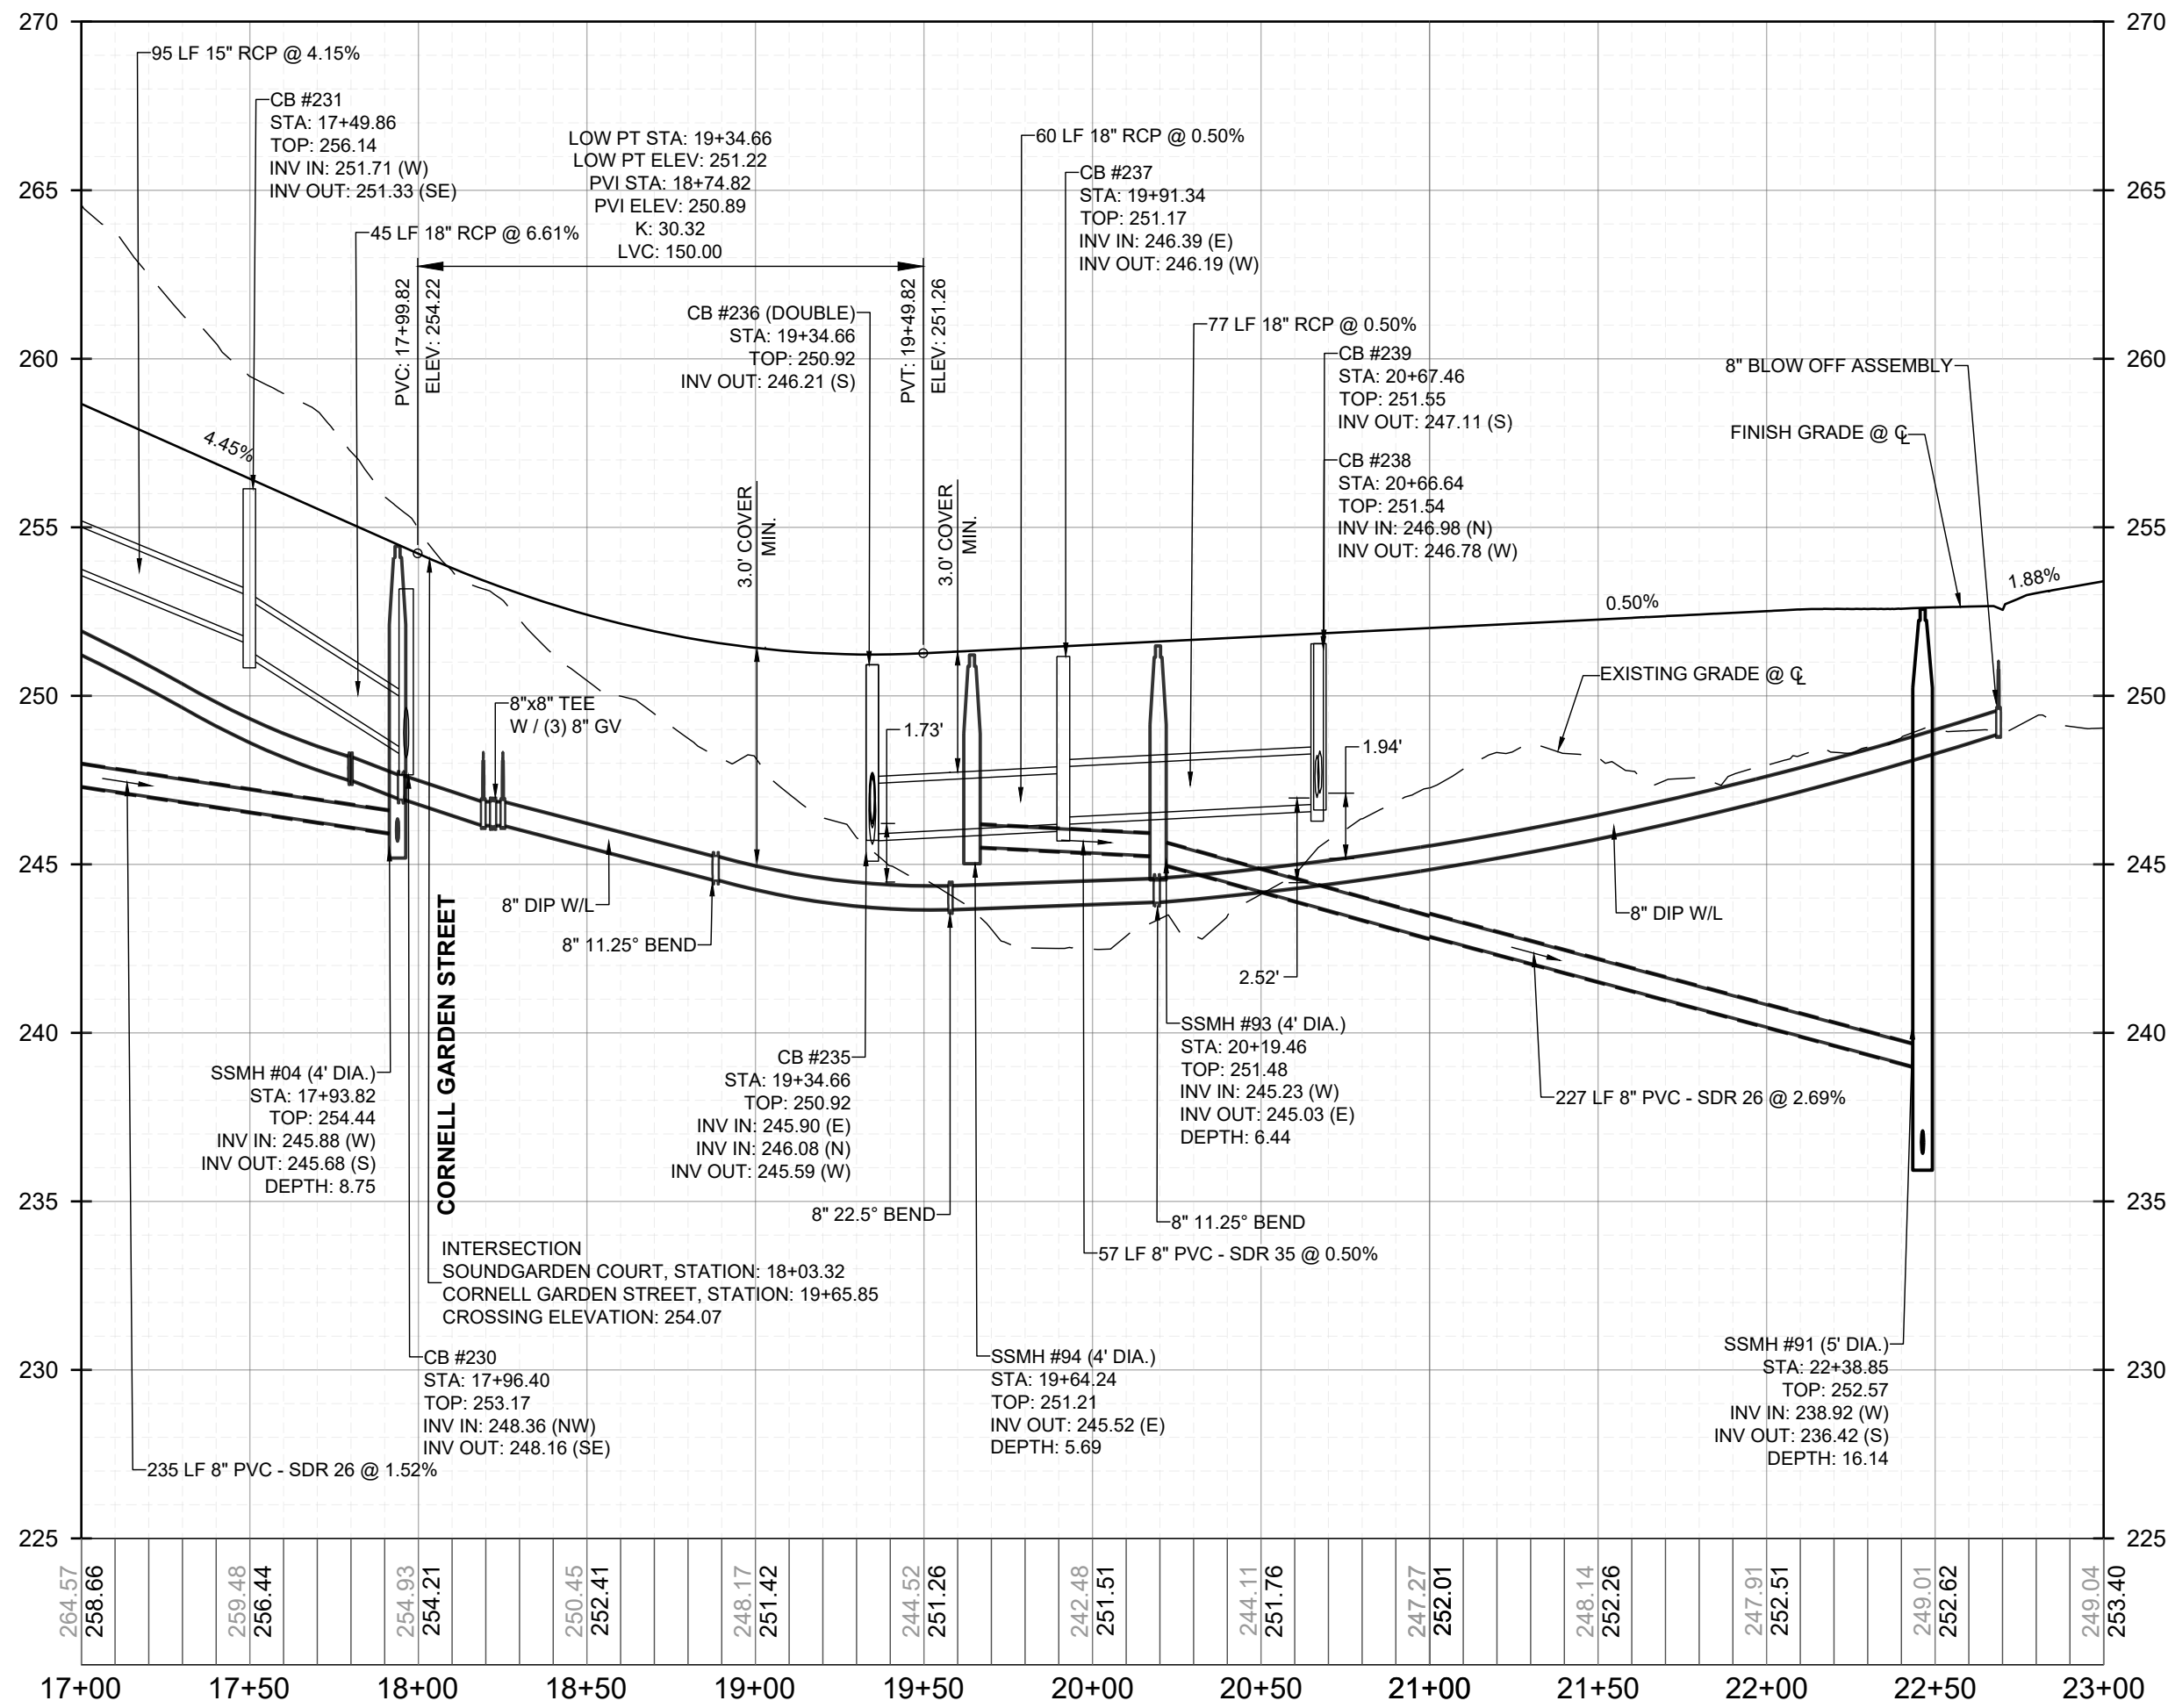

PROPOSED SOUNDGARDEN COURT - PROFILE
VERTICAL: 1" = 5'
HORIZONTAL: 1" = 50'

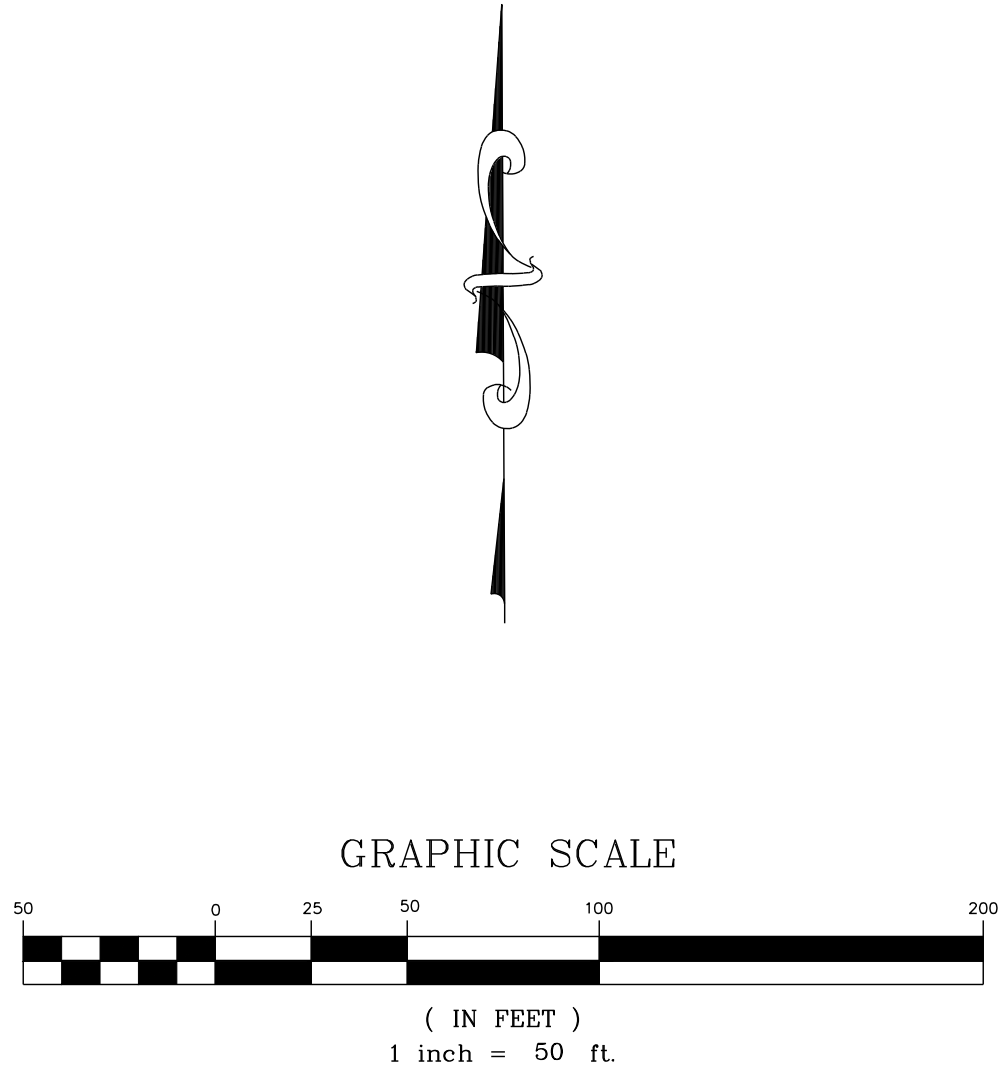

PUBLIC
WATER DISTRIBUTION / EXTENSION SYSTEM
THE CITY OF RALEIGH CONSENTS TO THE CONNECTION AND EXTENSION OF THE CITY'S PUBLIC WATER SYSTEM AS SHOWN ON THIS PLAN. THE MATERIAL AND CONSTRUCTION METHODS USED FOR THIS PROJECT SHALL CONFORM TO THE STANDARDS AND SPECIFICATIONS OF THE CITY'S PUBLIC UTILITIES HANDBOOK. CITY OF RALEIGH
PUBLIC UTILITIES DEPARTMENT PERMIT # _____

PUBLIC
SEWER COLLECTION / EXTENSION SYSTEM
THE CITY OF RALEIGH CONSENTS TO THE CONNECTION AND EXTENSION OF THE CITY'S PUBLIC SEWER SYSTEM AS SHOWN ON THIS PLAN. THE MATERIAL AND CONSTRUCTION METHODS USED FOR THIS PROJECT SHALL CONFORM TO THE STANDARDS AND SPECIFICATIONS OF THE CITY'S PUBLIC UTILITIES HANDBOOK. CITY OF RALEIGH
PUBLIC UTILITIES DEPARTMENT PERMIT # _____

SEAL:

STRONGROCK

ENGINEERING GROUP

STRONG ROCK ENGINEERING GROUP, PLLC | COMPANY LICENSE # P-2166
305 CHURCH AT NORTH HILLS STREET, SUITE 1110 RALEIGH, NC 27609 | INFORMATION@STRONGROCKGROUP.COM

CONSTRUCTION INFRASTRUCTURE DRAWINGS
CID-24-04

01

02

135

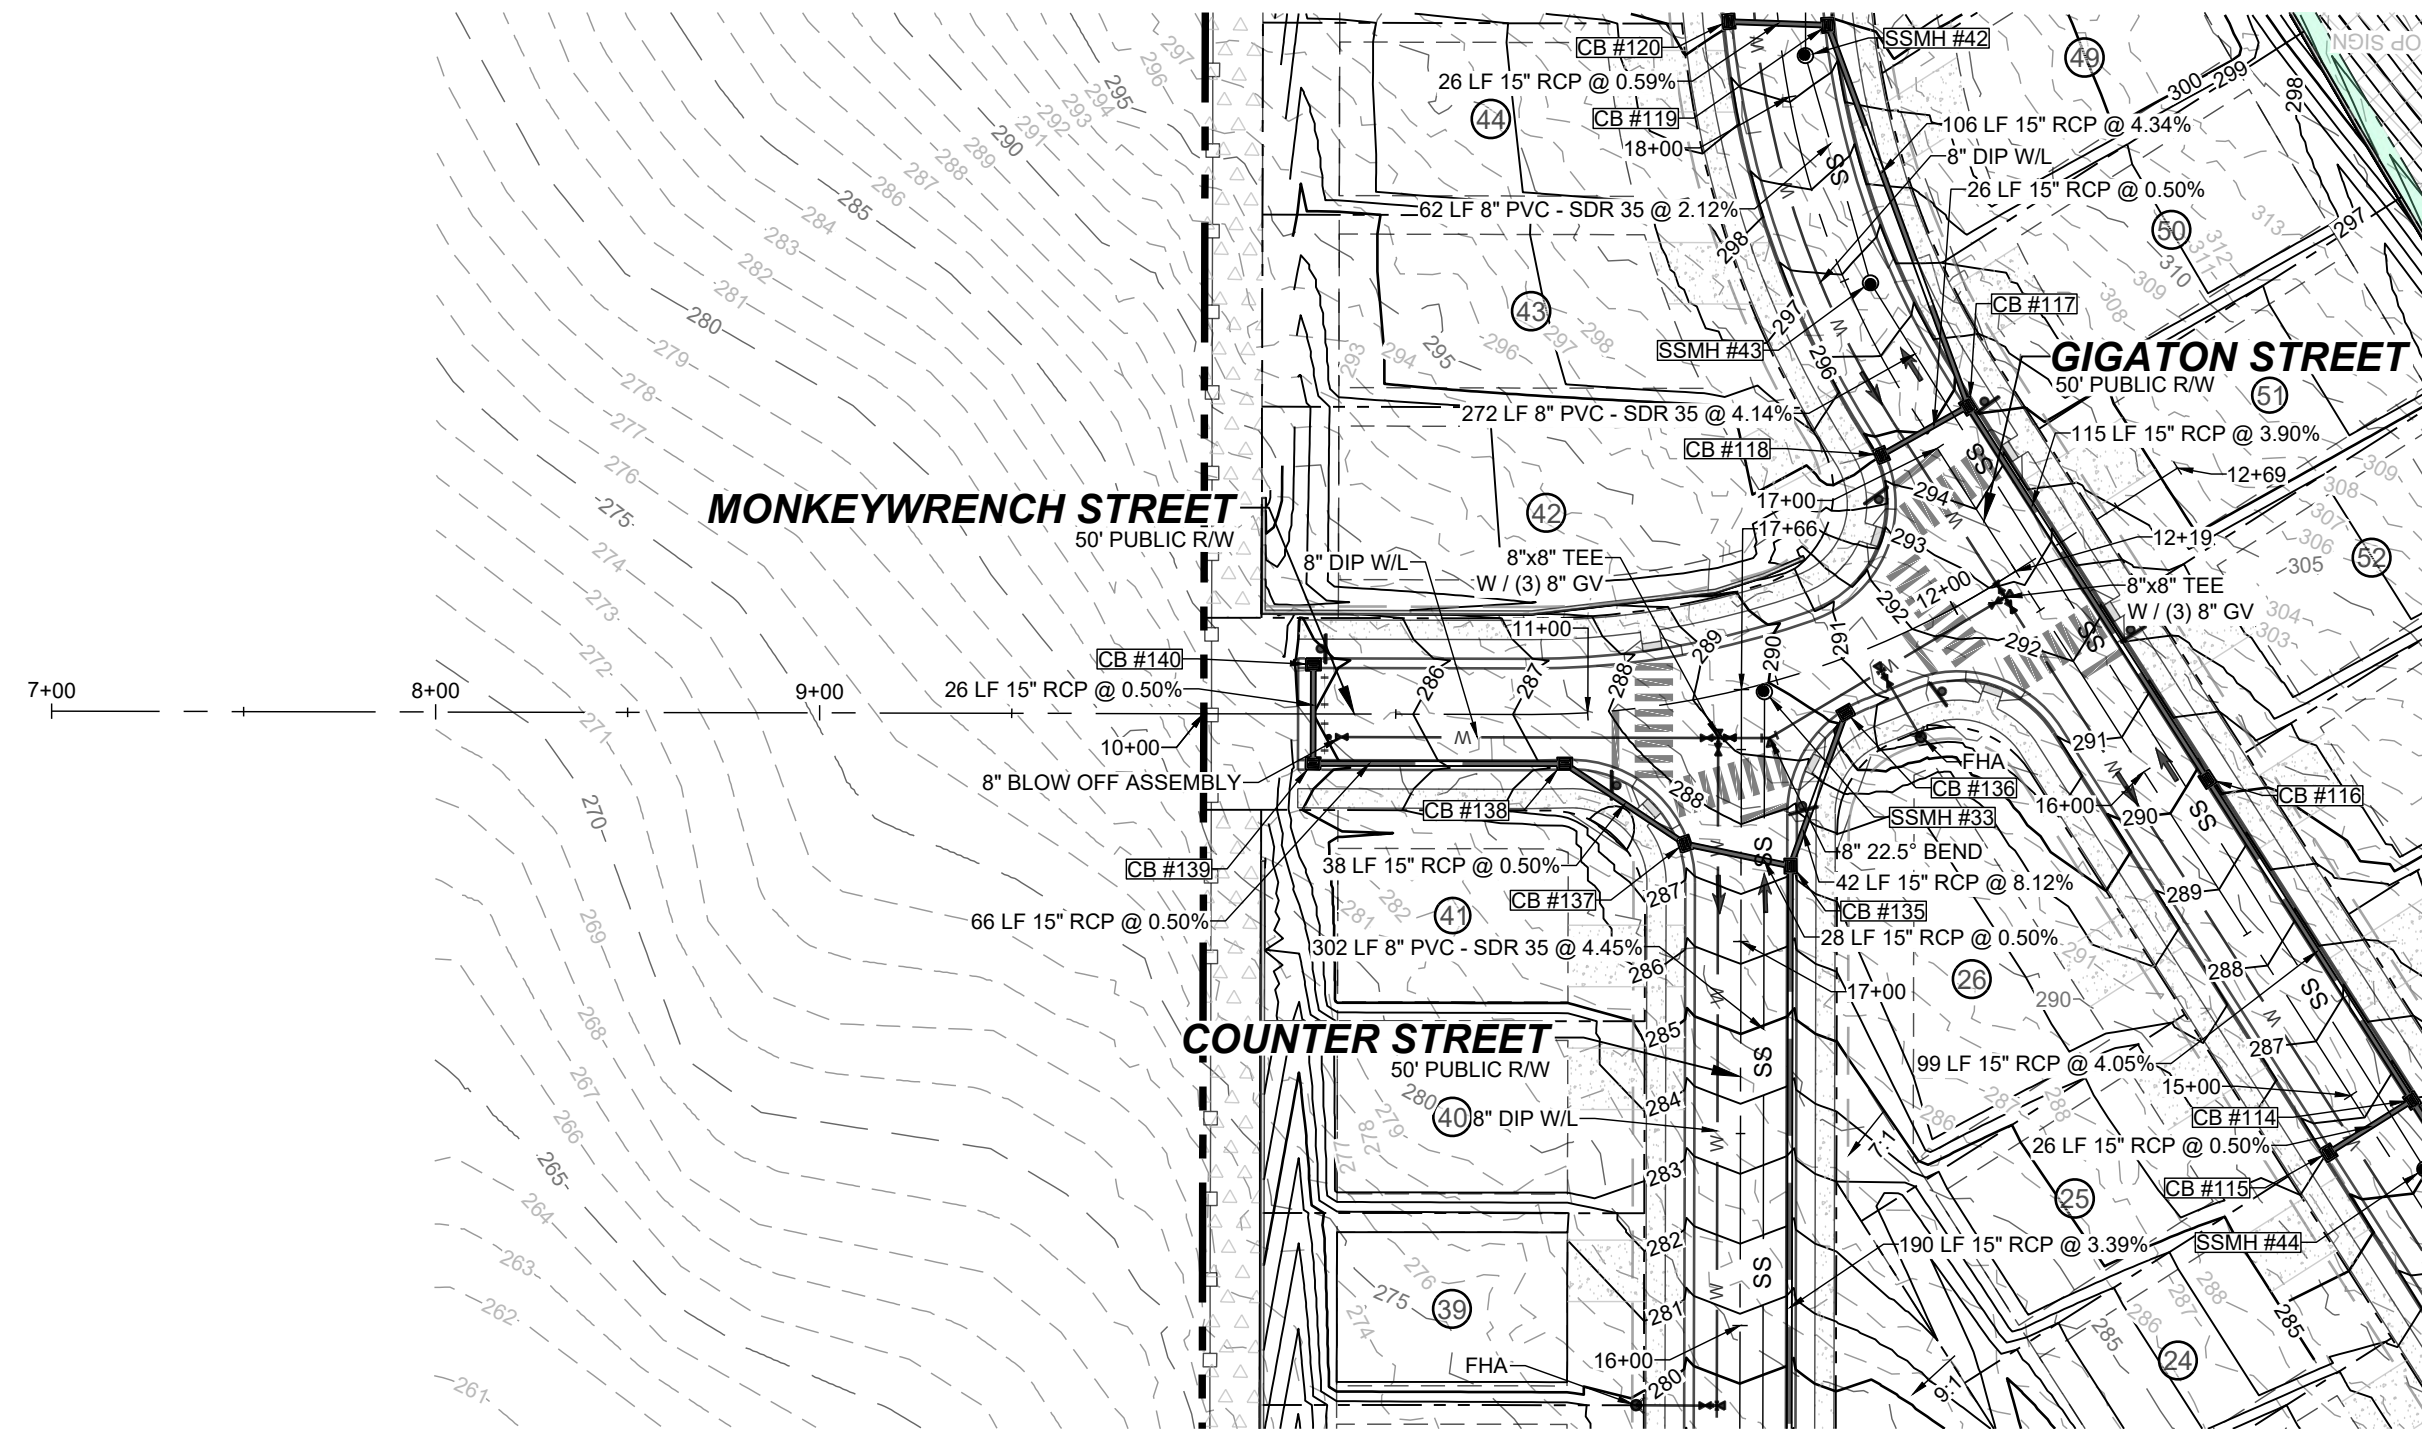

PROPOSED MONKEYWRENCH STREET - PLAN
HORIZONTAL: 1" = 50'

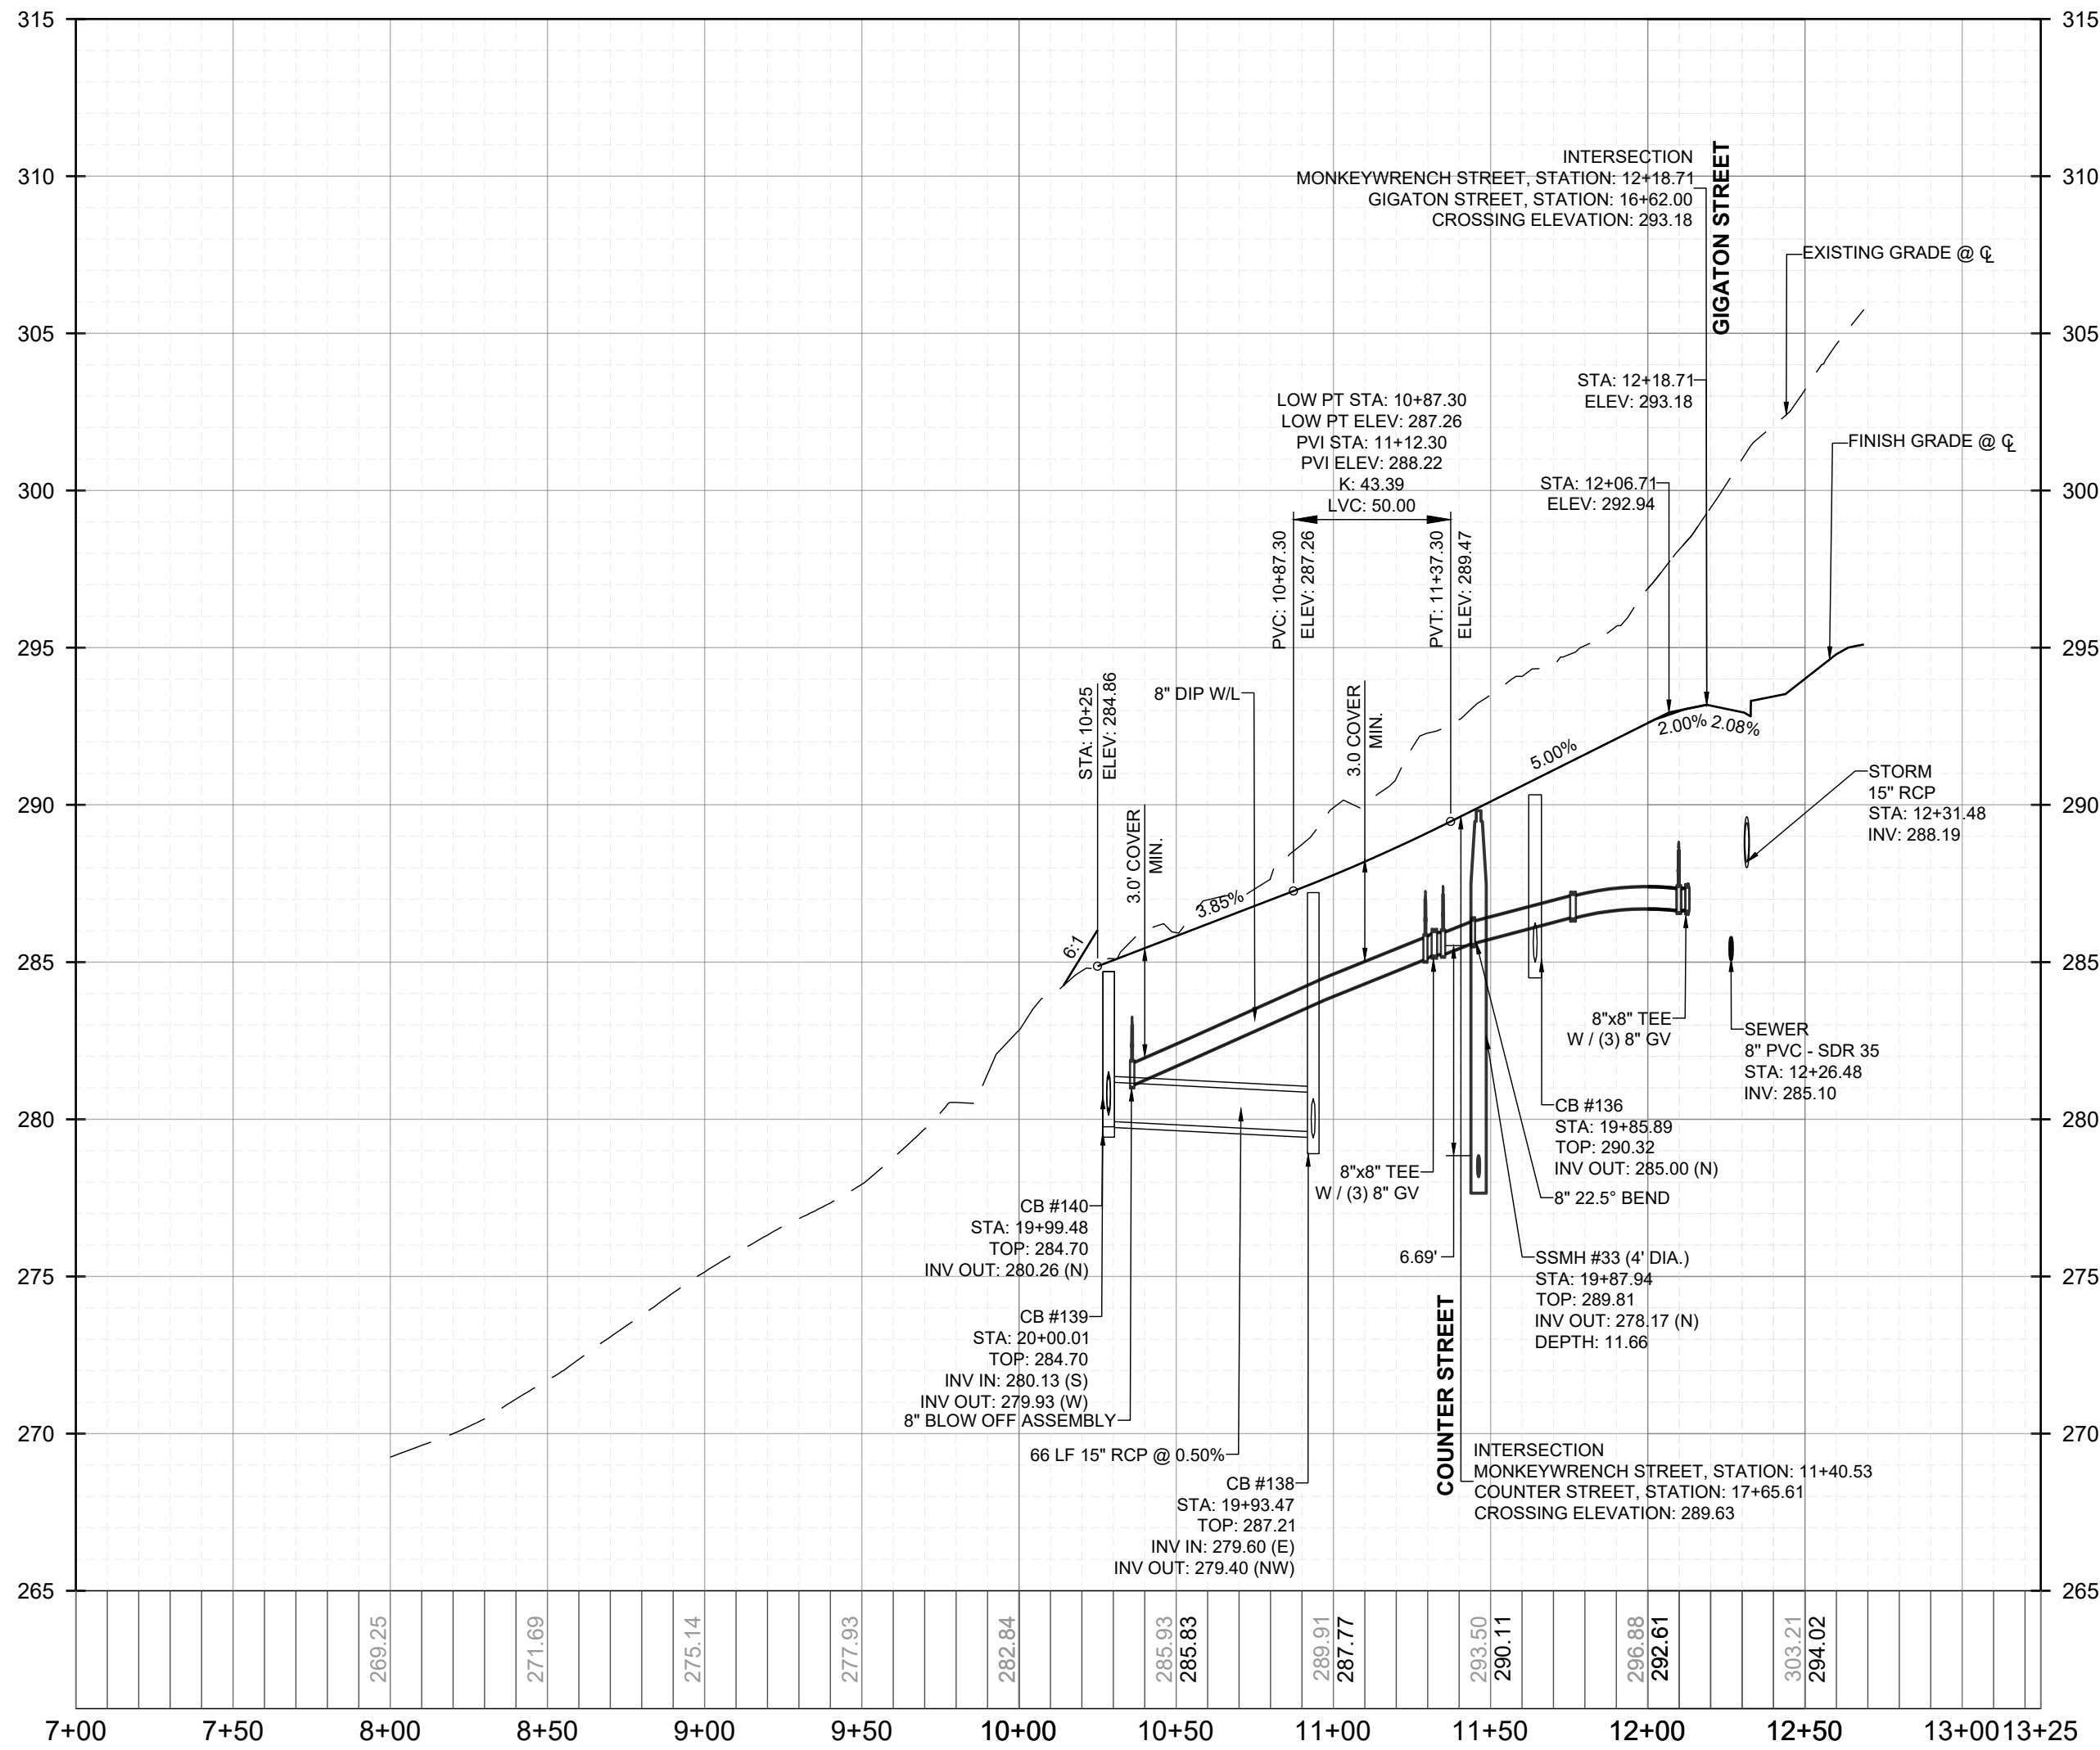

PROPOSED MONKEYWRENCH STREET - PROFILE
VERTICAL: 1" = 5'
HORIZONTAL: 1" = 50'

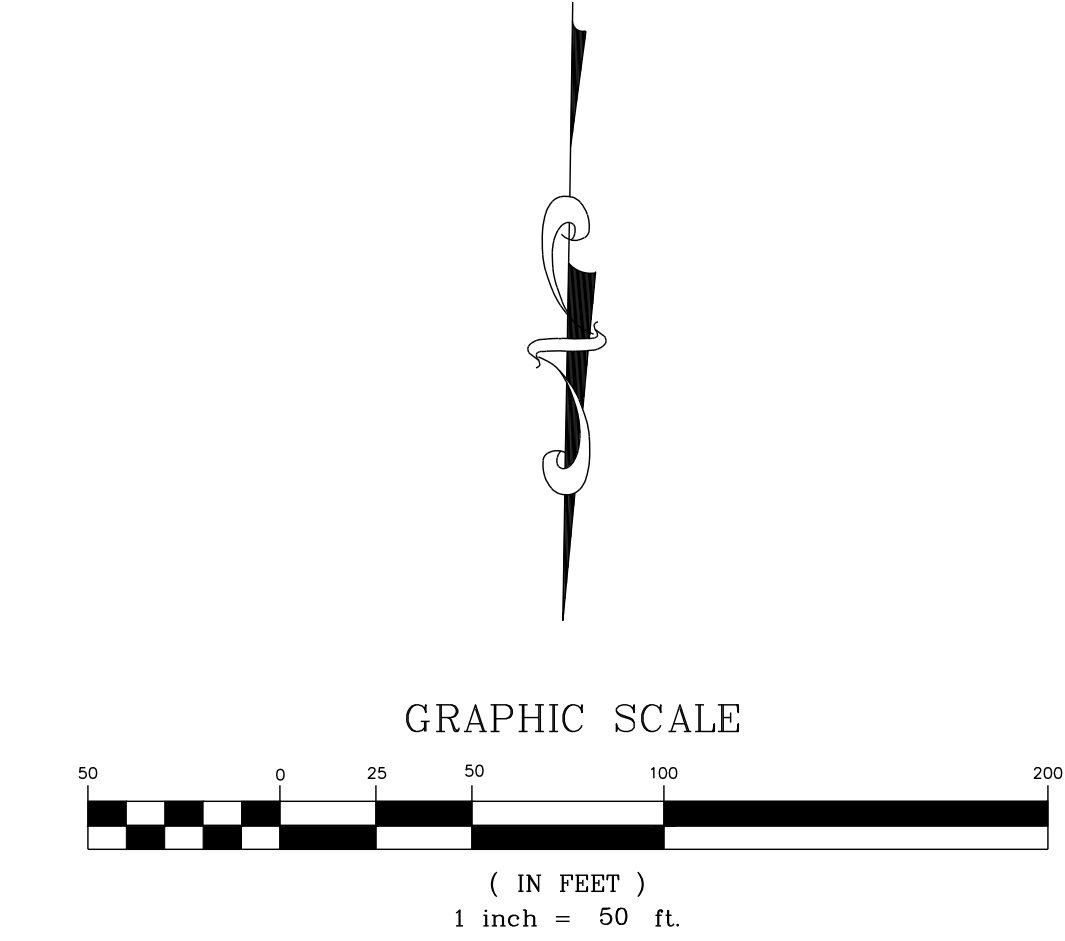

PUBLIC
WATER DISTRIBUTION / EXTENSION SYSTEM
THE CITY OF RALEIGH CONSENTS TO THE CONNECTION AND EXTENSION OF THE CITY'S PUBLIC WATER SYSTEM AS SHOWN ON THIS PLAN. THE MATERIAL AND CONSTRUCTION METHODS USED FOR THIS PROJECT SHALL CONFORM TO THE STANDARDS AND SPECIFICATIONS OF THE CITY'S PUBLIC UTILITIES HANDBOOK. CITY OF RALEIGH
PUBLIC UTILITIES DEPARTMENT PERMIT # _____

PUBLIC
SEWER COLLECTION / EXTENSION SYSTEM
THE CITY OF RALEIGH CONSENTS TO THE CONNECTION AND EXTENSION OF THE CITY'S PUBLIC SEWER SYSTEM AS SHOWN ON THIS PLAN. THE MATERIAL AND CONSTRUCTION METHODS USED FOR THIS PROJECT SHALL CONFORM TO THE STANDARDS AND SPECIFICATIONS OF THE CITY'S PUBLIC UTILITIES HANDBOOK. CITY OF RALEIGH
PUBLIC UTILITIES DEPARTMENT PERMIT # _____

SEAL:

STRONGROCK

ENGINEERING GROUP

STRONG ROCK ENGINEERING GROUP, PLLC | COMPANY LICENSE # P-2166
305 CHURCH AT NORTH HILLS STREET, SUITE 1110 RALEIGH, NC 27609 | INFORMATION@STRONGROCKGROUP.COM

CONSTRUCTION INFRASTRUCTURE DRAWINGS
CID-24-04

01
02
03
04
05

08/01/2024
11/01/2024
02/01/2024
08/02/2025
09/02/2025

SRREG
SRREG
SRREG
SRREG
SRREG

TOWN OF ROLESVILLE CID-24-04 V2
TOWN OF ROLESVILLE CID-24-04 V3
TOWN OF ROLESVILLE CID-24-04 V4
TOWN OF ROLESVILLE CID-24-04 V5

REVISIONS

DATE

BY

STRONG ROCK PROJECT
PSP-24-03

NOT FOR
CONSTRUCTION

SCALE
AS SHOWN

DESIGNED BY
SRG

DRAWN BY
SRG


CHECKED BY
SRG

RESERVE @ MITCHELL MILL
TOWN OF ROLESVILLE, WAKE COUNTY, NORTH CAROLINA
CONSTRUCTION PLANS
PROPOSED MONKEYWRENCH
STREET - PLAN & PROFILE



DRAWING
SHEET
C-11.19

115 OF 230

THIS PLANSET AND ANY ASSOCIATED DOCUMENTS ARE PRELIMINARY AND NOT AUTHORIZED FOR CONSTRUCTION UNTIL SIGNED, DATED, AND OFFICIALLY RELEASED FOR CONSTRUCTION BY THE ENGINEER OF RECORD.

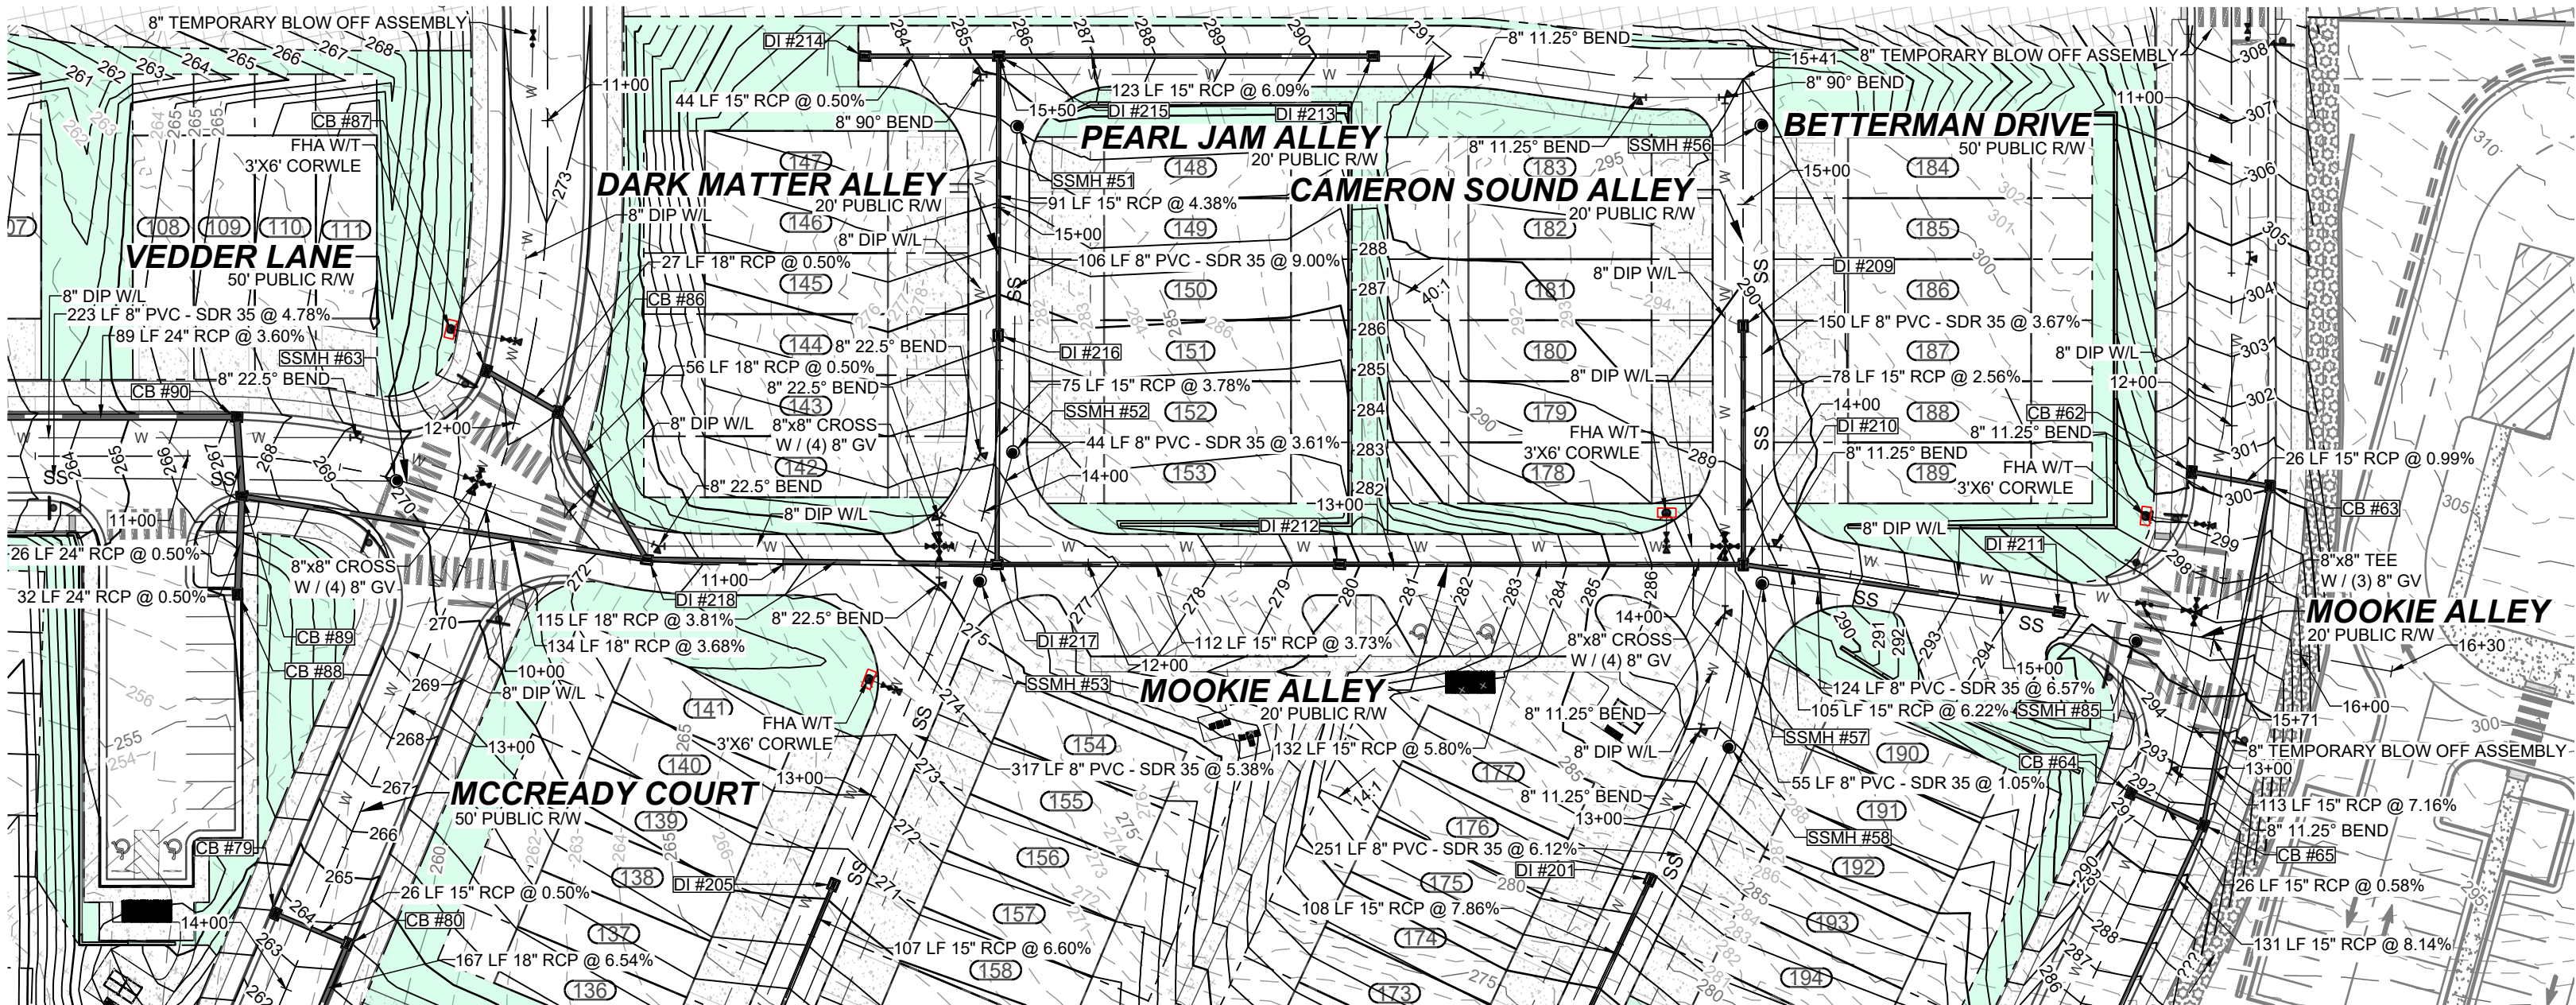

PROPOSED MOOKIE ALLEY - PLAN
HORIZONTAL: 1" = 50'

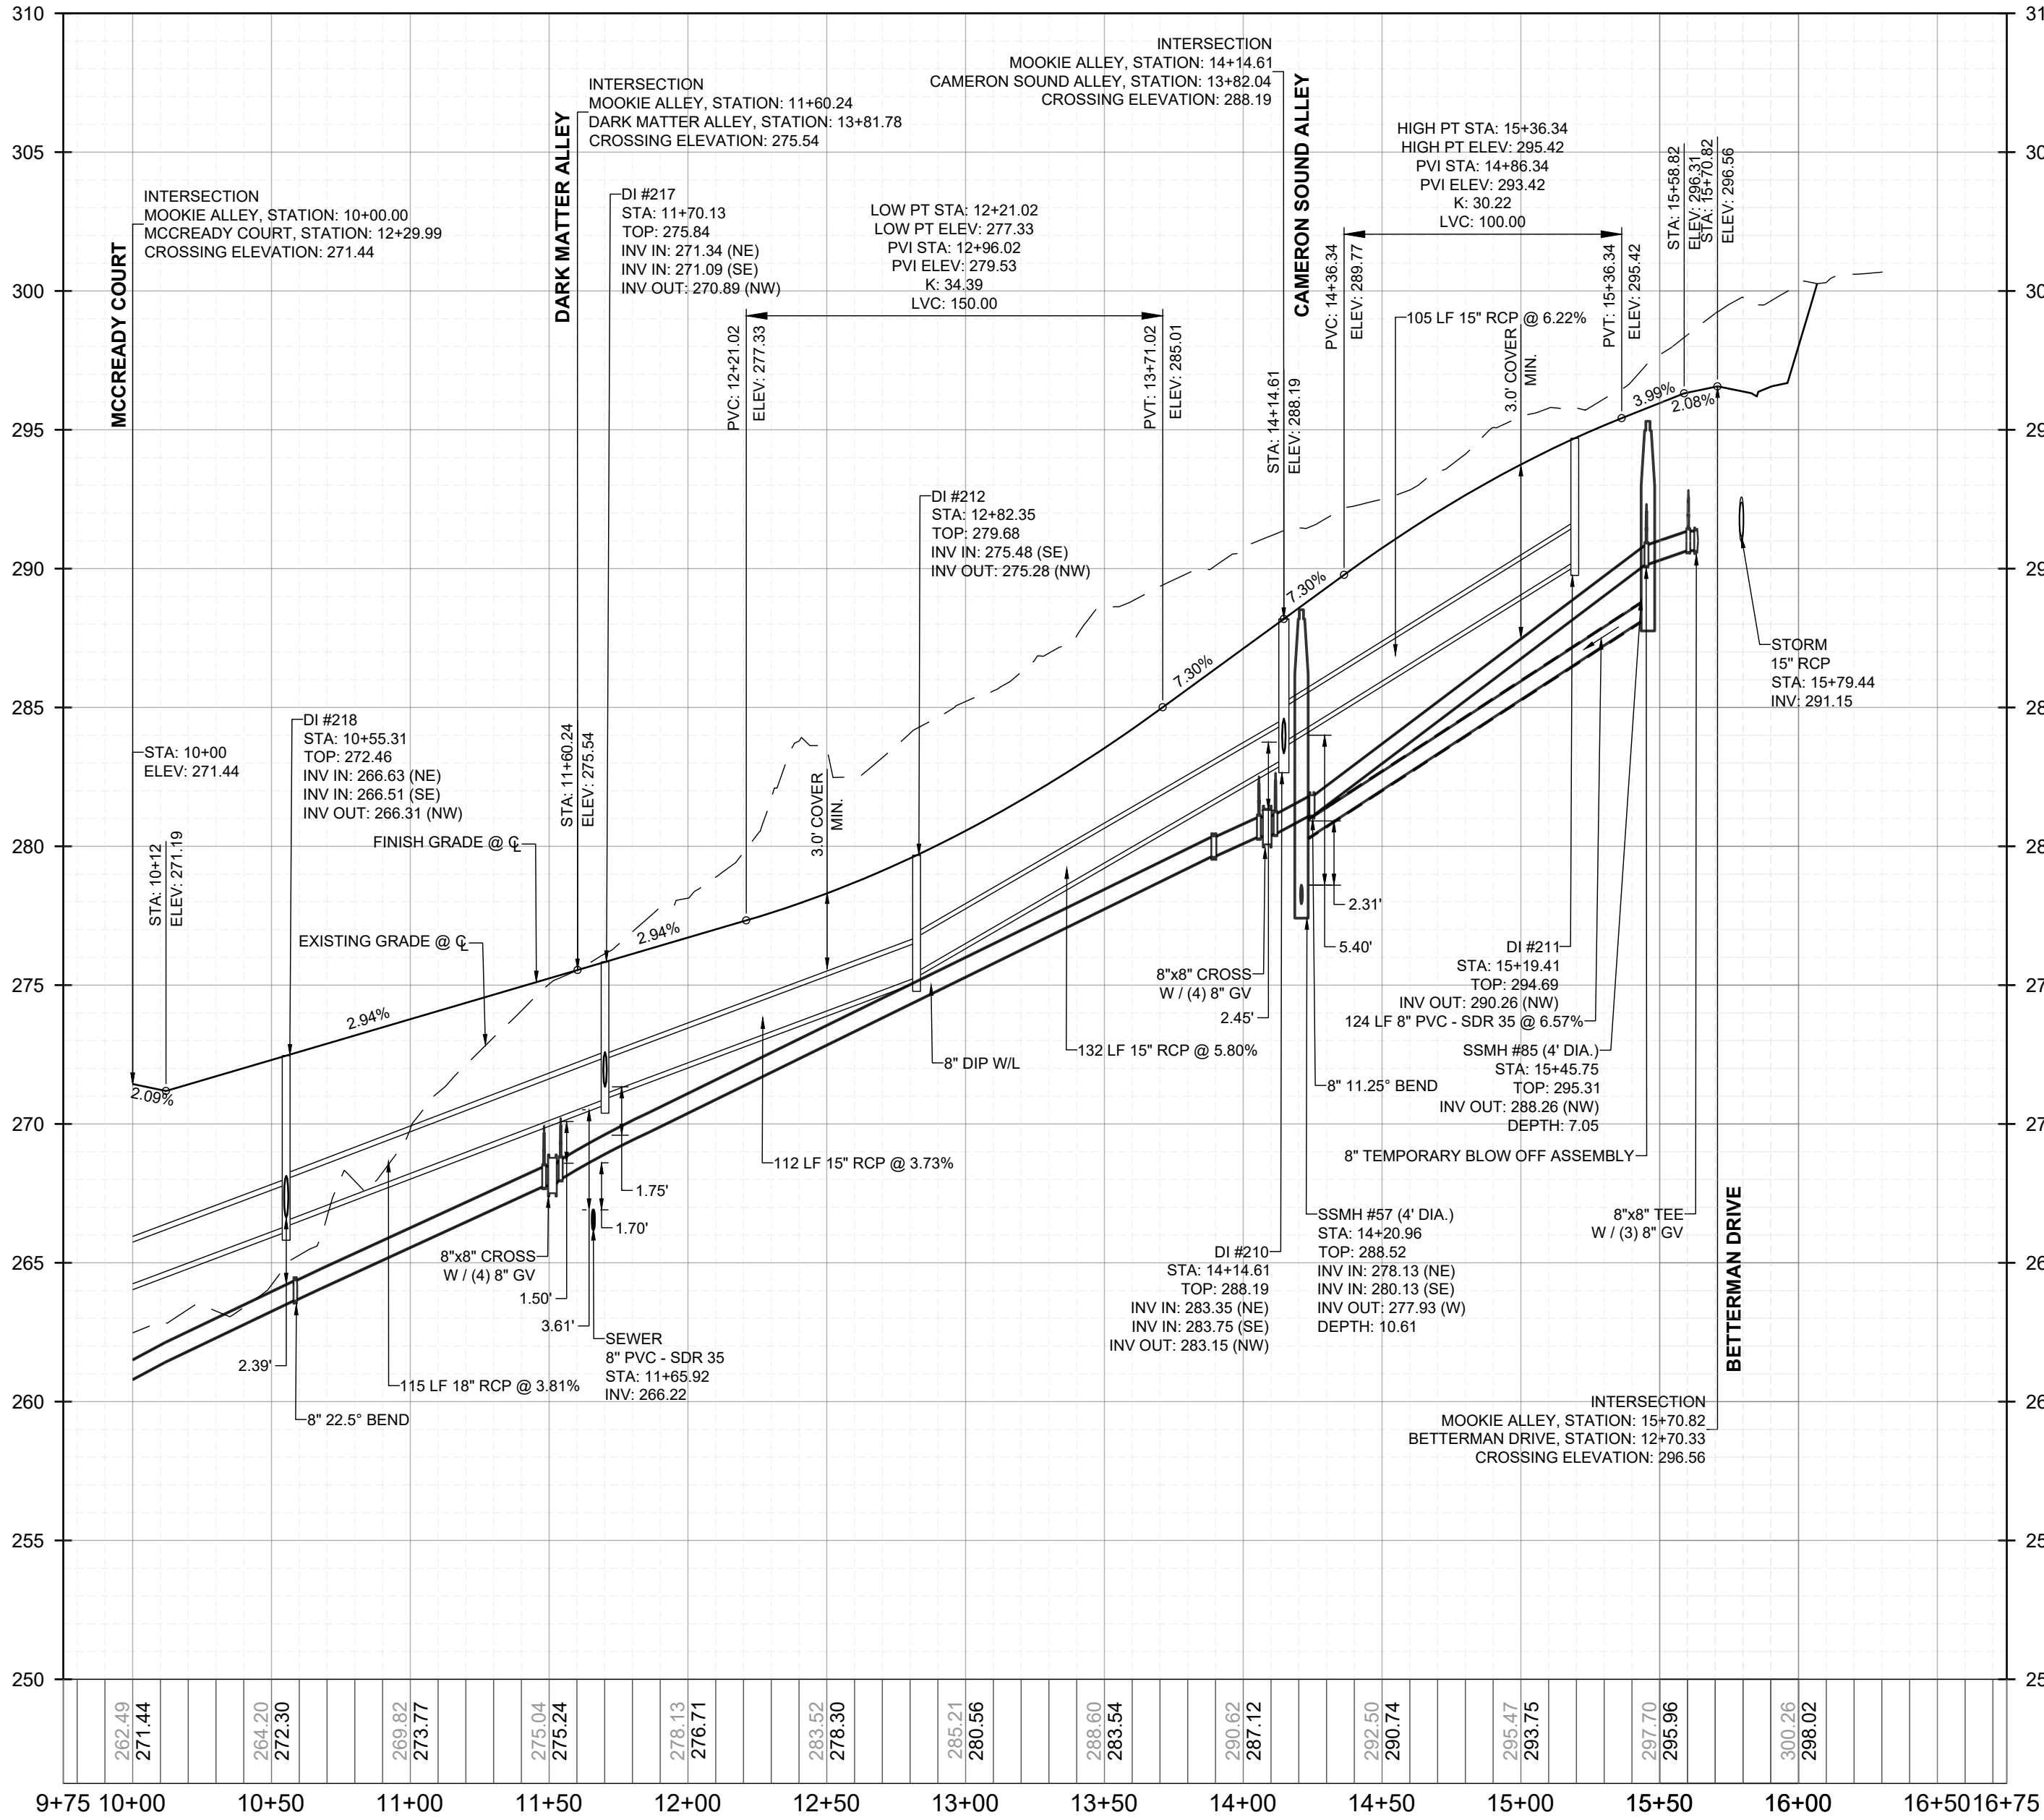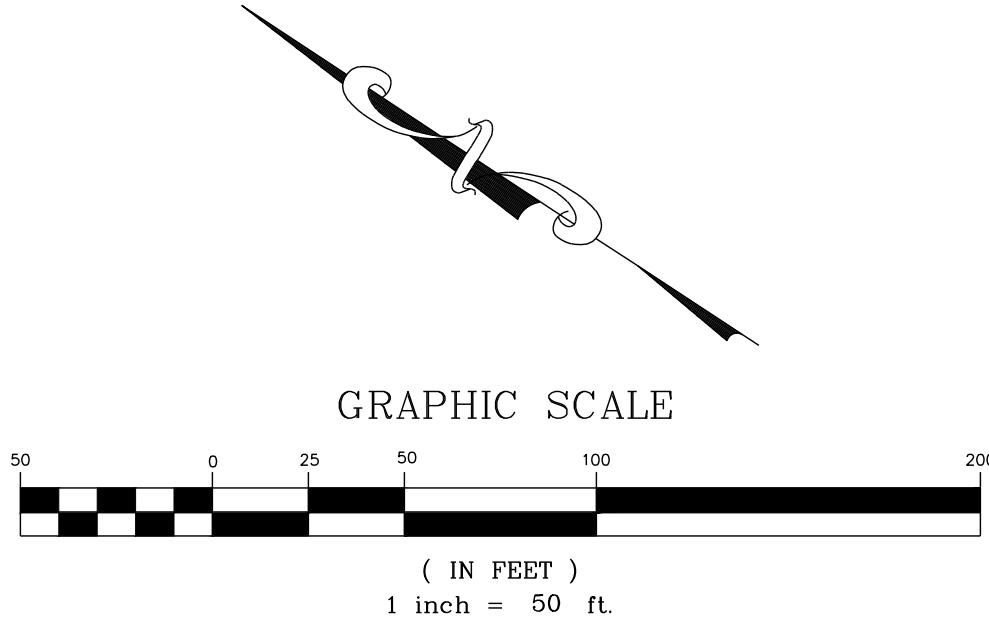

PROPOSED MOOKIE ALLEY - PROFILE
VERTICAL: 1" = 5'
HORIZONTAL: 1" = 50'

CONSTRUCTION INFRASTRUCTURE DRAWINGS					REVISIONS		DATE	BY
01	CID-24-04	08/04/2024	SREG					
02	TOWN OF ROLESVILLE CID-24-04 V2	11/07/2024	SREG					
03	TOWN OF ROLESVILLE CID-24-04 V3	02/07/2024	SREG					
04	TOWN OF ROLESVILLE CID-24-04 V4	08/02/2025	SREG					
05	TOWN OF ROLESVILLE CID-24-04 V5	09/02/2025	SREG					
					No.			

SEAL:

STRONGROCK

ENGINEERING GROUP


STRONG ROCK ENGINEERING GROUP, PLLC | COMPANY LICENSE # P-2166
305 CHURCH AT NORTH HILLS STREET, SUITE 1110 RALEIGH, NC 27609 | INFORMATION@STRONGROCKGROUP.COM

STRONG ROCK PROJECT	NOT FOR CONSTRUCTION	SCALE	AS SHOWN	DESIGNED BY	SRG	DRAWN BY	SRG	CHECKED BY	SRG
PSP-24-03									



RESERVE @ MITCHELL MILL
TOWN OF ROLESVILLE, WAKE COUNTY, NORTH CAROLINA
CONSTRUCTION PLANS
PROPOSED MOOKIE ALLEY -
PLAN & PROFILE

DRAWING
SHEET

C-11.20

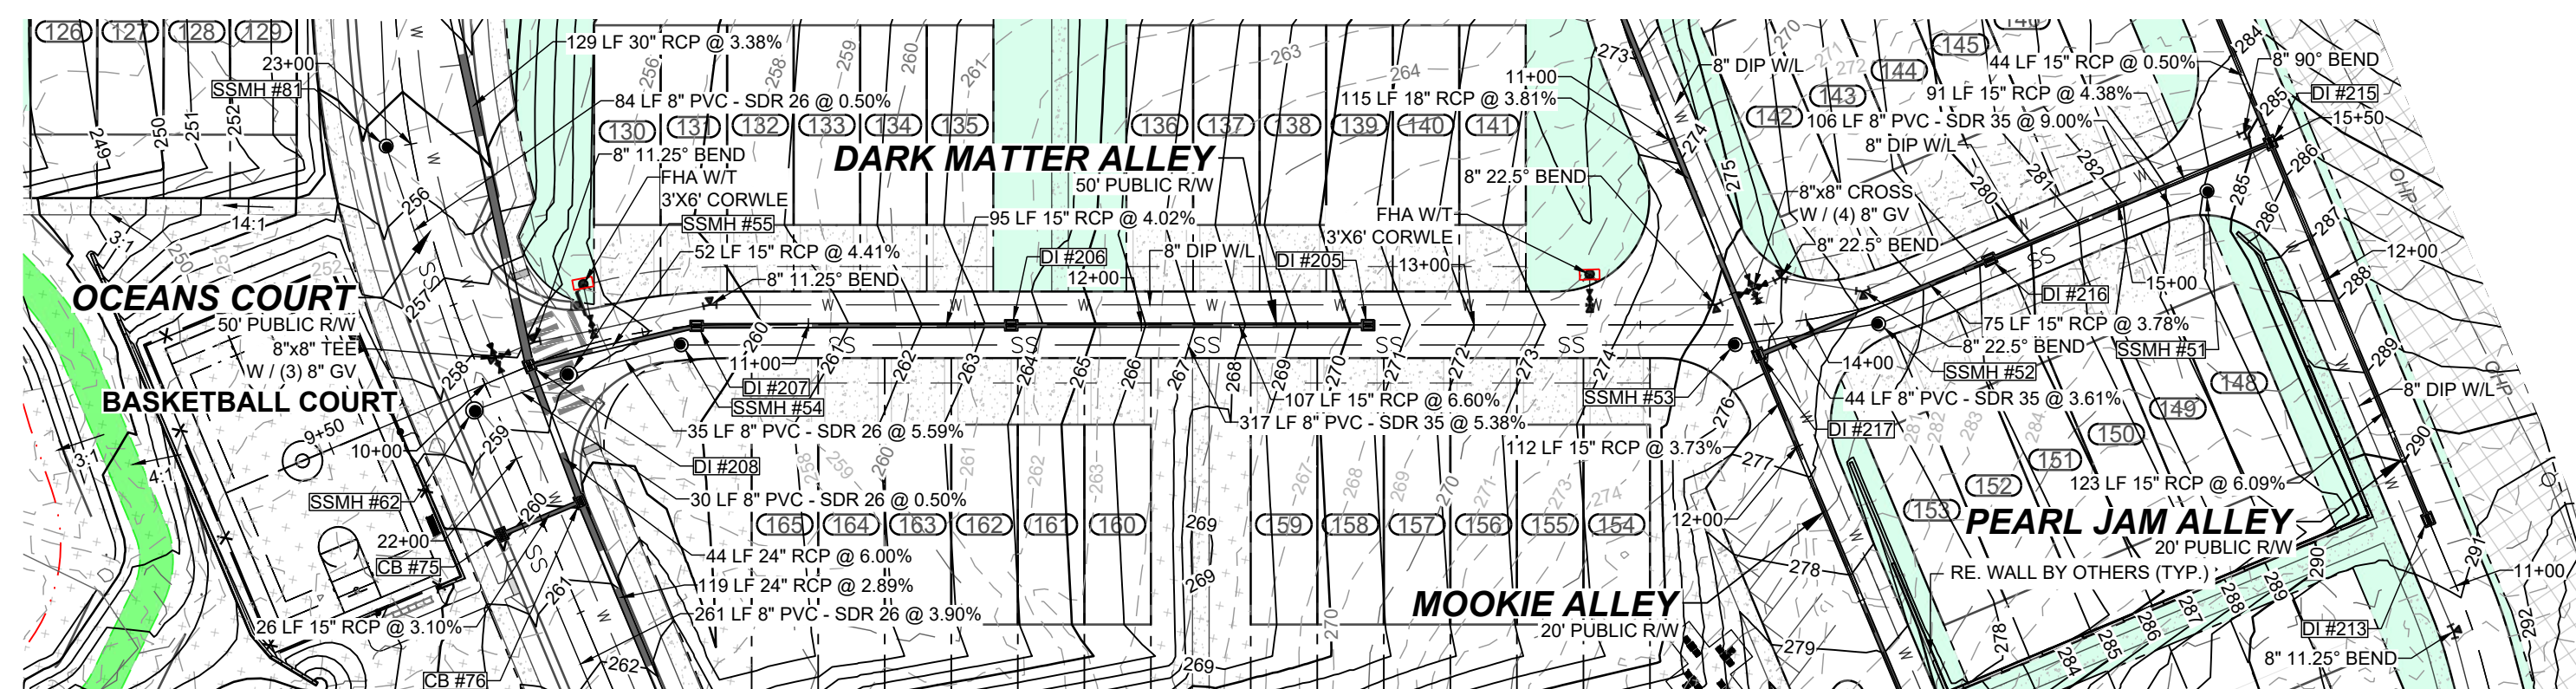

PROPOSED DARK MATTER ALLEY - PLAN
HORIZONTAL: 1" = 50'

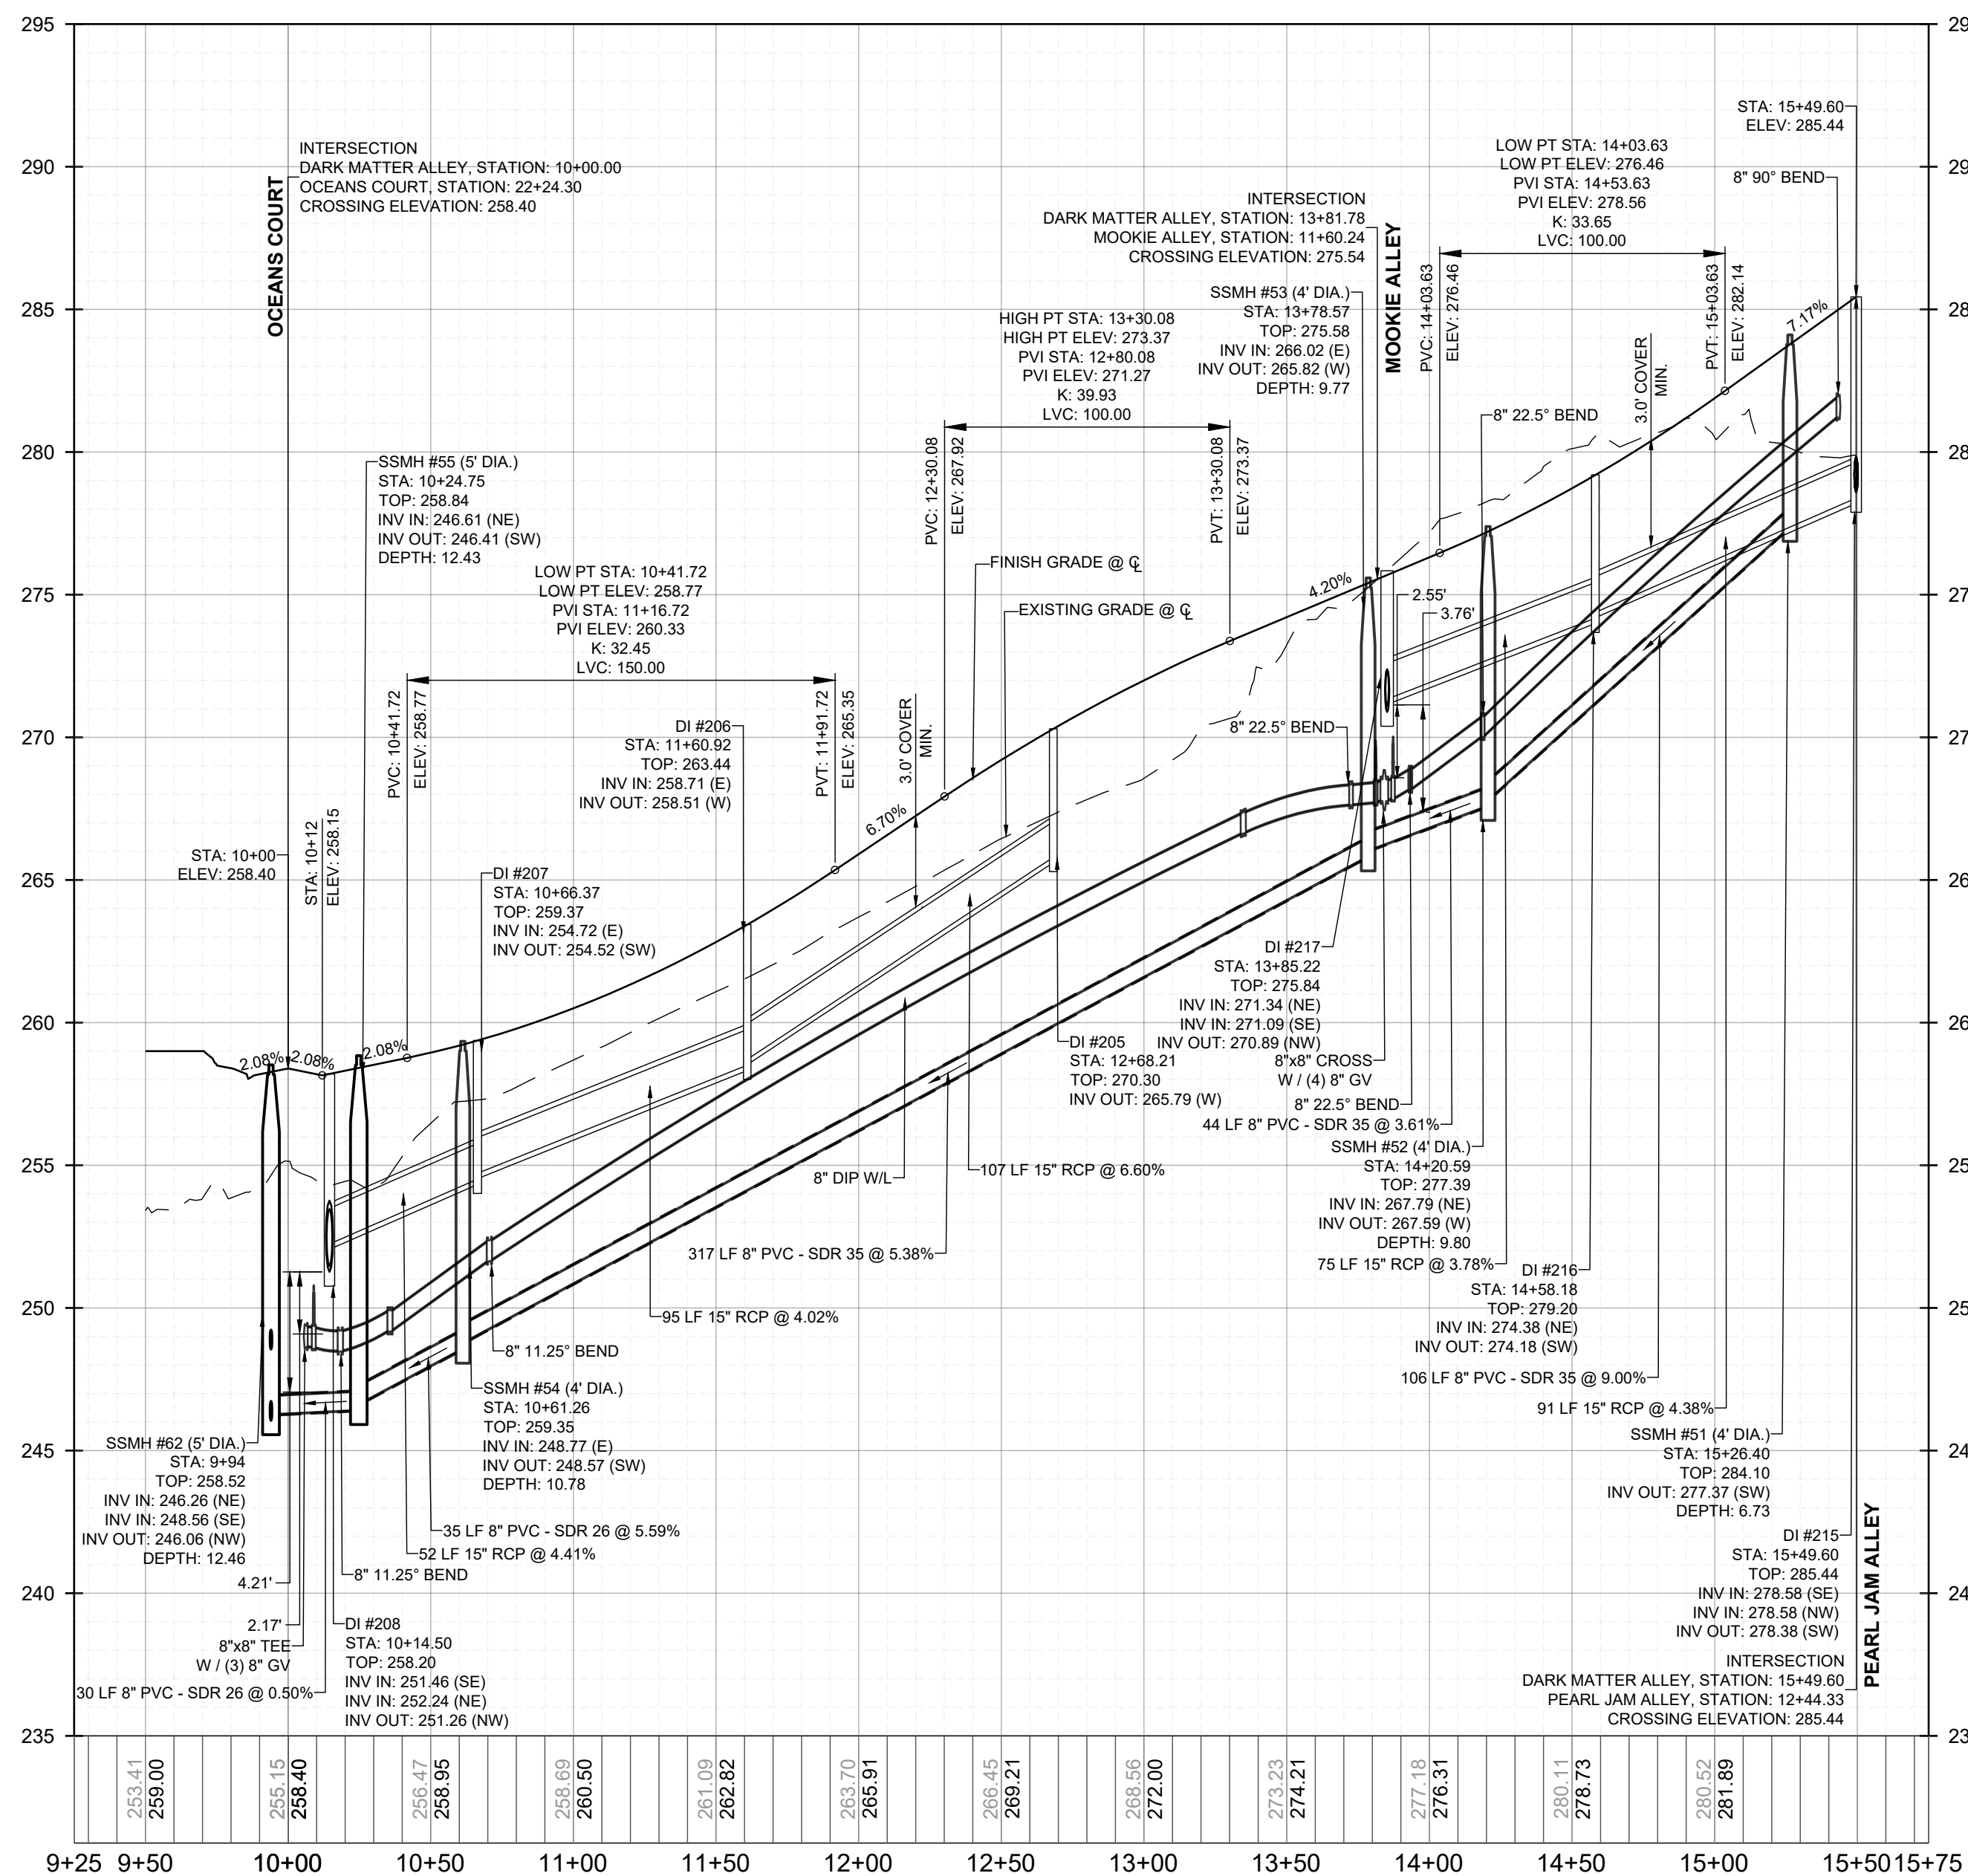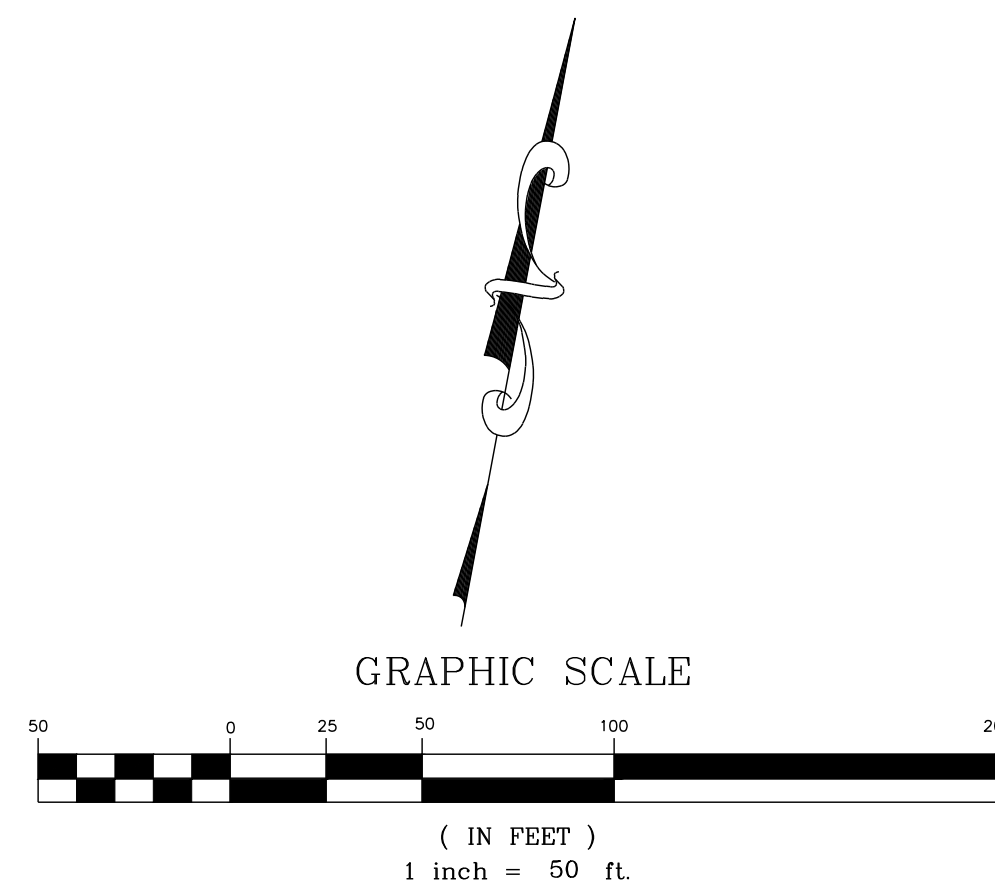

PROPOSED DARK MATTER ALLEY - PROFILE
VERTICAL: 1" = 5'
HORIZONTAL: 1" = 50'

PUBLIC
WATER DISTRIBUTION / EXTENSION SYSTEM

THE CITY OF RALEIGH CONSENTS TO THE CONNECTION AND EXTENSION OF THE CITY'S PUBLIC WATER SYSTEM AS SHOWN ON THIS PLAN. THE MATERIAL AND CONSTRUCTION METHODS USED FOR THIS PROJECT SHALL CONFORM TO THE STANDARDS AND SPECIFICATIONS OF THE CITY'S PUBLIC UTILITIES HANDBOOK. CITY OF RALEIGH

PUBLIC UTILITIES DEPARTMENT PERMIT # _____

PUBLIC
SEWER COLLECTION / EXTENSION SYSTEM

THE CITY OF RALEIGH CONSENTS TO THE CONNECTION AND EXTENSION OF THE CITY'S PUBLIC SEWER SYSTEM AS SHOWN ON THIS PLAN. THE MATERIAL AND CONSTRUCTION METHODS USED FOR THIS PROJECT SHALL CONFORM TO THE STANDARDS AND SPECIFICATIONS OF THE CITY'S PUBLIC UTILITIES HANDBOOK. CITY OF RALEIGH

PUBLIC UTILITIES DEPARTMENT PERMIT # _____

No.	REVISIONS	DATE	BY
01	CONSTRUCTION INFRASTRUCTURE DRAWINGS CID-24-04	06/04/2024	SREG
02	TOWN OF ROLESVILLE CID-24-04 V2	11/01/2024	SREG
03	TOWN OF ROLESVILLE CID-24-04 V3	02/01/2024	SREG
04	TOWN OF ROLESVILLE CID-24-04 V4	08/02/2025	SREG
05	TOWN OF ROLESVILLE CID-24-04 V5	09/02/2025	SREG

SEAL:

STRONGROCK
ENGINEERING GROUP
STRONG ROCK ENGINEERING GROUP, PLLC | COMPANY LICENSE # P-2166

STRONG ROCK PROJECT	PSP-23-03
NOT FOR CONSTRUCTION	
SCALE	AS SHOWN
DESIGNED BY	SRG
DRAWN BY	SRG
CHECKED BY	SRG


RESERVE @ MITCHELL MILL
TOWN OF ROLESVILLE, WAKE COUNTY, NORTH CAROLINA
CONSTRUCTION PLANS
PROPOSED DARK MATTER ALLEY
- PLAN & PROFILE

DRAWING SHEET


C-11.21

117 OF 230


THIS PLANSET AND ANY ASSOCIATED DOCUMENTS ARE PRELIMINARY AND NOT AUTHORIZED FOR CONSTRUCTION UNTIL SIGNED, DATED, AND OFFICIALLY RELEASED FOR CONSTRUCTION BY THE ENGINEER OF RECORD.

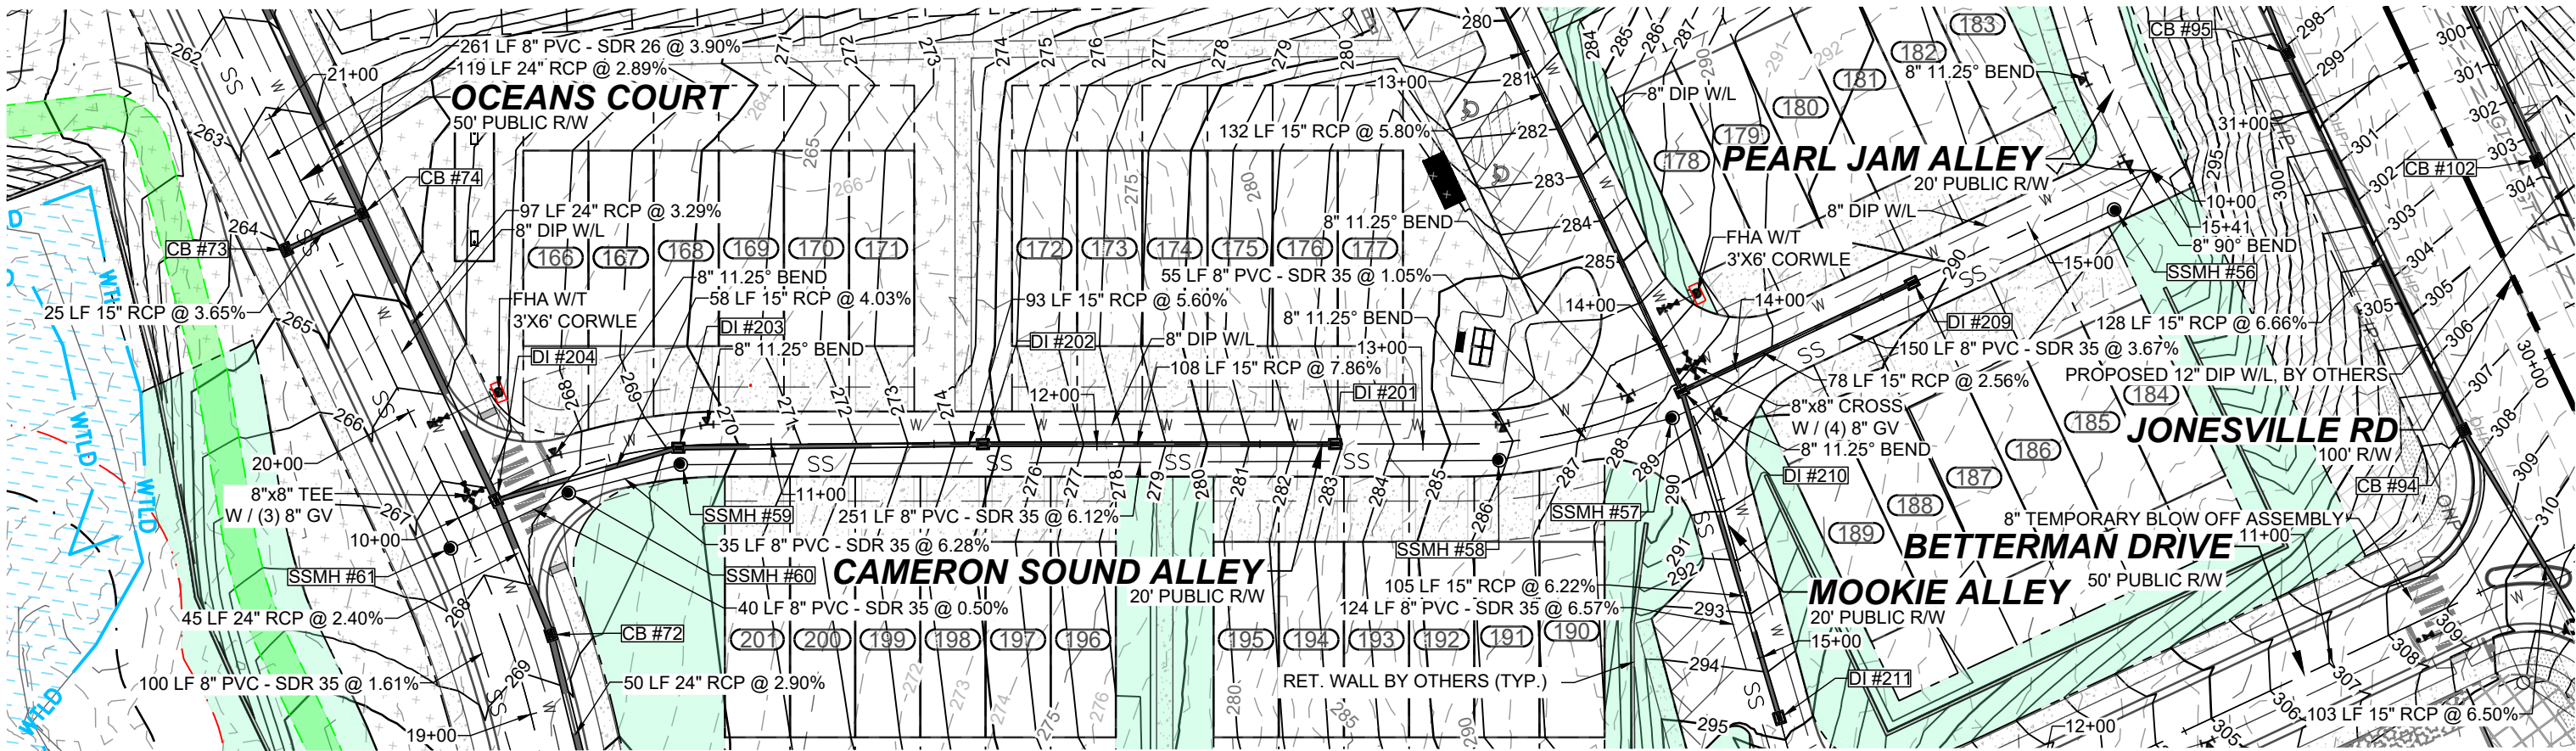

PROPOSED CAMERON SOUND ALLEY - PLAN
HORIZONTAL: 1" = 50'

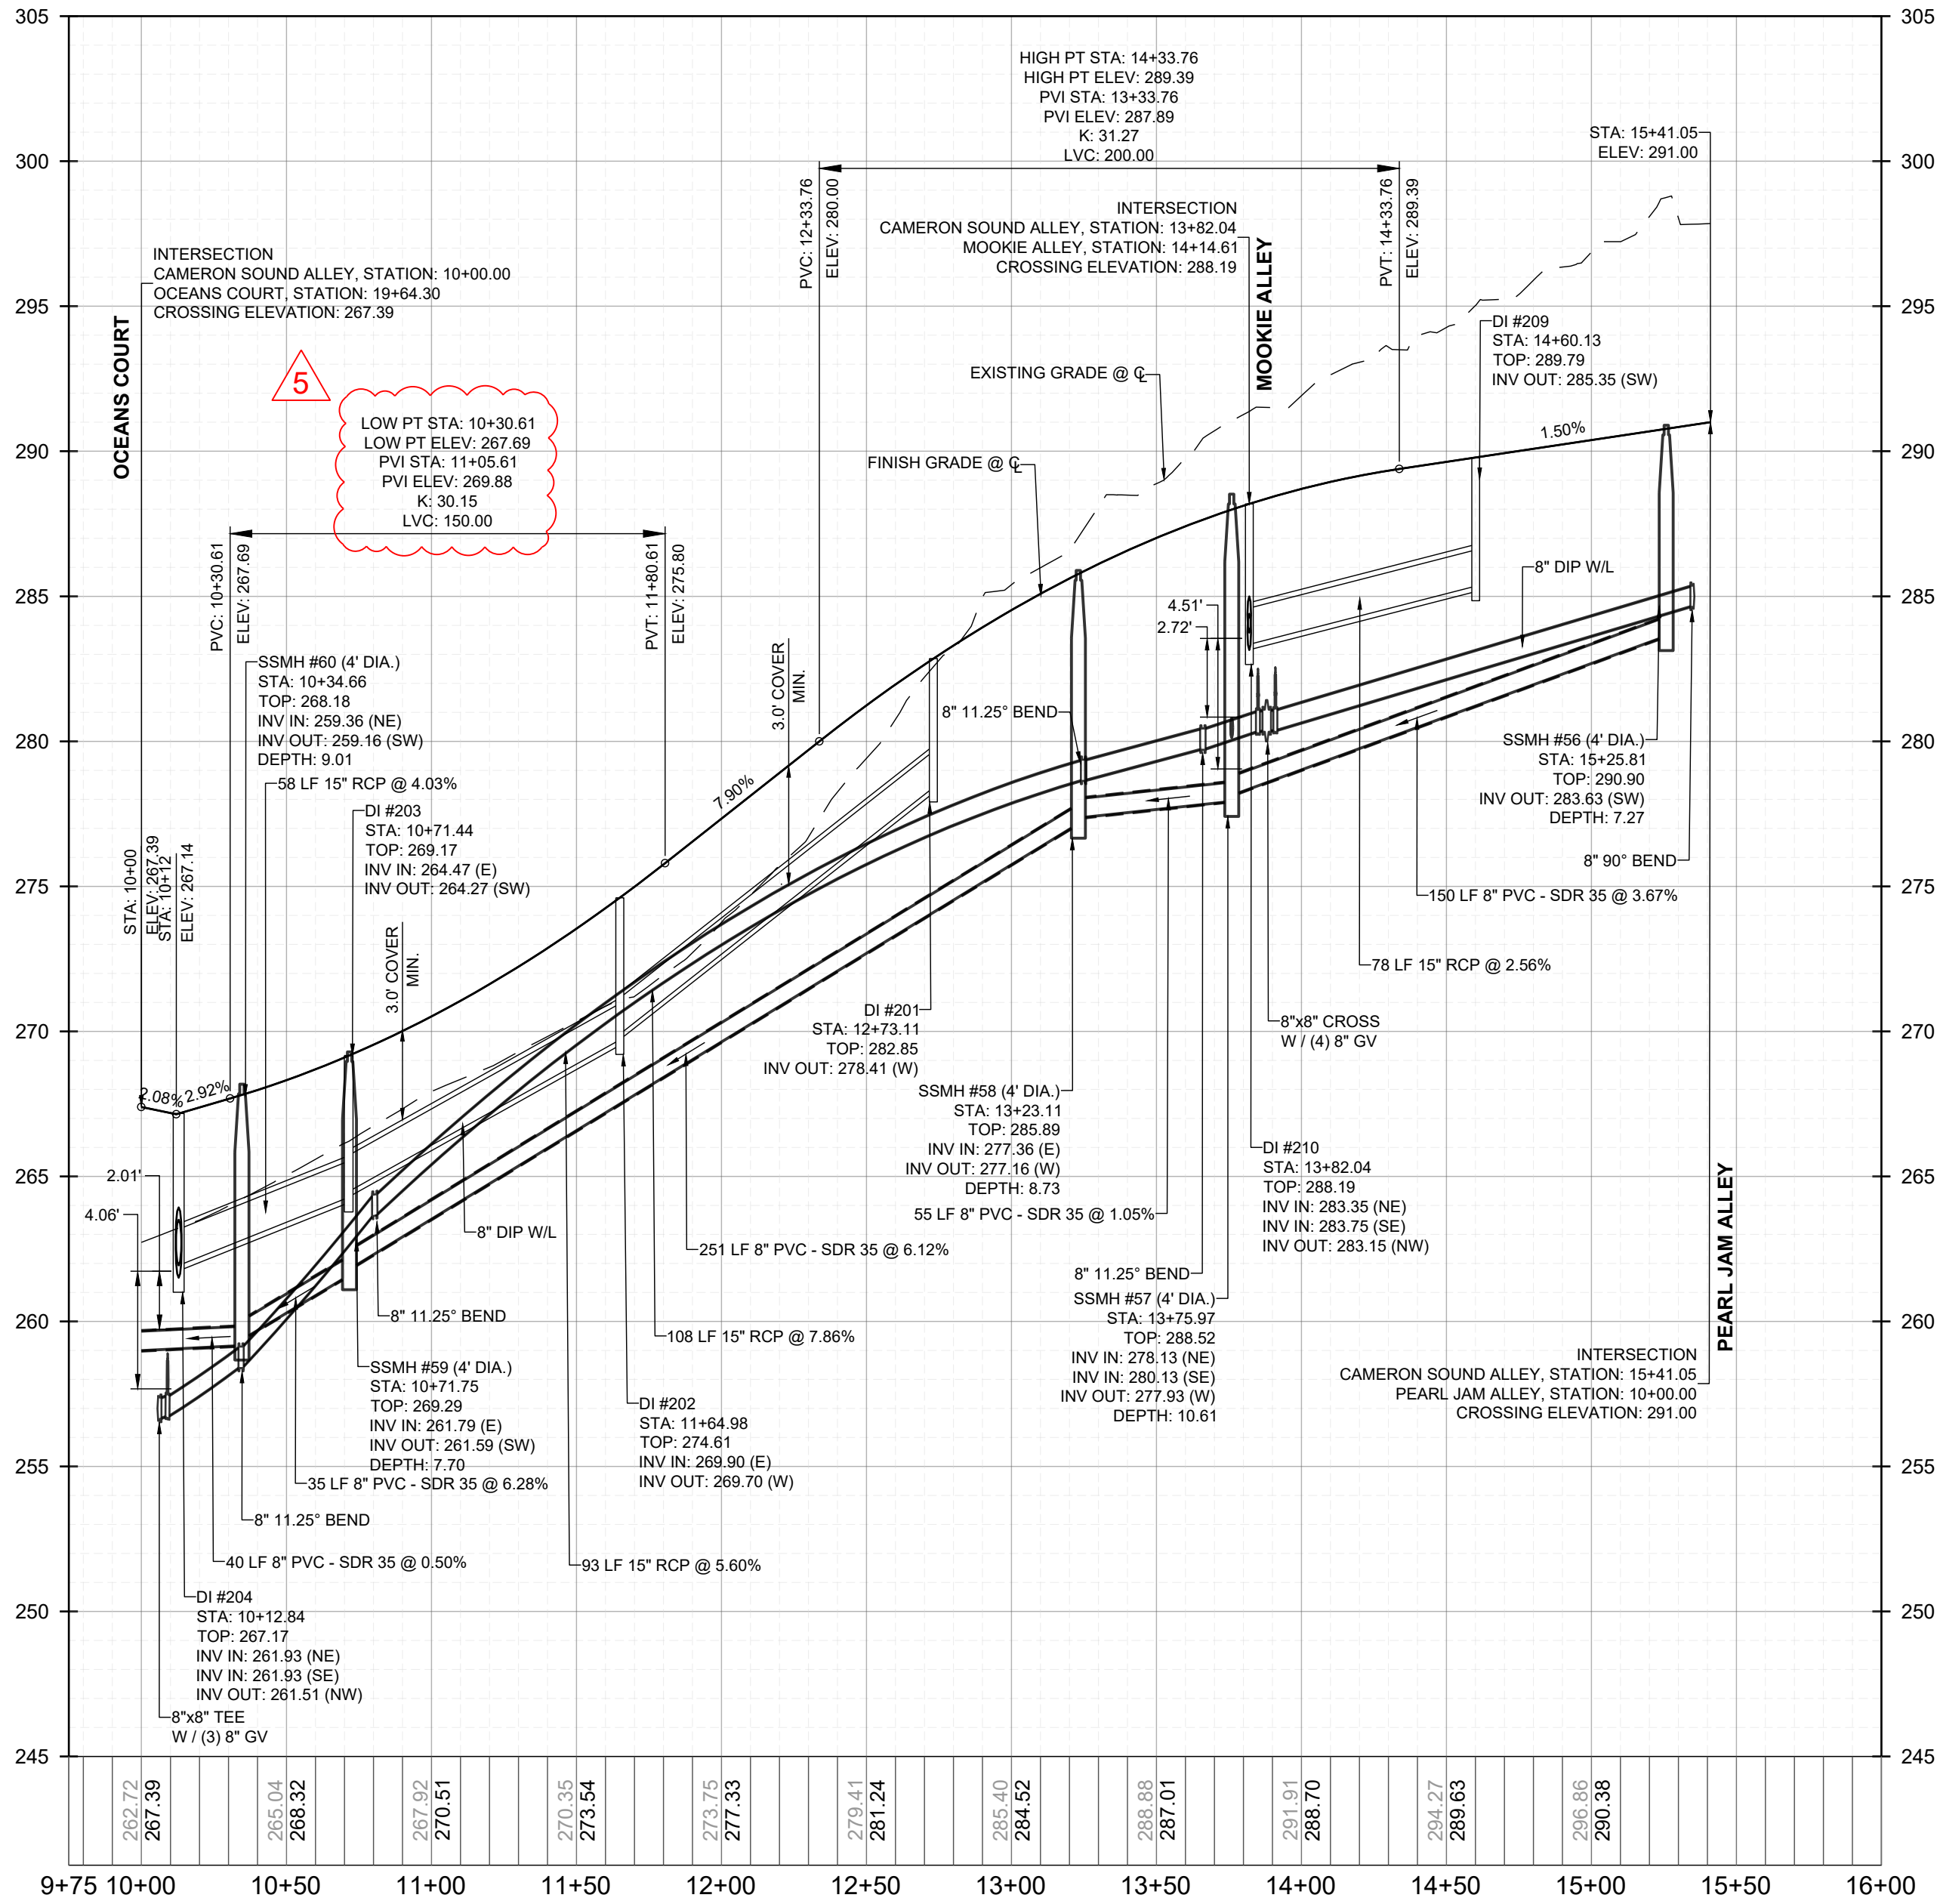

PROPOSED CAMERON SOUND ALLEY - PROFILE
VERTICAL: 1" = 5'
HORIZONTAL: 1" = 50'

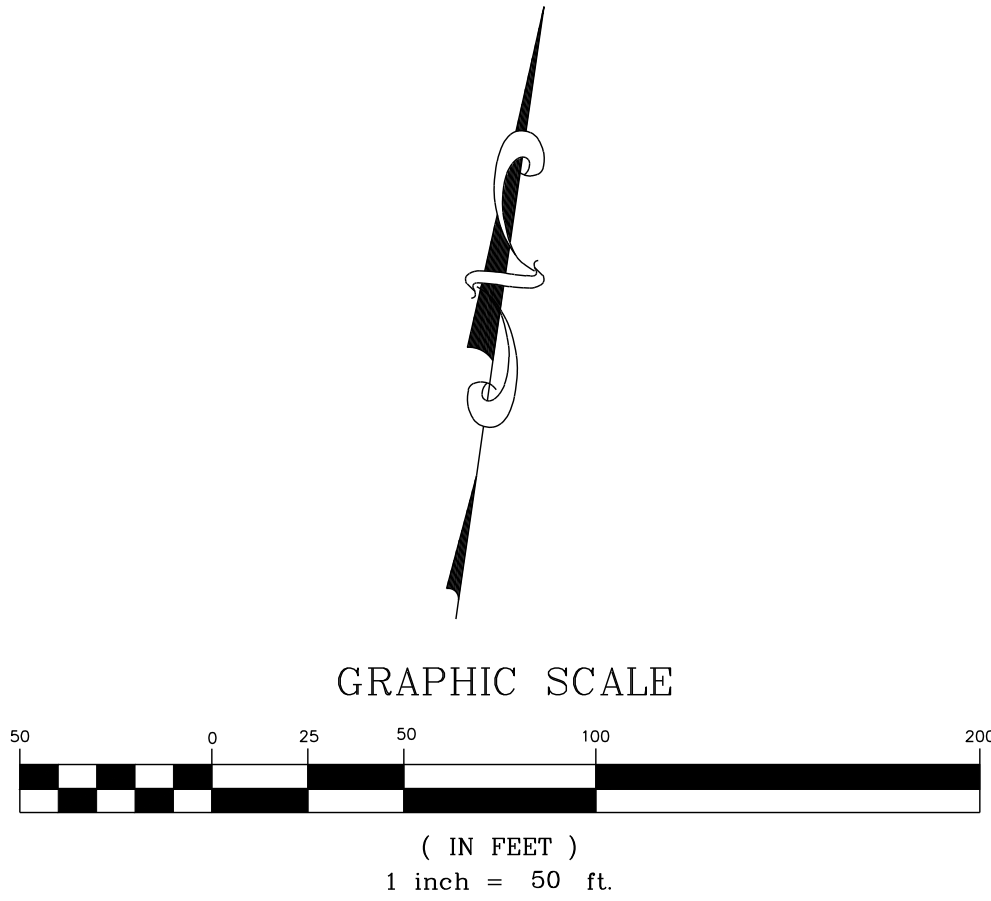

PUBLIC
WATER DISTRIBUTION / EXTENSION SYSTEM
THE CITY OF RALEIGH CONSENTS TO THE CONNECTION AND EXTENSION OF THE CITY'S PUBLIC WATER SYSTEM AS SHOWN ON THIS PLAN. THE MATERIAL AND CONSTRUCTION METHODS USED FOR THIS PROJECT SHALL CONFORM TO THE STANDARDS AND SPECIFICATIONS OF THE CITY'S PUBLIC UTILITIES HANDBOOK. CITY OF RALEIGH
PUBLIC UTILITIES DEPARTMENT PERMIT # _____

PUBLIC
SEWER COLLECTION / EXTENSION SYSTEM
THE CITY OF RALEIGH CONSENTS TO THE CONNECTION AND EXTENSION OF THE CITY'S PUBLIC SEWER SYSTEM AS SHOWN ON THIS PLAN. THE MATERIAL AND CONSTRUCTION METHODS USED FOR THIS PROJECT SHALL CONFORM TO THE STANDARDS AND SPECIFICATIONS OF THE CITY'S PUBLIC UTILITIES HANDBOOK. CITY OF RALEIGH
PUBLIC UTILITIES DEPARTMENT PERMIT # _____

CONSTRUCTION INFRASTRUCTURE DRAWINGS		DRAWING		DATE	
01	CID-24-04	08/04/2024	SRG		BY
02	TOWN OF ROLESVILLE CID-24-04 V2	11/07/2024	SRG		
03	TOWN OF ROLESVILLE CID-24-04 V3	02/07/2024	SRG		
04	TOWN OF ROLESVILLE CID-24-04 V4	08/02/2025	SRG		
05	TOWN OF ROLESVILLE CID-24-04 V5	09/02/2025	SRG		
No.		REVISIONS		DATE	

SEAL:

STRONGROCK

ENGINEERING GROUP



STRONG ROCK ENGINEERING GROUP, PLLC | COMPANY LICENSE # P-2166
305 CHURCH AT NORTH HILLS STREET, SUITE 1110 RALEIGH, NC 27609 | INFORMATION@STRONGROCKGROUP.COM

STRONG ROCK PROJECT PSP-24-03	NOT FOR CONSTRUCTION	SCALE AS SHOWN	DESIGNED BY SRG	DRAWN BY SRG	CHECKED BY SRG
----------------------------------	-------------------------	-------------------	--------------------	-----------------	-------------------

RESERVE @ MITCHELL MILL
TOWN OF ROLESVILLE, WAKE COUNTY, NORTH CAROLINA
CONSTRUCTION PLANS
PROPOSED CAMERON SOUND ALLEY
- PLAN & PROFILE

DRAWING
SHEET


C-11.22

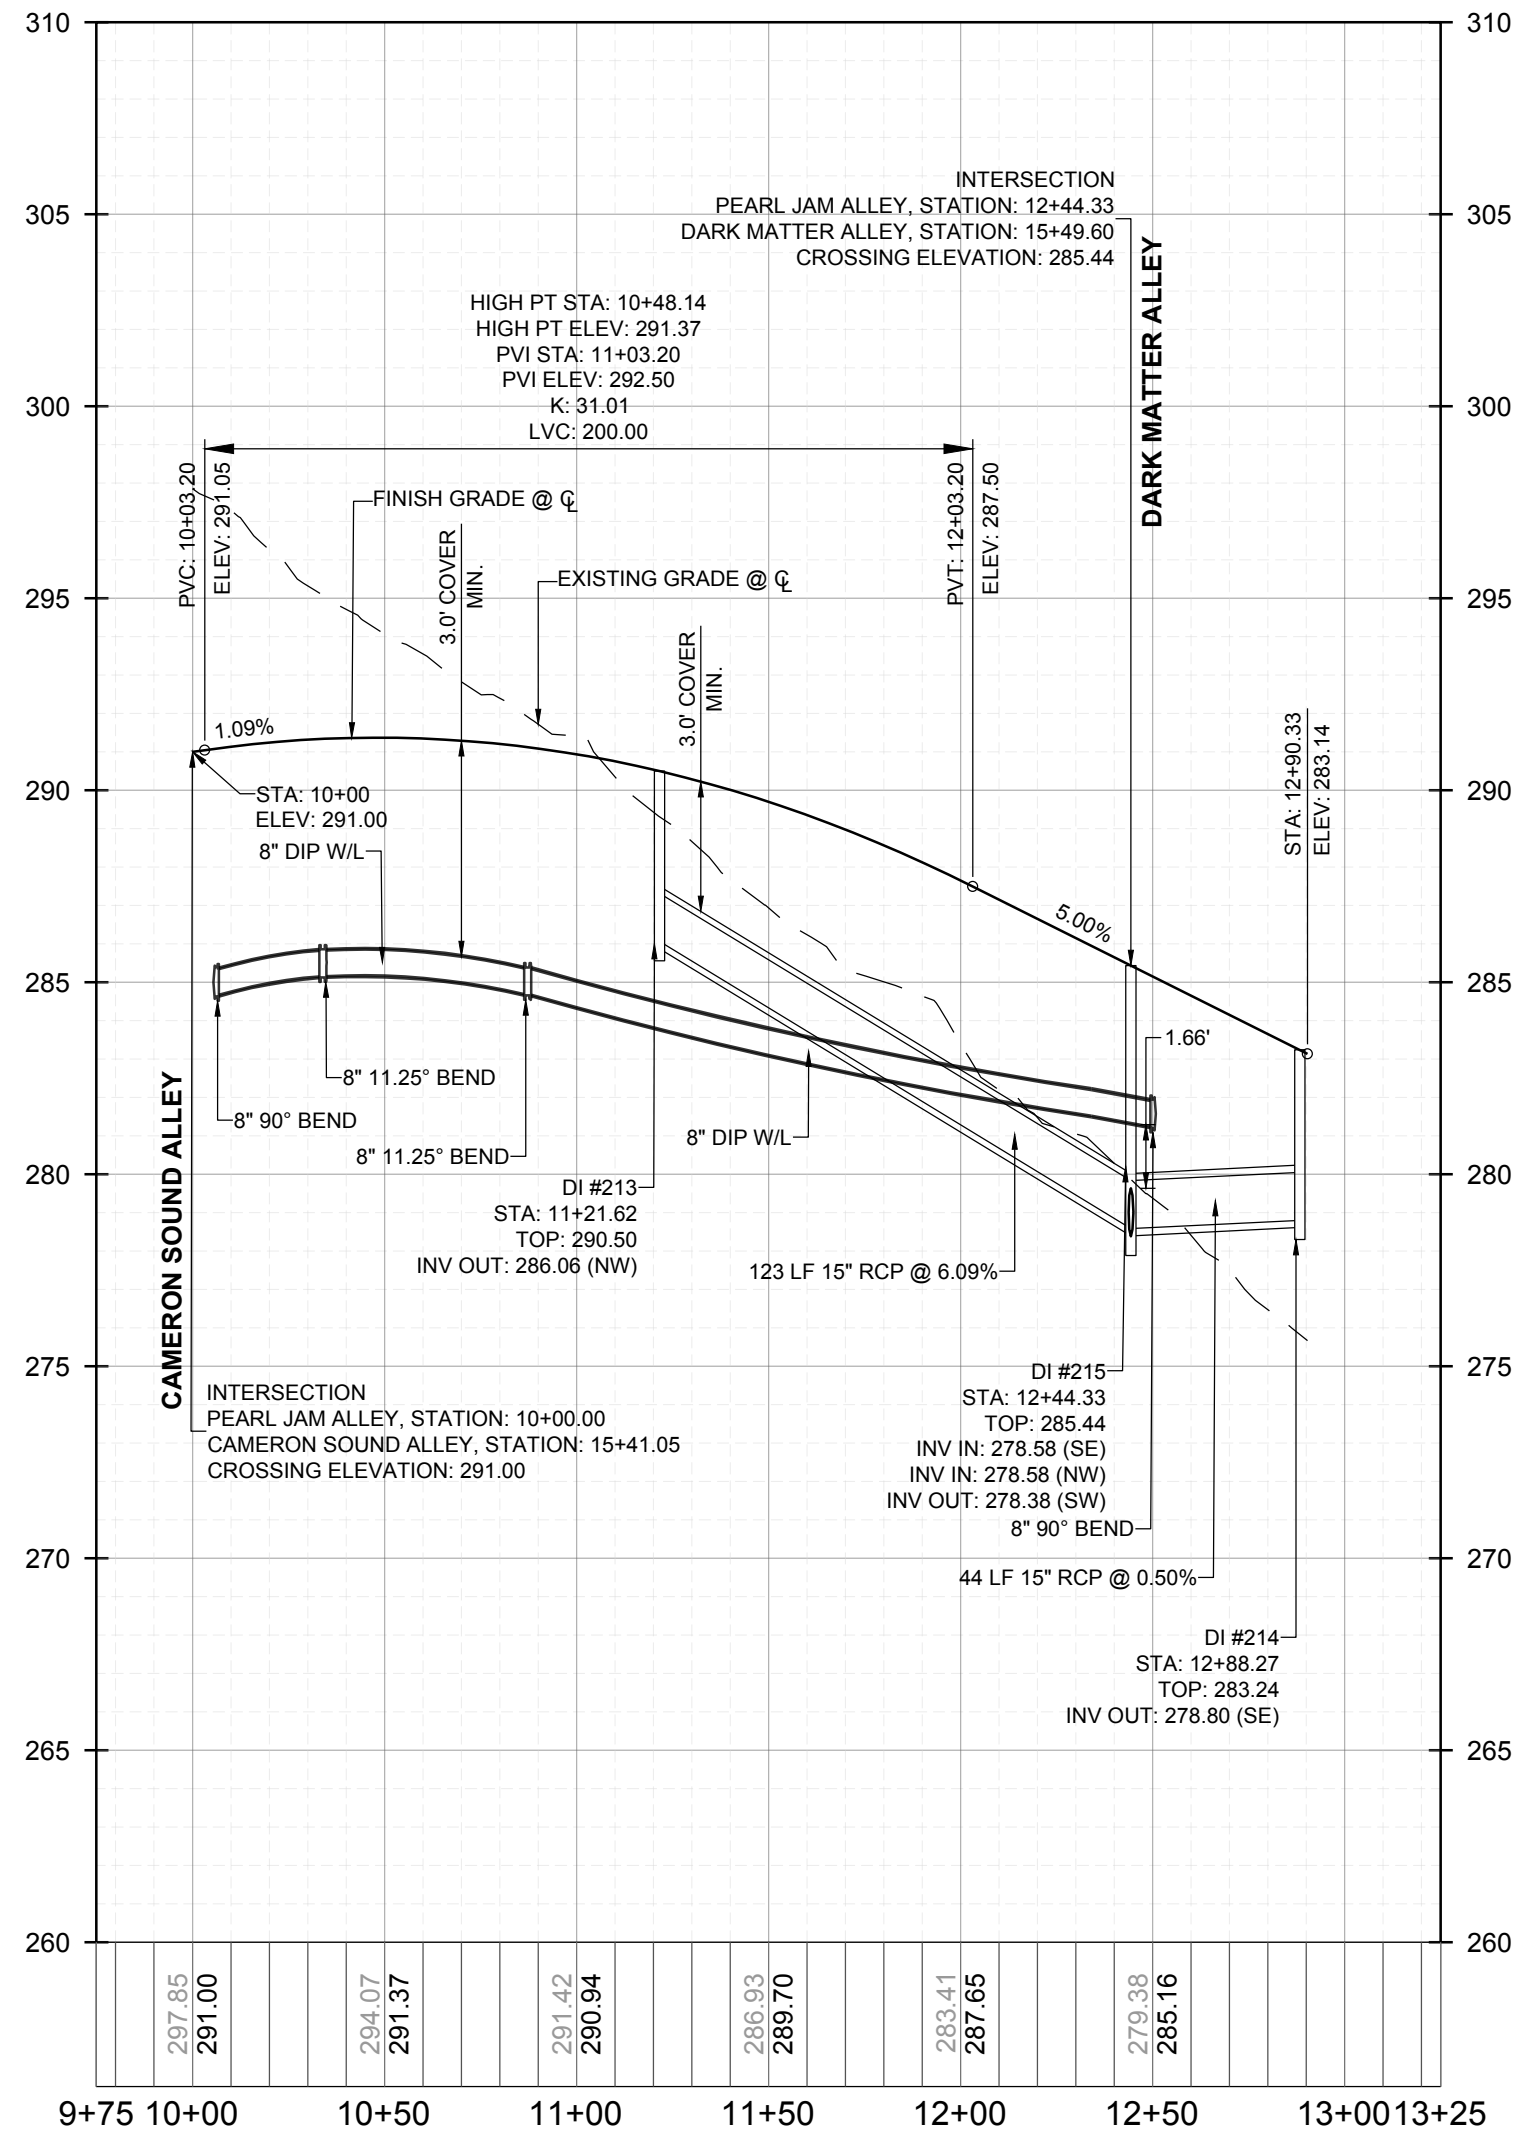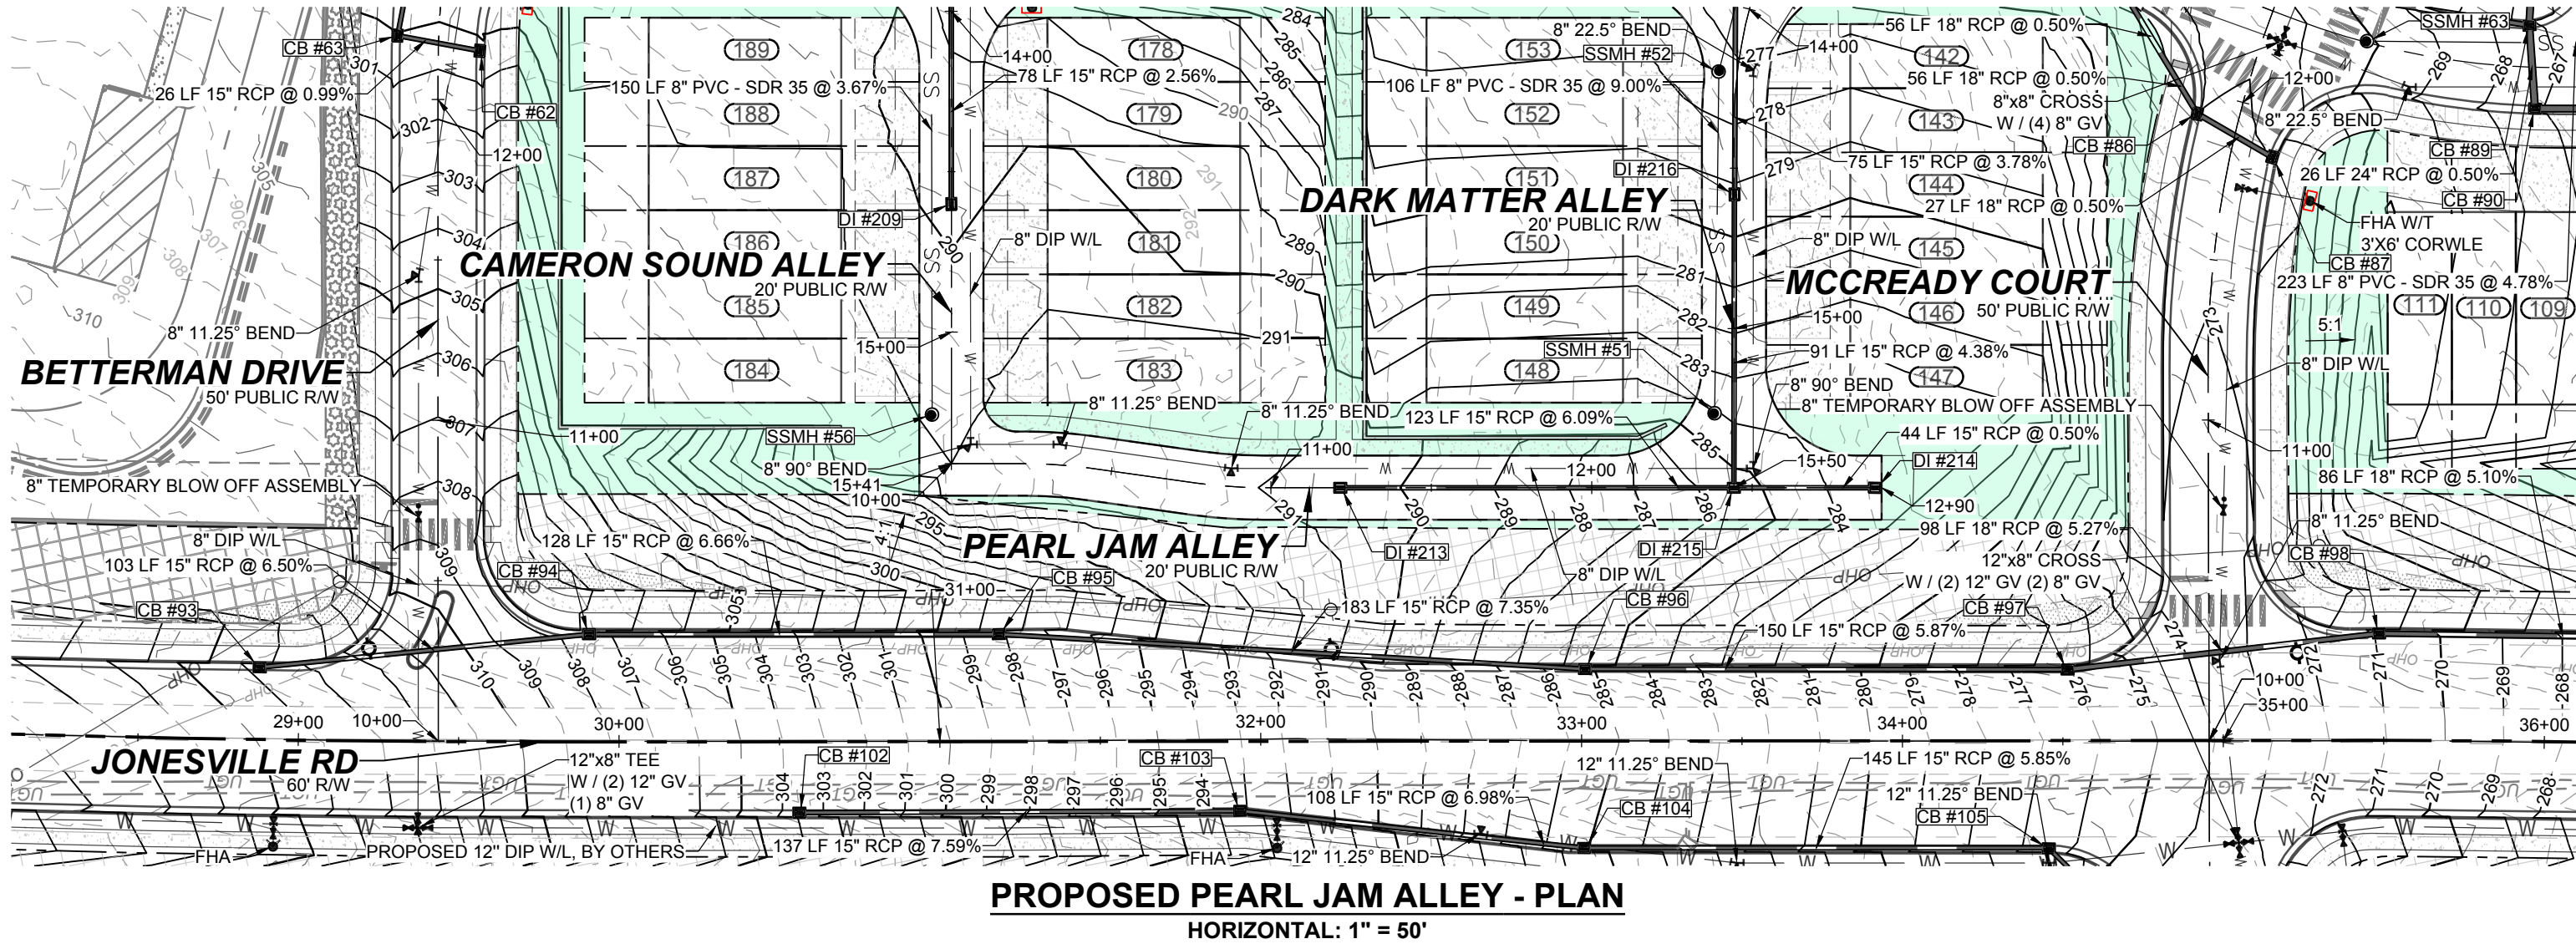



PUBLIC
WATER DISTRIBUTION / EXTENSION SYSTEM
THE CITY OF RALEIGH CONSENTS TO THE CONNECTION AND EXTENSION OF THE CITY'S PUBLIC WATER SYSTEM AS SHOWN ON THIS PLAN. THE MATERIAL AND CONSTRUCTION METHODS USED FOR THIS PROJECT SHALL CONFORM TO THE STANDARDS AND SPECIFICATIONS OF THE CITY'S PUBLIC UTILITIES HANDBOOK. CITY OF RALEIGH
PUBLIC UTILITIES DEPARTMENT PERMIT # _____

PUBLIC
SEWER COLLECTION / EXTENSION SYSTEM
THE CITY OF RALEIGH CONSENTS TO THE CONNECTION AND EXTENSION OF THE CITY'S PUBLIC SEWER SYSTEM AS SHOWN ON THIS PLAN. THE MATERIAL AND CONSTRUCTION METHODS USED FOR THIS PROJECT SHALL CONFORM TO THE STANDARDS AND SPECIFICATIONS OF THE CITY'S PUBLIC UTILITIES HANDBOOK. CITY OF RALEIGH
PUBLIC UTILITIES DEPARTMENT PERMIT # _____

STRONG ROCK ENGINEERING GROUP 305 CHURCH AT NORTH HILLS STREET, SUITE 1110 RALEIGH, NC 27609 INFORMATION@STRONGROCKGROUP.COM	STRONG ROCK PROJECT PSP-24-03	NOT FOR CONSTRUCTION	SCALE AS SHOWN	DESIGNED BY SRG	DRAWN BY SRG	CHECKED BY SRG	RESERVE @ MITCHELL MILL TOWN OF ROLESVILLE, WAKE COUNTY, NORTH CAROLINA CONSTRUCTION PLANS PROPOSED PEARL JAM ALLEY - PLAN & PROFILE	DRAWING SHEET C-11.23	119 OF 230
	CONSTRUCTION INFRASTRUCTURE DRAWINGS CID-24-04 01 TOWN OF ROLESVILLE CID-24-04 V2 02 TOWN OF ROLESVILLE CID-24-04 V3 03 TOWN OF ROLESVILLE CID-24-04 V4 04 TOWN OF ROLESVILLE CID-24-04 V5							REVISIONS	
	No.							DATE	
	BY								

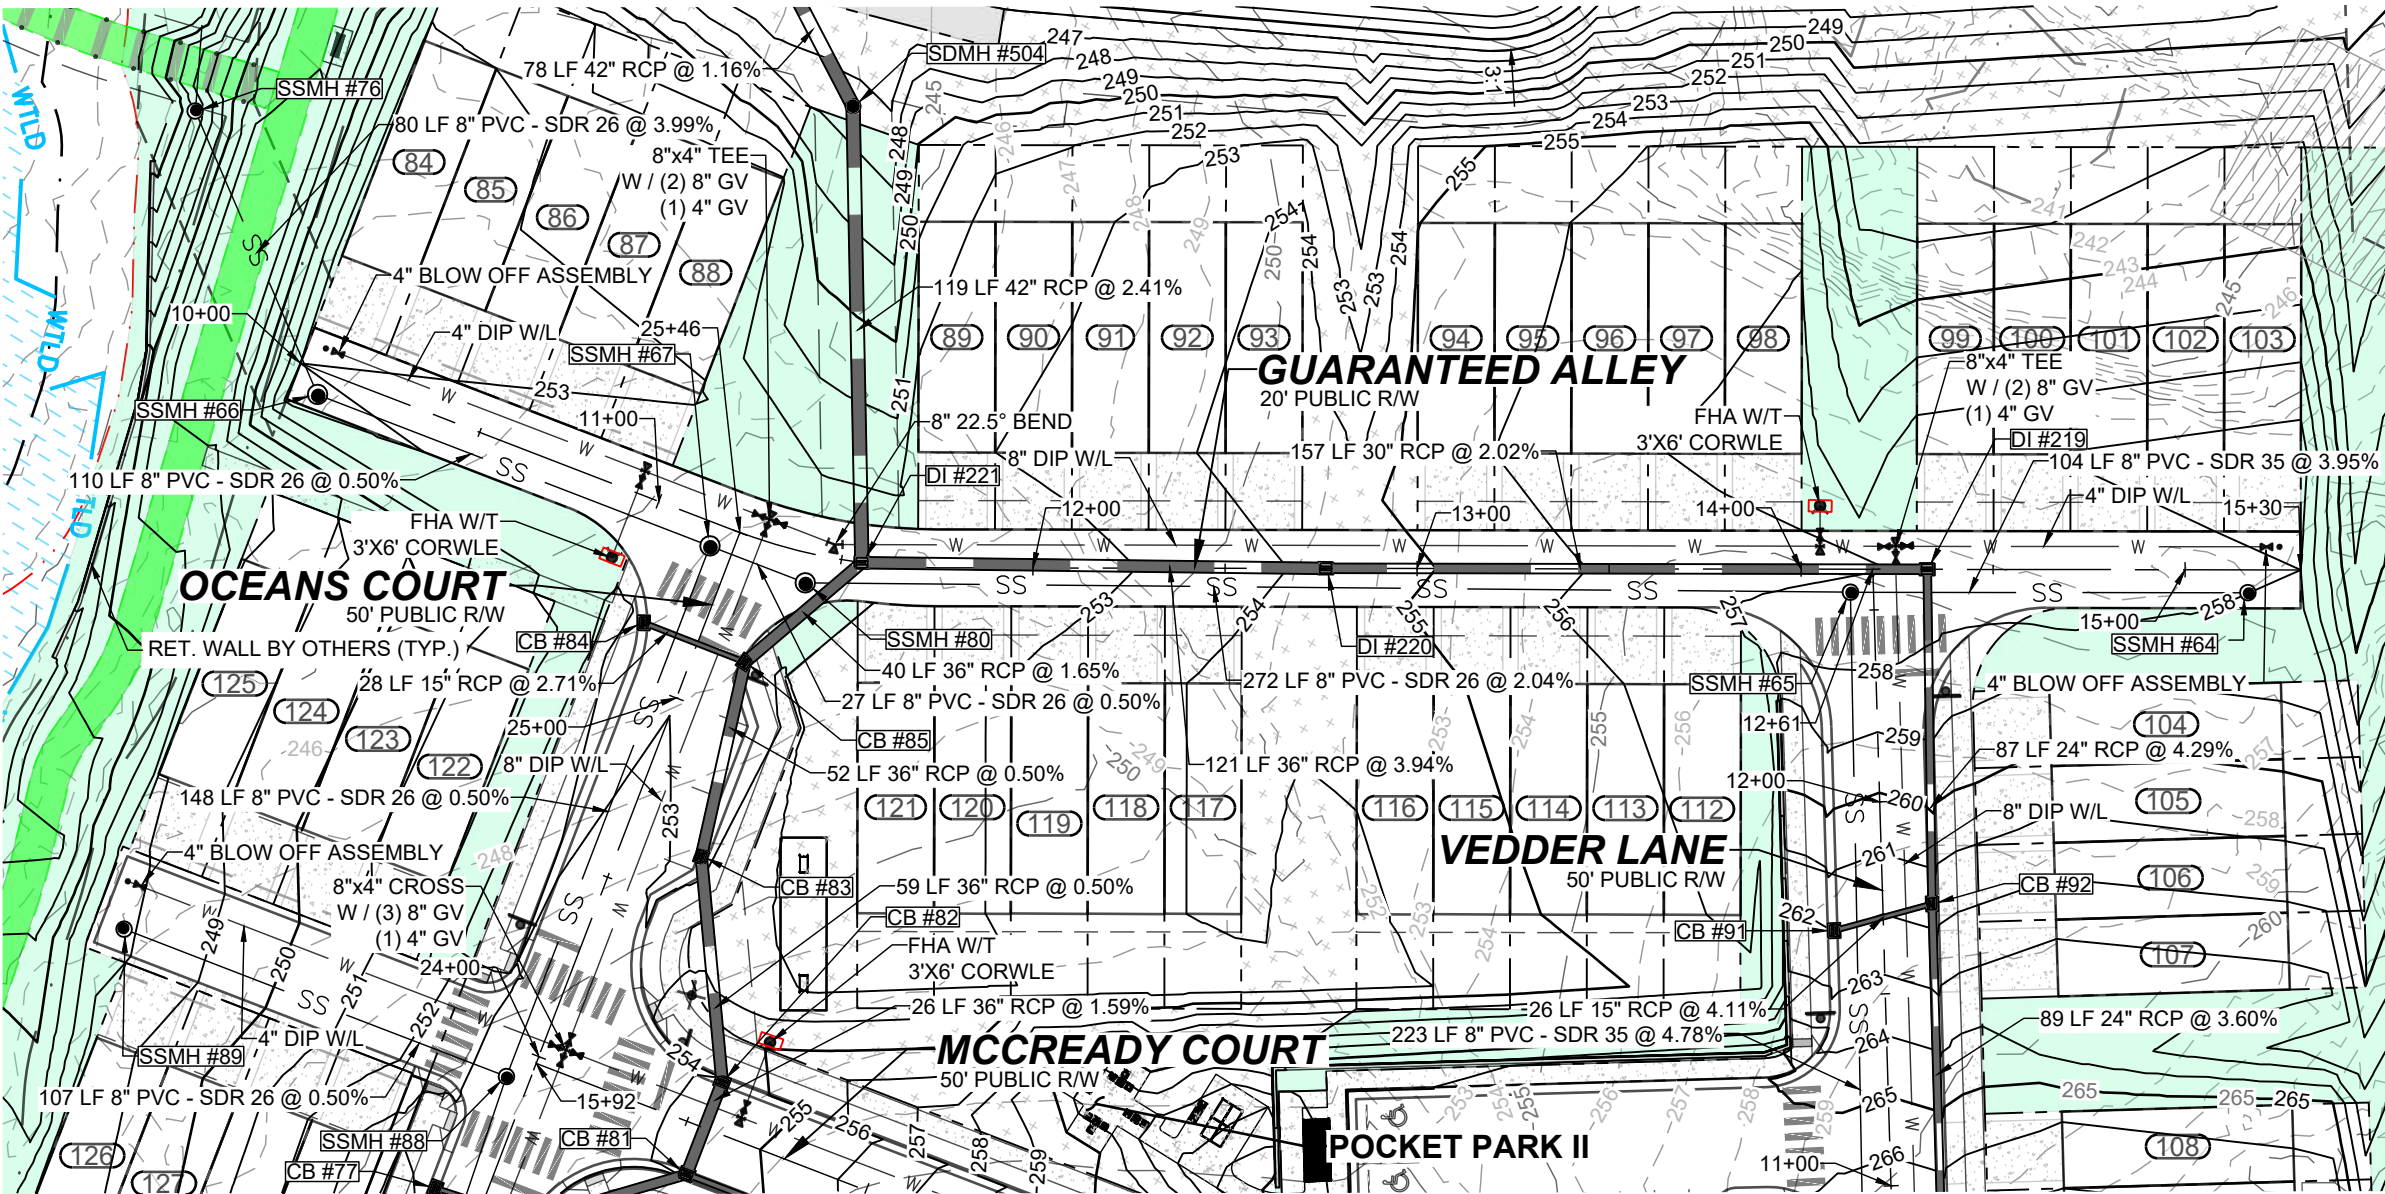

PROPOSED GUARANTEED ALLEY - PLAN
HORIZONTAL: 1" = 50'

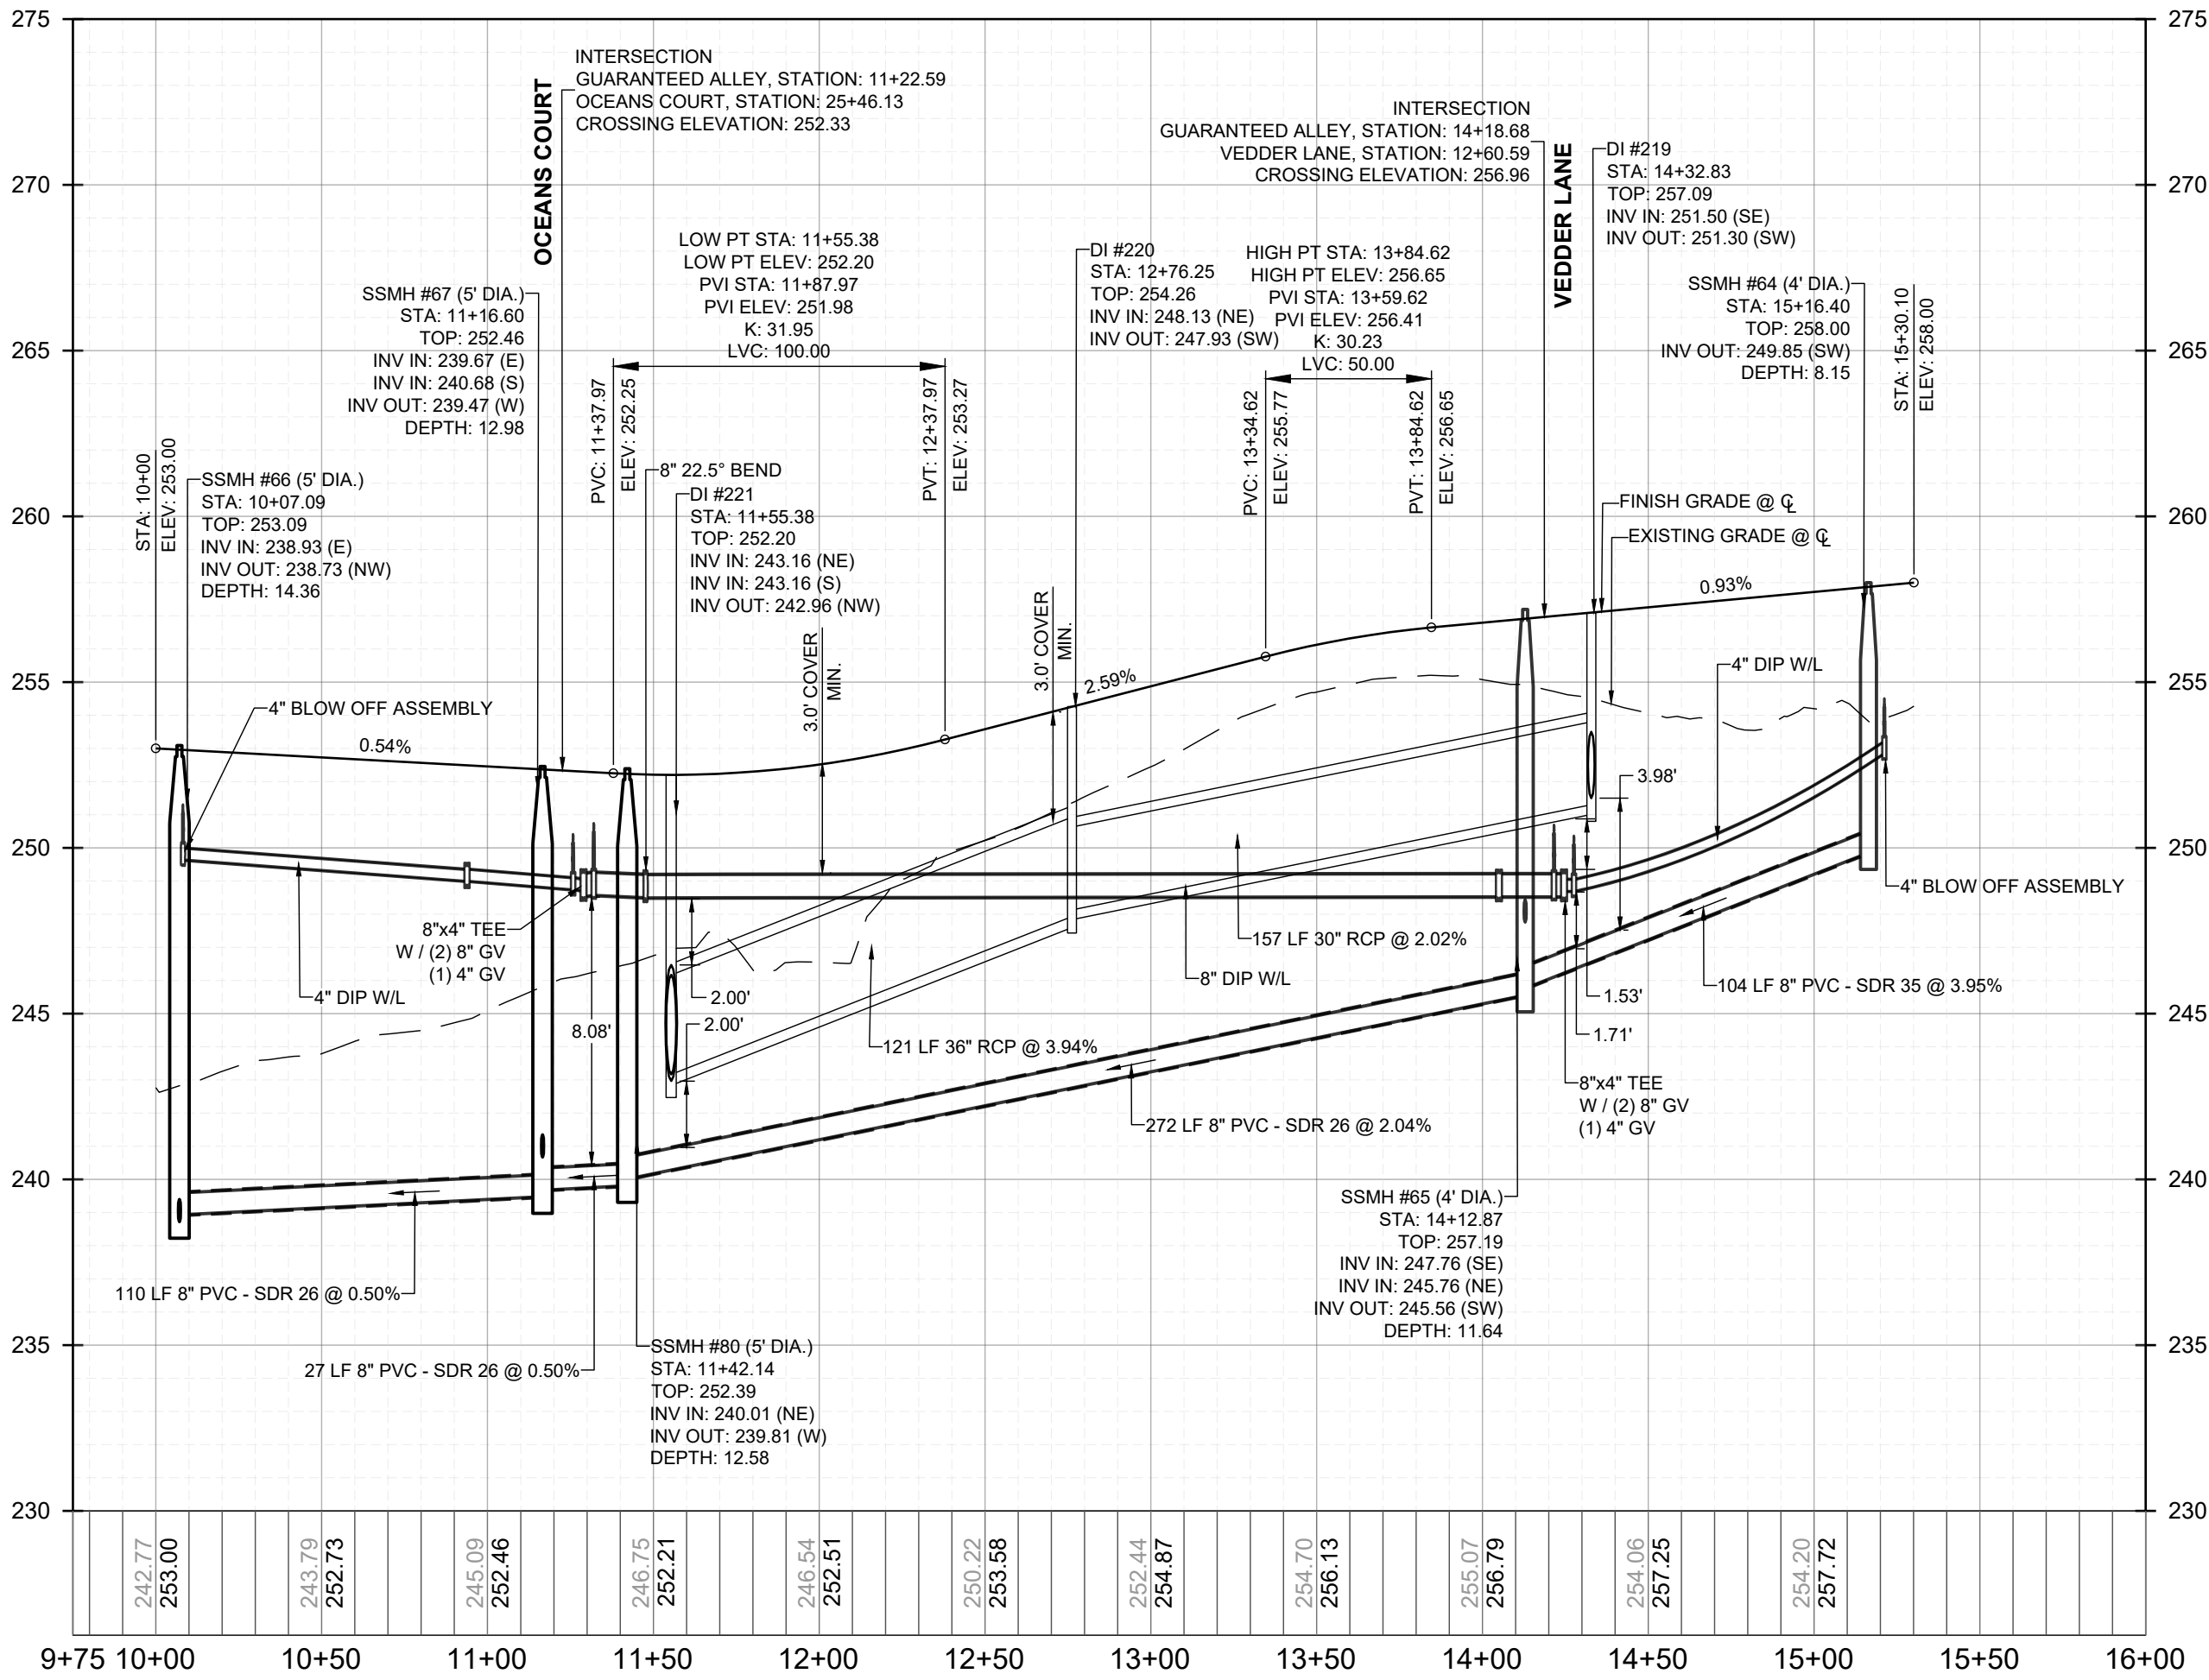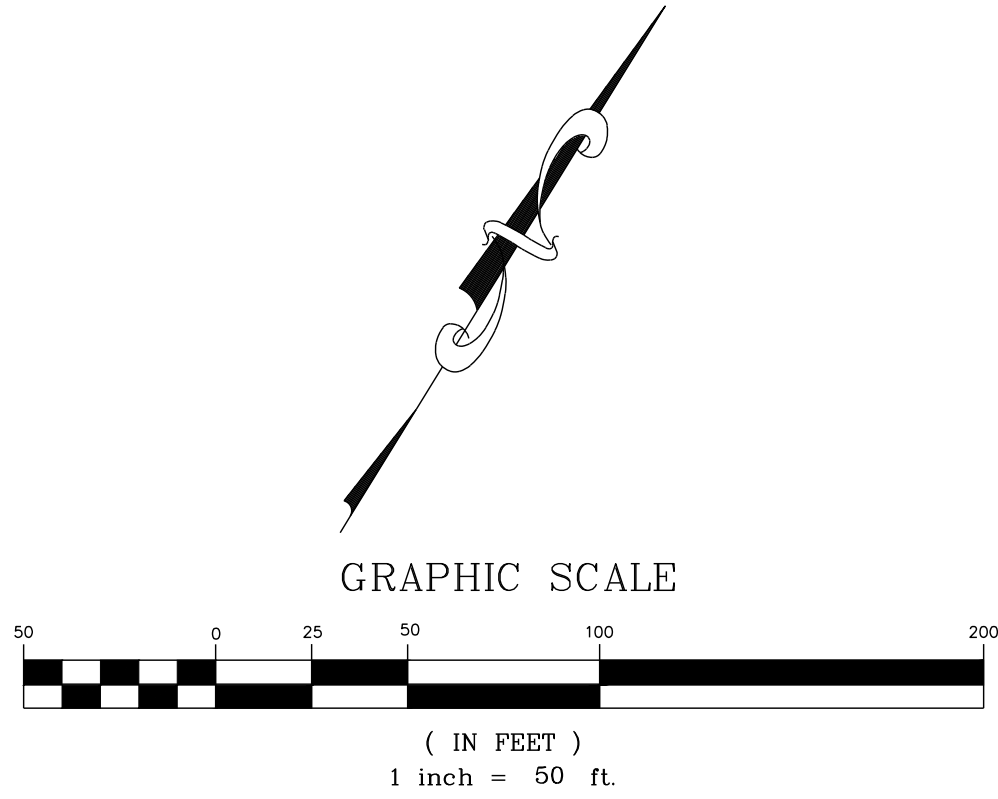

PROPOSED GUARANTEED ALLEY - PROFILE
VERTICAL: 1" = 5'
HORIZONTAL: 1" = 50'

PUBLIC
WATER DISTRIBUTION / EXTENSION SYSTEM
THE CITY OF RALEIGH consents to the connection and extension of the CITY'S PUBLIC WATER SYSTEM AS SHOWN ON THIS PLAN. THE MATERIAL AND CONSTRUCTION METHODS USED FOR THIS PROJECT SHALL CONFORM TO THE STANDARDS AND SPECIFICATIONS OF THE CITY'S PUBLIC UTILITIES HANDBOOK.
CITY OF RALEIGH
PUBLIC UTILITIES DEPARTMENT PERMIT # _____

PUBLIC
SEWER COLLECTION / EXTENSION SYSTEM
THE CITY OF RALEIGH consents to the connection and extension of the CITY'S PUBLIC SEWER SYSTEM AS SHOWN ON THIS PLAN. THE MATERIAL AND CONSTRUCTION METHODS USED FOR THIS PROJECT SHALL CONFORM TO THE STANDARDS AND SPECIFICATIONS OF THE CITY'S PUBLIC UTILITIES HANDBOOK.
CITY OF RALEIGH
PUBLIC UTILITIES DEPARTMENT PERMIT # _____

CONSTRUCTION INFRASTRUCTURE DRAWINGS		REVISIONS		DATE	BY
01	CID-24-04				
02	TOWN OF ROLESVILLE CID-24-04 V2				
03	TOWN OF ROLESVILLE CID-24-04 V3				
04	TOWN OF ROLESVILLE CID-24-04 V4				
05	TOWN OF ROLESVILLE CID-24-04 V5				
No.					

SEAL:

STRONGROCK

ENGINEERING GROUP


STRONG ROCK ENGINEERING GROUP, PLLC | COMPANY LICENSE # P-2166
305 CHURCH AT NORTH HILLS STREET, SUITE 1110 RALEIGH, NC 27609 | INFORMATION@STRONGROCKGROUP.COM

STRONG ROCK PROJECT	NOT FOR CONSTRUCTION	SCALE	SRG	SRG	SRG
PSP-24-03	AS SHOWN	DESIGNED BY	DRAWN BY	CHECKED BY	


RESERVE @ MITCHELL MILL
TOWN OF ROLESVILLE, WAKE COUNTY, NORTH CAROLINA
CONSTRUCTION PLANS
PROPOSED GUARANTEED ALLEY - PLAN & PROFILE

DRAWING SHEET

C-11.24

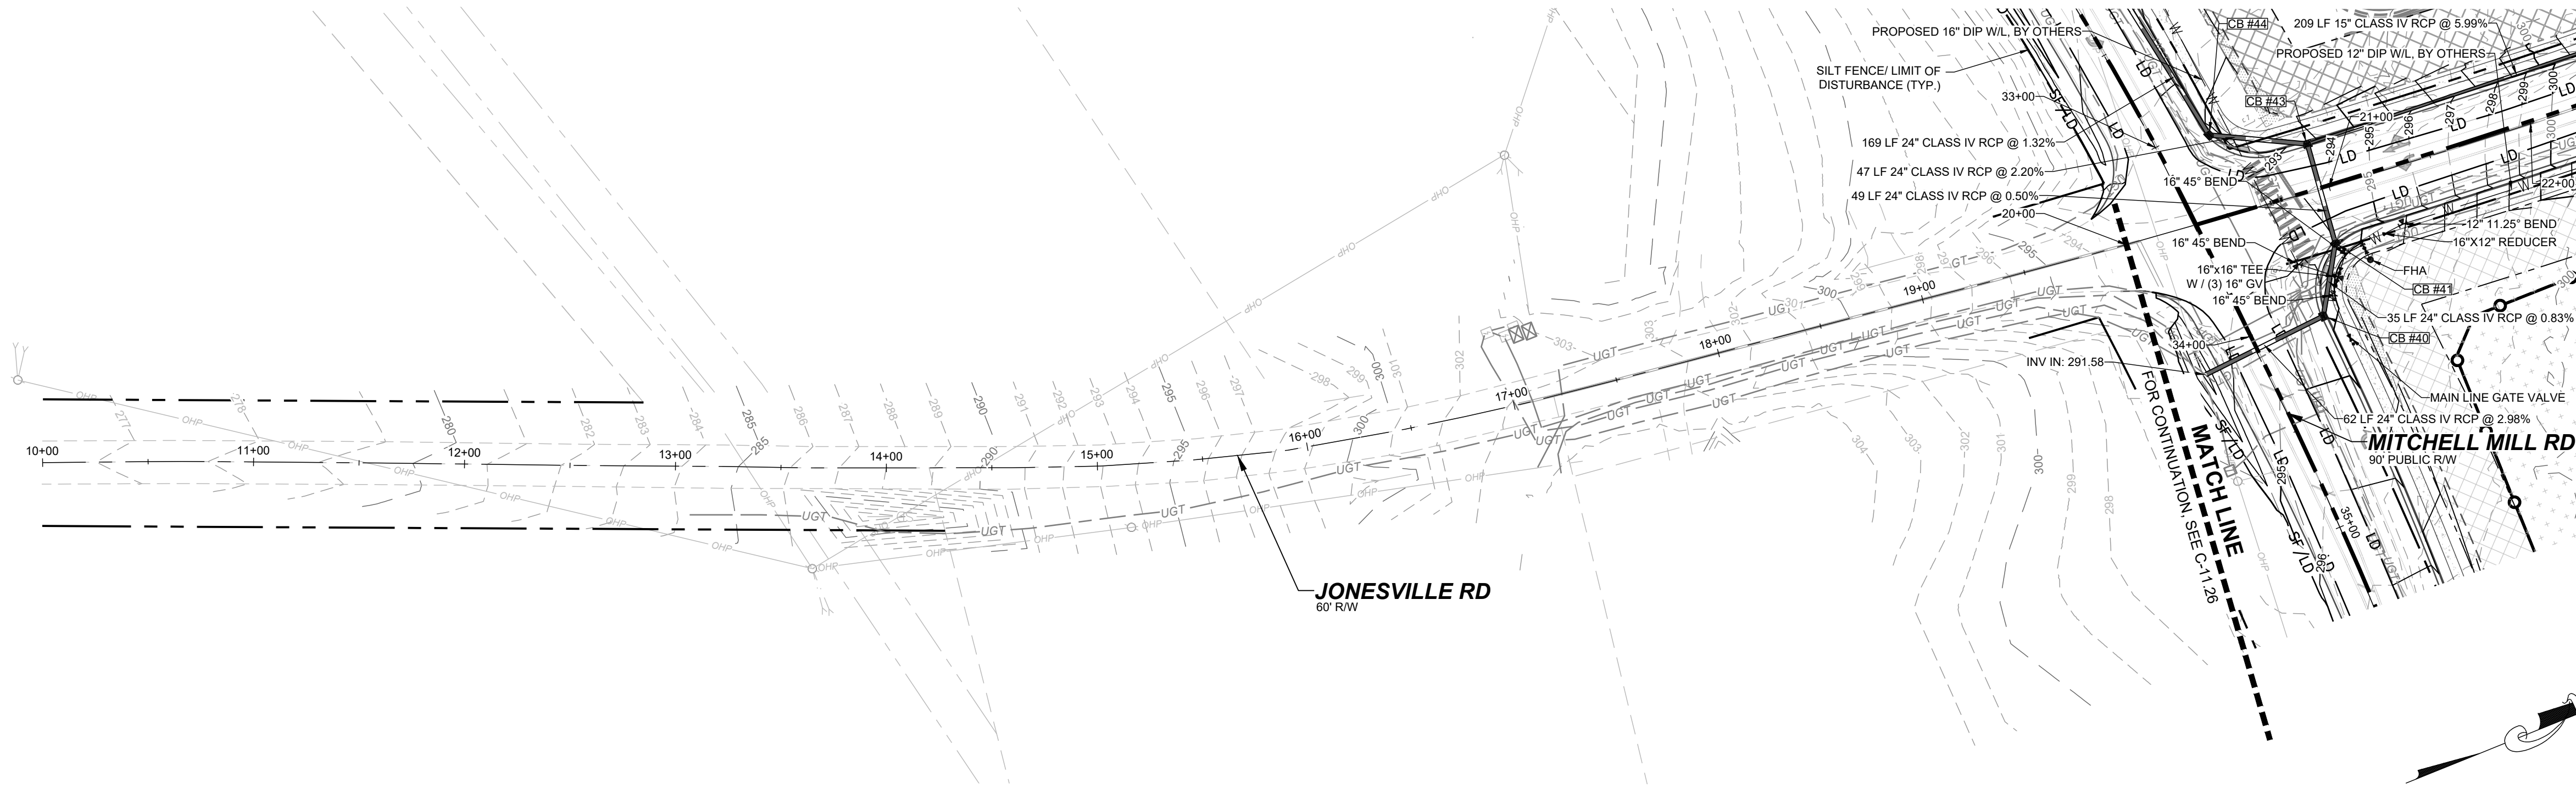


OFF-SITE JONESVILLE RD - PLAN
HORIZONTAL: 1" = 50'

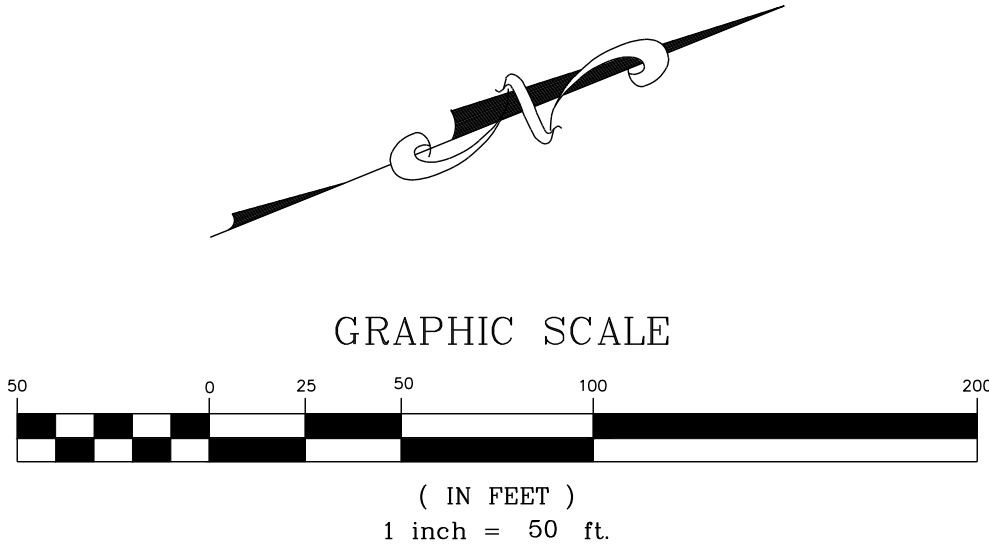

PUBLIC
WATER DISTRIBUTION / EXTENSION SYSTEM
THE CITY OF RALEIGH CONSENTS TO THE CONNECTION AND EXTENSION OF THE CITY'S PUBLIC WATER SYSTEM AS SHOWN ON THIS PLAN. THE MATERIAL AND CONSTRUCTION METHODS USED FOR THIS PROJECT SHALL CONFORM TO THE STANDARDS AND SPECIFICATIONS OF THE CITY'S PUBLIC UTILITIES HANDBOOK.
CITY OF RALEIGH
PUBLIC UTILITIES DEPARTMENT PERMIT # _____

PUBLIC
SEWER COLLECTION / EXTENSION SYSTEM
THE CITY OF RALEIGH CONSENTS TO THE CONNECTION AND EXTENSION OF THE CITY'S PUBLIC SEWER SYSTEM AS SHOWN ON THIS PLAN. THE MATERIAL AND CONSTRUCTION METHODS USED FOR THIS PROJECT SHALL CONFORM TO THE STANDARDS AND SPECIFICATIONS OF THE CITY'S PUBLIC UTILITIES HANDBOOK.
CITY OF RALEIGH
PUBLIC UTILITIES DEPARTMENT PERMIT # _____

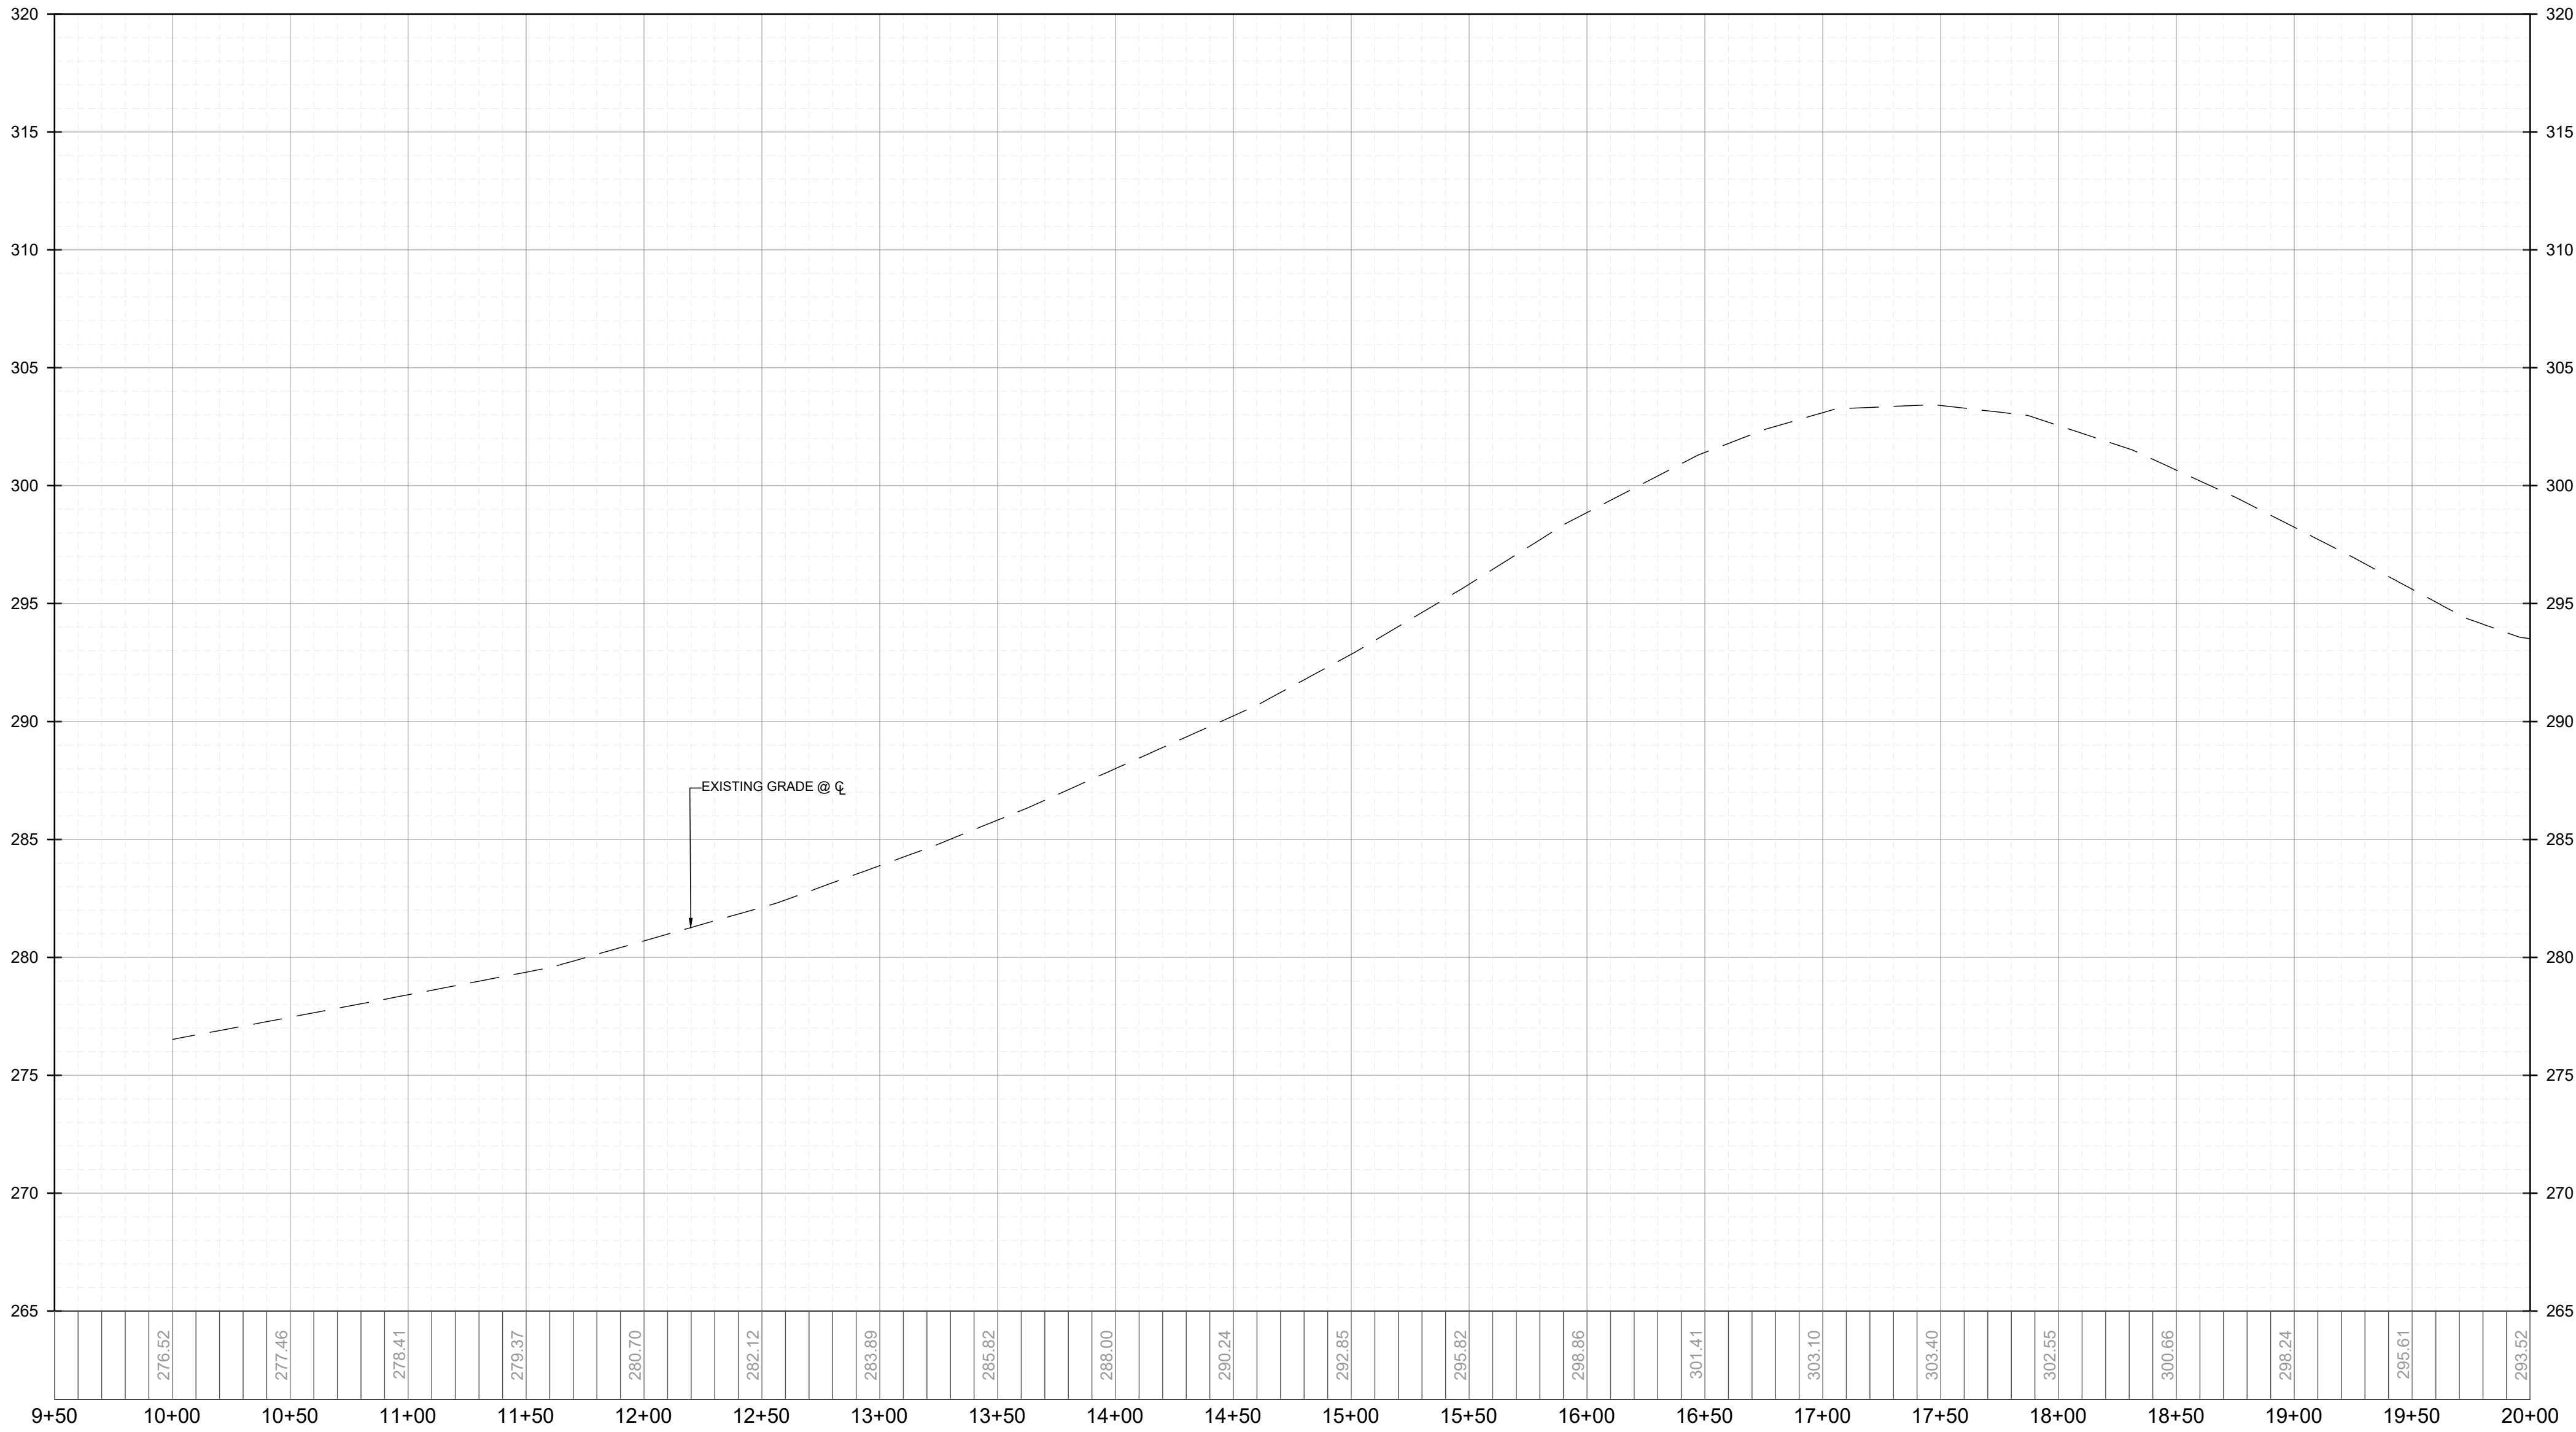

OFF-SITE JONESVILLE RD - PROFILE
VERTICAL: 1" = 5'
HORIZONTAL: 1" = 50'

THIS PLANSET AND ANY ASSOCIATED DOCUMENTS ARE PRELIMINARY AND NOT AUTHORIZED FOR CONSTRUCTION UNTIL SIGNED, DATED, AND OFFICIALLY RELEASED FOR CONSTRUCTION BY THE ENGINEER OF RECORD.

CONSTRUCTION INFRASTRUCTURE DRAWINGS		DATE	BY
01	CID-24-04	08/04/2024	SRG
02	TOWN OF ROLESVILLE CID-24-04 V2	11/07/2024	SRG
03	TOWN OF ROLESVILLE CID-24-04 V3	02/07/2024	SRG
04	TOWN OF ROLESVILLE CID-24-04 V4	08/02/2025	SRG
05	TOWN OF ROLESVILLE CID-24-04 V5	09/02/2025	SRG
No.	REVISIONS		

SEAL:

STRONGROCK

ENGINEERING GROUP

STRONG ROCK ENGINEERING GROUP, PLLC | COMPANY LICENSE # P-2166
305 CHURCH AT NORTH HILLS STREET, SUITE 1110 RALEIGH, NC 27609 | INFORMATION@STRONGROCKGROUP.COM


STRONG ROCK PROJECT PSP-24-03	NOT FOR CONSTRUCTION	SCALE AS SHOWN	DESIGNED BY SRG	CHECKED BY SRG
----------------------------------	-------------------------	-------------------	--------------------	-------------------

RESERVE @ MITCHELL MILL
TOWN OF ROLESVILLE, WAKE COUNTY, NORTH CAROLINA
CONSTRUCTION PLANS
OFF-SITE JONESVILLE RD -
PLAN & PROFILE


DRAWING
SHEET

C-11.25

121 OF 230

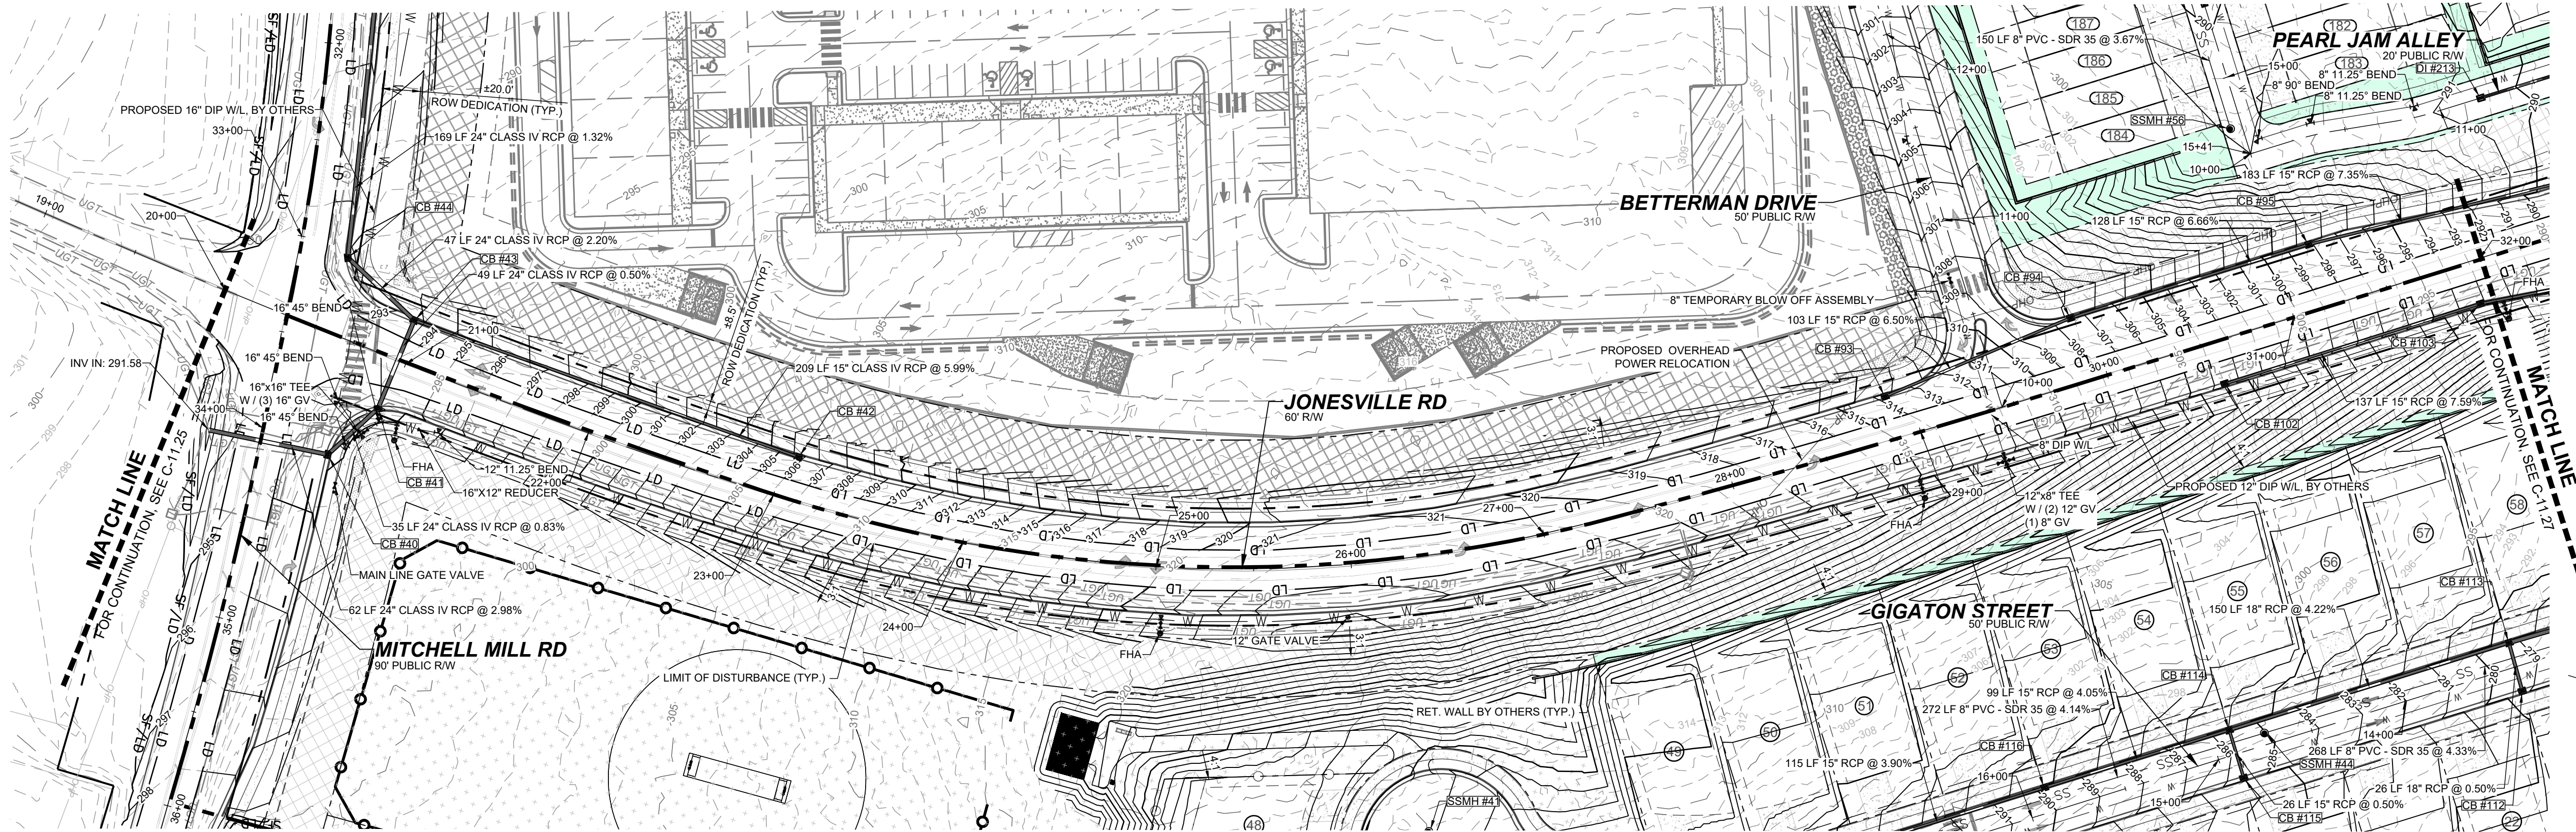

OFF-SITE JONESVILLE RD - PLAN
HORIZONTAL: 1" = 50'

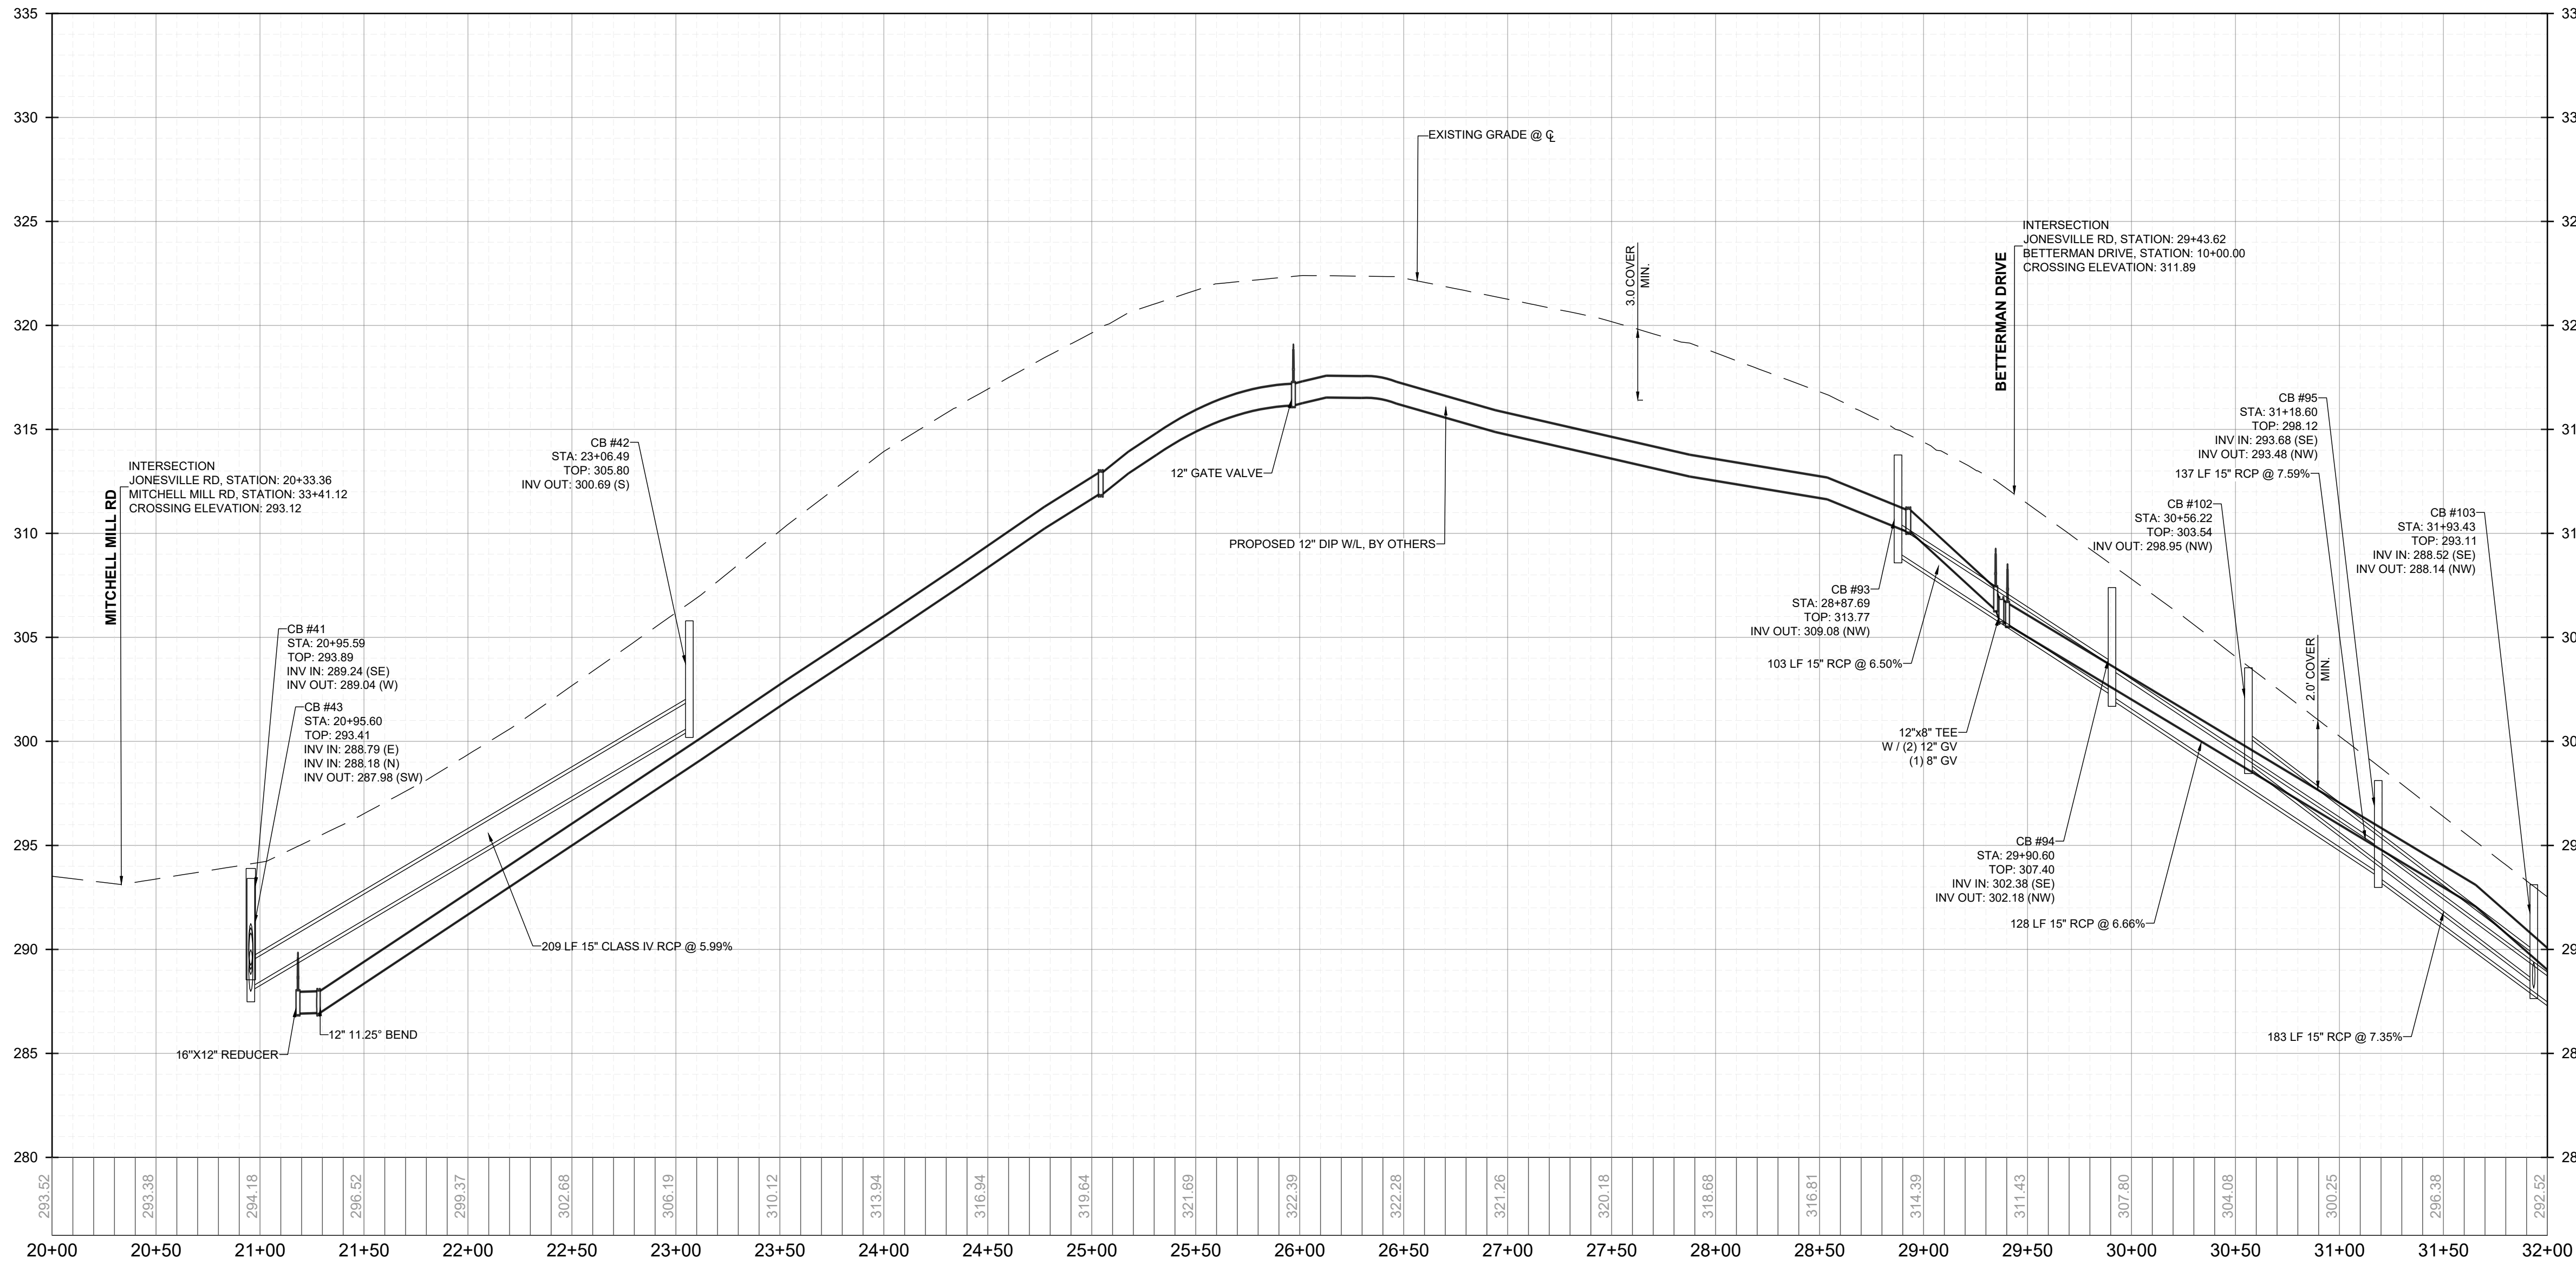

OFF-SITE JONESVILLE RD - PROFILE
VERTICAL: 1" = 5'
HORIZONTAL: 1" = 50'

THIS PLANSET AND ANY ASSOCIATED DOCUMENTS ARE PRELIMINARY AND NOT AUTHORIZED FOR CONSTRUCTION UNTIL SIGNED, DATED, AND OFFICIALLY RELEASED FOR CONSTRUCTION BY THE ENGINEER OF RECORD.

CONSTRUCTION INFRASTRUCTURE DRAWINGS		SEAL:		REVISIONS		BY	
No.		No.		No.		No.	
01	TOWN OF ROLESVILLE CID-24-04 V1	02	TOWN OF ROLESVILLE CID-24-04 V2	03	TOWN OF ROLESVILLE CID-24-04 V3	04	TOWN OF ROLESVILLE CID-24-04 V4

STRONGROCK

ENGINEERING GROUP

STRONG ROCK ENGINEERING GROUP, PLLC | COMPANY LICENSE # P-2766
305 CHURCH AT NORTH HILLS STREET, SUITE 1110 RALEIGH, NC 27609 | INFORMATION@STRONGROCKGROUP.COM



STRONG ROCK PROJECT	NOT FOR CONSTRUCTION	SCALE	AS SHOWN	SRG	SRG	SRG
PSP-24-03						

RESERVE @ MITCHELL MILL
TOWN OF ROLESVILLE, WAKE COUNTY, NORTH CAROLINA
CONSTRUCTION PLANS
OFF-SITE JONESVILLE RD -
PLAN & PROFILE

DRAWING SHEET

C-11.26

122 OF 230

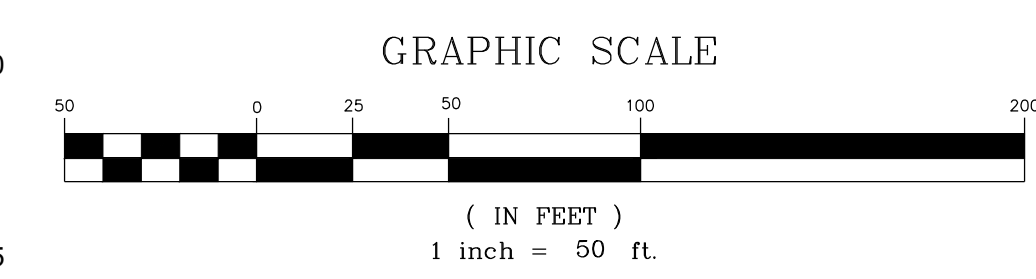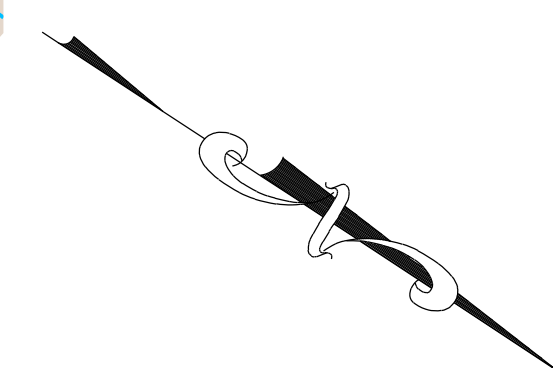

PUBLIC
WATER DISTRIBUTION / EXTENSION SYSTEM


THE CITY OF RALEIGH CONSENTS TO THE CONNECTION AND EXTENSION OF THE CITY'S PUBLIC WATER SYSTEM AS SHOWN ON THIS PLAN, THE MATERIAL AND CONSTRUCTION METHODS USED FOR THE PROJECT SHALL CONFORM TO THE STANDARDS AND SPECIFICATIONS OF THE CITY'S PUBLIC UTILITIES HANDBOOK, CITY OF RALEIGH.

PUBLIC UTILITIES DEPARTMENT PERMIT # _____


PUBLIC
SEWER COLLECTION / EXTENSION SYSTEM

THE CITY OF RALEIGH CONSENTS TO THE CONNECTION AND EXTENSION OF THE CITY'S PUBLIC SEWER SYSTEM AS SHOWN ON THIS PLAN. THE MATERIAL AND CONSTRUCTION METHODS USED FOR THIS PROJECT SHALL CONFORM TO THE STANDARDS AND SPECIFICATIONS OF THE CITY'S PUBLIC UTILITIES HANDBOOK.
CITY OF RALEIGH
PUBLIC UTILITIES DEPARTMENT PERMIT # _____

THIS PLANSET AND ANY ASSOCIATED DOCUMENTS ARE PRELIMINARY AND NOT AUTHORIZED FOR CONSTRUCTION UNTIL SIGNED, DATED, AND OFFICIALLY RELEASED FOR CONSTRUCTION BY THE ENGINEER OF RECORD.

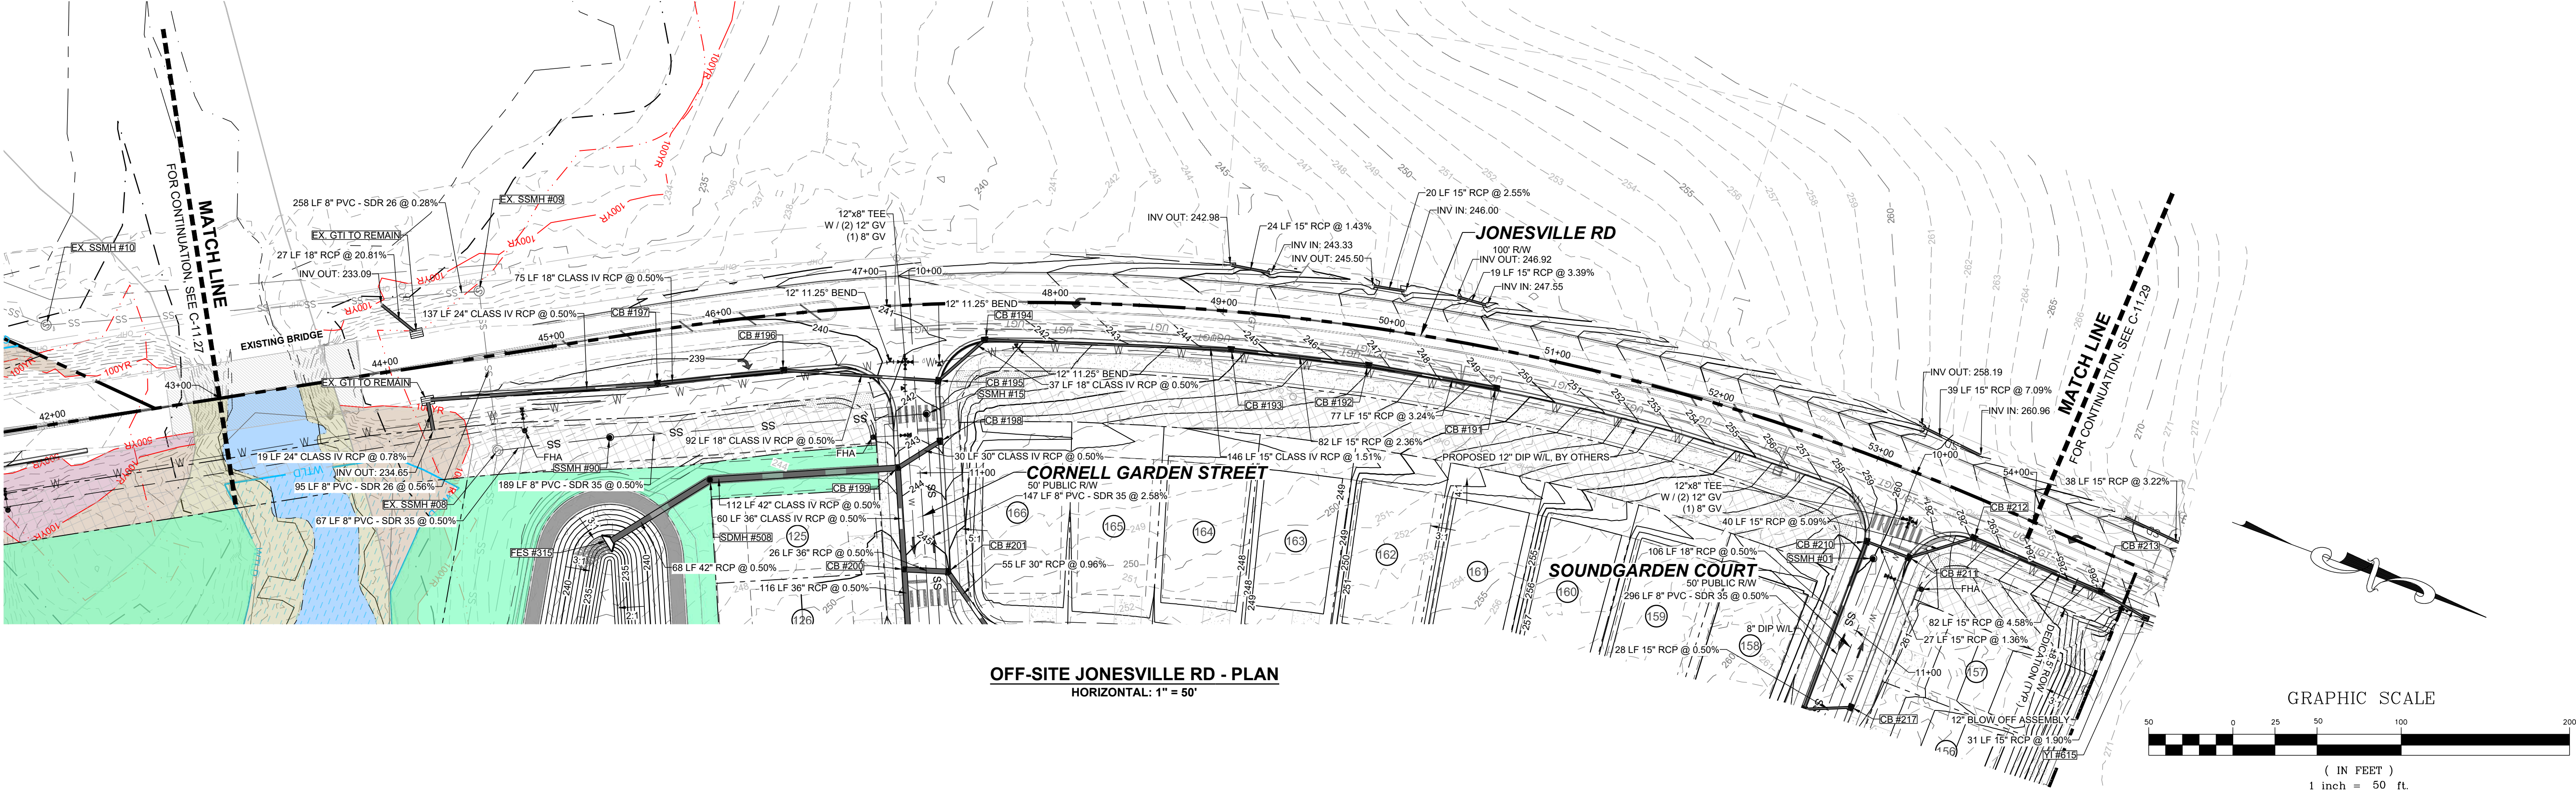

OFF-SITE JONESVILLE RD - PLAN
HORIZONTAL: 1" = 50'

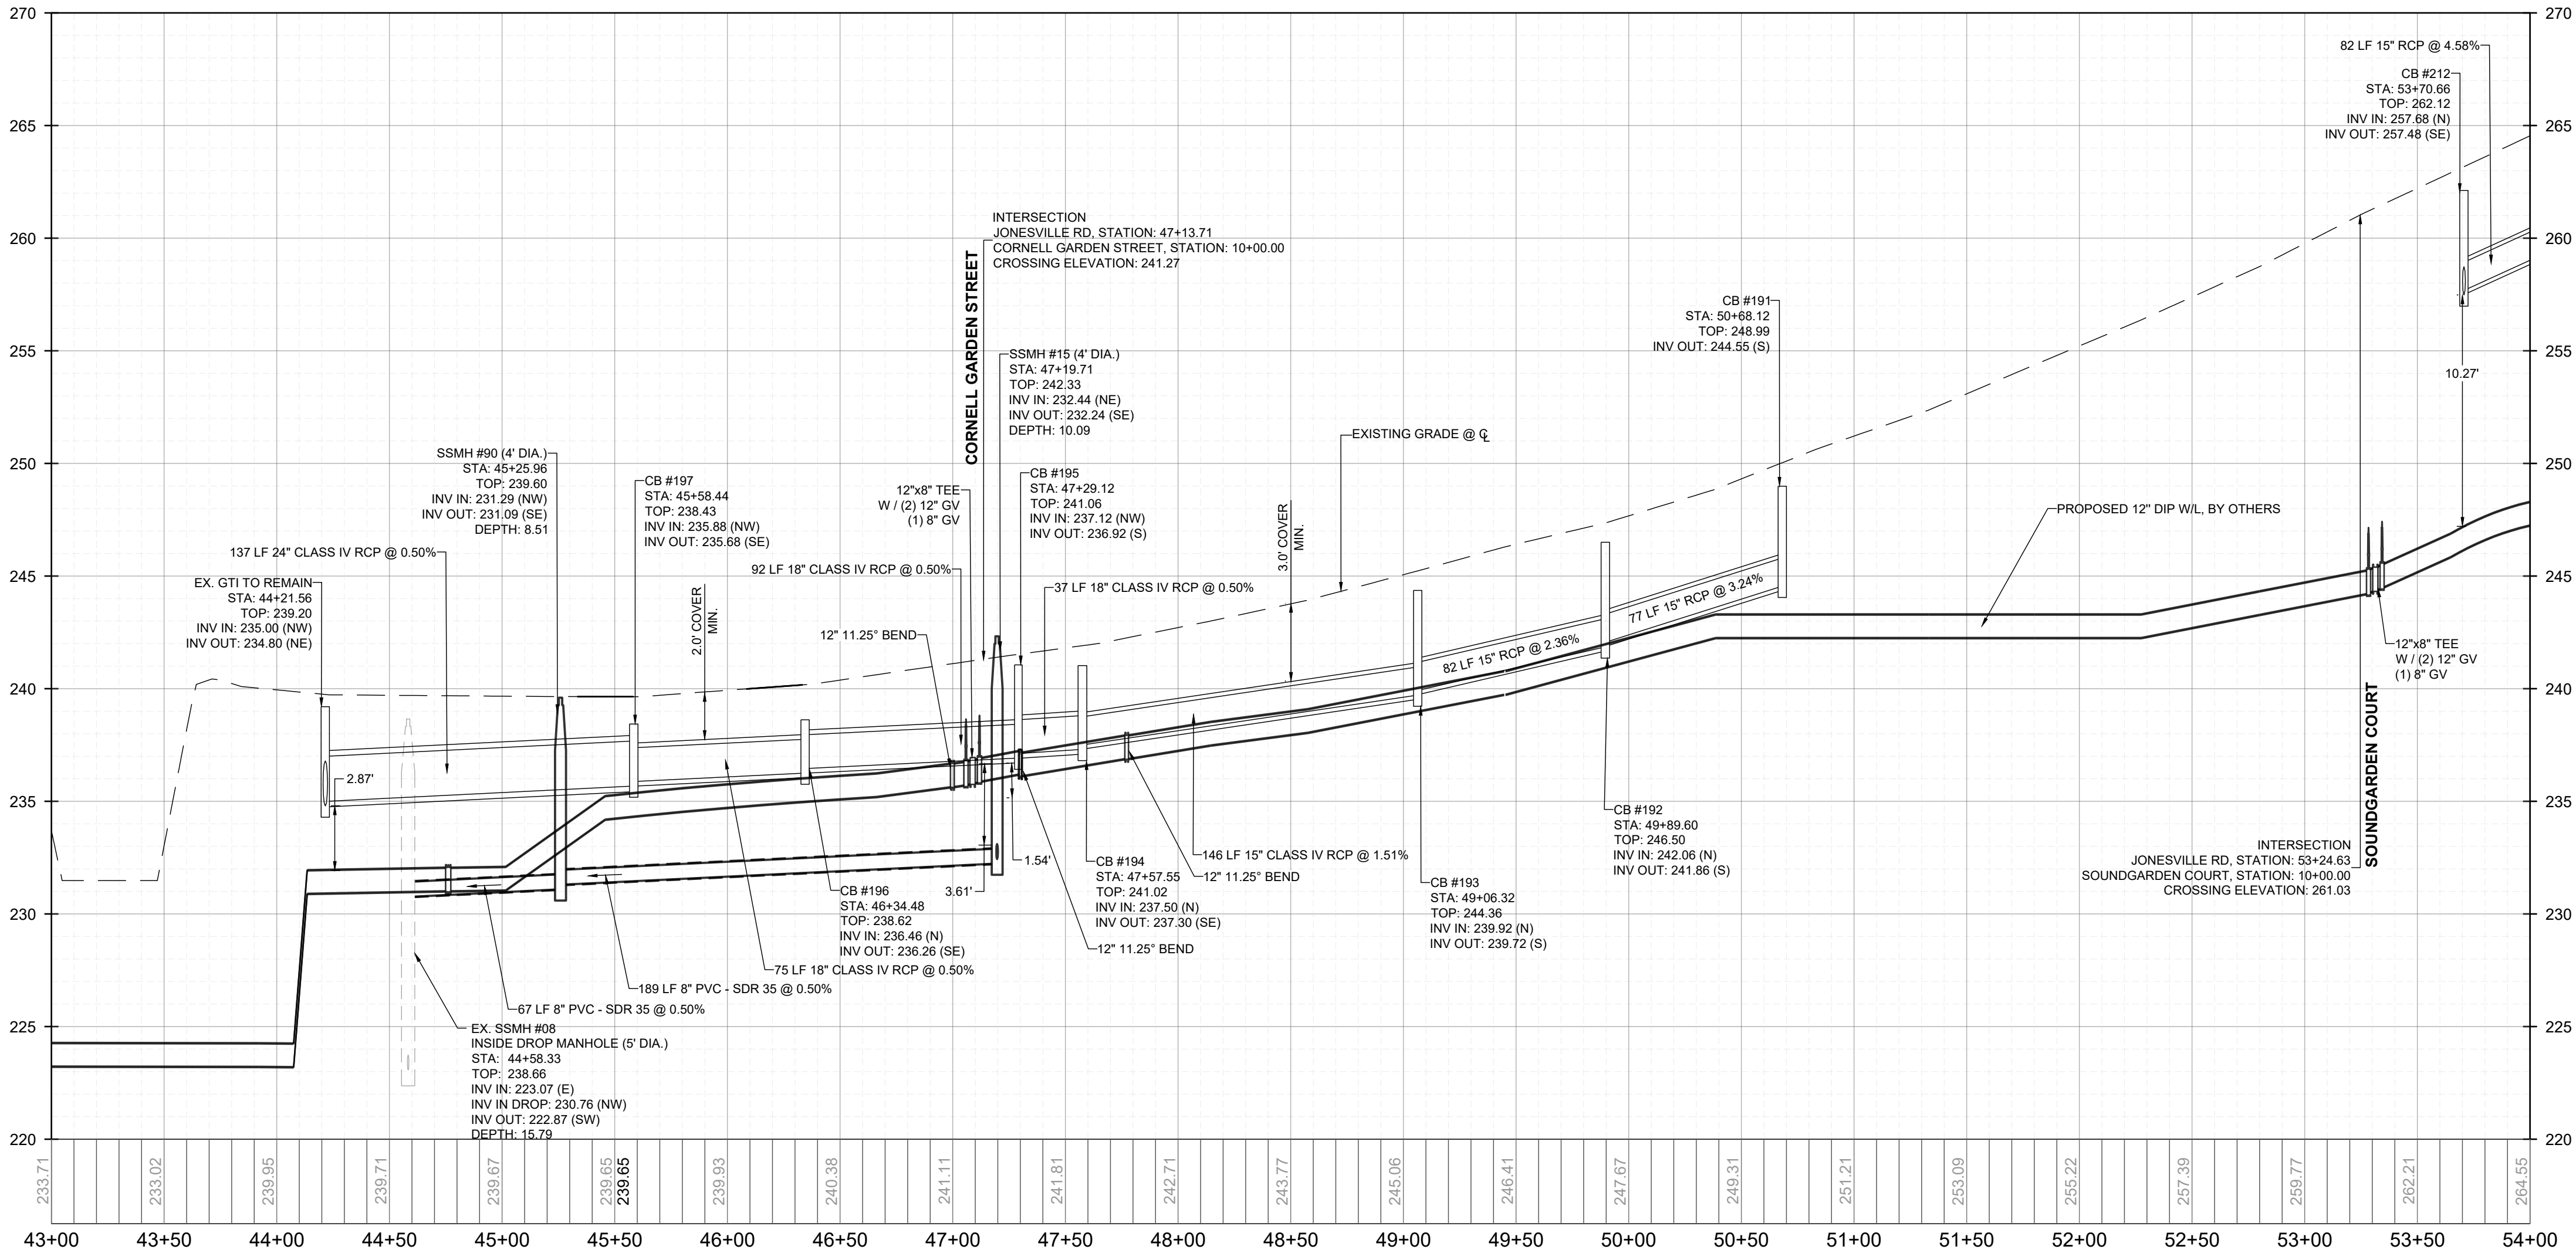

OFF-SITE JONESVILLE RD - PROFILE
VERTICAL: 1" = 5'
HORIZONTAL: 1" = 50'

PUBLIC
WATER DISTRIBUTION / EXTENSION SYSTEM
THE CITY OF RALEIGH CONSENTS TO THE CONNECTION AND EXTENSION OF THE CITY'S PUBLIC WATER SYSTEM AS SHOWN ON THIS PLAN. THE MATERIAL AND CONSTRUCTION METHODS USED FOR THIS PROJECT SHALL CONFORM TO THE STANDARDS AND SPECIFICATIONS OF THE CITY'S PUBLIC UTILITIES HANDBOOK.
CITY OF RALEIGH
PUBLIC UTILITIES DEPARTMENT PERMIT # _____

PUBLIC
SEWER COLLECTION / EXTENSION SYSTEM
THE CITY OF RALEIGH CONSENTS TO THE CONNECTION AND EXTENSION OF THE CITY'S PUBLIC SEWER SYSTEM AS SHOWN ON THIS PLAN. THE MATERIAL AND CONSTRUCTION METHODS USED FOR THIS PROJECT SHALL CONFORM TO THE STANDARDS AND SPECIFICATIONS OF THE CITY'S PUBLIC UTILITIES HANDBOOK.
CITY OF RALEIGH
PUBLIC UTILITIES DEPARTMENT PERMIT # _____

THIS PLANSET AND ANY ASSOCIATED DOCUMENTS ARE PRELIMINARY AND NOT AUTHORIZED FOR CONSTRUCTION UNTIL SIGNED, DATED, AND OFFICIALLY RELEASED FOR CONSTRUCTION BY THE ENGINEER OF RECORD.

STRONGROCK

ENGINEERING GROUP

STRONG ROCK ENGINEERING GROUP, PLLC | COMPANY LICENSE # P-2166
305 CHURCH AT NORTH HILLS STREET, SUITE 1110 RALEIGH, NC 27609 | INFORMATION@STRONGROCKGROUP.COM

CONSTRUCTION INFRASTRUCTURE DRAWINGS
CID-24-04

01

02

03

04

05

NO.

DATE


REVISIONS

BY



RESERVE @ MITCHELL MILL
TOWN OF ROLESVILLE, WAKE COUNTY, NORTH CAROLINA
CONSTRUCTION PLANS
OFF-SITE JONESVILLE RD -
PLAN & PROFILE

DRAWING SHEET
C-11.28

124 OF 230

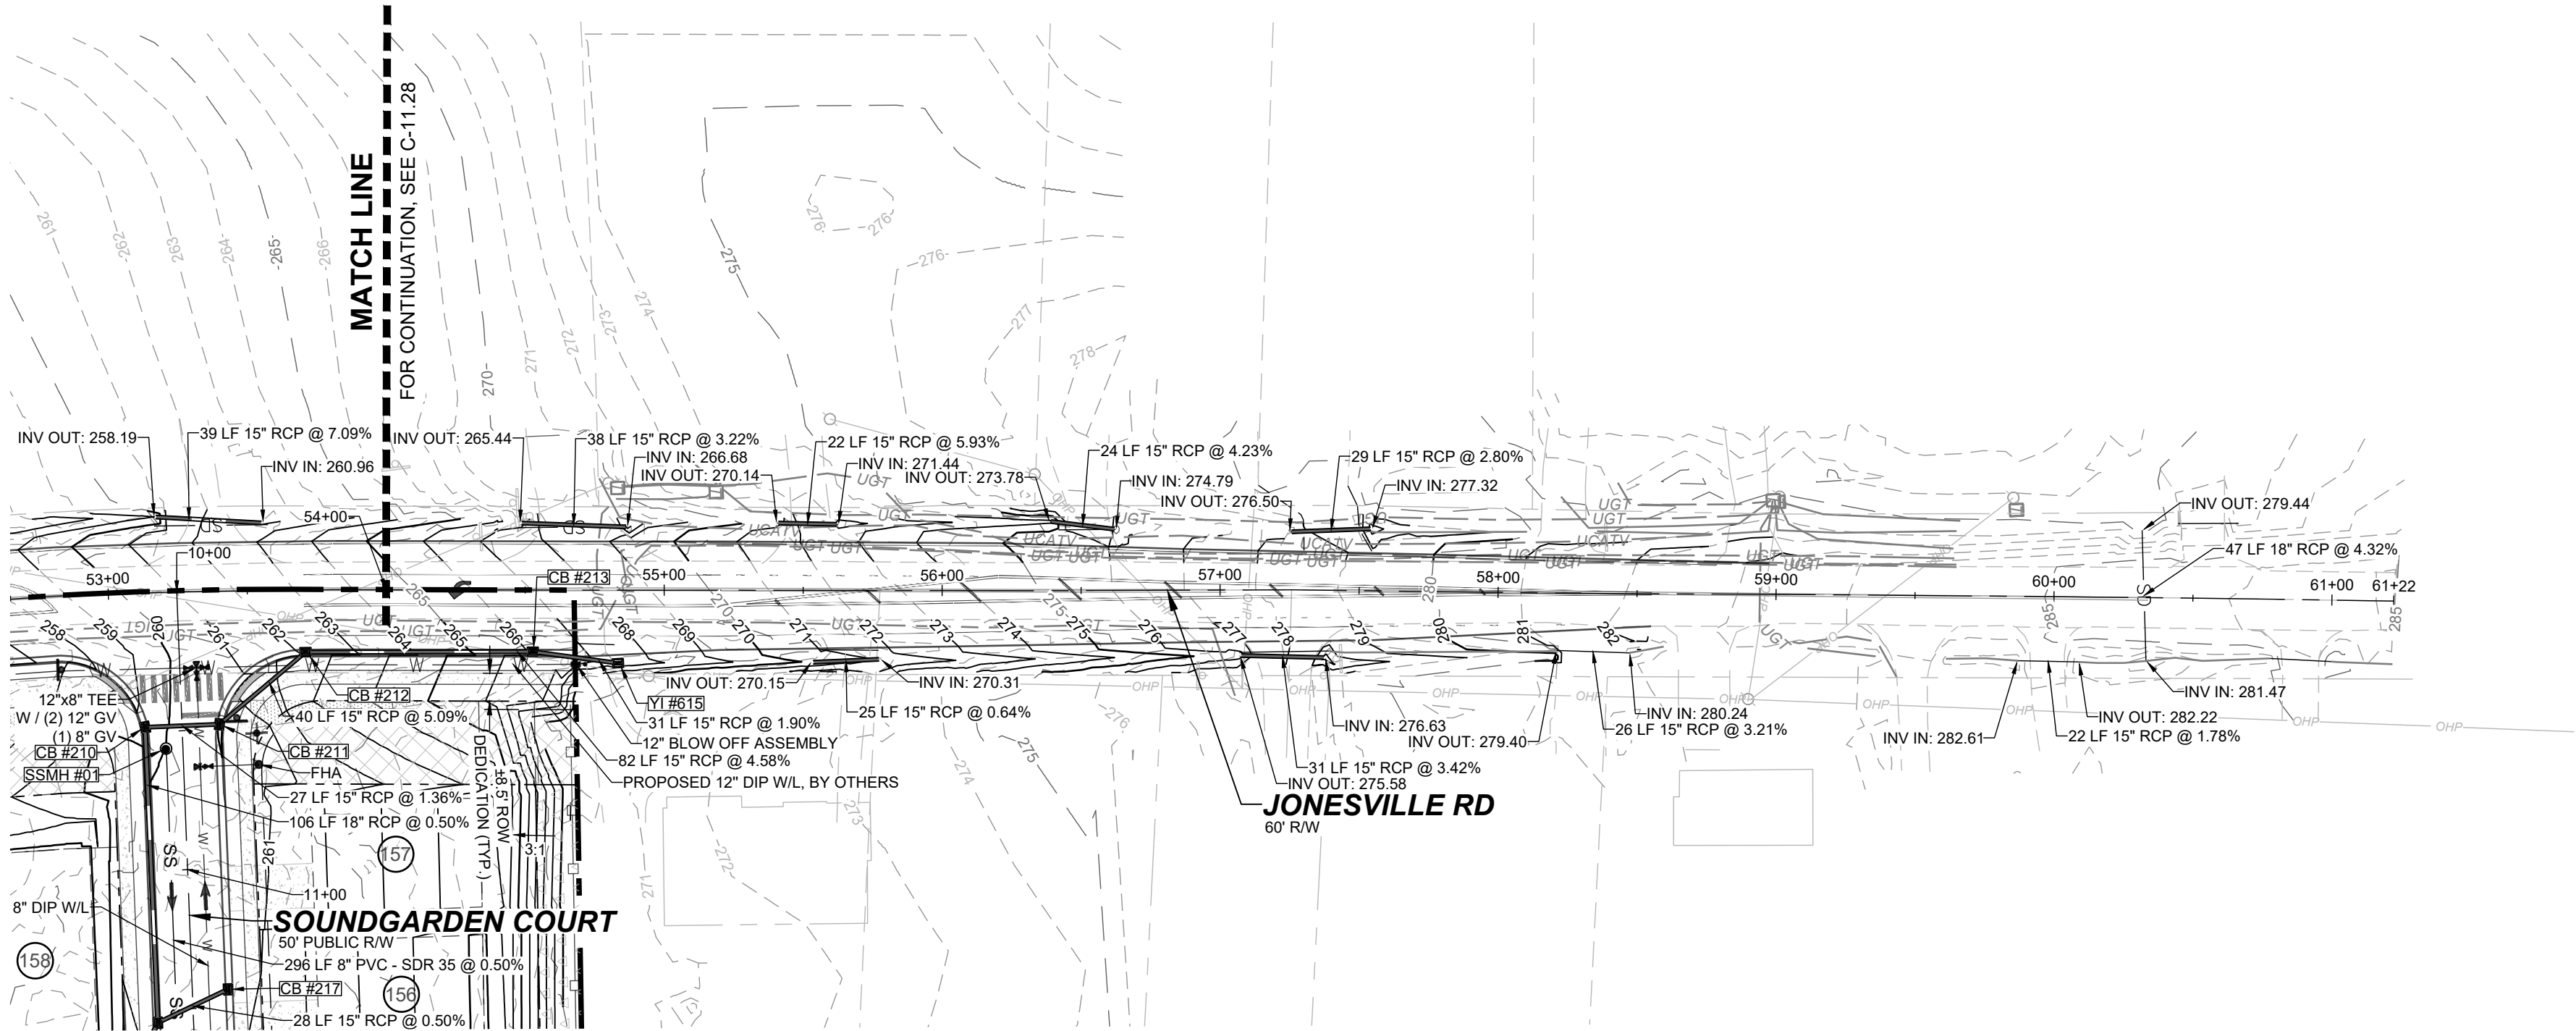

OFF-SITE JONESVILLE RD - PLAN
HORIZONTAL: 1" = 50'

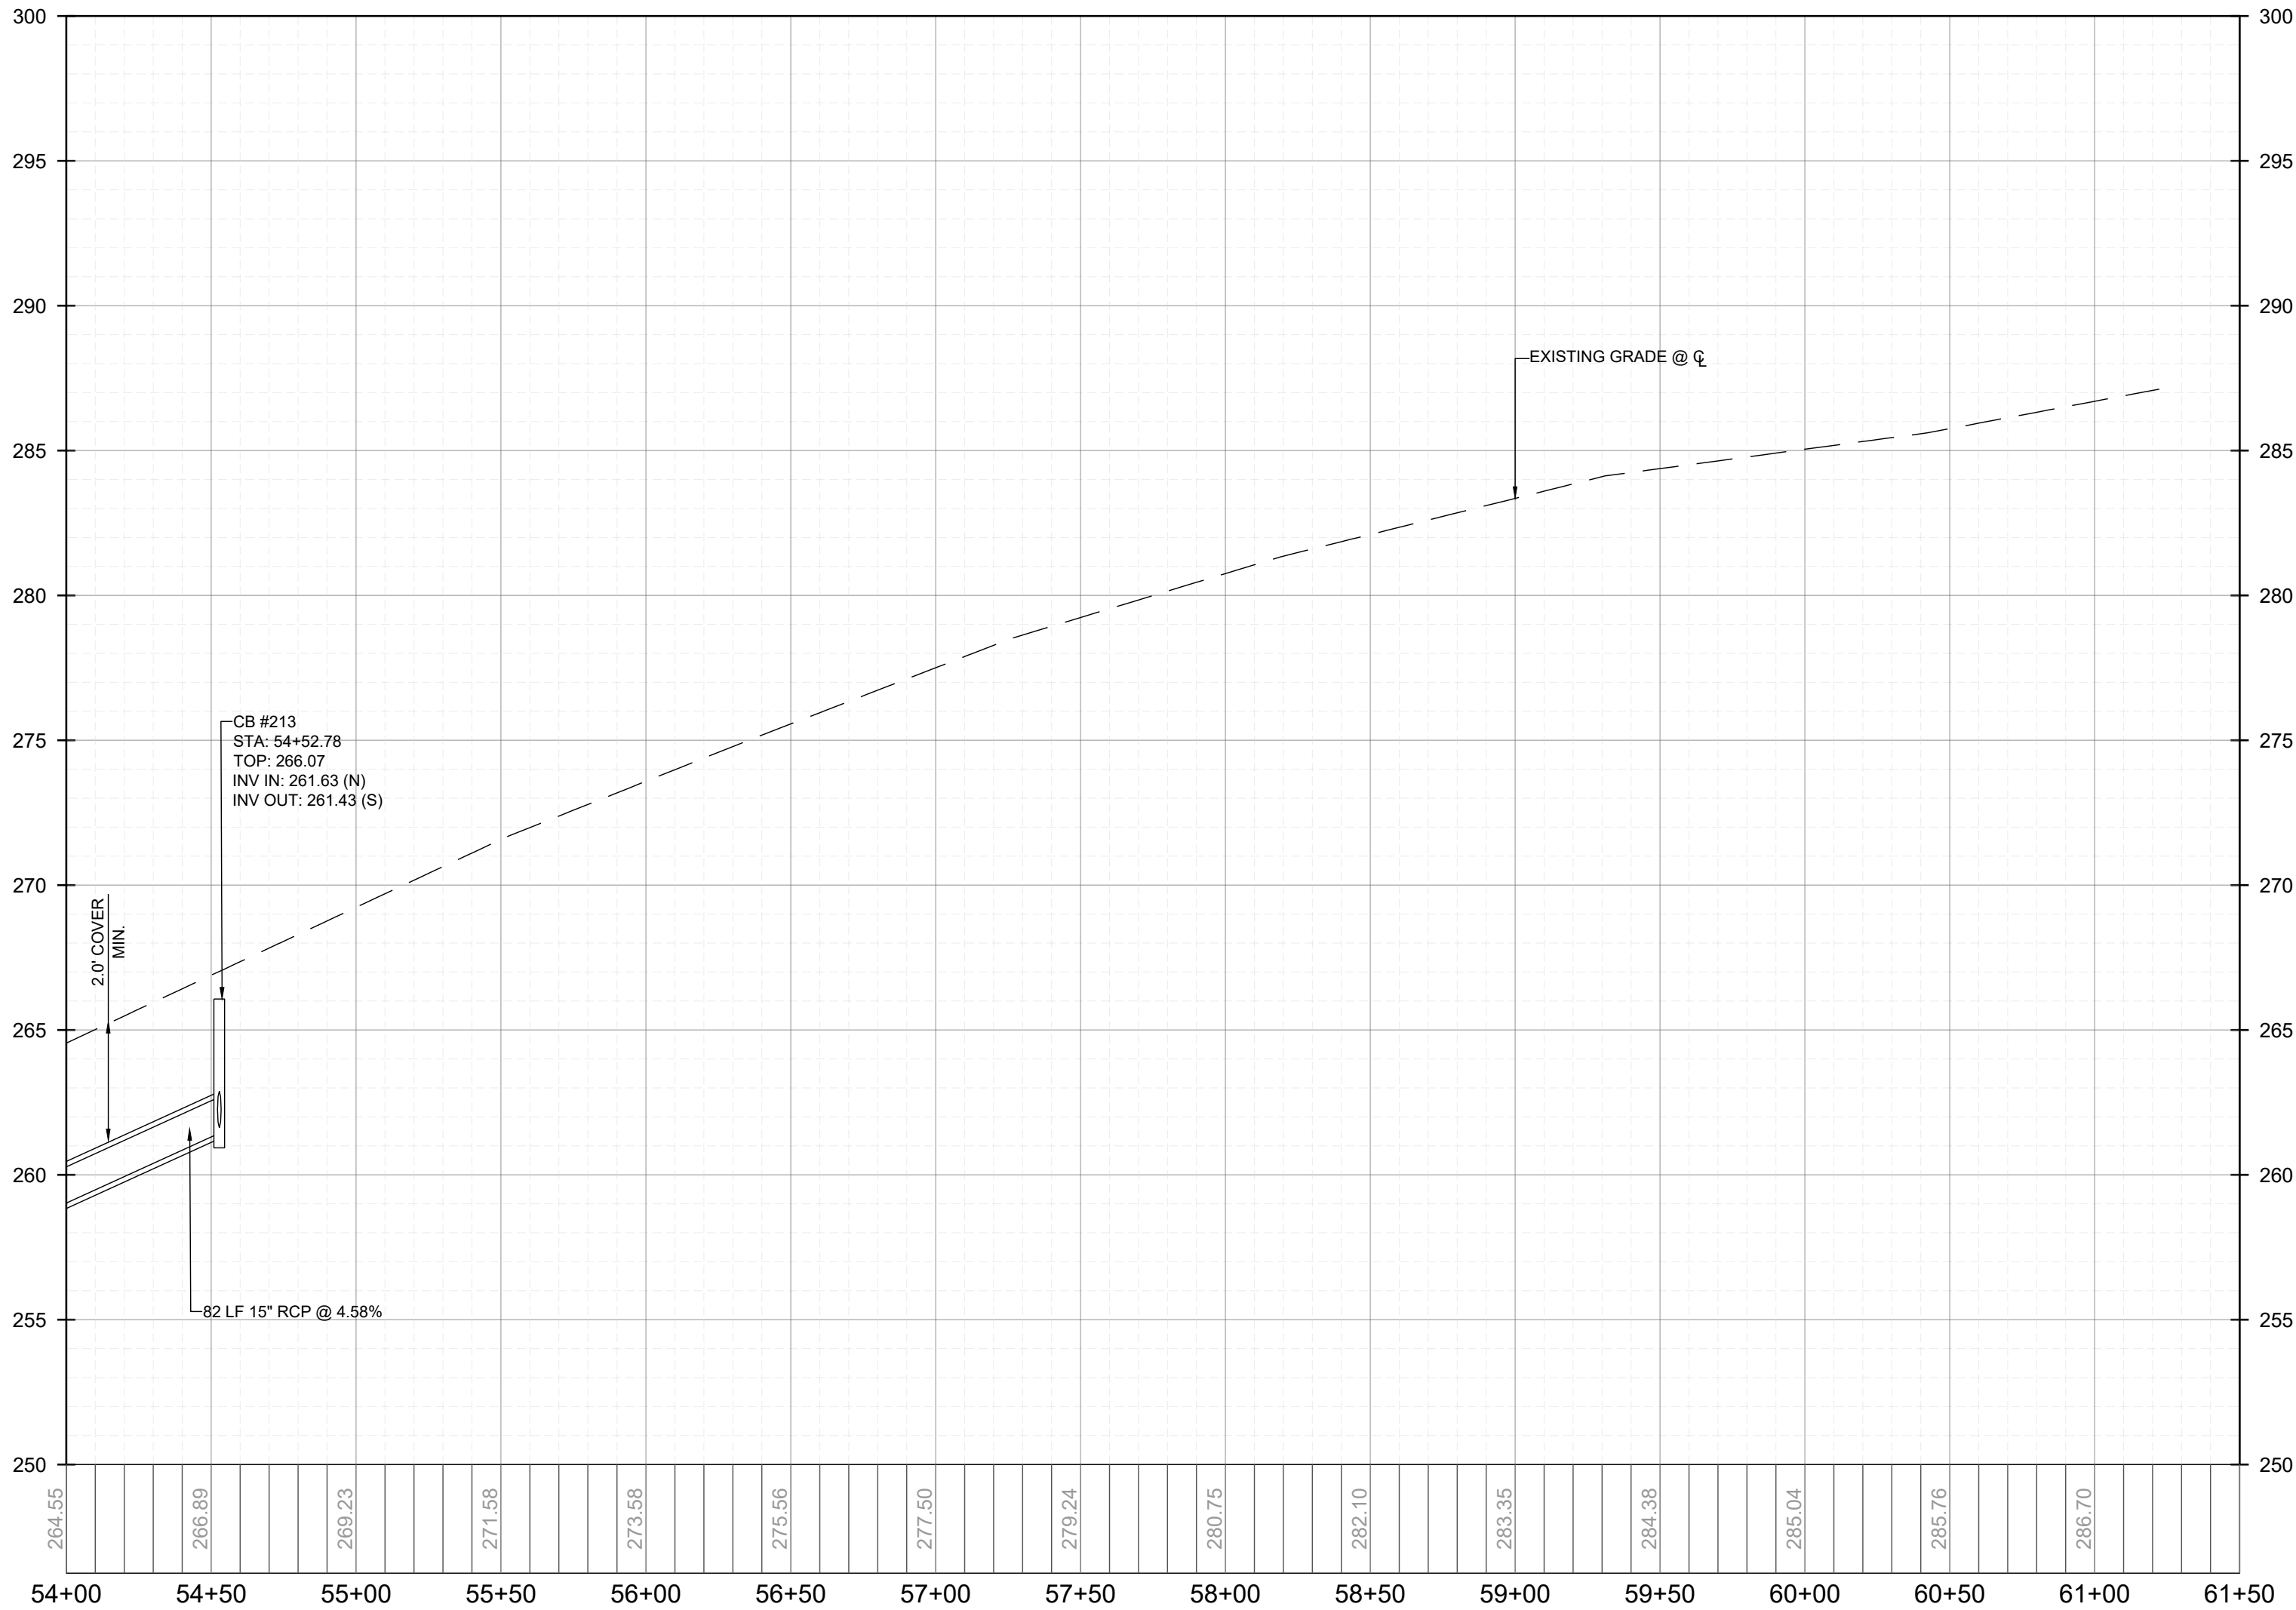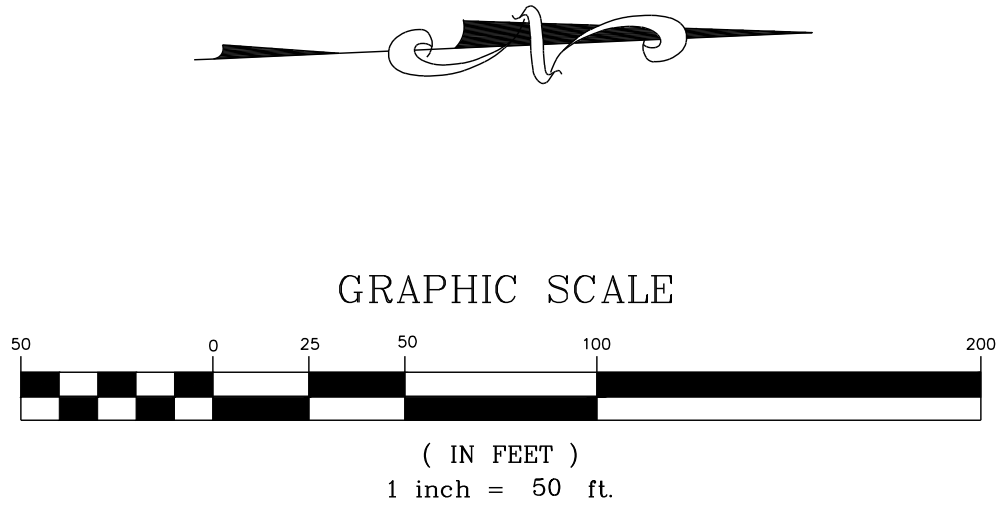

OFF-SITE JONESVILLE RD - PROFILE
VERTICAL: 1" = 5'
HORIZONTAL: 1" = 50'

PUBLIC
WATER DISTRIBUTION / EXTENSION SYSTEM
THE CITY OF RALEIGH CONSENTS TO THE CONNECTION AND EXTENSION OF THE CITY'S PUBLIC WATER SYSTEM AS SHOWN ON THIS PLAN. THE MATERIAL AND CONSTRUCTION METHODS USED FOR THIS PROJECT SHALL CONFORM TO THE STANDARDS AND SPECIFICATIONS OF THE CITY'S PUBLIC UTILITIES HANDBOOK.
CITY OF RALEIGH
PUBLIC UTILITIES DEPARTMENT PERMIT # _____

PUBLIC
SEWER COLLECTION / EXTENSION SYSTEM
THE CITY OF RALEIGH CONSENTS TO THE CONNECTION AND EXTENSION OF THE CITY'S PUBLIC SEWER SYSTEM AS SHOWN ON THIS PLAN. THE MATERIAL AND CONSTRUCTION METHODS USED FOR THIS PROJECT SHALL CONFORM TO THE STANDARDS AND SPECIFICATIONS OF THE CITY'S PUBLIC UTILITIES HANDBOOK.
CITY OF RALEIGH
PUBLIC UTILITIES DEPARTMENT PERMIT # _____

CONSTRUCTION INFRASTRUCTURE DRAWINGS		SEAL:		DATE		BY	
01	CID-24-04	08/04/2024	SRG				
02	TOWN OF ROLESVILLE CID-24-04 V2	11/07/2024	SRG				
03	TOWN OF ROLESVILLE CID-24-04 V3	02/07/2024	SRG				
04	TOWN OF ROLESVILLE CID-24-04 V4	08/02/2025	SRG				
05	TOWN OF ROLESVILLE CID-24-04 V5	09/02/2025	SRG				
				REVISIONS			
				No.			

STRONGROCK

ENGINEERING GROUP

STRONG ROCK ENGINEERING GROUP, PLLC | COMPANY LICENSE # P-2166
305 CHURCH AT NORTH HILLS STREET, SUITE 1110 RALEIGH, NC 27609 | INFORMATION@STRONGROCKGROUP.COM


STRONG ROCK PROJECT	NOT FOR CONSTRUCTION	SCALE	DESIGNED BY	DRAWN BY	CHECKED BY
PSP-24-03	AS SHOWN	SRG	SRG	SRG	SRG

RESERVE @ MITCHELL MILL
TOWN OF ROLESVILLE, WAKE COUNTY, NORTH CAROLINA
CONSTRUCTION PLANS
OFF-SITE JONESVILLE RD -
PLAN & PROFILE



DRAWING
SHEET

C-11.29

125 OF 230

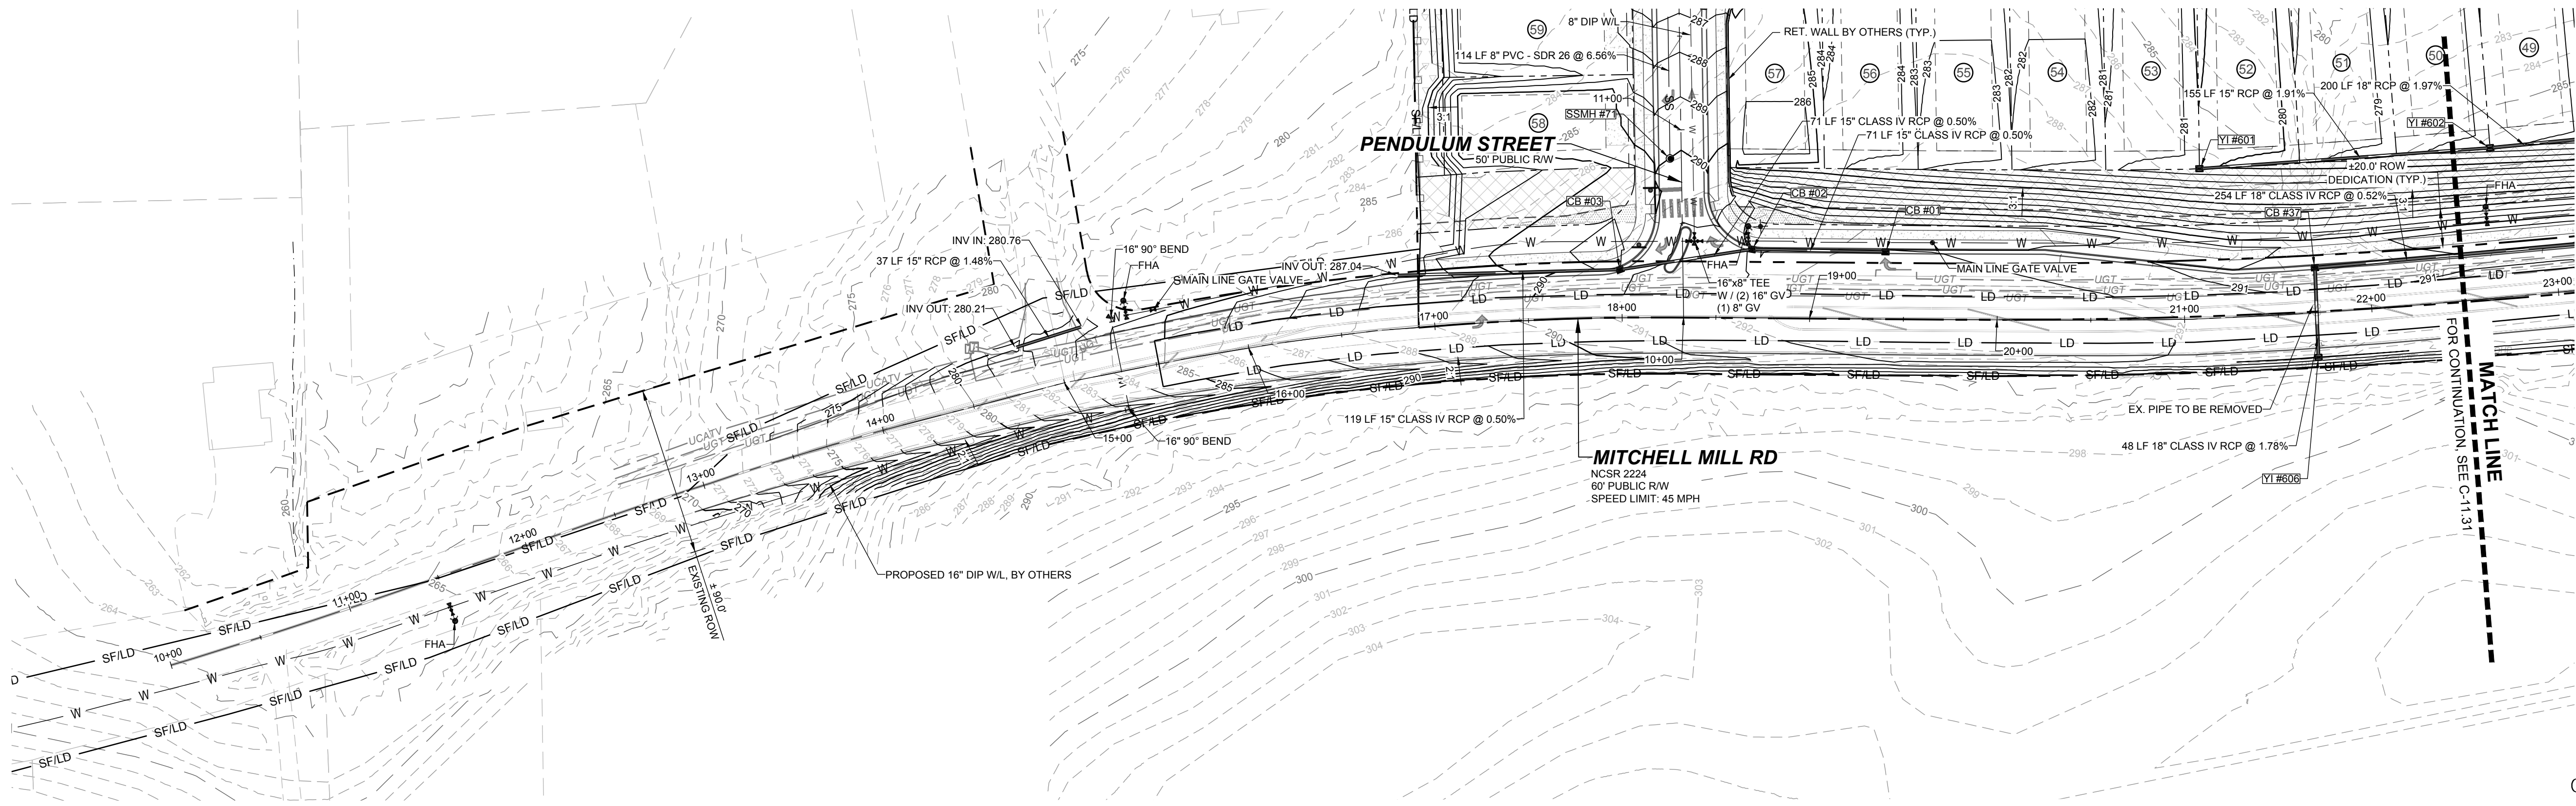

OFF-SITE MITCHELL MILL RD - PLAN
HORIZONTAL: 1" = 50'

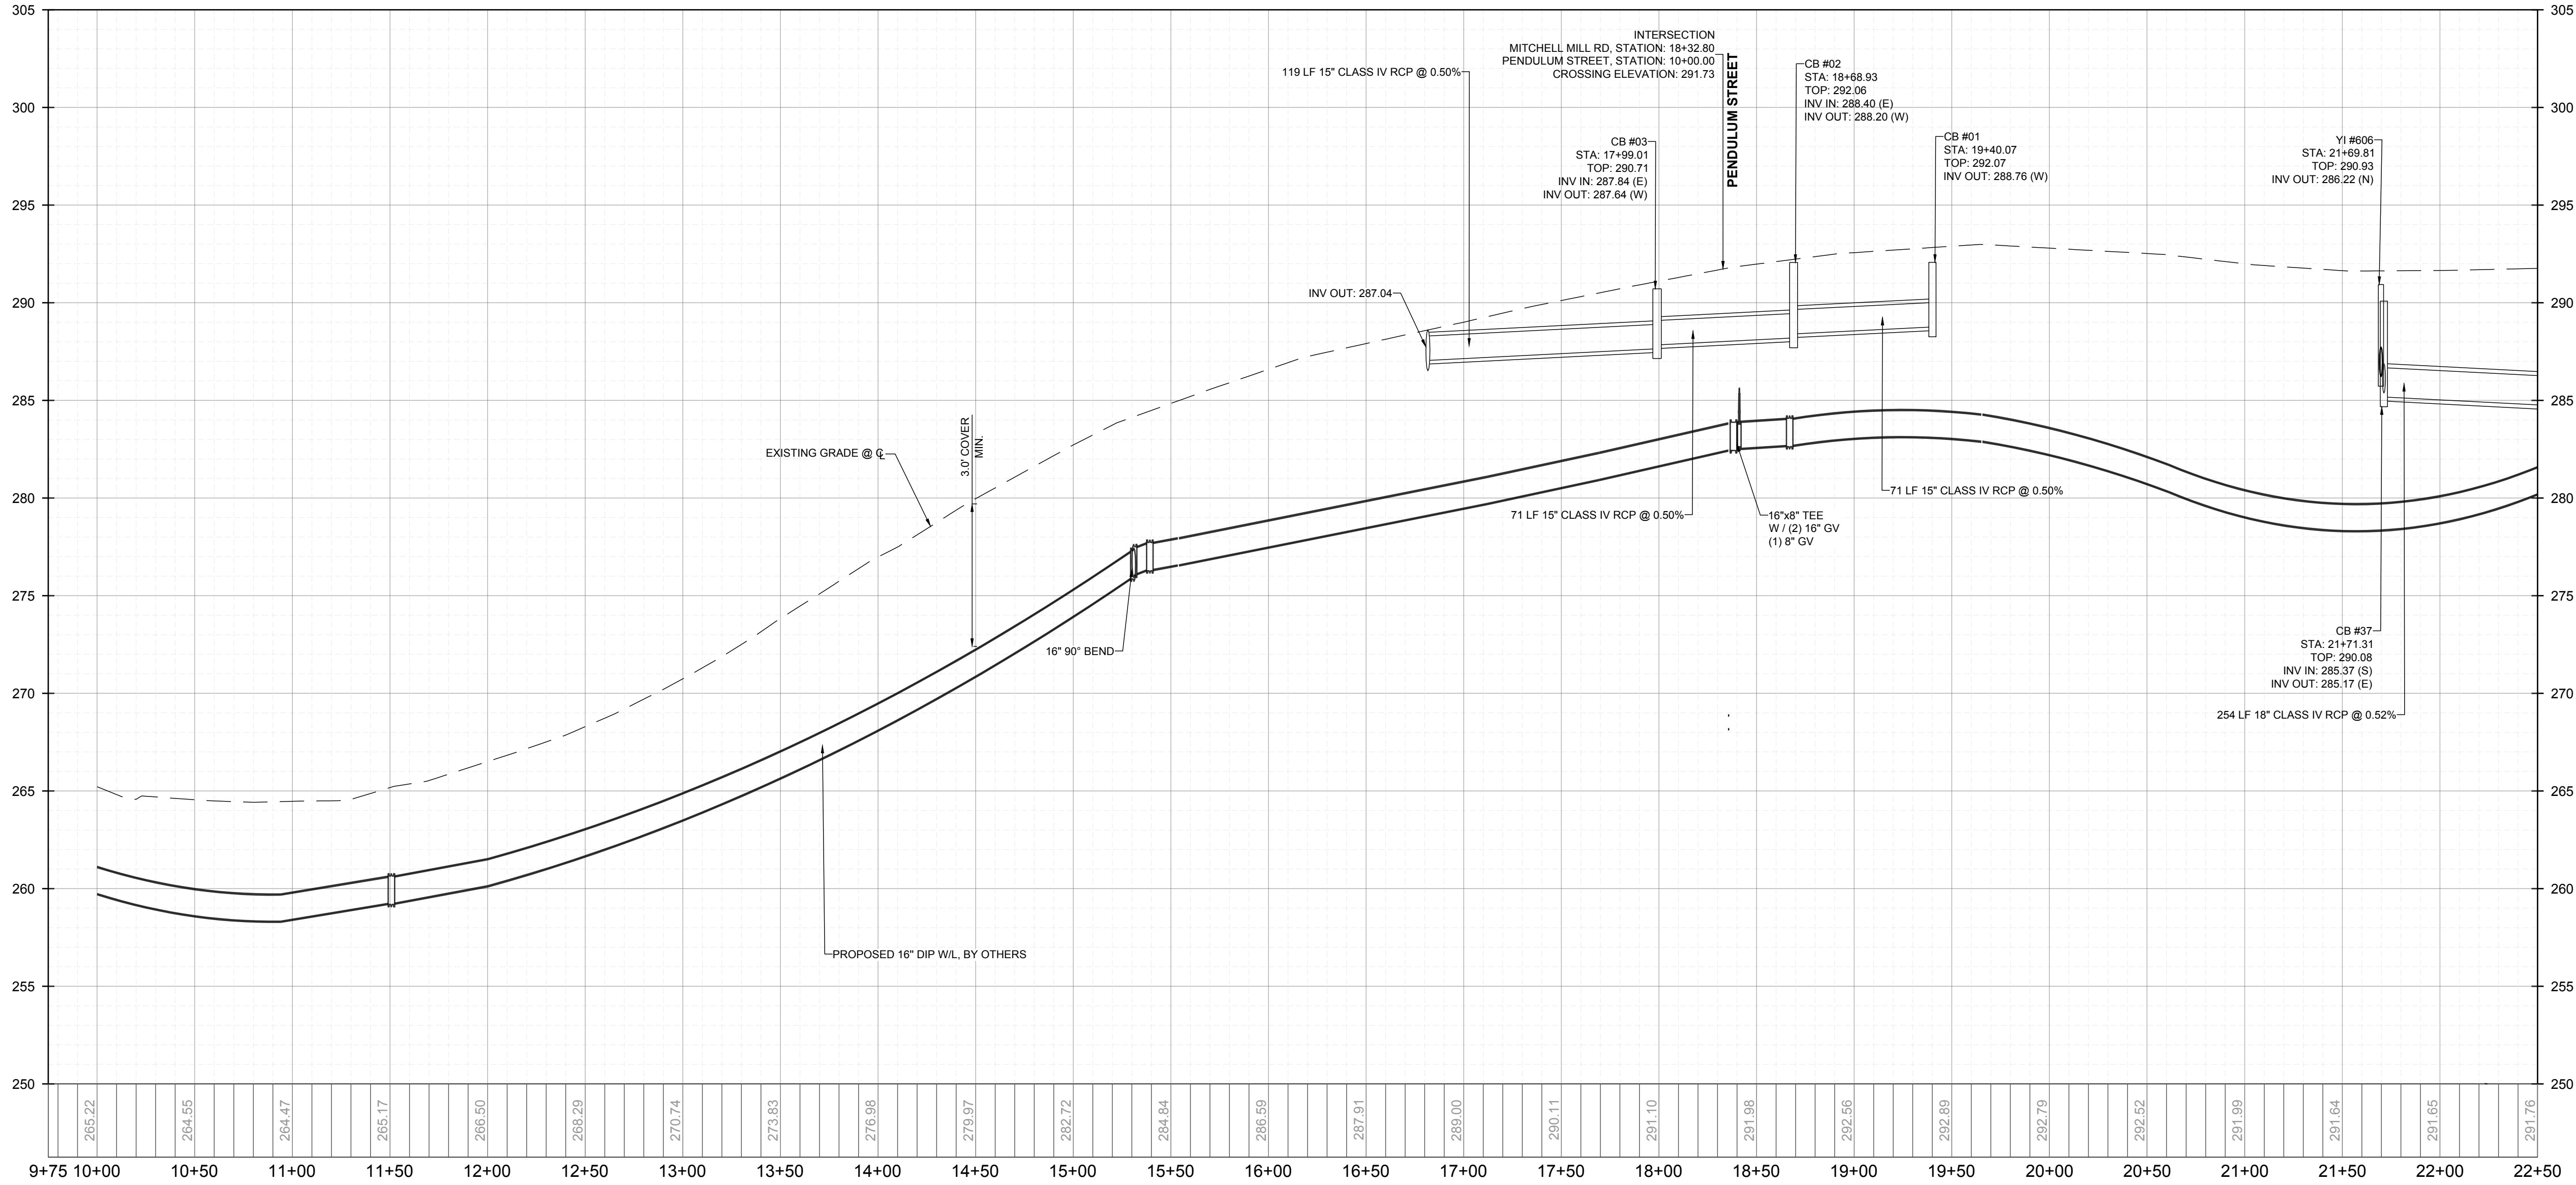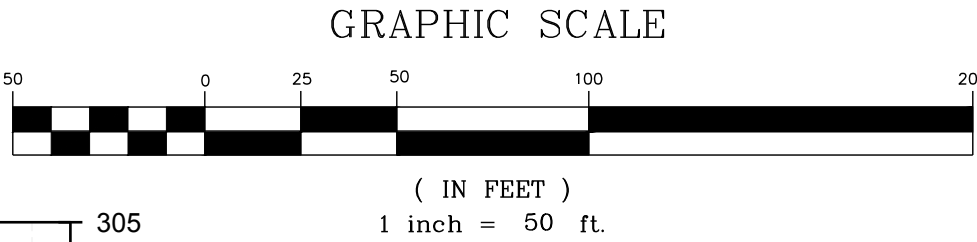

OFF-SITE MITCHELL MILL RD - PROFILE
VERTICAL: 1" = 5'
HORIZONTAL: 1" = 50'

PUBLIC
WATER DISTRIBUTION / EXTENSION SYSTEM
THE CITY OF RALEIGH CONSENTS TO THE CONNECTION AND EXTENSION OF THE CITY'S PUBLIC WATER SYSTEM AS SHOWN ON THIS PLAN. THE MATERIAL AND CONSTRUCTION METHODS USED FOR THIS PROJECT SHALL CONFORM TO THE STANDARDS AND SPECIFICATIONS OF THE CITY'S PUBLIC UTILITIES HANDBOOK.
CITY OF RALEIGH
PUBLIC UTILITIES DEPARTMENT PERMIT # _____

PUBLIC
SEWER COLLECTION / EXTENSION SYSTEM
THE CITY OF RALEIGH CONSENTS TO THE CONNECTION AND EXTENSION OF THE CITY'S PUBLIC SEWER SYSTEM AS SHOWN ON THIS PLAN. THE MATERIAL AND CONSTRUCTION METHODS USED FOR THIS PROJECT SHALL CONFORM TO THE STANDARDS AND SPECIFICATIONS OF THE CITY'S PUBLIC UTILITIES HANDBOOK.
CITY OF RALEIGH
PUBLIC UTILITIES DEPARTMENT PERMIT # _____

SEAL:

STRONGROCK

ENGINEERING GROUP

STRONG ROCK ENGINEERING GROUP, PLLC | COMPANY LICENSE # P-2166
305 CHURCH AT NORTH HILLS STREET, SUITE 1110 RALEIGH, NC 27609 | INFORMATION@STRONGROCKGROUP.COM

CONSTRUCTION INFRASTRUCTURE DRAWINGS
CID-24-04

01

02

03

04

05

NO.

REVISIONS

DATE


BY

RESERVE @ MITCHELL MILL
TOWN OF ROLESVILLE, WAKE COUNTY, NORTH CAROLINA
CONSTRUCTION PLANS
OFF-SITE MITCHELL MILL RD -
PLAN & PROFILE

DRAWING
SHEET
C-11.30

126 OF 230

THIS PLANSET AND ANY ASSOCIATED DOCUMENTS ARE PRELIMINARY AND NOT AUTHORIZED FOR CONSTRUCTION UNTIL SIGNED, DATED, AND OFFICIALLY RELEASED FOR CONSTRUCTION BY THE ENGINEER OF RECORD.

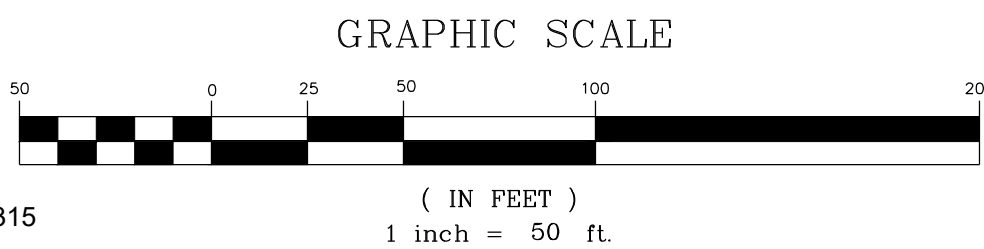


PUBLIC
WATER DISTRIBUTION / EXTENSION SYSTEM
THE CITY OF RALEIGH CONSENTS TO THE
CONNECTION AND EXTENSION OF THE CITY'S
PUBLIC WATER SYSTEM AS SHOWN ON THIS PLAN.
THE MATERIAL AND CONSTRUCTION METHODS
USED FOR THIS PROJECT SHALL CONFORM TO THE
STANDARDS AND SPECIFICATIONS OF THE CITY'S
PUBLIC UTILITIES HANDBOOK.
CITY OF RALEIGH
PUBLIC UTILITIES DEPARTMENT PERMIT # _____

PUBLIC
SEWER COLLECTION / EXTENSION SYSTEM



THE CITY OF RALEIGH CONSENTS TO THE CONNECTION AND EXTENSION OF THE CITY'S PUBLIC SEWER SYSTEM AS SHOWN ON THIS PLAN. THE MATERIAL AND CONSTRUCTION METHODS USED FOR THIS PROJECT SHALL CONFORM TO THE STANDARDS AND SPECIFICATIONS OF THE CITY'S PUBLIC UTILITIES HANDBOOK.

CITY OF RALEIGH
PUBLIC UTILITIES DEPARTMENT PERMIT # _____



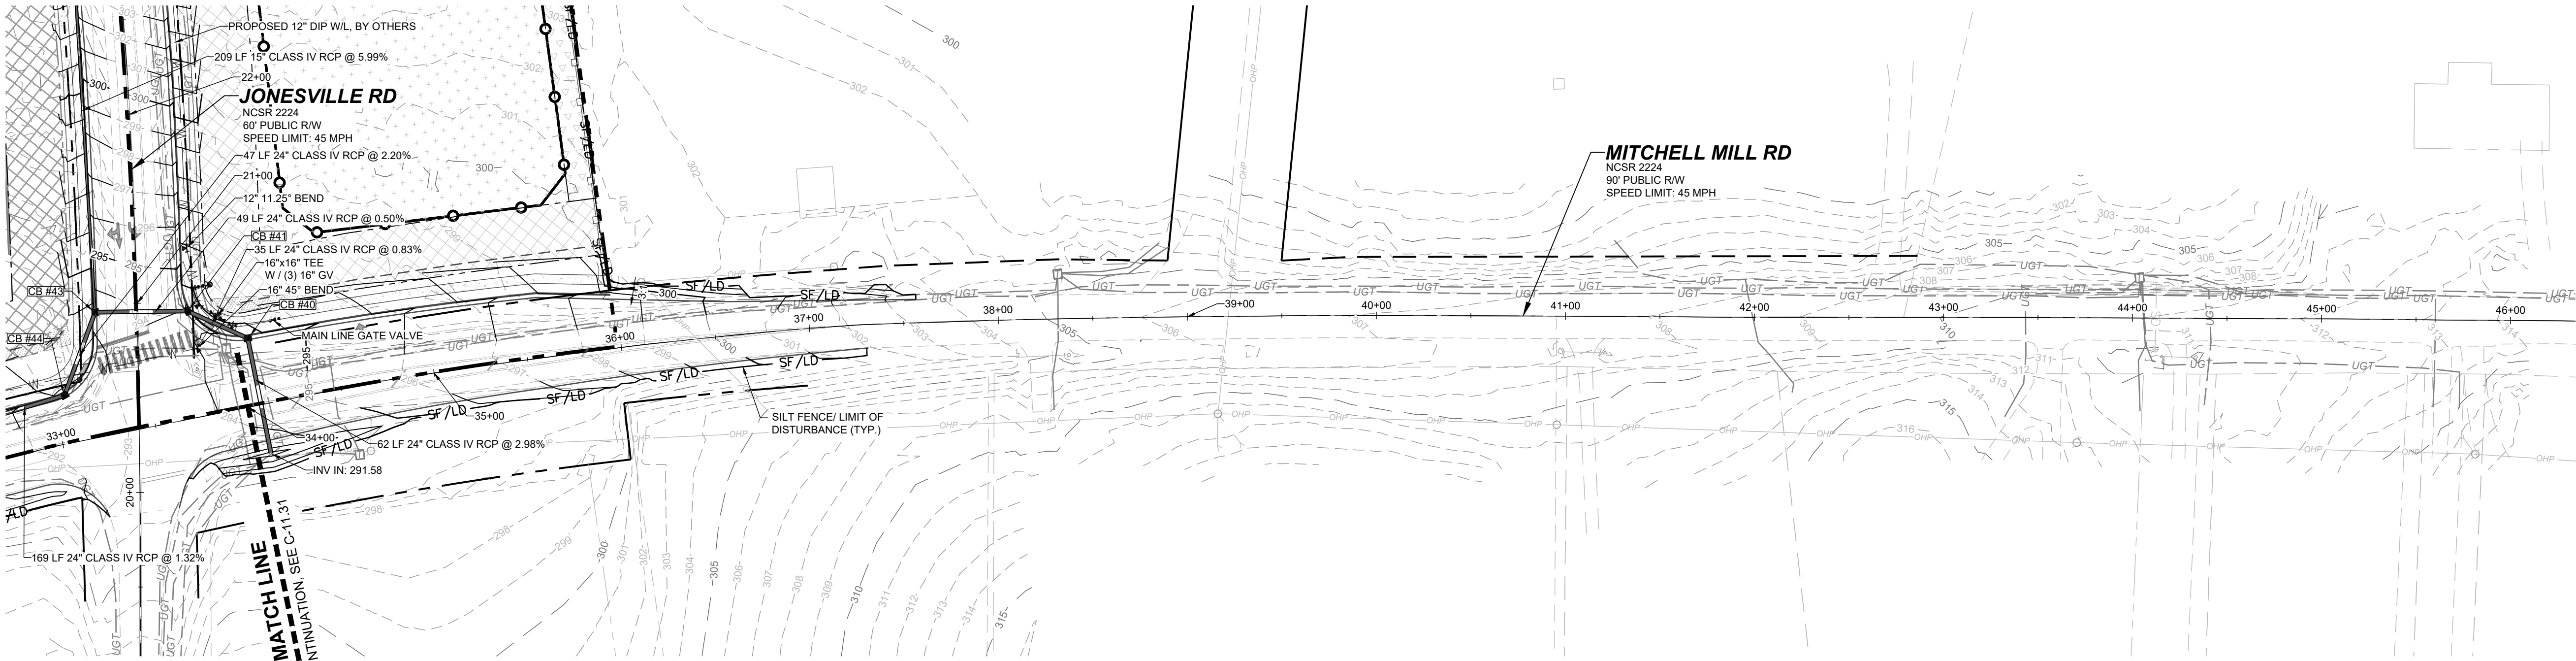

OFF-SITE MITCHELL MILL RD - PLAN
HORIZONTAL: 1" = 50'

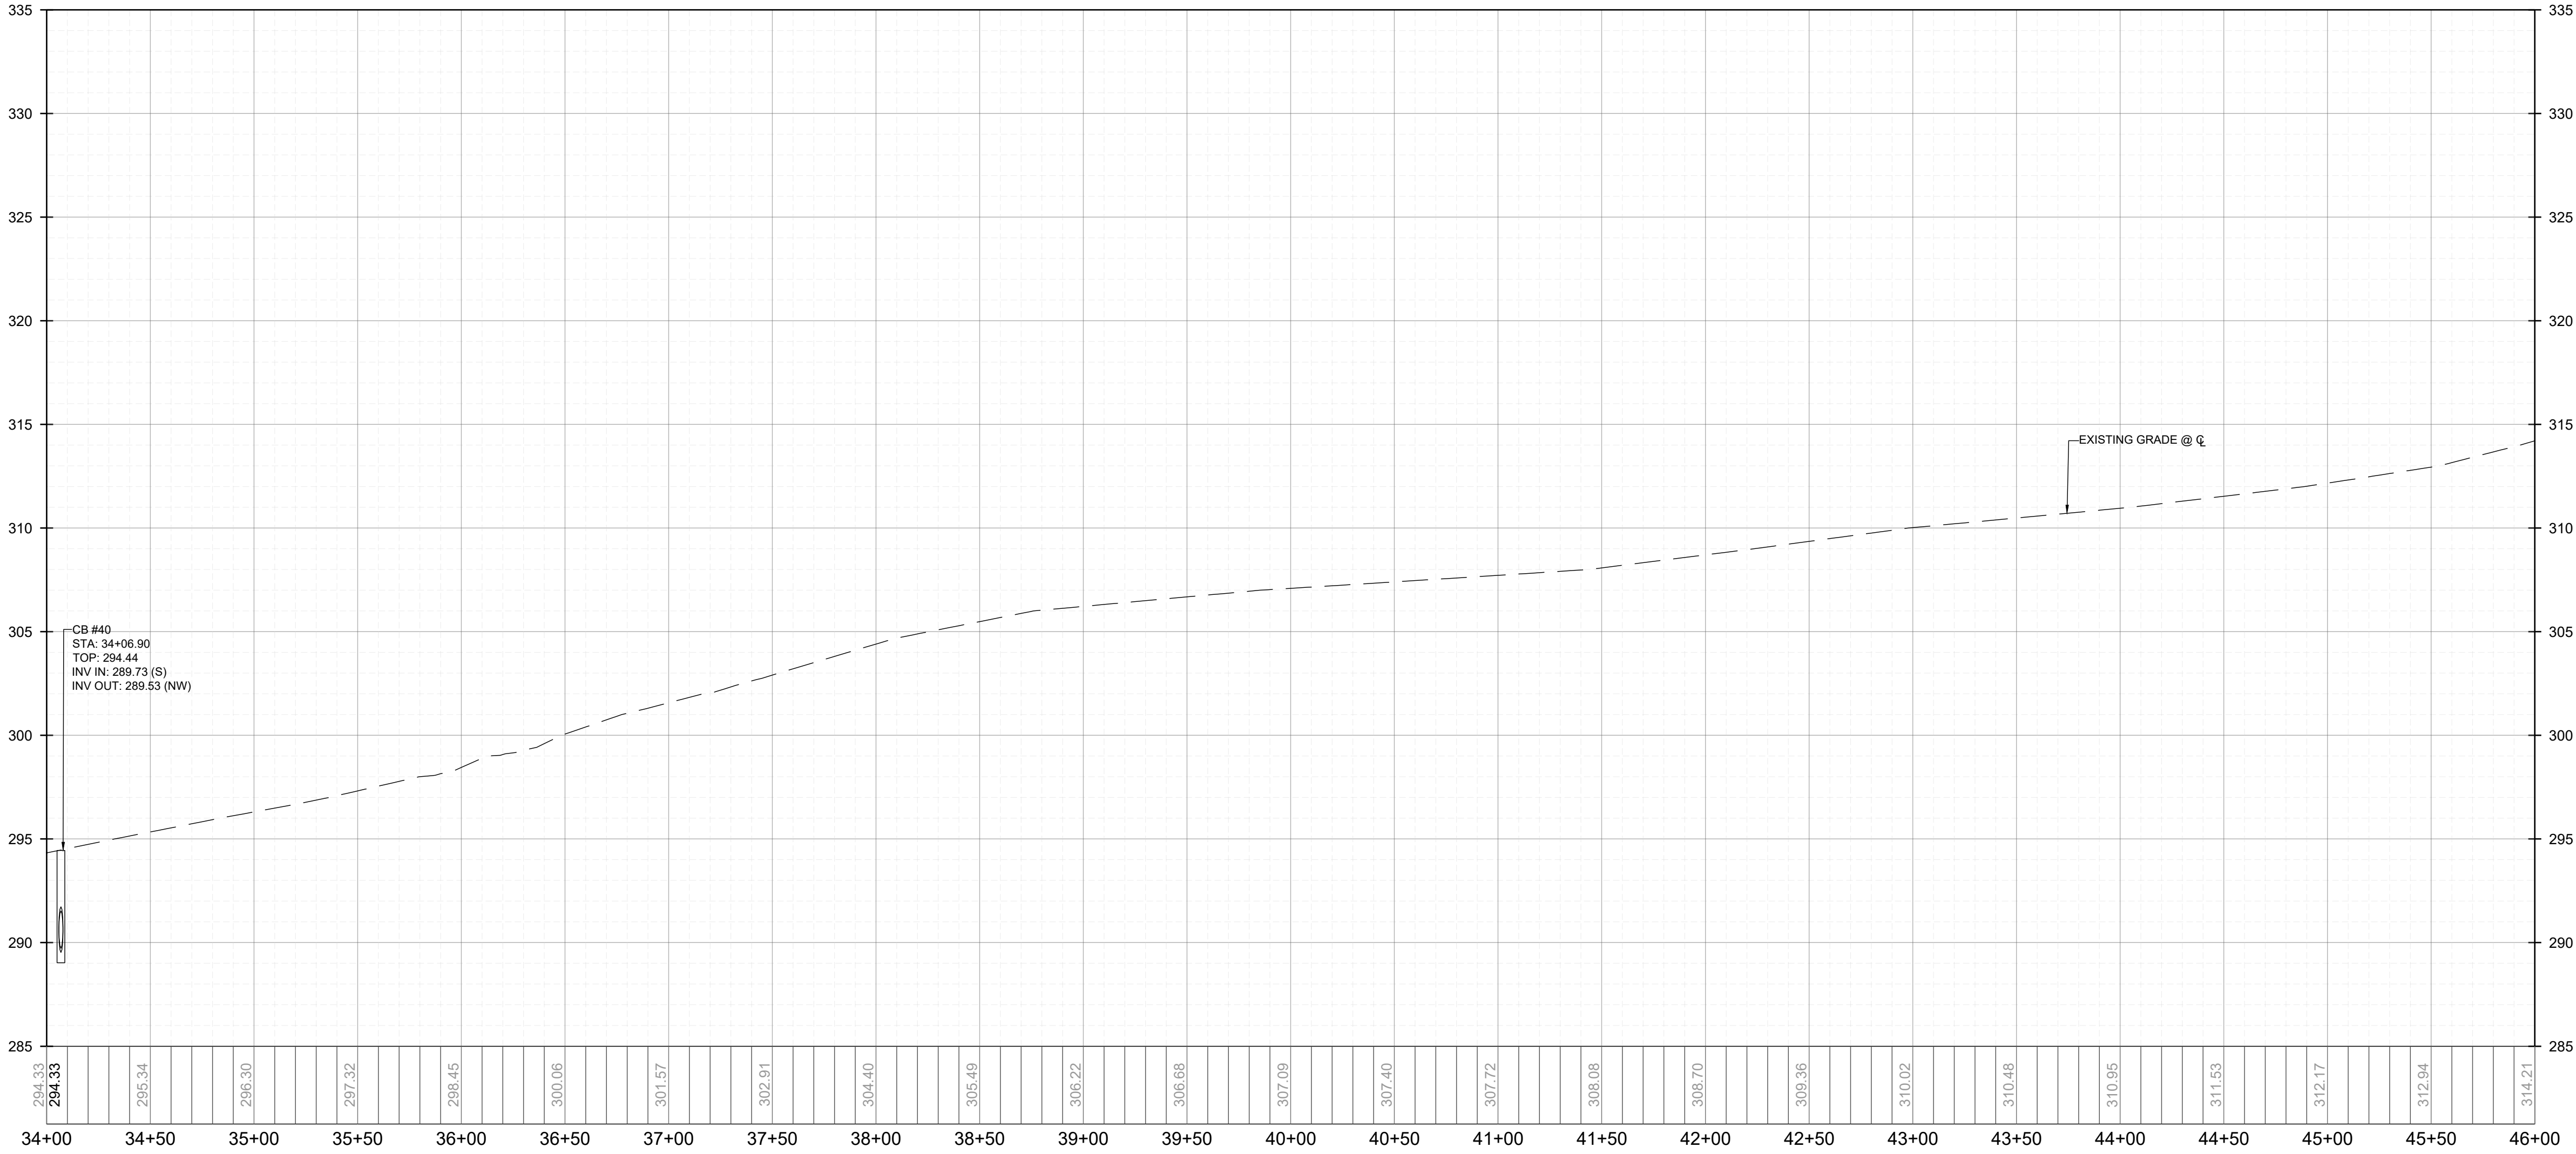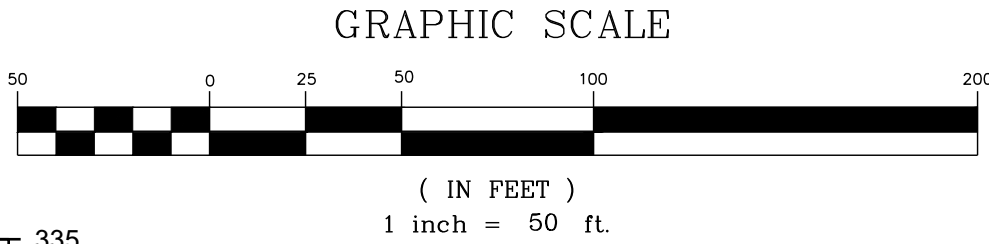

OFF-SITE MITCHELL MILL RD - PROFILE
VERTICAL: 1" = 5'
HORIZONTAL: 1" = 50'

PUBLIC
WATER DISTRIBUTION / EXTENSION SYSTEM
THE CITY OF RALEIGH CONSENTS TO THE CONNECTION AND EXTENSION OF THE CITY'S PUBLIC WATER SYSTEM AS SHOWN ON THIS PLAN. THE MATERIAL AND CONSTRUCTION METHODS USED FOR THIS PROJECT SHALL CONFORM TO THE STANDARDS AND SPECIFICATIONS OF THE CITY'S PUBLIC UTILITIES HANDBOOK.
CITY OF RALEIGH
PUBLIC UTILITIES DEPARTMENT PERMIT # _____

PUBLIC
SEWER COLLECTION / EXTENSION SYSTEM
THE CITY OF RALEIGH CONSENTS TO THE CONNECTION AND EXTENSION OF THE CITY'S PUBLIC SEWER SYSTEM AS SHOWN ON THIS PLAN. THE MATERIAL AND CONSTRUCTION METHODS USED FOR THIS PROJECT SHALL CONFORM TO THE STANDARDS AND SPECIFICATIONS OF THE CITY'S PUBLIC UTILITIES HANDBOOK.
CITY OF RALEIGH
PUBLIC UTILITIES DEPARTMENT PERMIT # _____

STRONGROCK

ENGINEERING GROUP

STRONG ROCK ENGINEERING GROUP, PLLC | COMPANY LICENSE # P-2166
305 CHURCH AT NORTH HILLS STREET, SUITE 1110 RALEIGH, NC 27609 | INFORMATION@STRONGROCKGROUP.COM

STRONG ROCK PROJECT
PSP-24-03

NOT FOR
CONSTRUCTION

SCALE
AS SHOWN

DESIGNED BY
SRG

DRAWN BY
SRG

CHECKED BY
SRG

RESERVE @ MITCHELL MILL
TOWN OF ROLESVILLE, WAKE COUNTY, NORTH CAROLINA
CONSTRUCTION PLANS
OFF-SITE MITCHELL MILL RD -
PLAN & PROFILE

DRAWING
SHEET
C-11.32

128 OF 230

CONSTRUCTION INFRASTRUCTURE DRAWINGS
CID-24-04

01

02

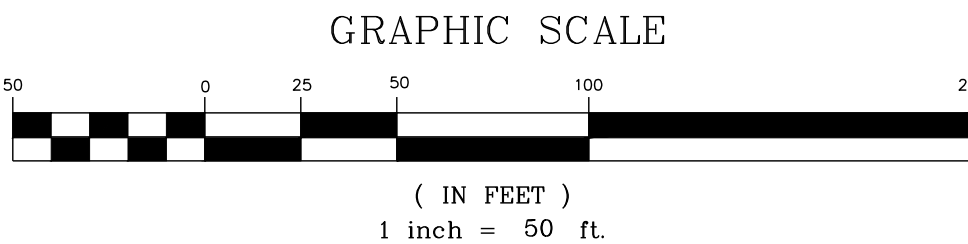

PUBLIC

WATER DISTRIBUTION / EXTENSION SYSTEM

THE CITY OF RALEIGH CONSENTS TO THE CONNECTION AND EXTENSION OF THE CITY'S PUBLIC WATER SYSTEM AS SHOWN ON THIS PLAN. THE MATERIAL AND CONSTRUCTION METHODS USED FOR THIS PROJECT SHALL CONFORM TO THE STANDARDS AND SPECIFICATIONS OF THE CITY'S PUBLIC UTILITIES HANDBOOK.

CITY OF RALEIGH
PUBLIC UTILITIES DEPARTMENT PERMIT # _____

PUBLIC

SEWER COLLECTION / EXTENSION SYSTEM

THE CITY OF RALEIGH CONSENTS TO THE CONNECTION AND EXTENSION OF THE CITY'S PUBLIC SEWER SYSTEM AS SHOWN ON THIS PLAN. THE MATERIAL AND CONSTRUCTION METHODS USED FOR THIS PROJECT SHALL CONFORM TO THE STANDARDS AND SPECIFICATIONS OF THE CITY'S PUBLIC UTILITIES HANDBOOK.

CITY OF RALEIGH
PUBLIC UTILITIES DEPARTMENT PERMIT # _____

