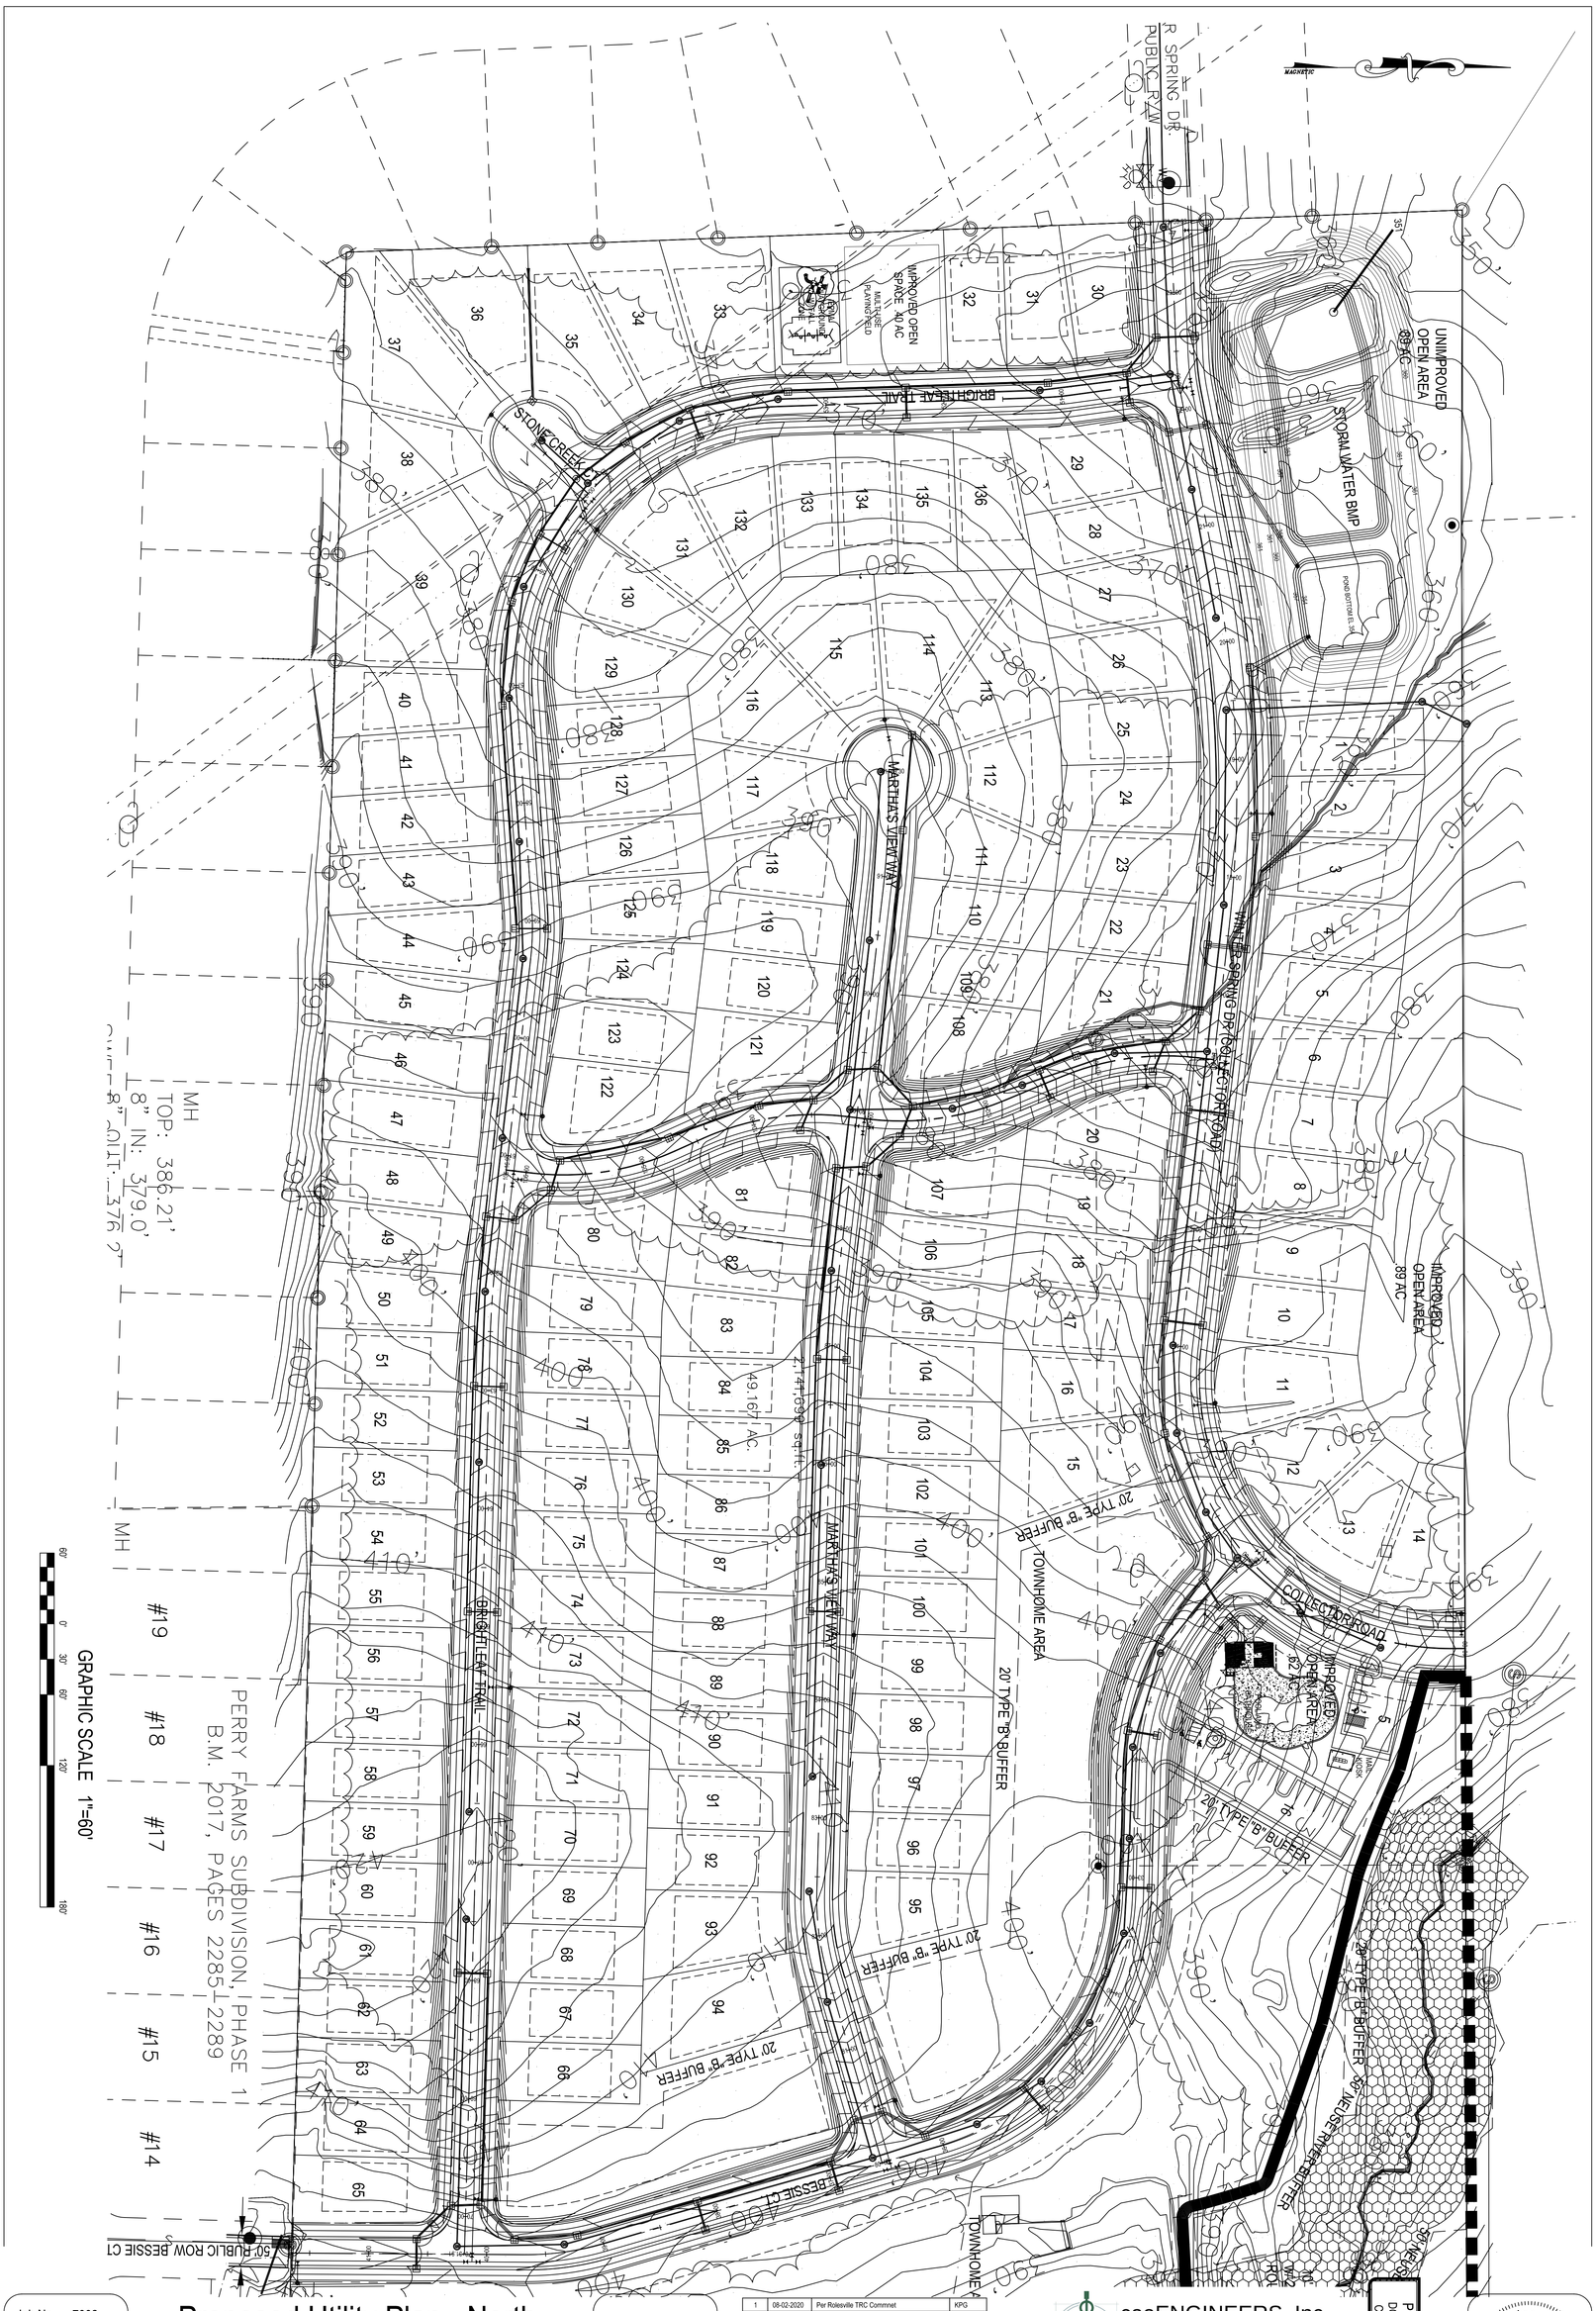

Job No. 7002

Dwg No.

C4

Proposed Utility Plan - North

Preserve at Jones Dairy Subdivision - North

Jones Dairy Road

Rolesville, Wake County, North Carolina

NORTH CAROLINA PROFESSIONAL ENGINEER SEAL 030913 KEITH P. GETTLE

NO.	DATE	REVISION DESCRIPTION	BY
1	08-02-2020	Per Rolesville TRC Commnet	KPG
2	Date	Comment	By
3	Date	Comment	By
4	Date	Comment	By
5	Date	Comment	By
6	Date	Comment	By
7	Date	Comment	By
8	Date	Comment	By

caaENGINEERS, Inc.

McIntyre, Gettle, Crowley

PROFESSIONAL ENGINEERS

1233 Heritage Links Drive, Wake Forest, North Carolina 27587

4932B Windy Hill Drive, Raleigh, North Carolina 27609

(919)625-6755

C-2151 © caaENGINEERS, Inc. All Rights Reserved

PRELIMINARY DO NOT USE FOR CONSTRUCTION

CAAengineers, INC. PROFESSIONAL SEAL NORTH CAROLINA 2018 CORPORATION